

SUITE: 1400



RSF: 23,516

AS-BUILT CONFIGURATION

OFFICES.....	37
RECEPTION.....	1
CONFERENCE ROOMS.....	5
KITCHEN.....	2
OPEN WORK AREA.....	+/-58

Not to scale, furniture and appliances not included

KEY PLAN

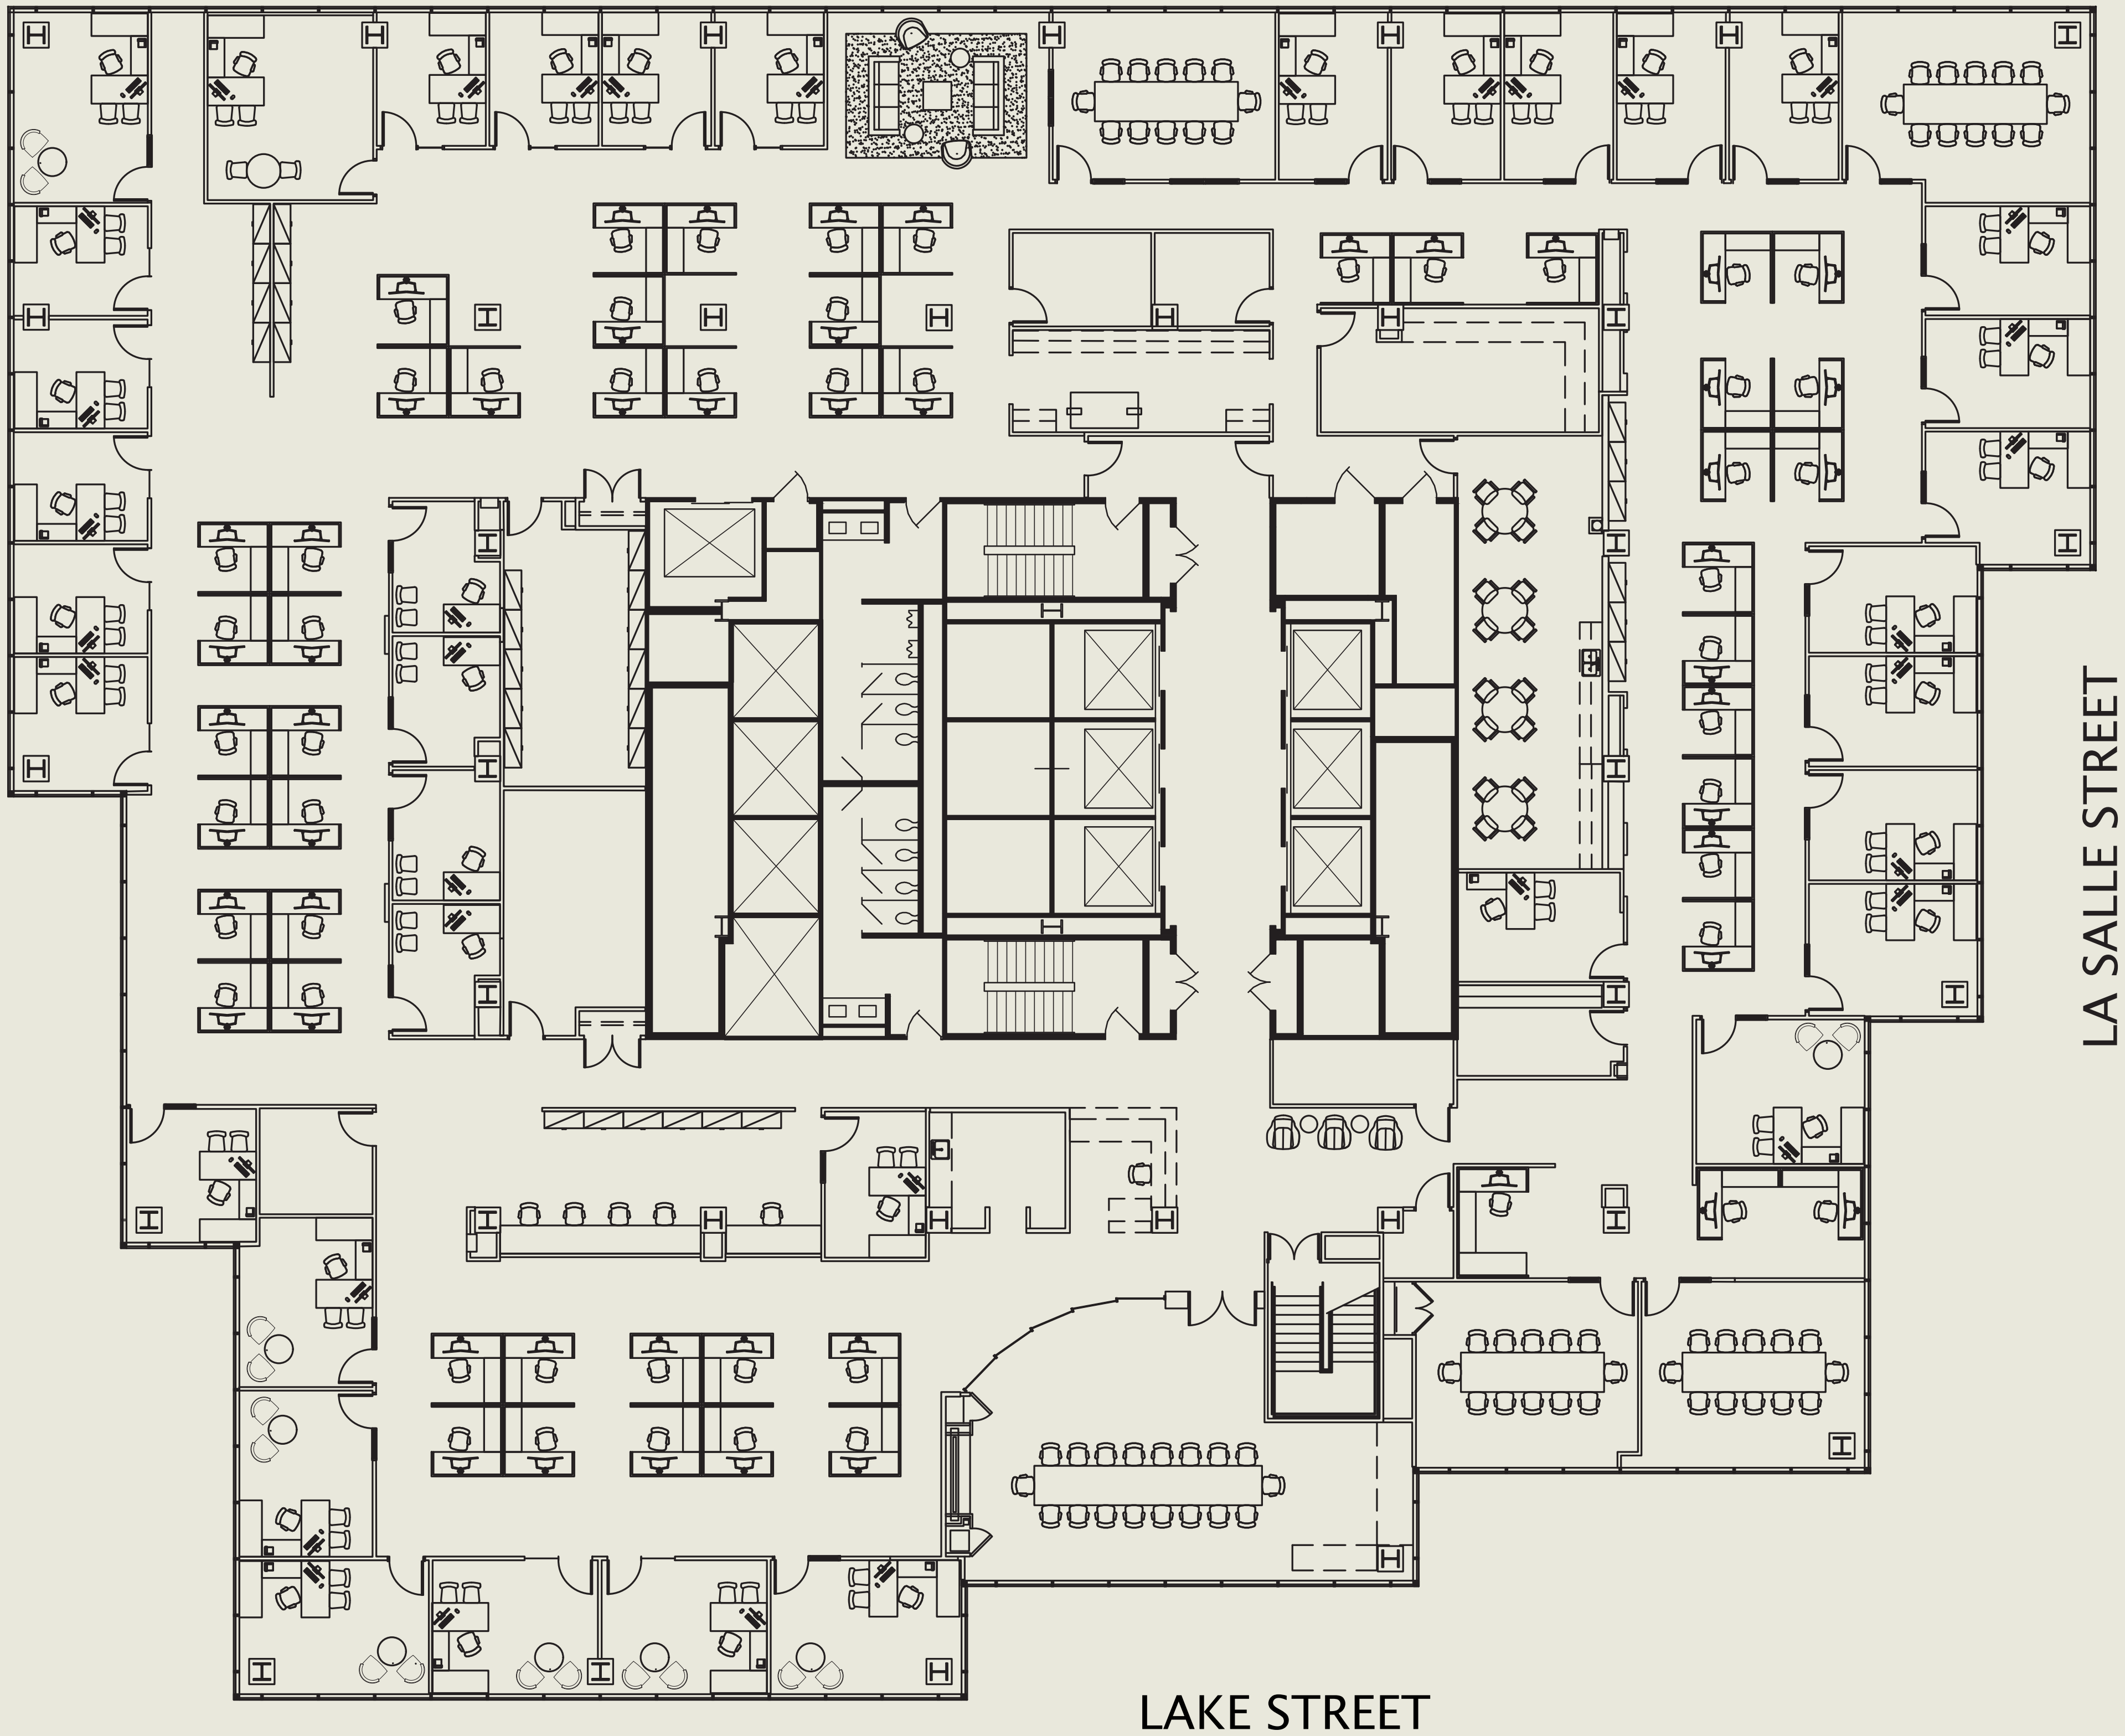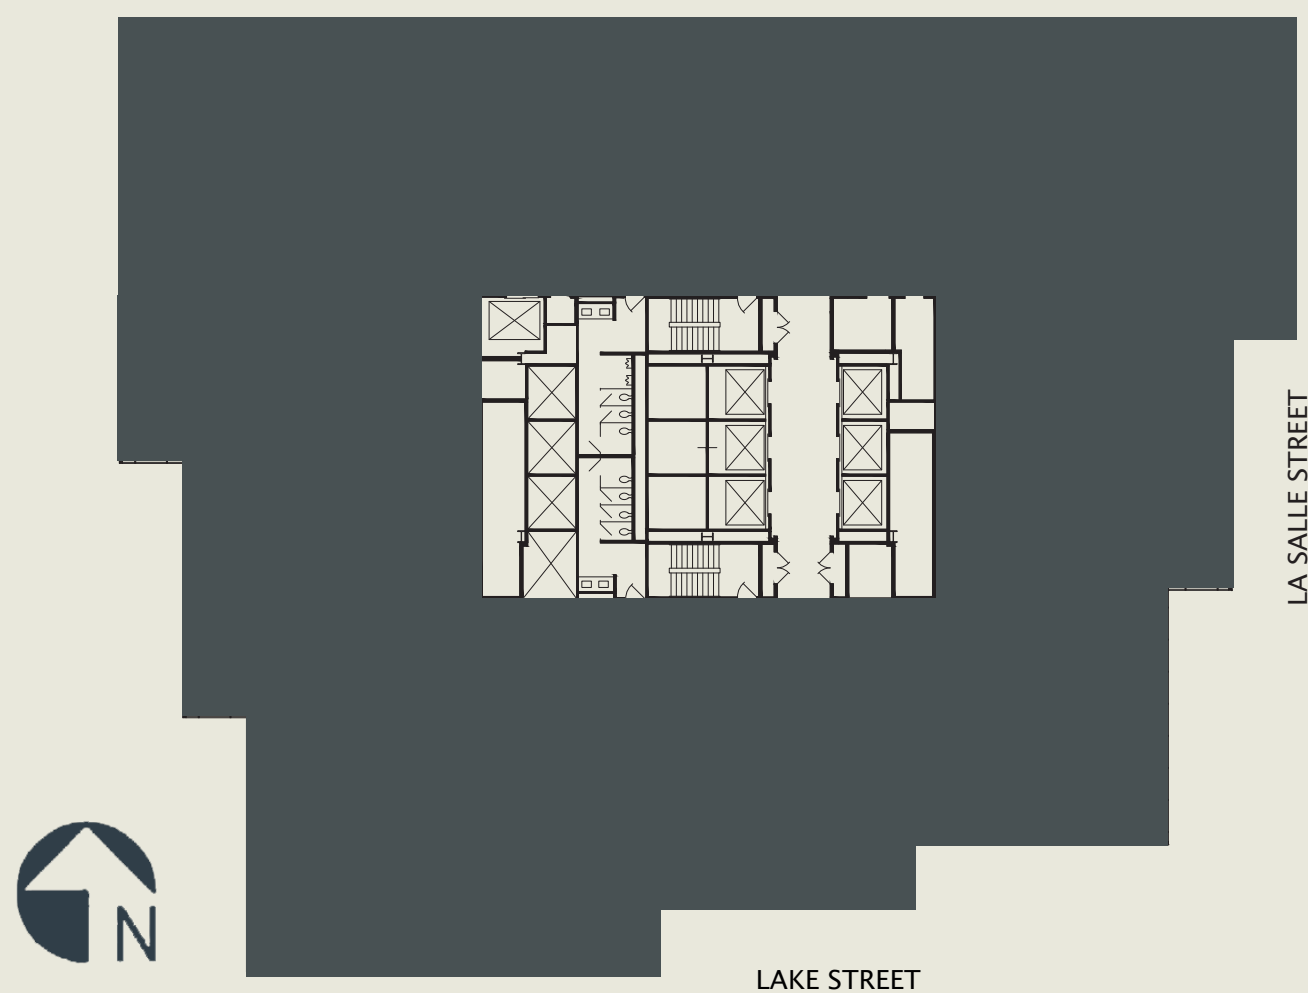

FOR LEASING INFORMATION PLEASE CONTACT:

MARK GUNDERSON
312 448 8645 | mark.gunderson@streamrealty.com

BEN CLEVELAND
312 448 6221 | ben.cleveland@streamrealty.com