

SUITE: 1510



RSF: 4,412

AS-BUILT CONFIGURATION

OFFICES.....	3
RECEPTION.....	1
CONFERENCE ROOMS.....	5
KITCHEN.....	1
OPEN WORK AREA.....	+/- 41

Not to scale, furniture and appliances not included

KEY PLAN

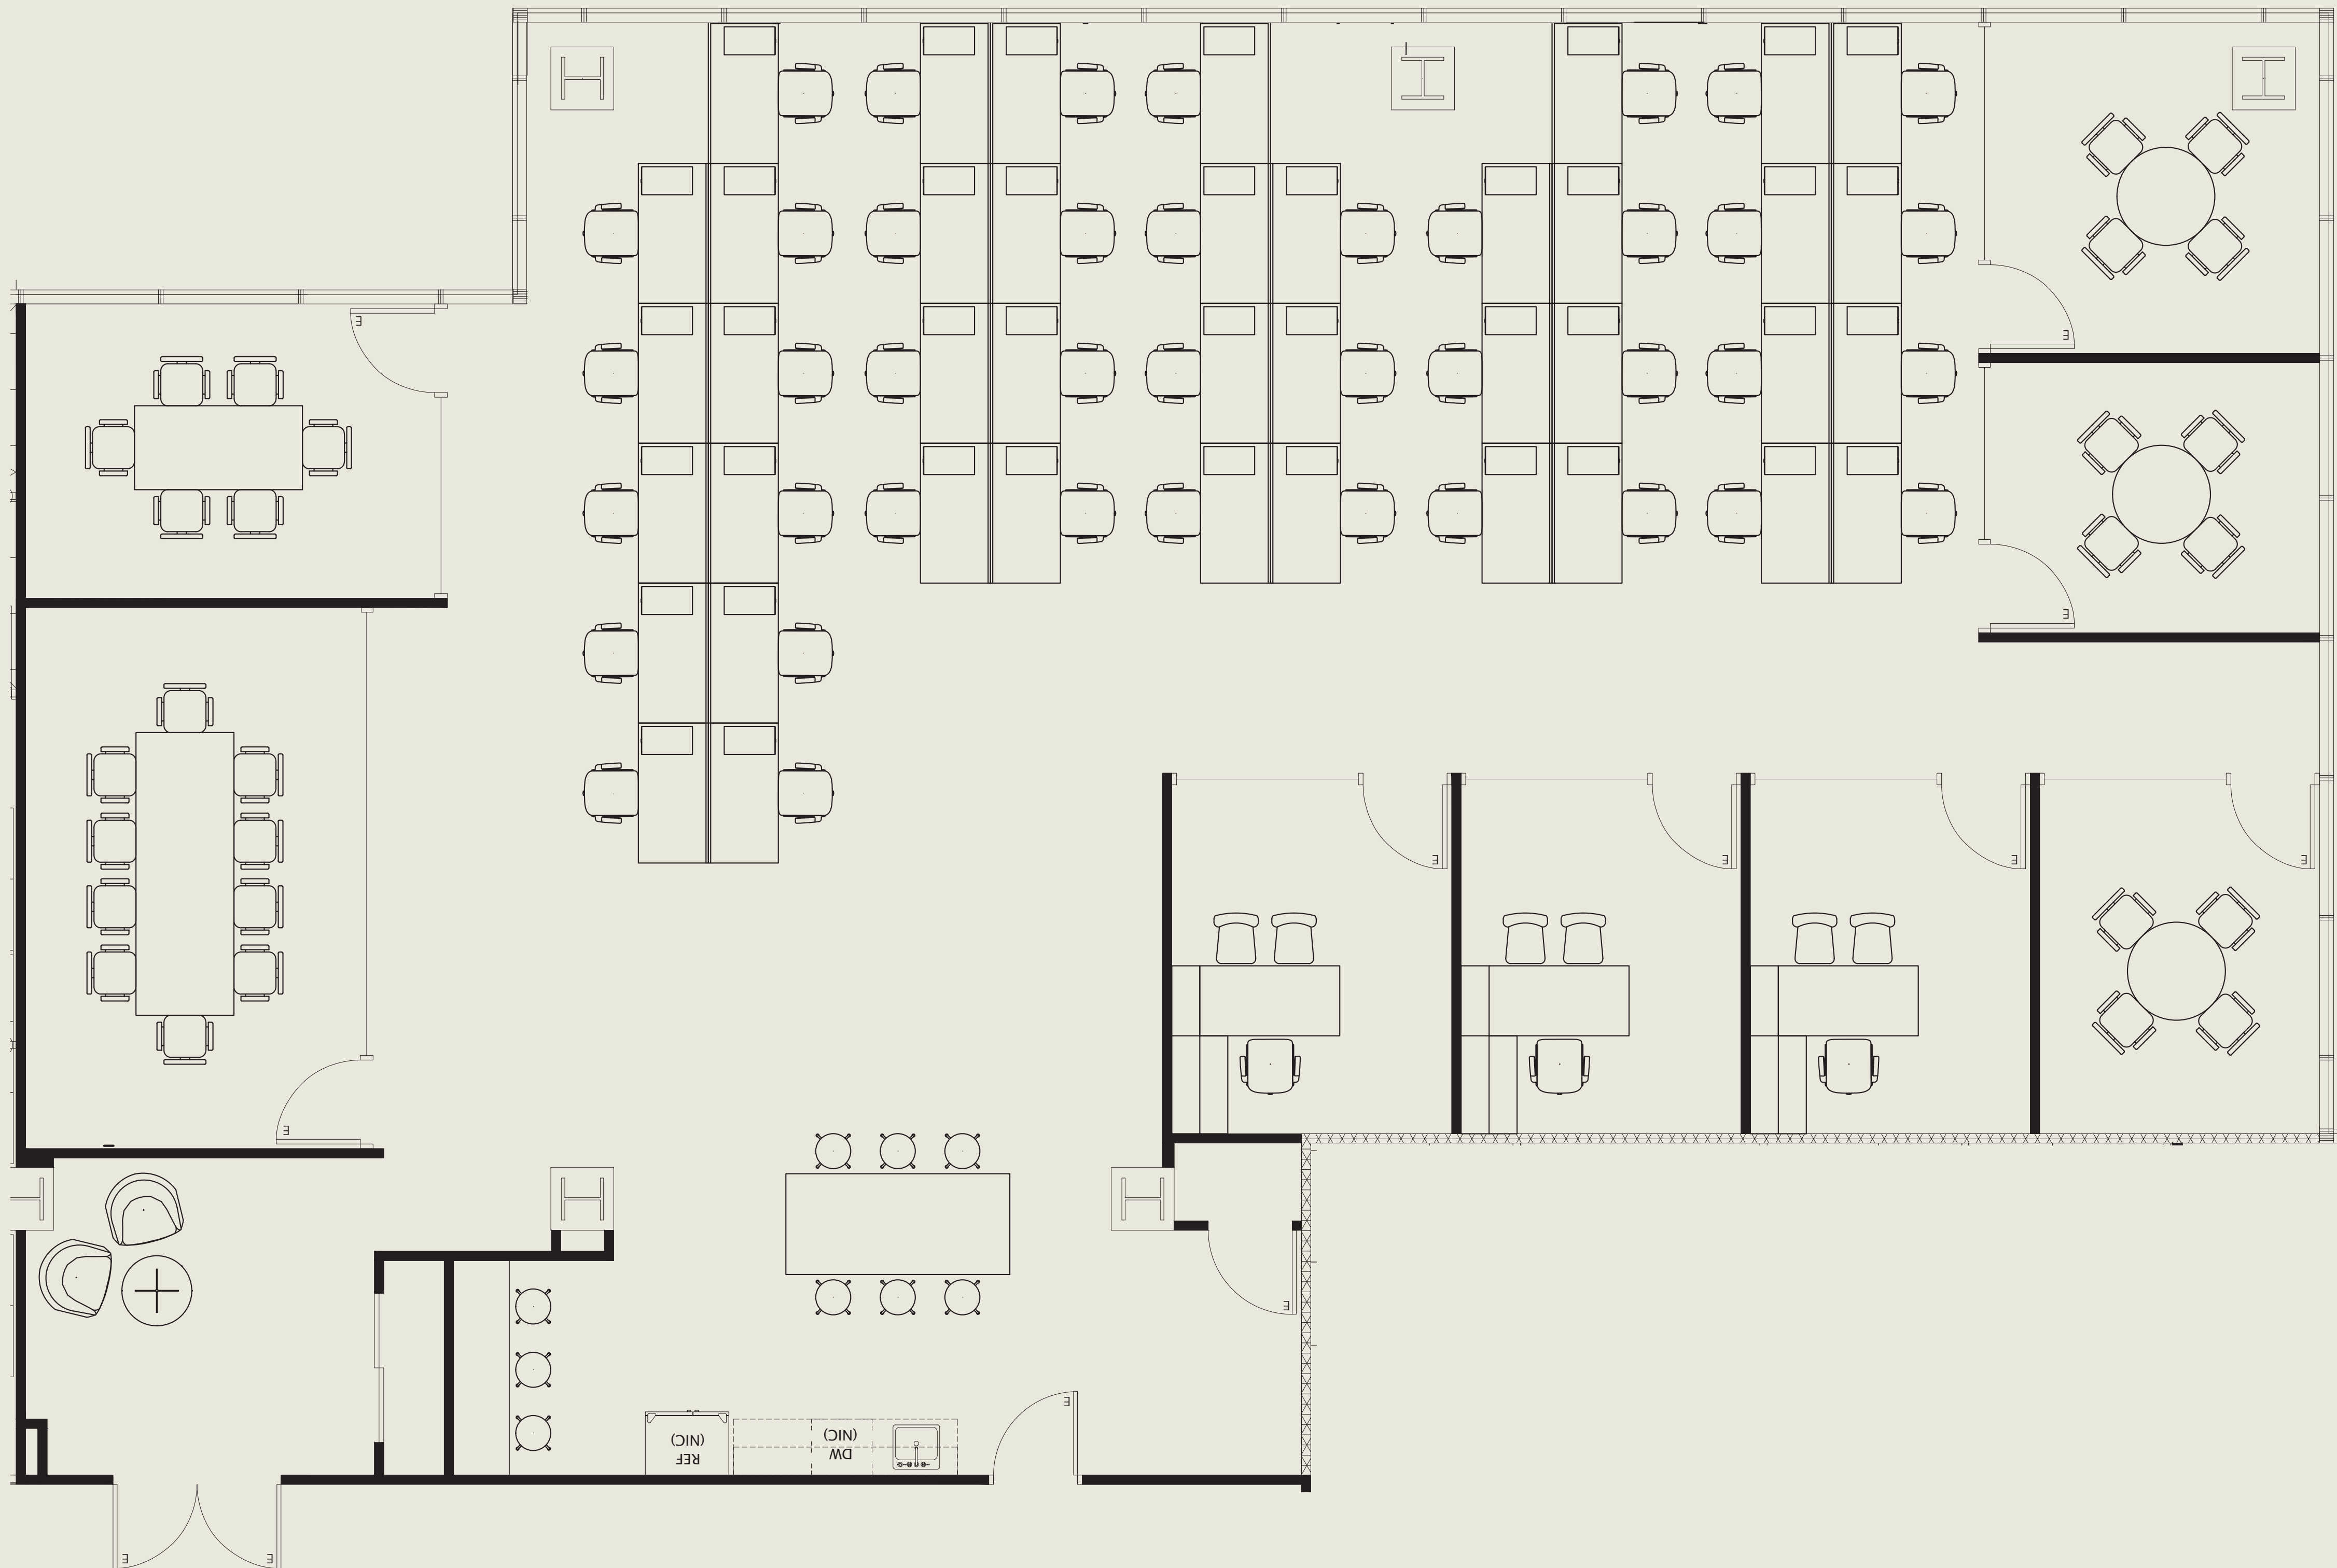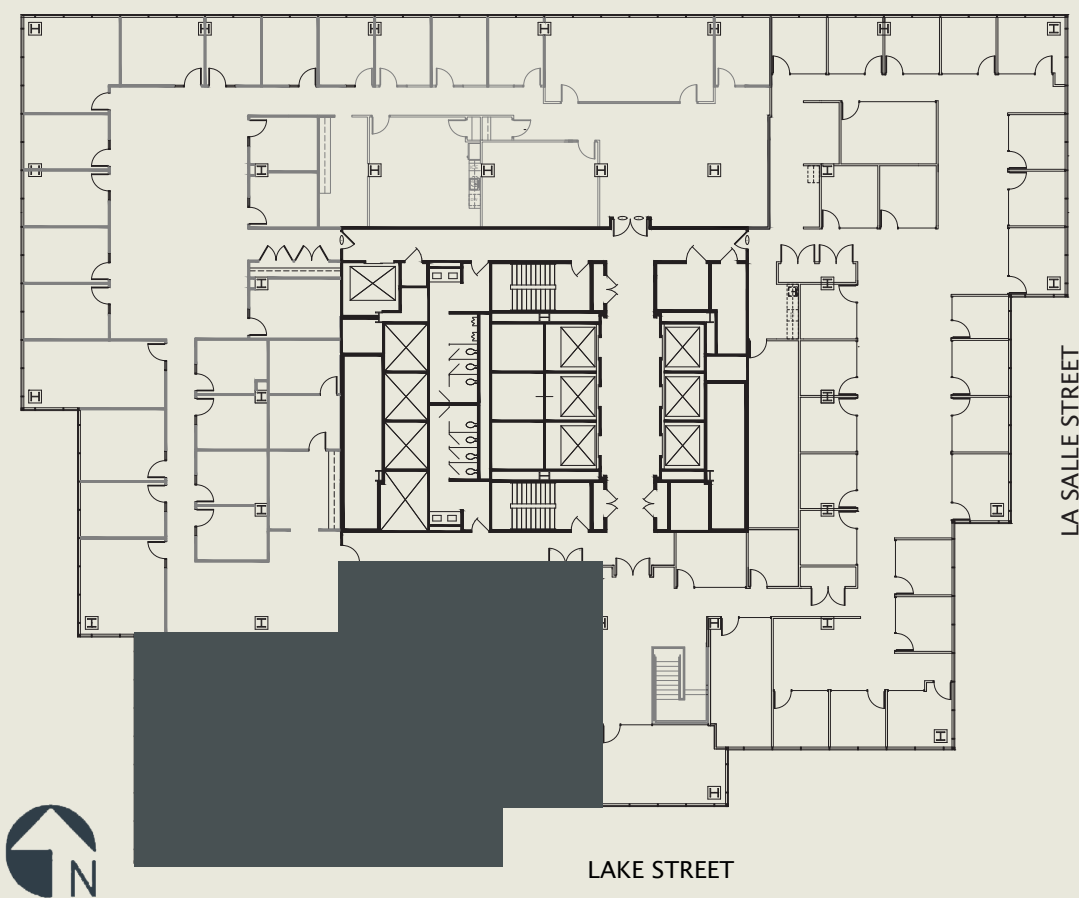

FOR LEASING INFORMATION PLEASE CONTACT:

MARK GUNDERSON  
312 448 8645 | mark.gunderson@streamrealty.com

BEN CLEVELAND  
312 448 6221 | ben.cleveland@streamrealty.com