

SUITE: 1650


RSF: 12,181

AS-BUILT CONFIGURATION

OFFICES.....	N/A
RECEPTION.....	N/A
CONFERENCE ROOMS.....	N/A
KITCHEN.....	N/A
OPEN WORK AREA.....	N/A

Not to scale, furniture and appliances not included

KEY PLAN

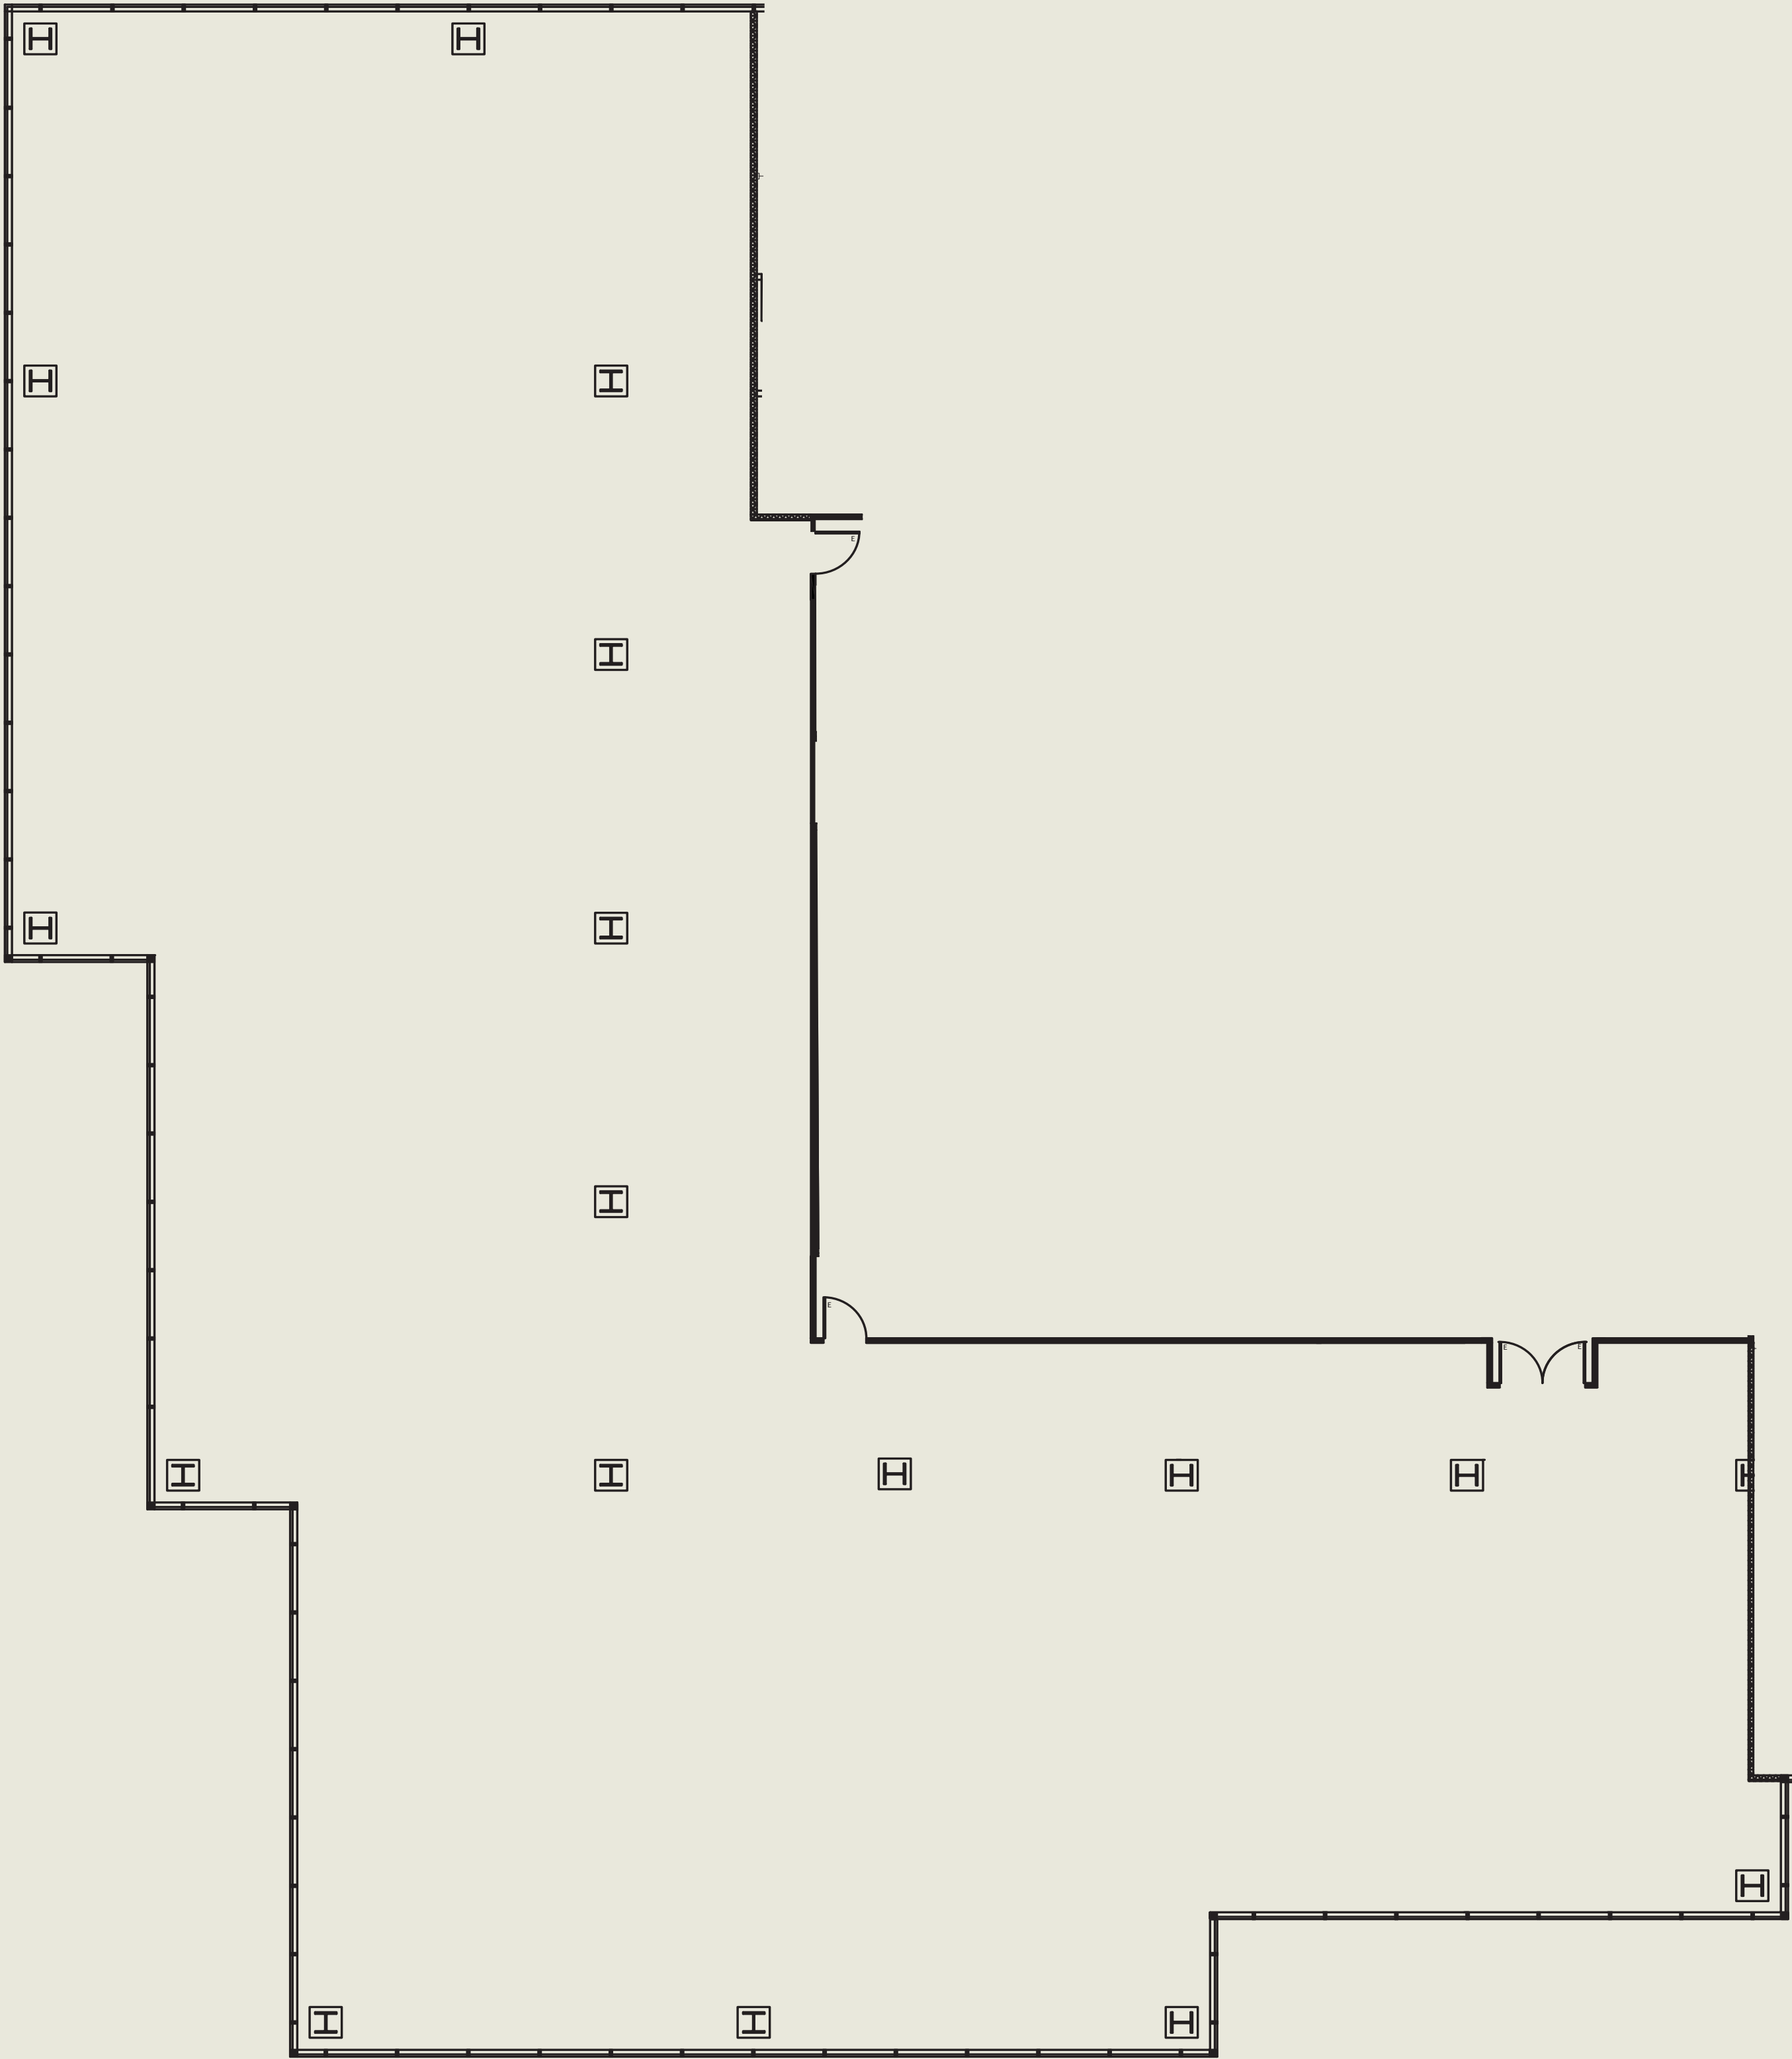

FOR LEASING INFORMATION PLEASE CONTACT:  
USALEASING@ONNI.COM  
(213) 629-2041