
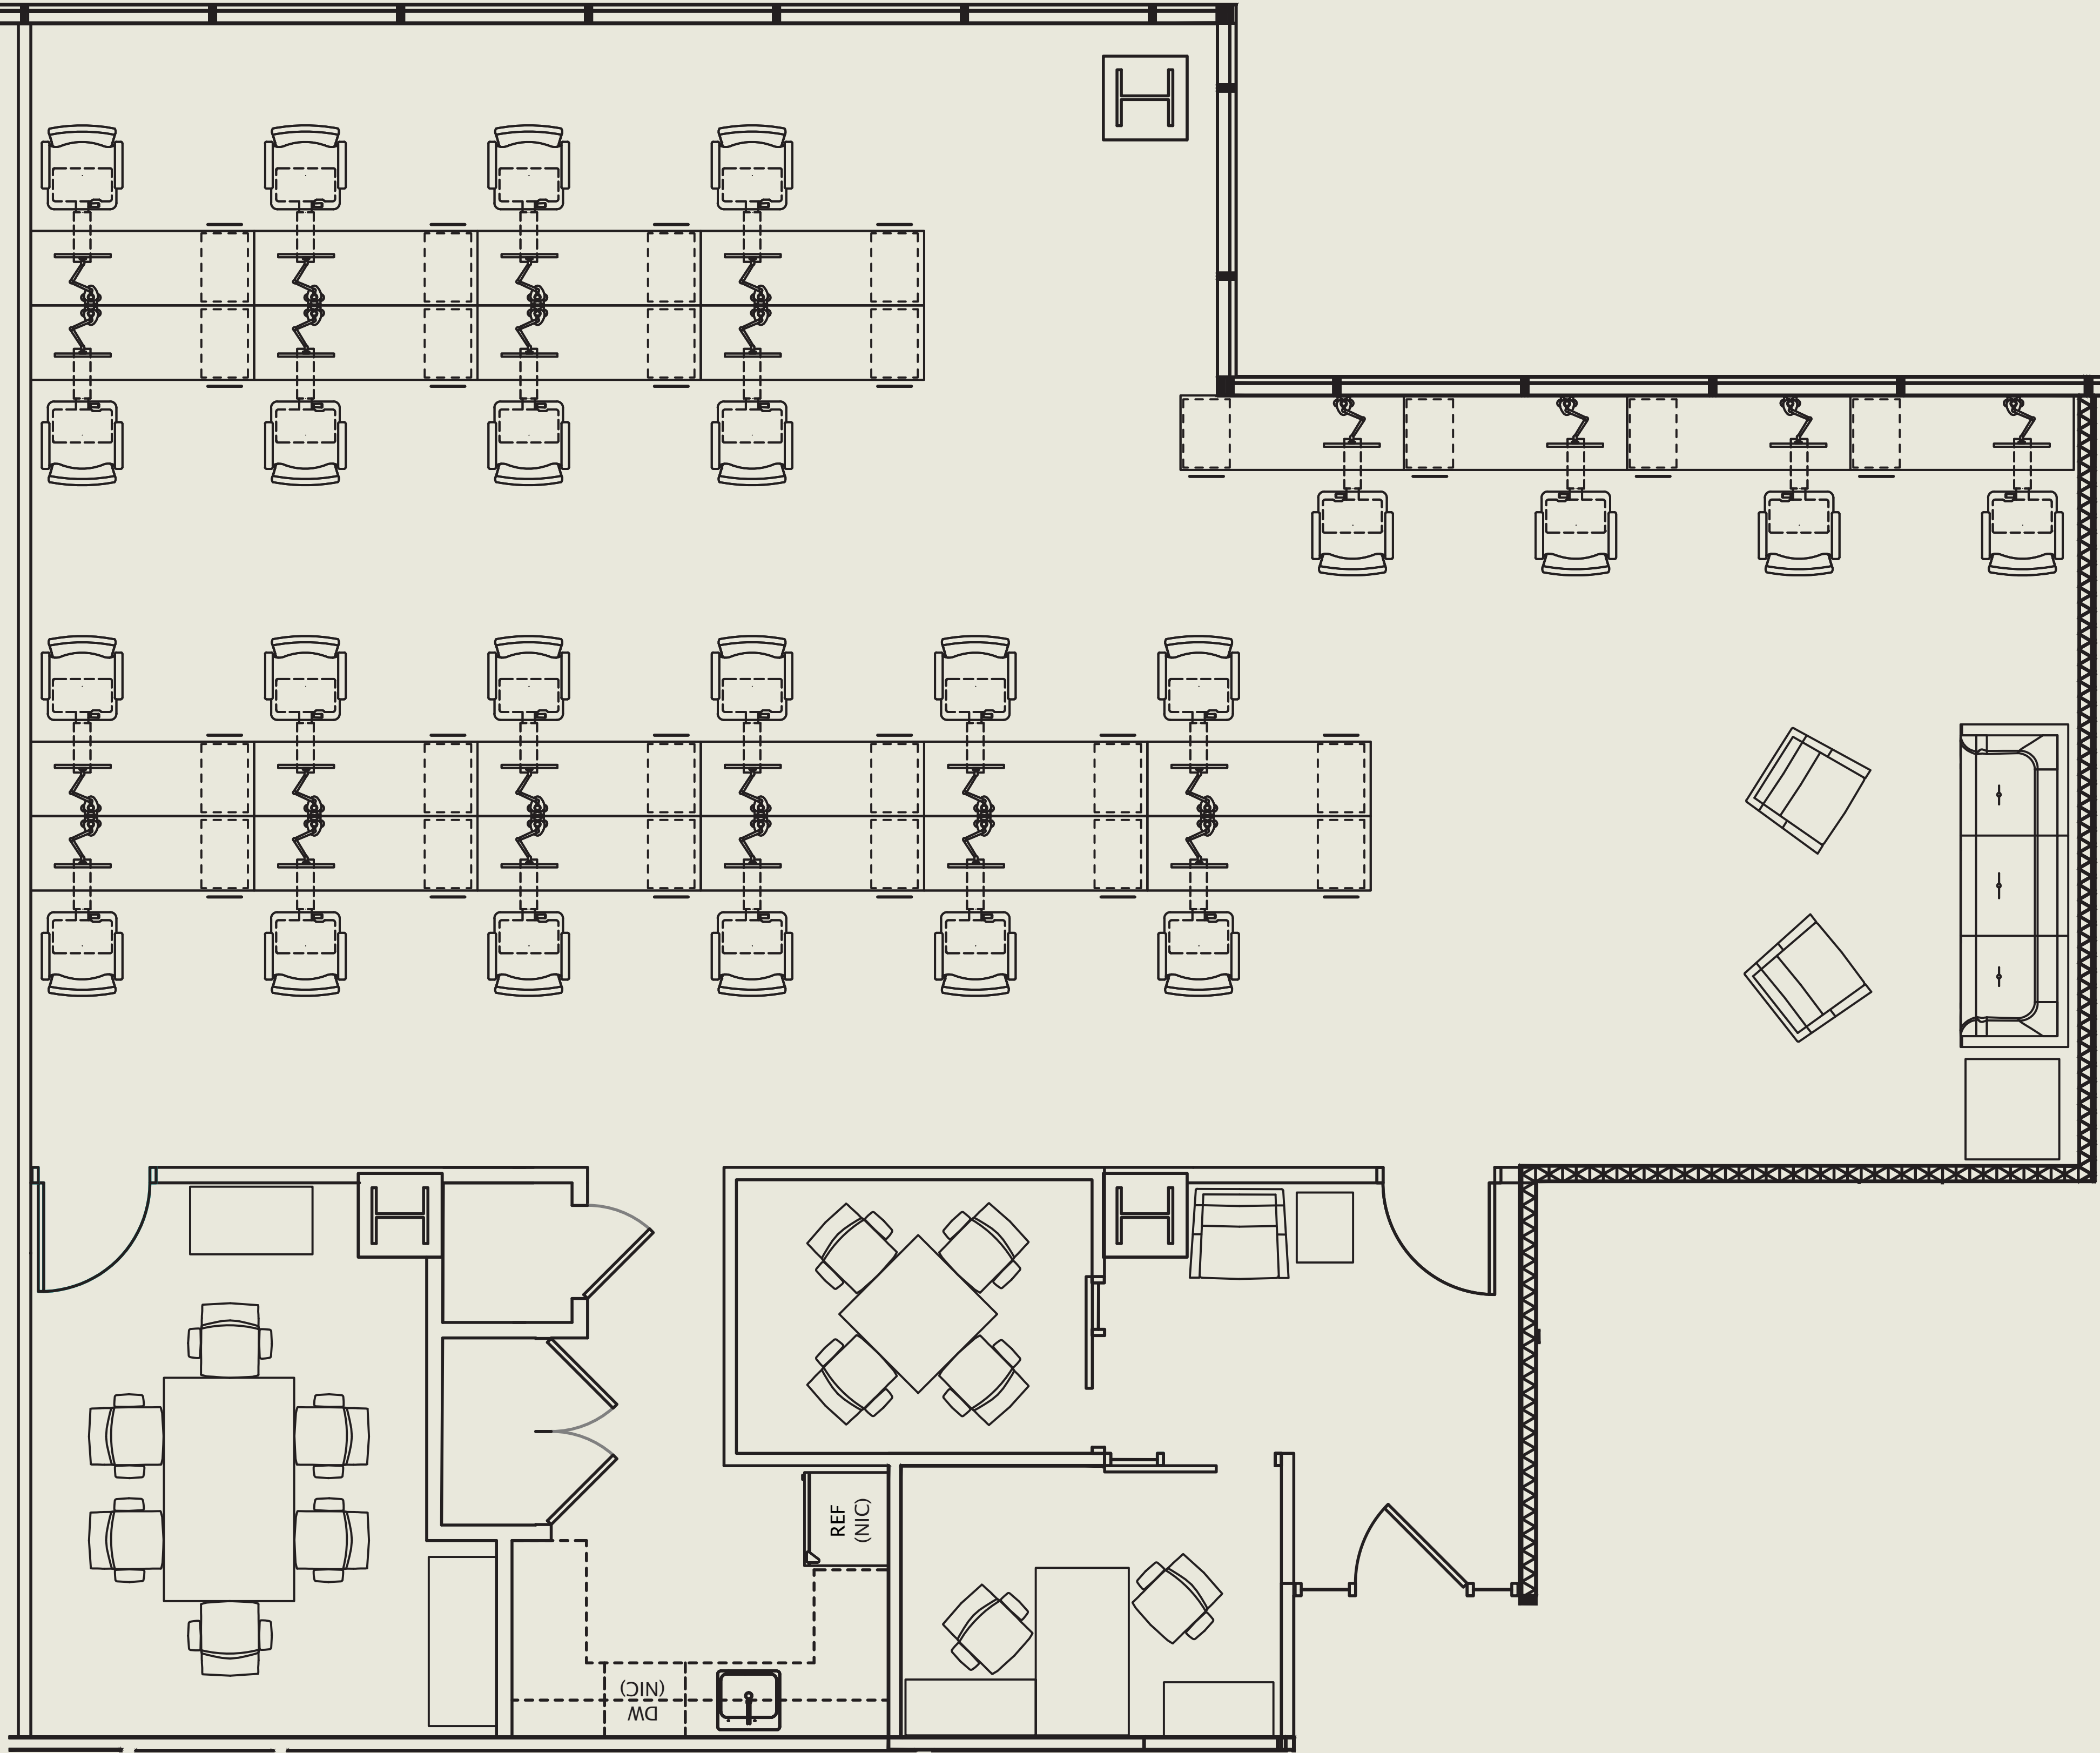


AS-BUILT CONFIGURATION

OFFICES.....	1
RECEPTION.....	1
CONFERENCE ROOMS.....	2
KITCHEN.....	1
OPEN WORK AREA.....	+/- 24

Not to scale, furniture and appliances not included

KEY PLAN

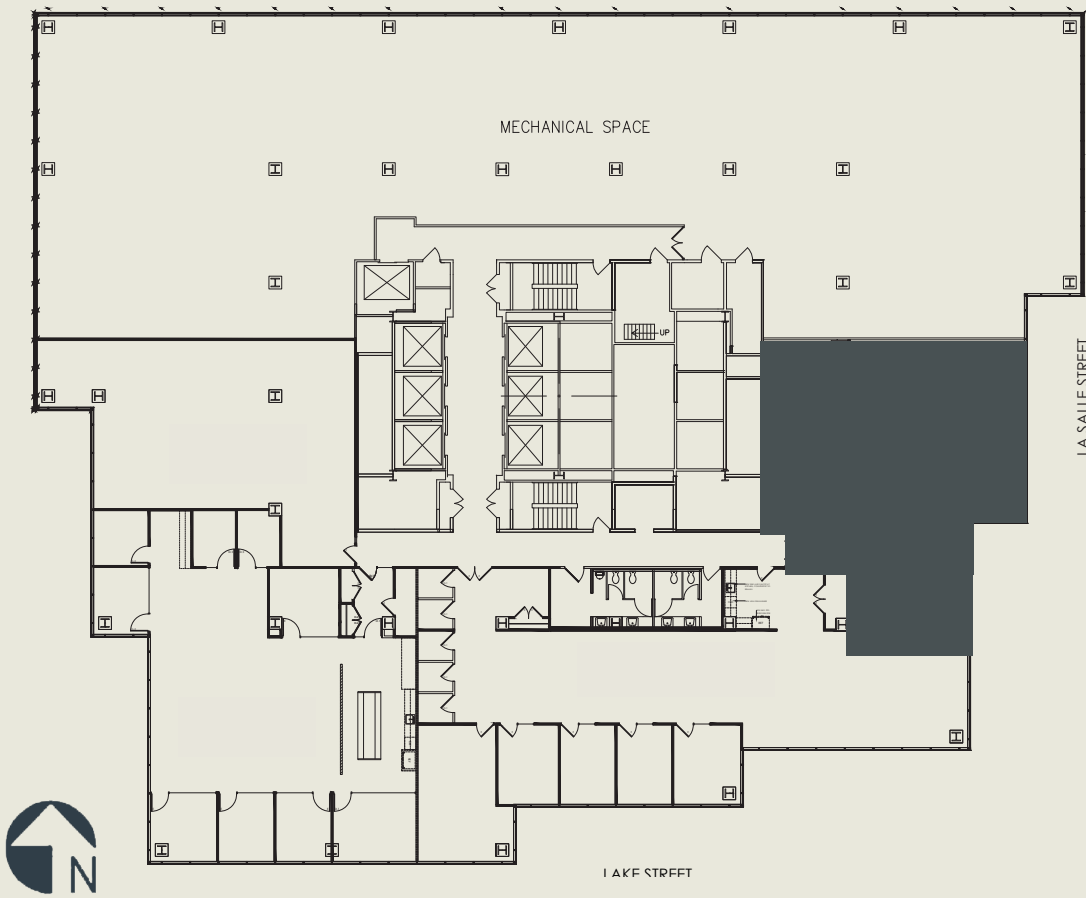

FOR LEASING INFORMATION PLEASE CONTACT:

MARK GUNDERSON
312 448 8645 | mark.gunderson@streamrealty.com

BEN CLEVELAND
312 448 6221 | ben.cleveland@streamrealty.com