
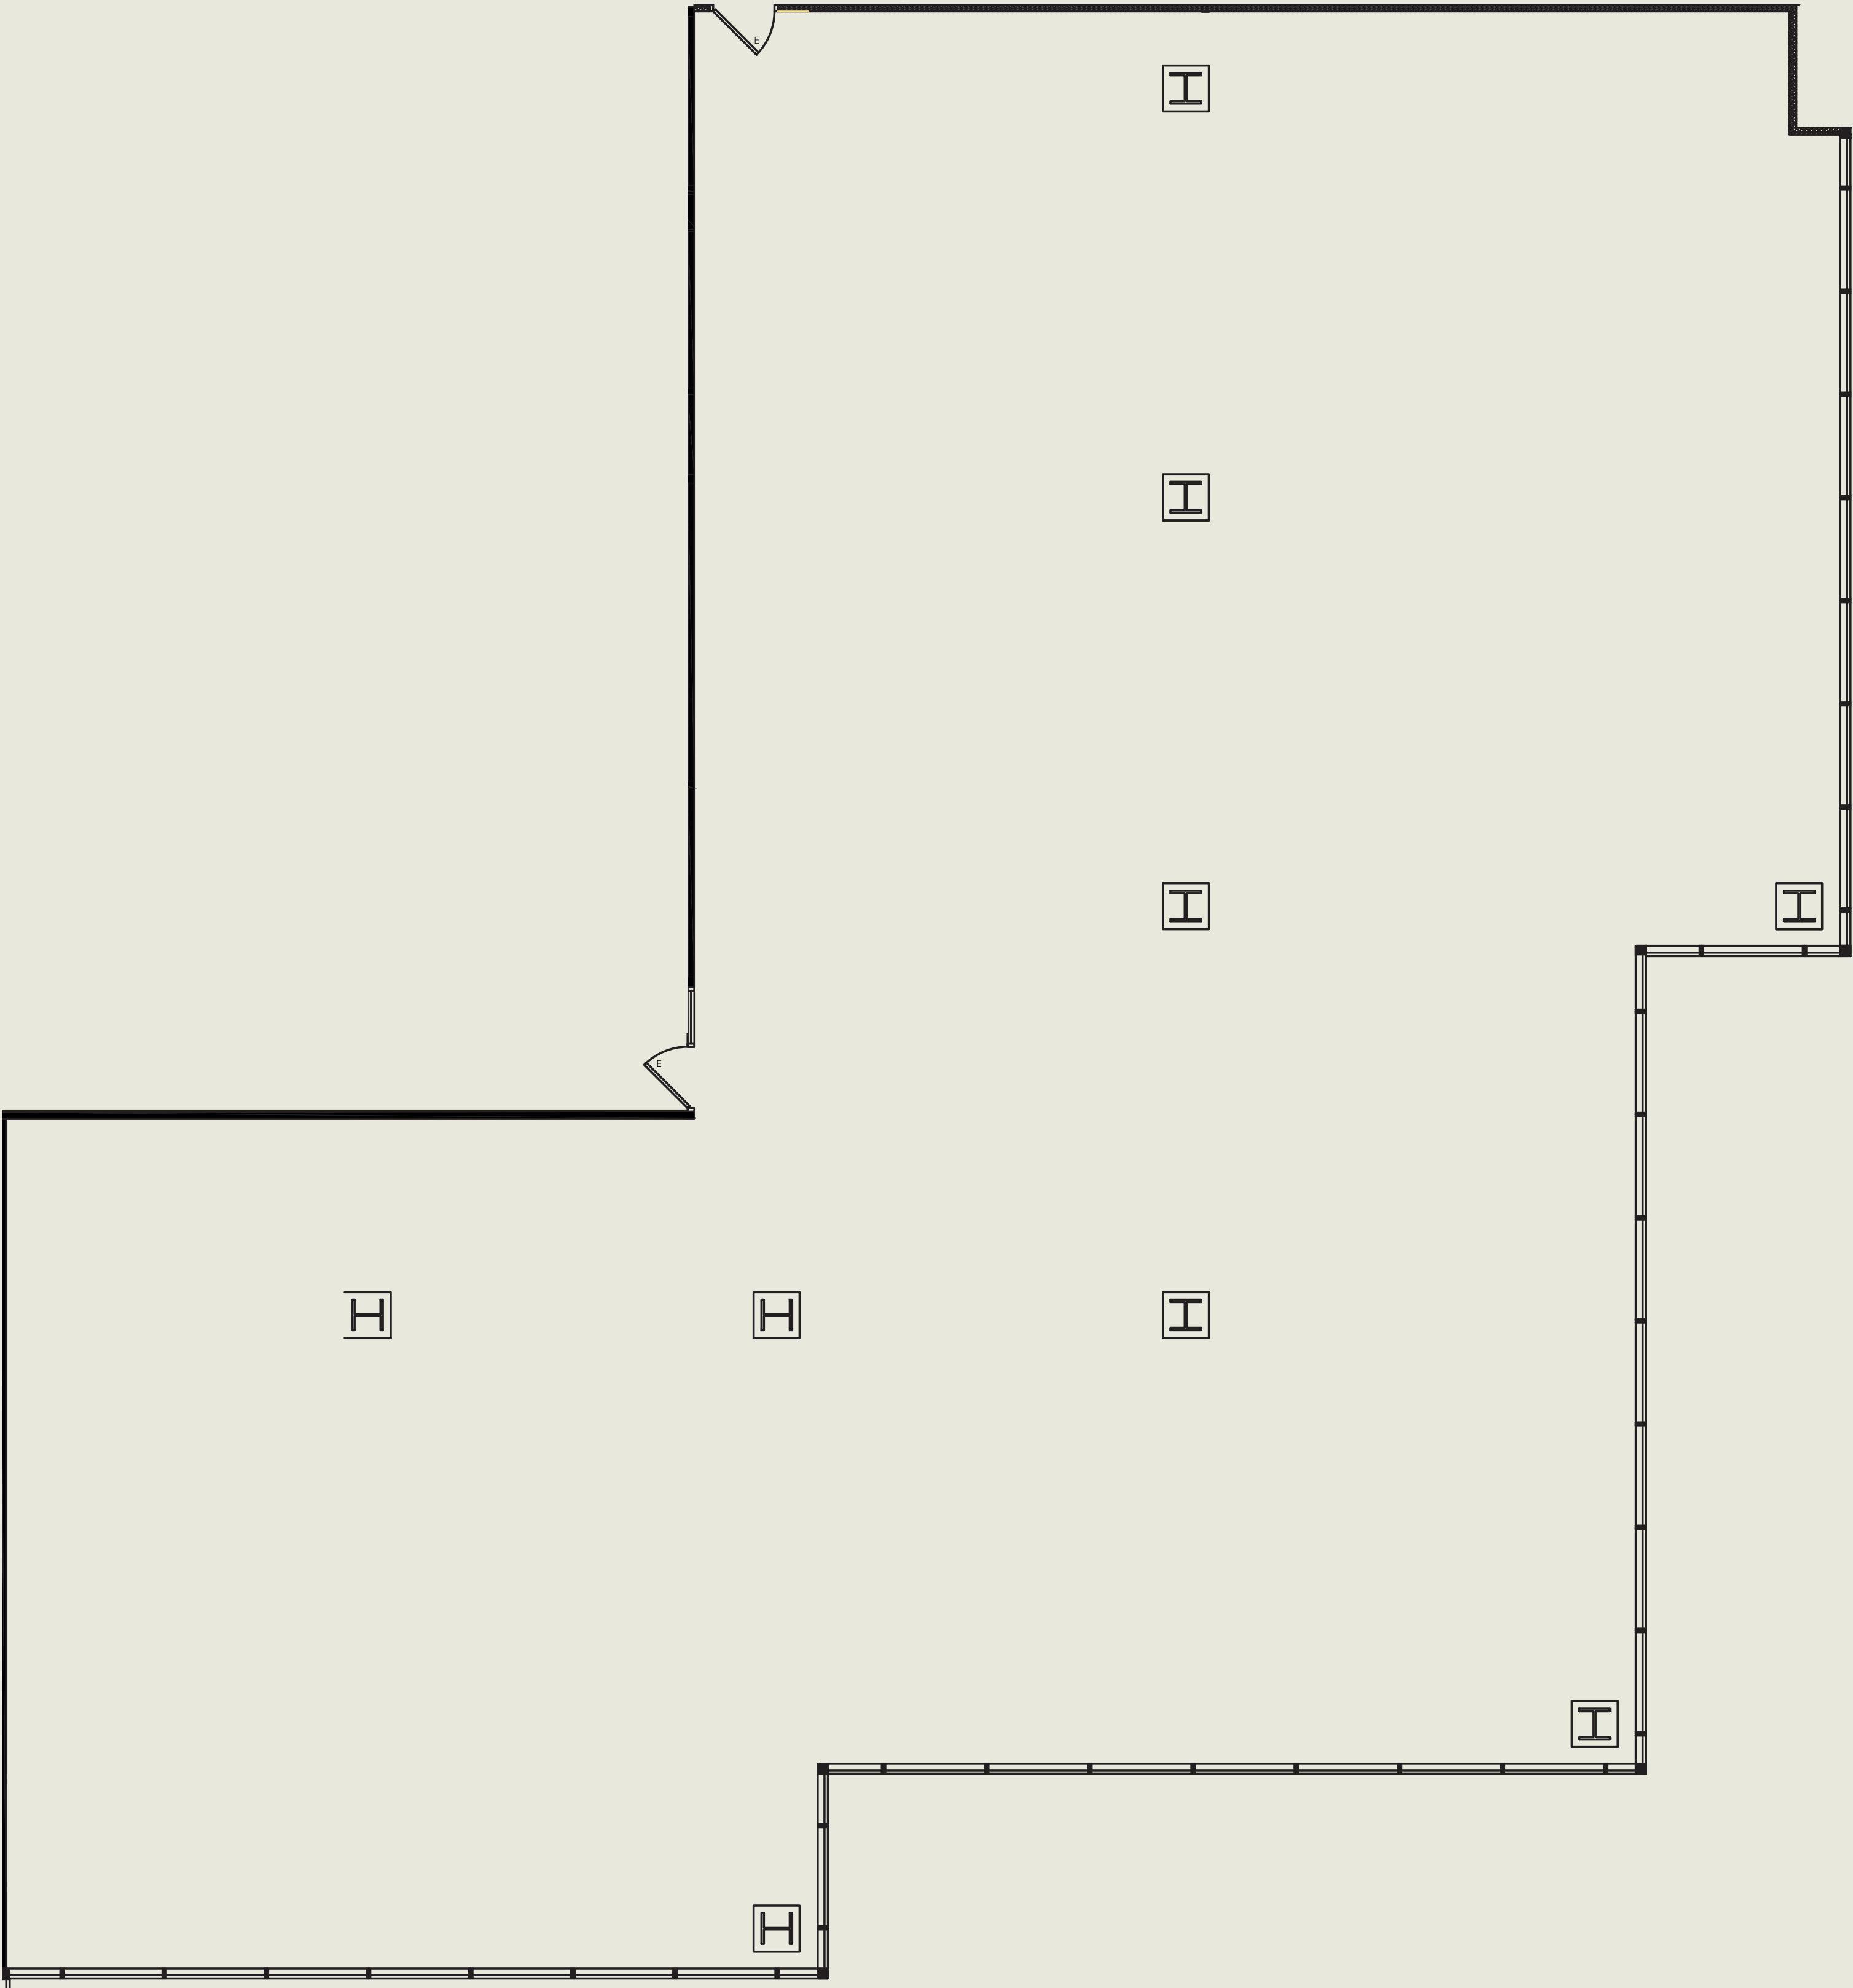


AS-BUILT CONFIGURATION

OFFICES.....	N/A
RECEPTION.....	N/A
CONFERENCE ROOMS.....	N/A
KITCHEN.....	N/A
OPEN WORK AREA.....	N/A

Not to scale, furniture and appliances not included

KEY PLAN

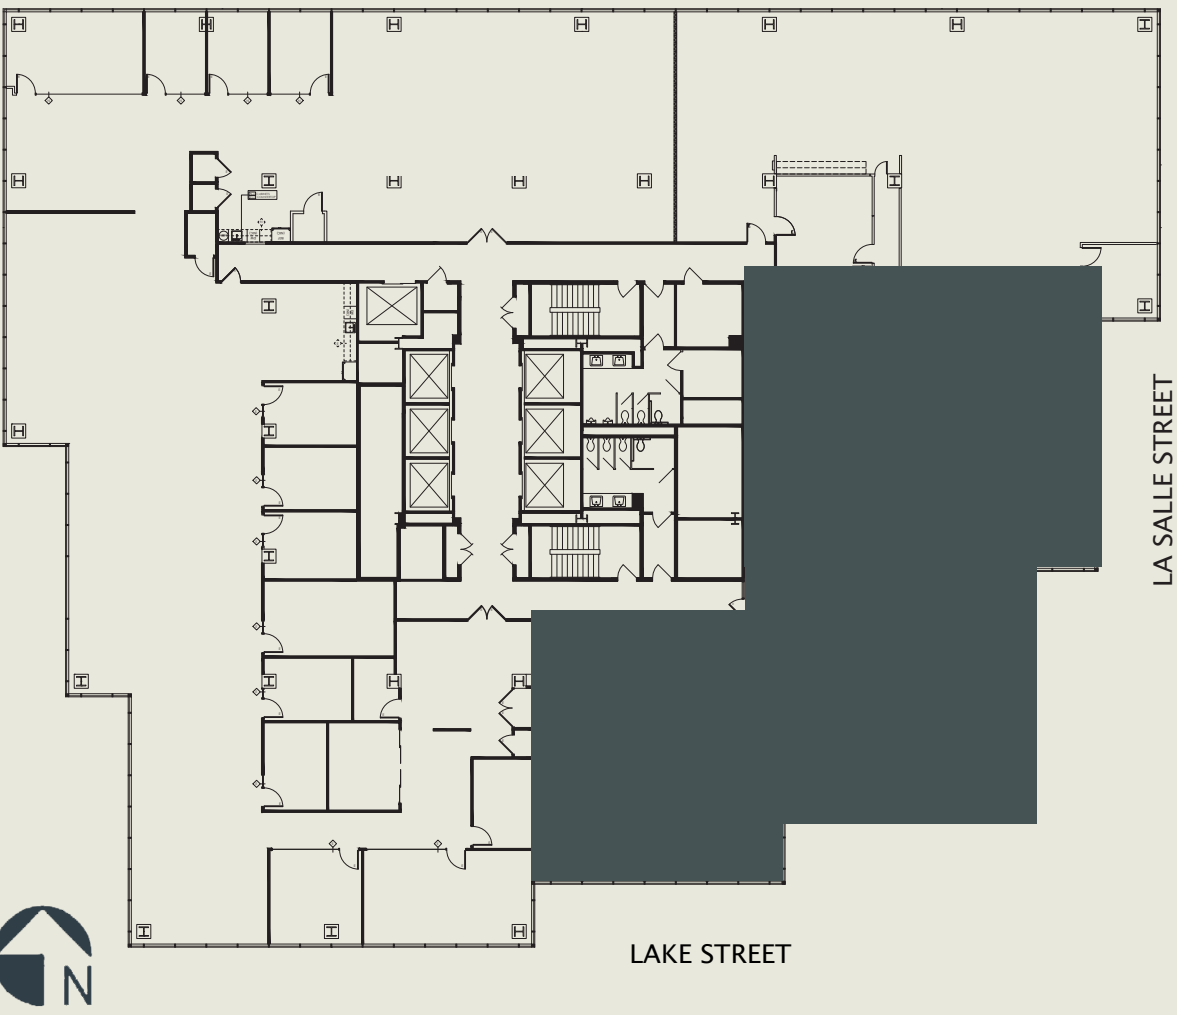

For leasing information please contact:  
Mark J. Gunderson  
312.448.8645 | mark.gunderson@streamrealty.com

Ben Cleveland  
312 448.6221 | ben.cleveland@streamrealty.com