

SUITE: 2550



RSF: 7,511

AS-BUILT CONFIGURATION

OFFICES.....	2
RECEPTION.....	1
CONFERENCE ROOMS.....	5
KITCHEN.....	1
OPEN WORK AREA.....	+/- 53

Not to scale, furniture and appliances not included

KEY PLAN

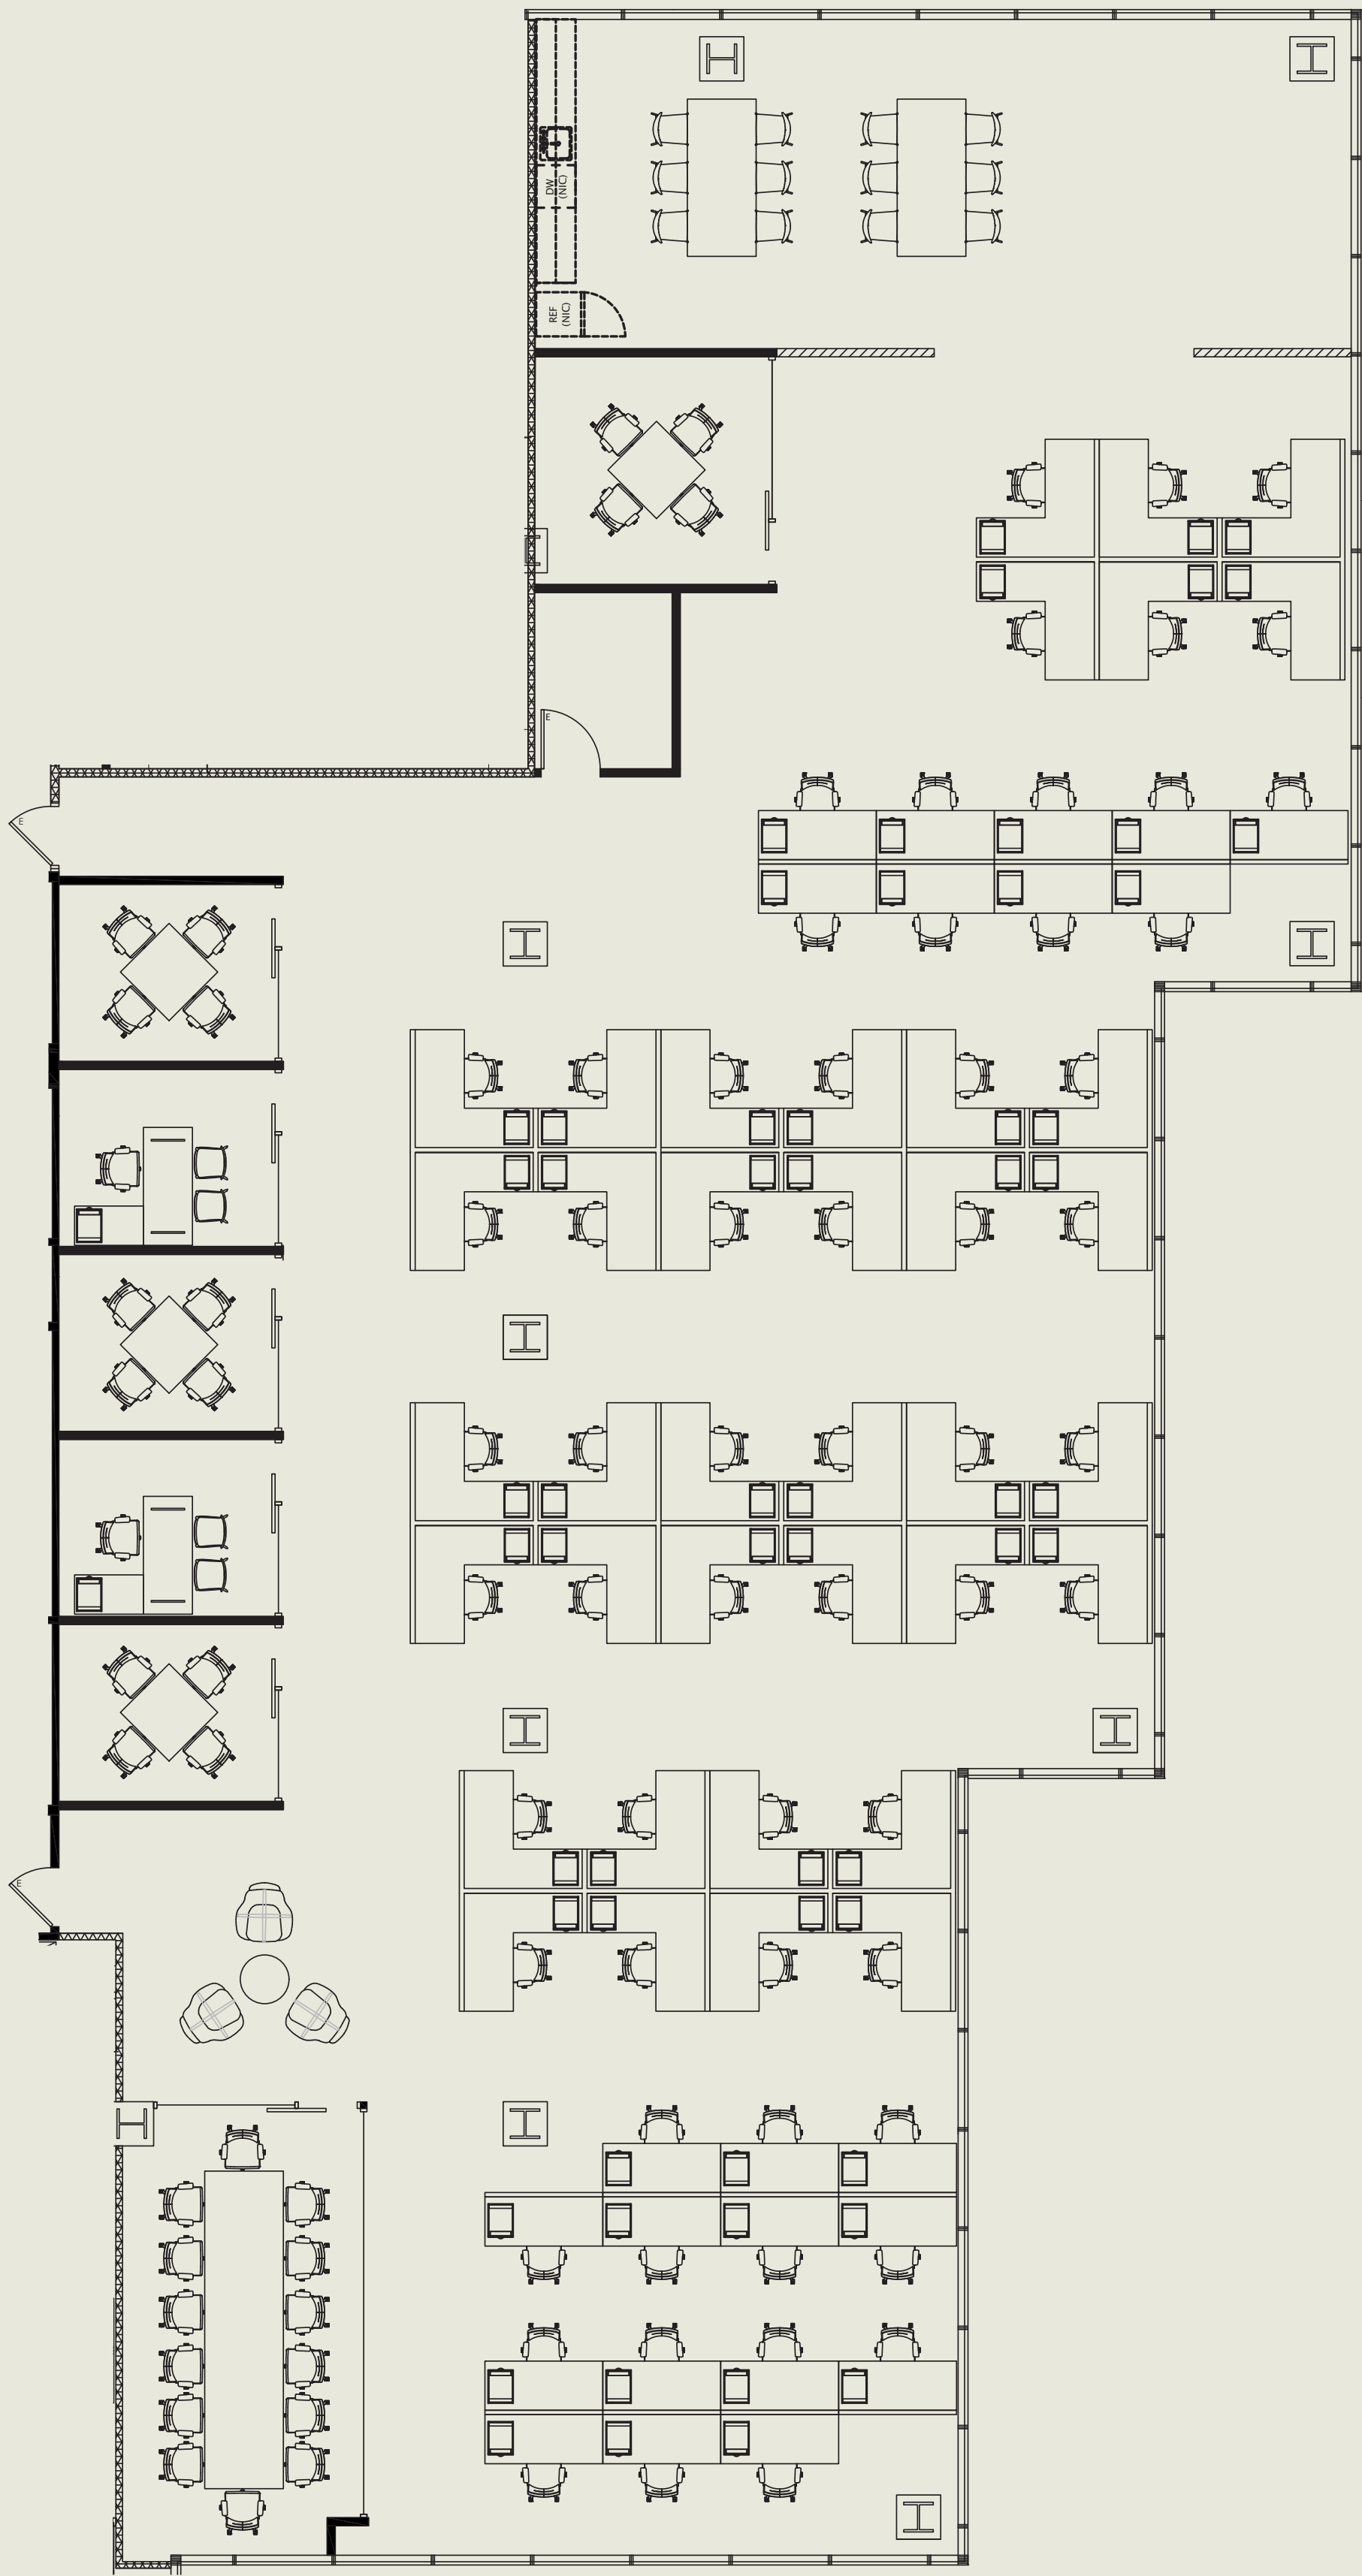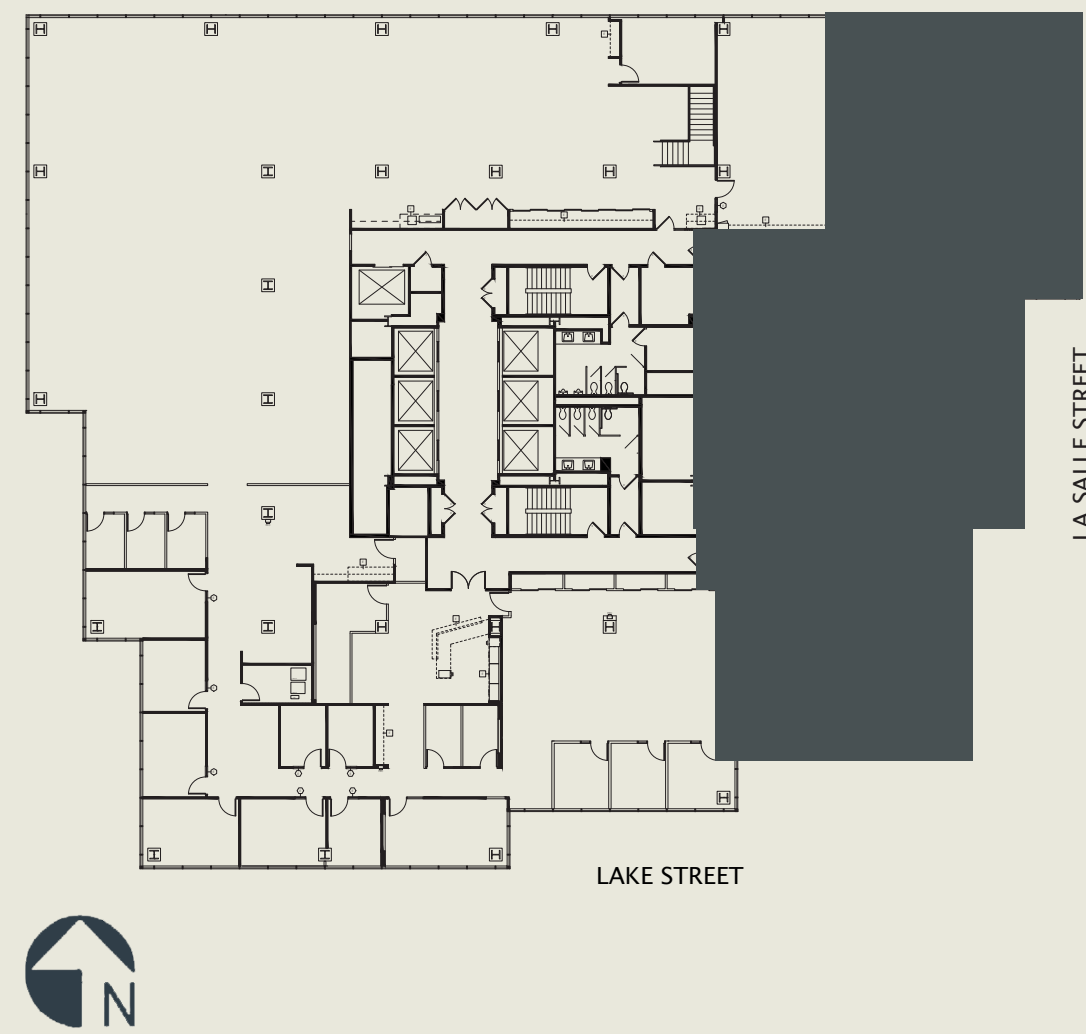

FOR LEASING INFORMATION PLEASE CONTACT:
USALEASING@ONNI.COM
(213) 629-2041