
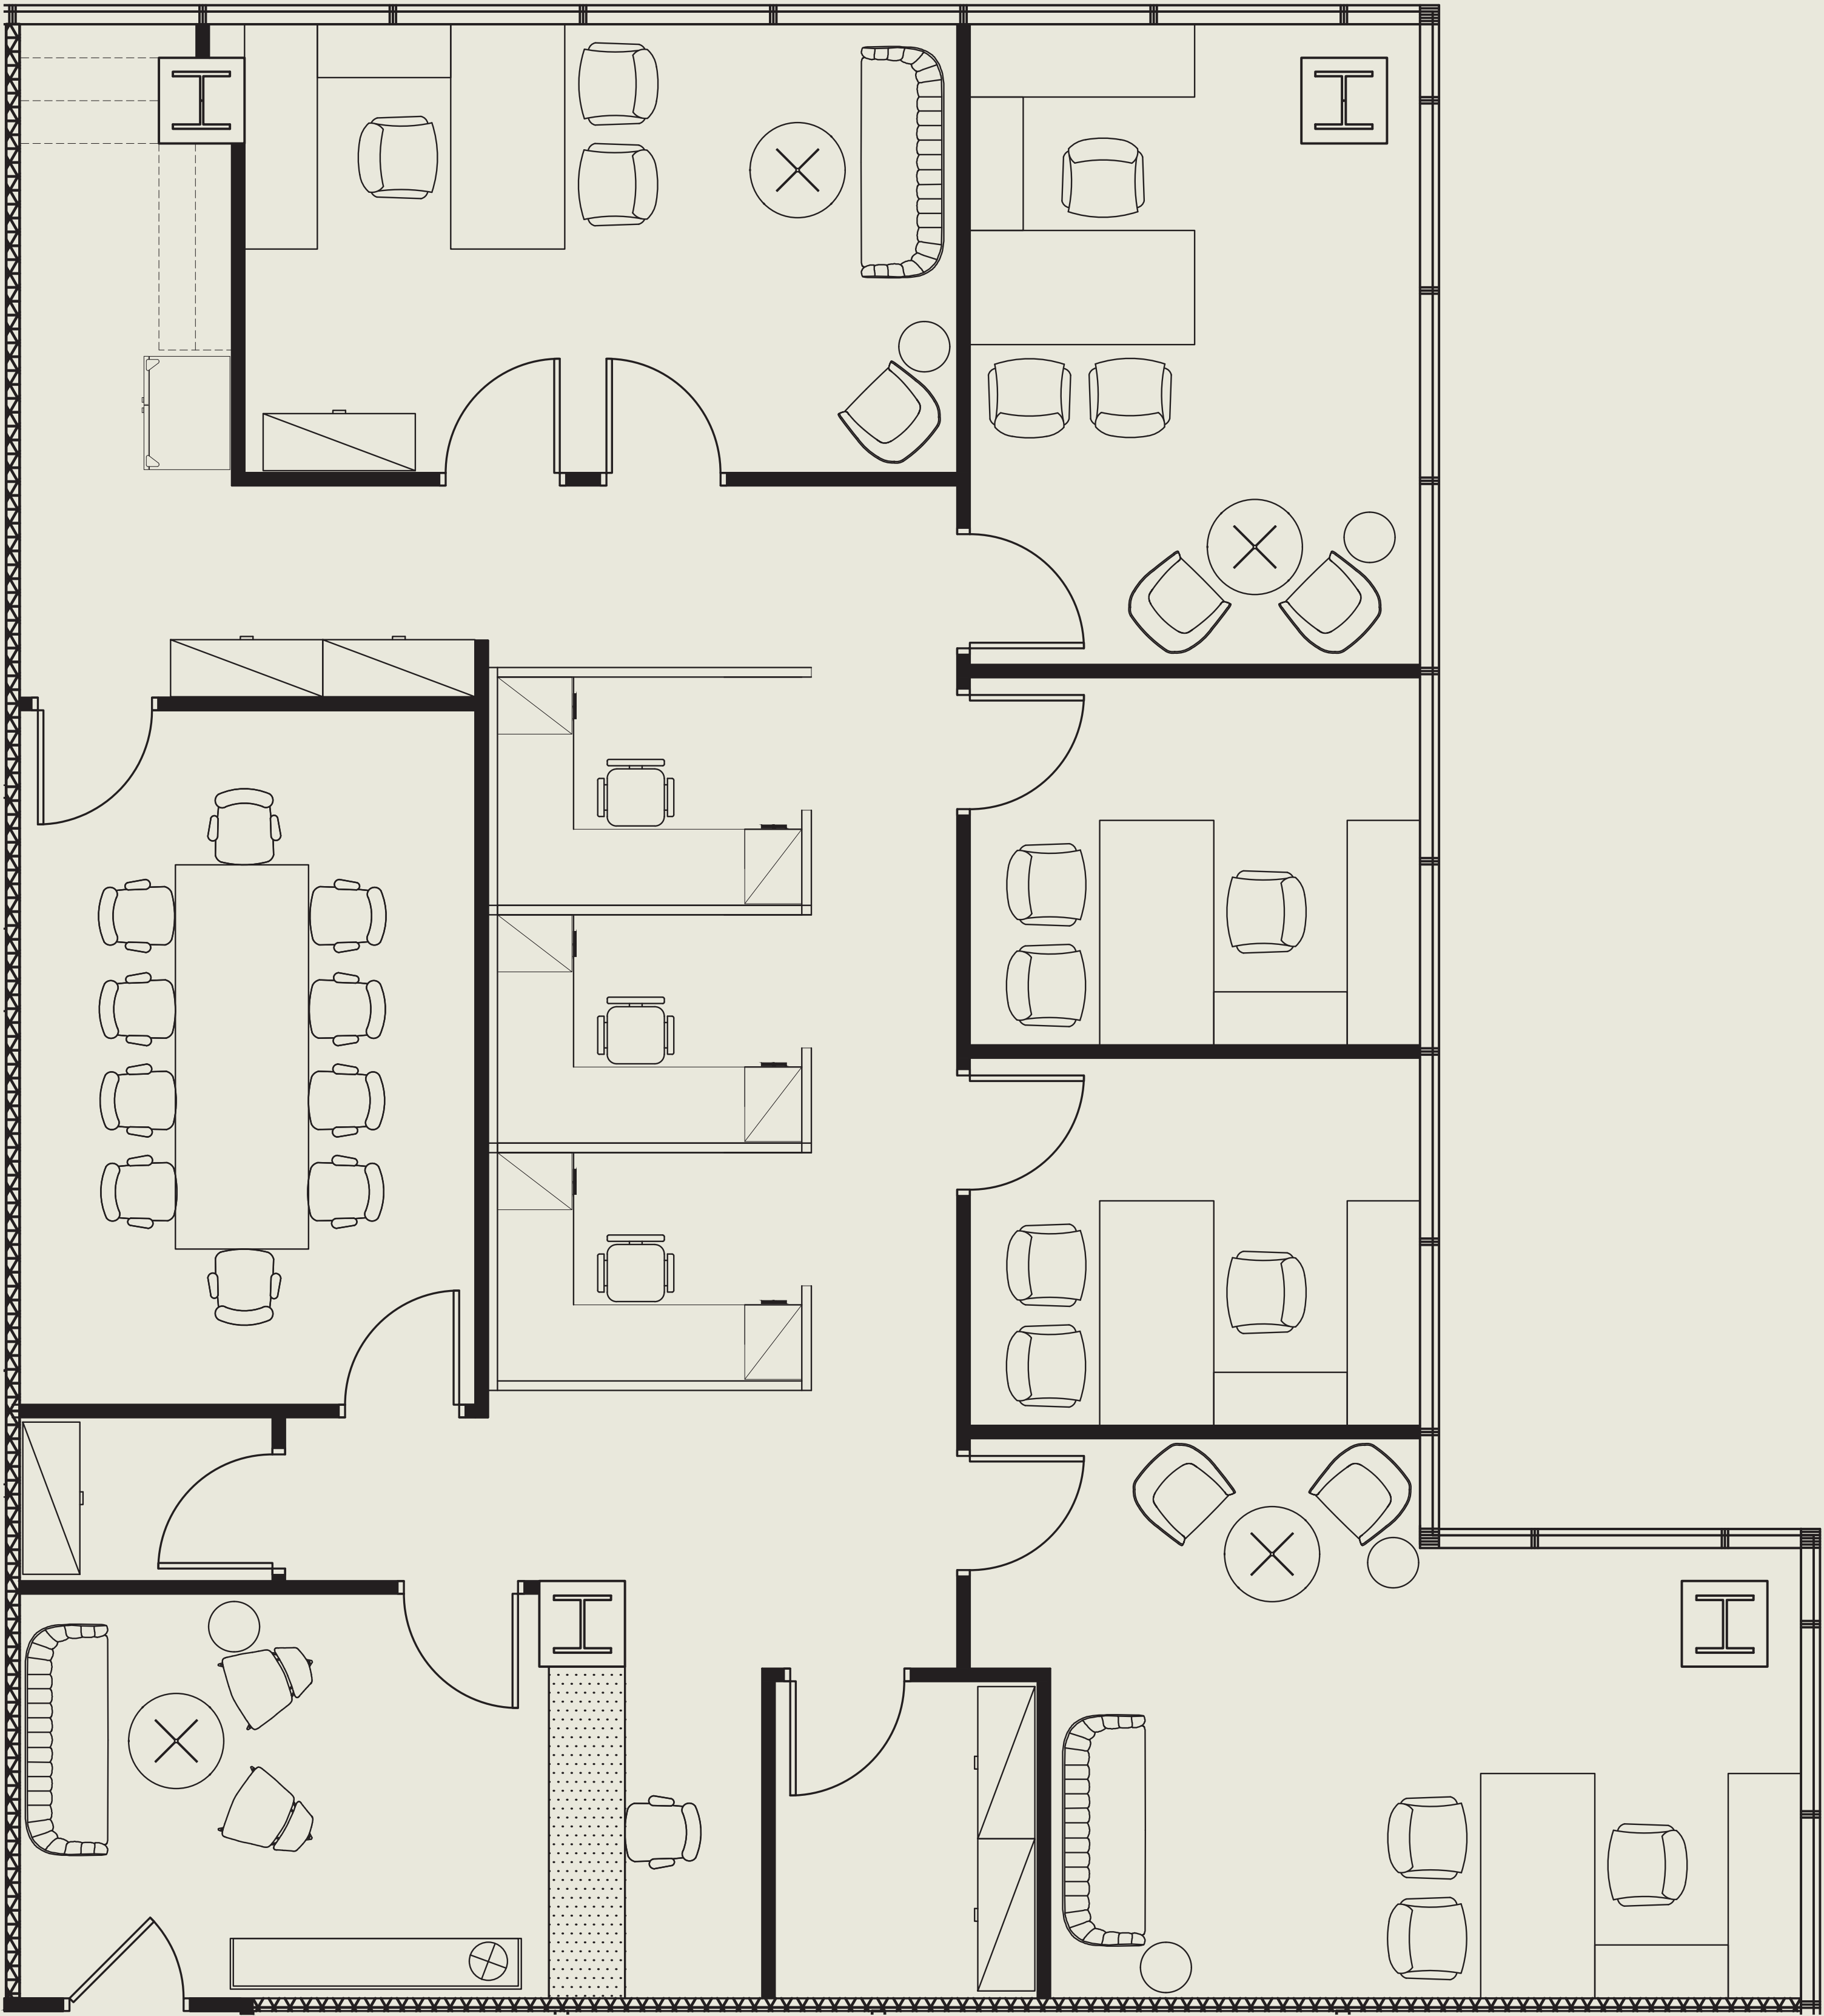


AS-BUILT CONFIGURATION

OFFICES.....	5
RECEPTION.....	1
CONFERENCE ROOMS.....	1
KITCHEN.....	1
OPEN WORK AREA.....	+/- 3

Not to scale, furniture and appliances not included

KEY PLAN

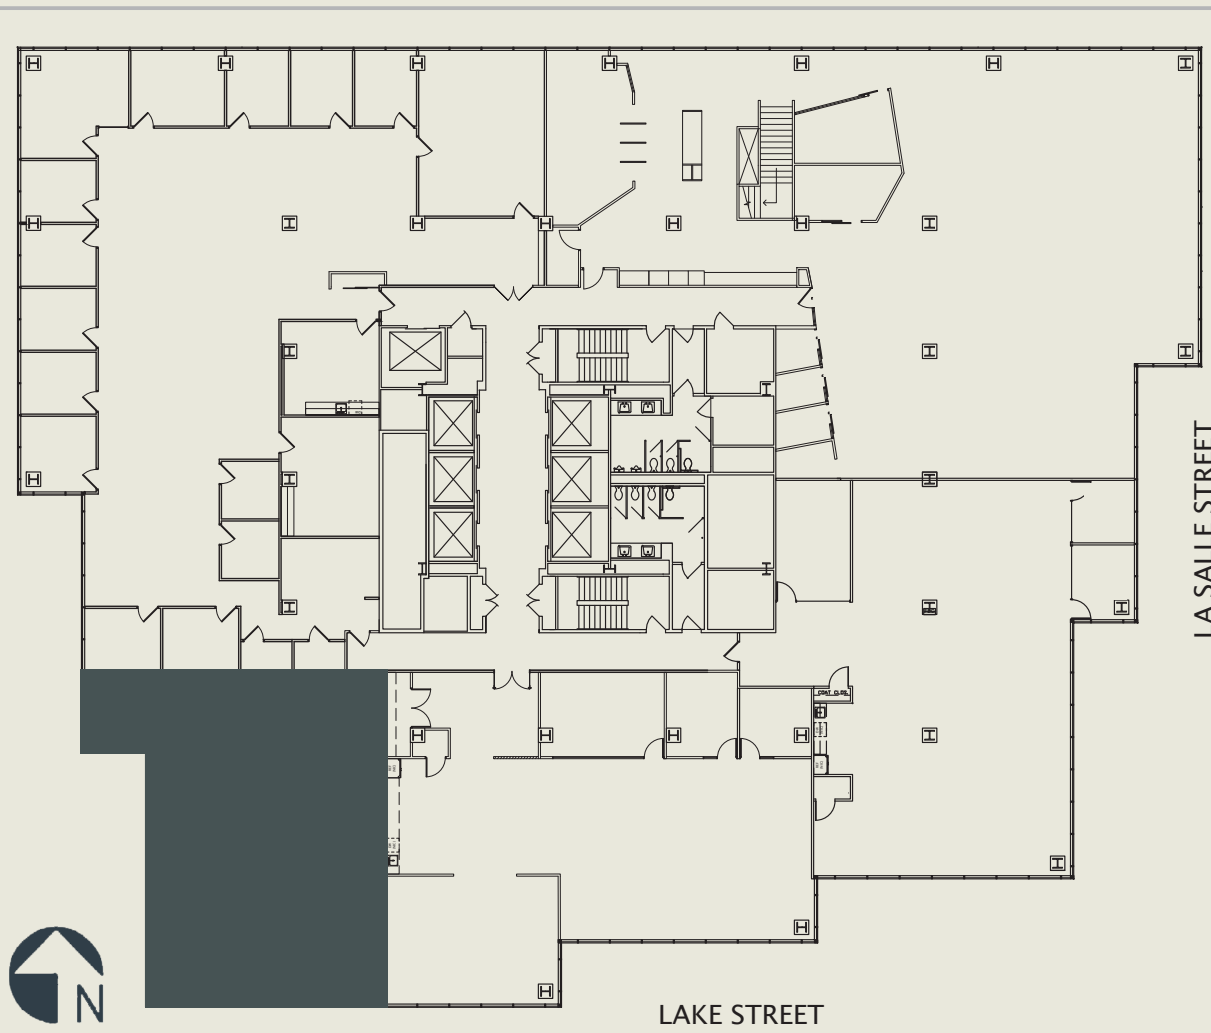

For leasing information please contact:
Mark J. Gunderson
312.448.8645 | mark.gunderson@streamrealty.com

Ben Cleveland
312 448.6221 | ben.cleveland@streamrealty.com