
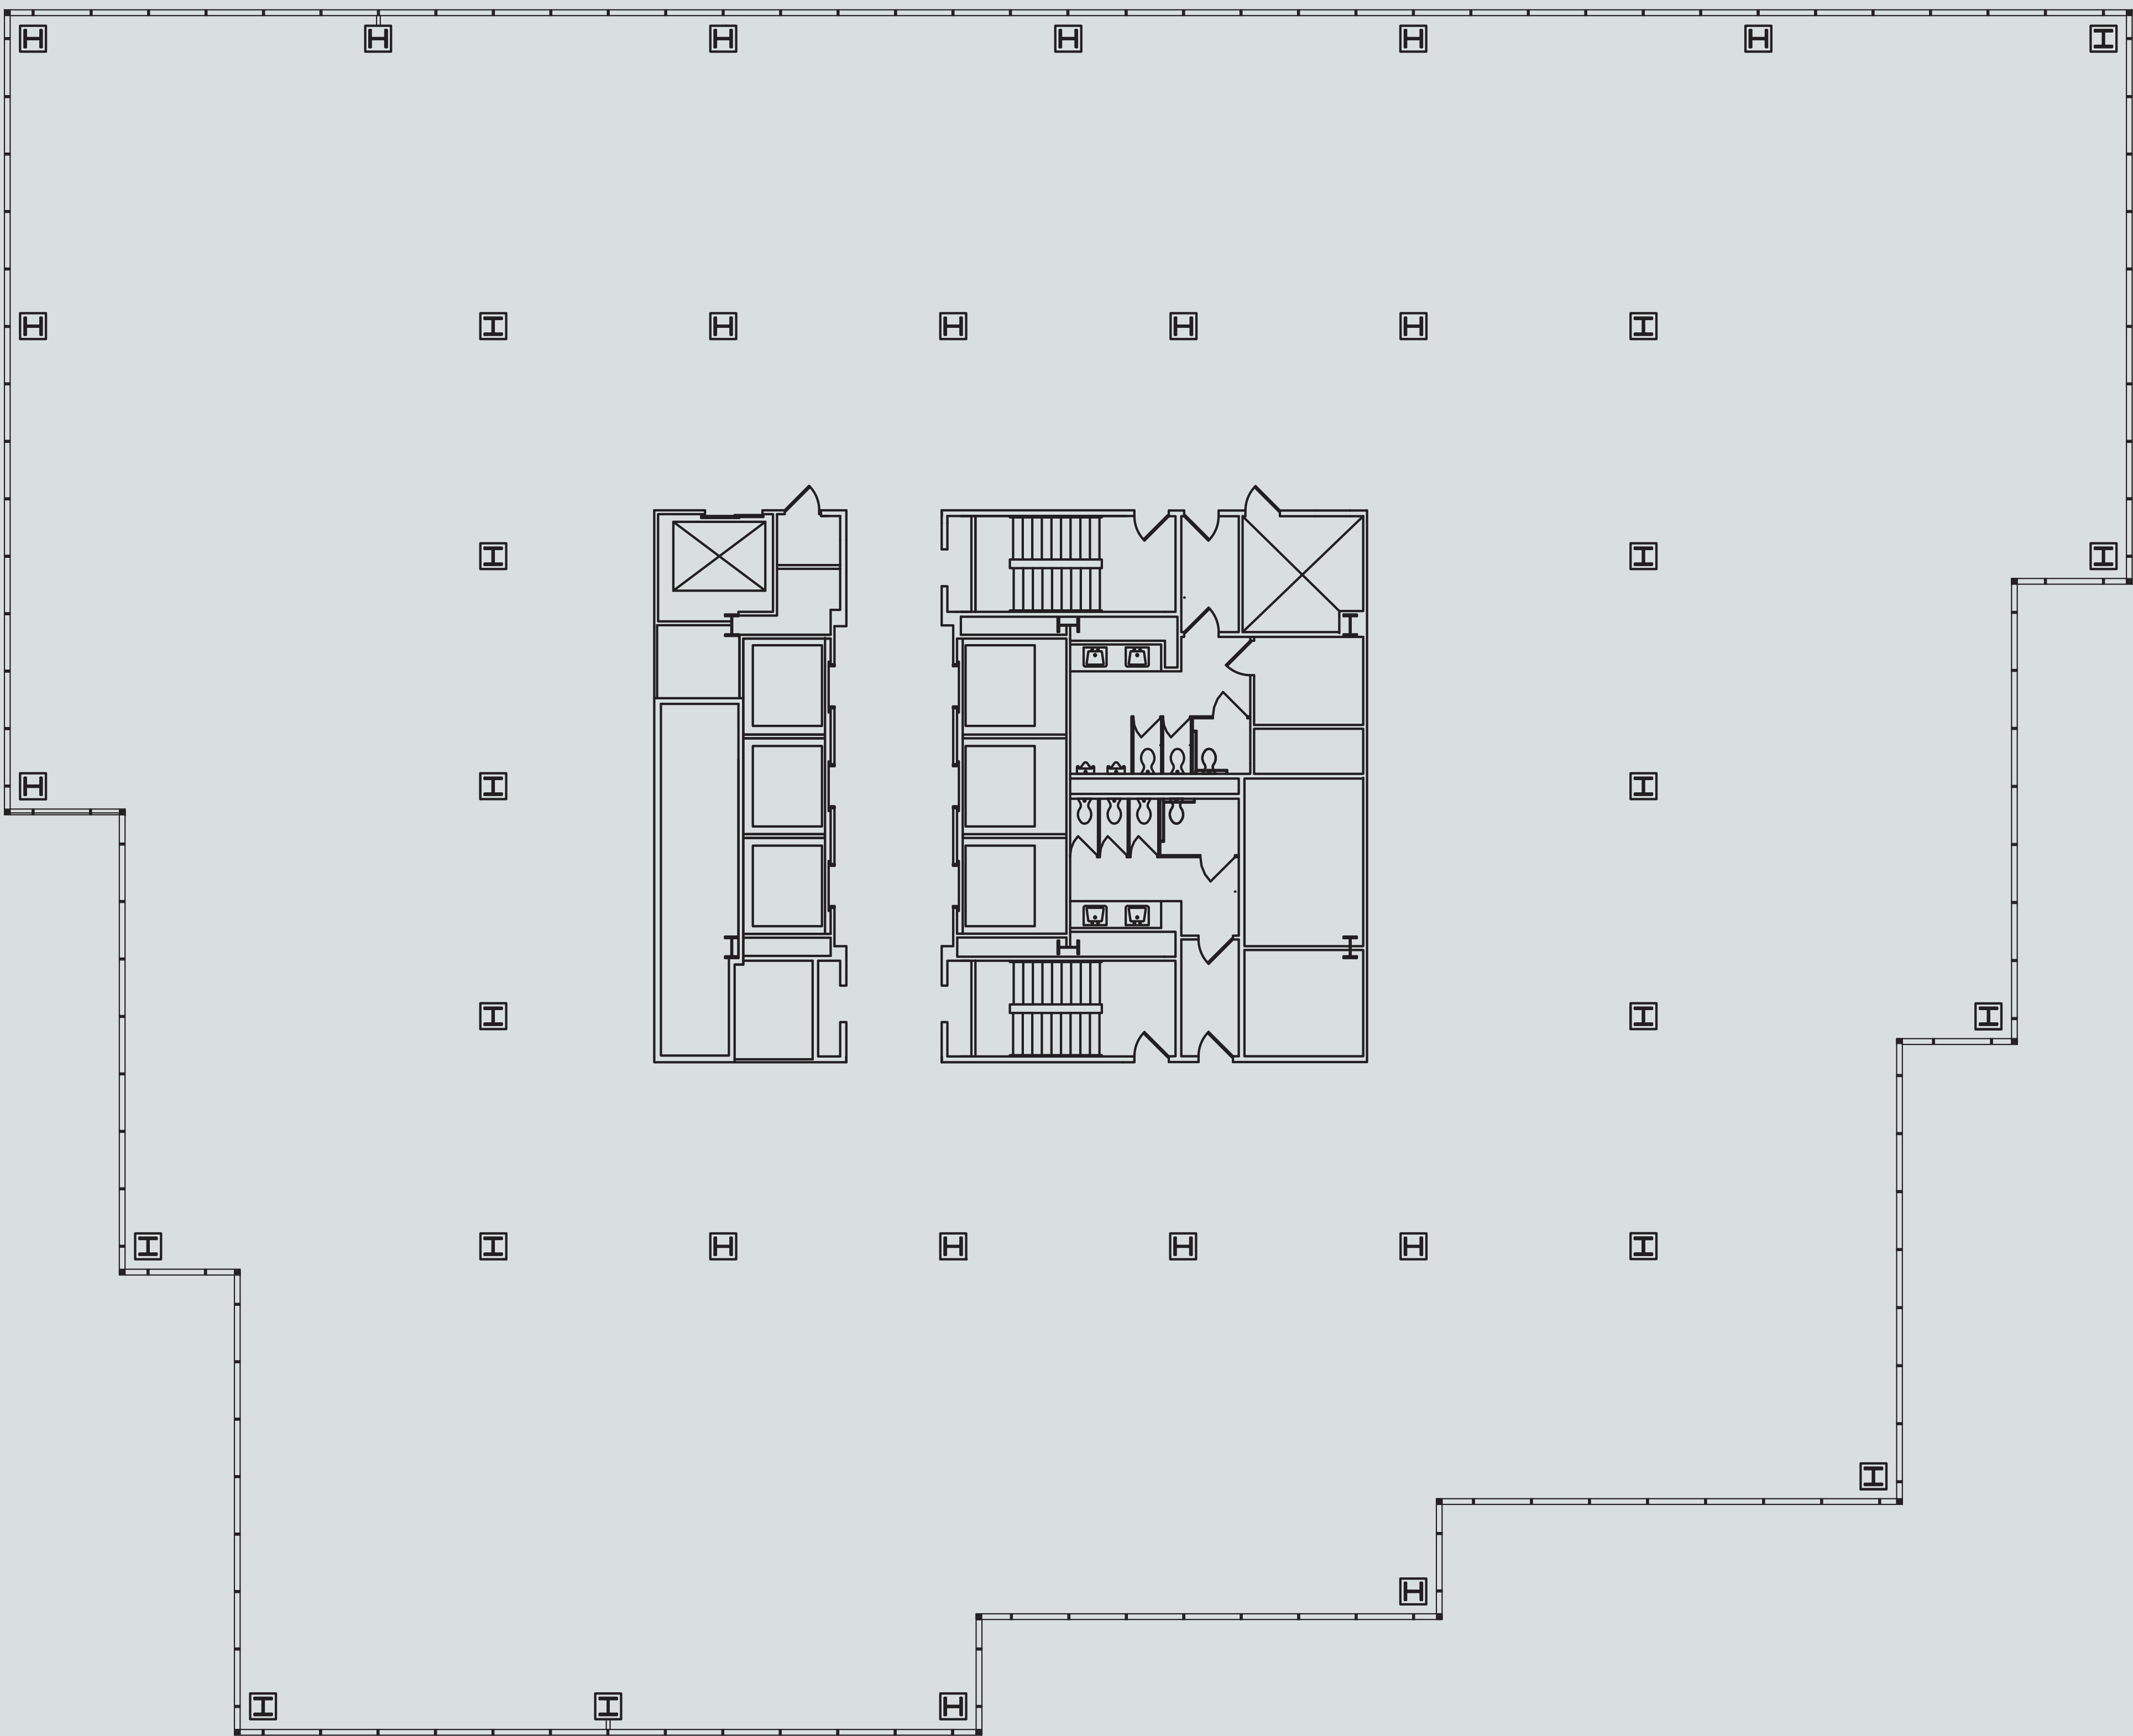


AS-BUILT CONFIGURATION

OFFICES.....	N/A
RECEPTION.....	N/A
CONFERENCE ROOMS.....	N/A
KITCHEN.....	N/A
OPEN WORK AREA.....	N/A

Not to scale, furniture and appliances not included

KEY PLAN

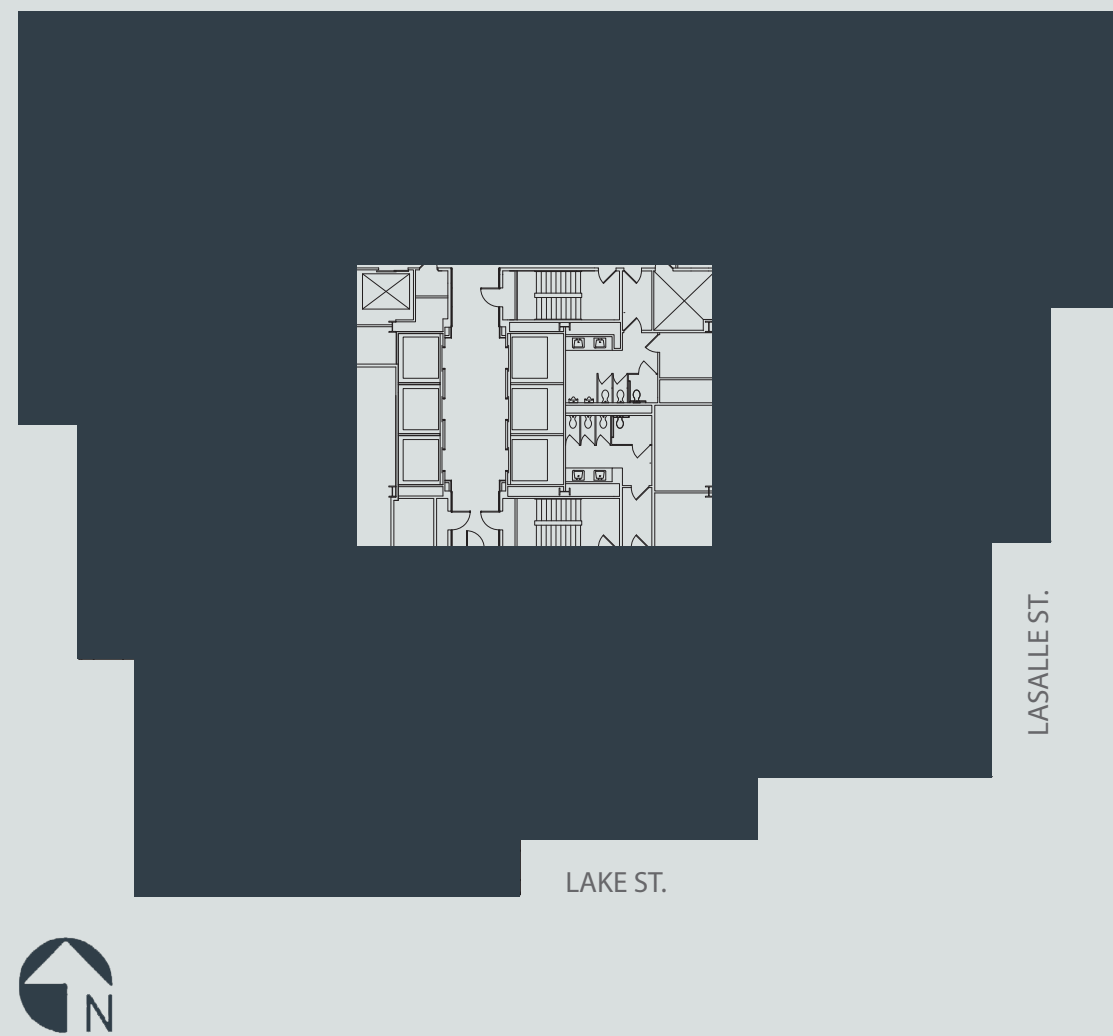

For leasing information please contact:
Mark J. Gunderson
312.448.8645
mark.gunderson@streamrealty.com

Ben Cleveland
312.448.6221
ben.cleveland@streamrealty.com