

SUITE: 425

 

RSF: 3,868

AS-BUILT CONFIGURATION

OFFICES.....	N,
RECEPTION.....	N,
CONFERENCE ROOMS.....	N,
KITCHEN.....	N,
OPEN WORK AREA.....	N,

Not to scale, furniture and appliances not included

KEY PLAN

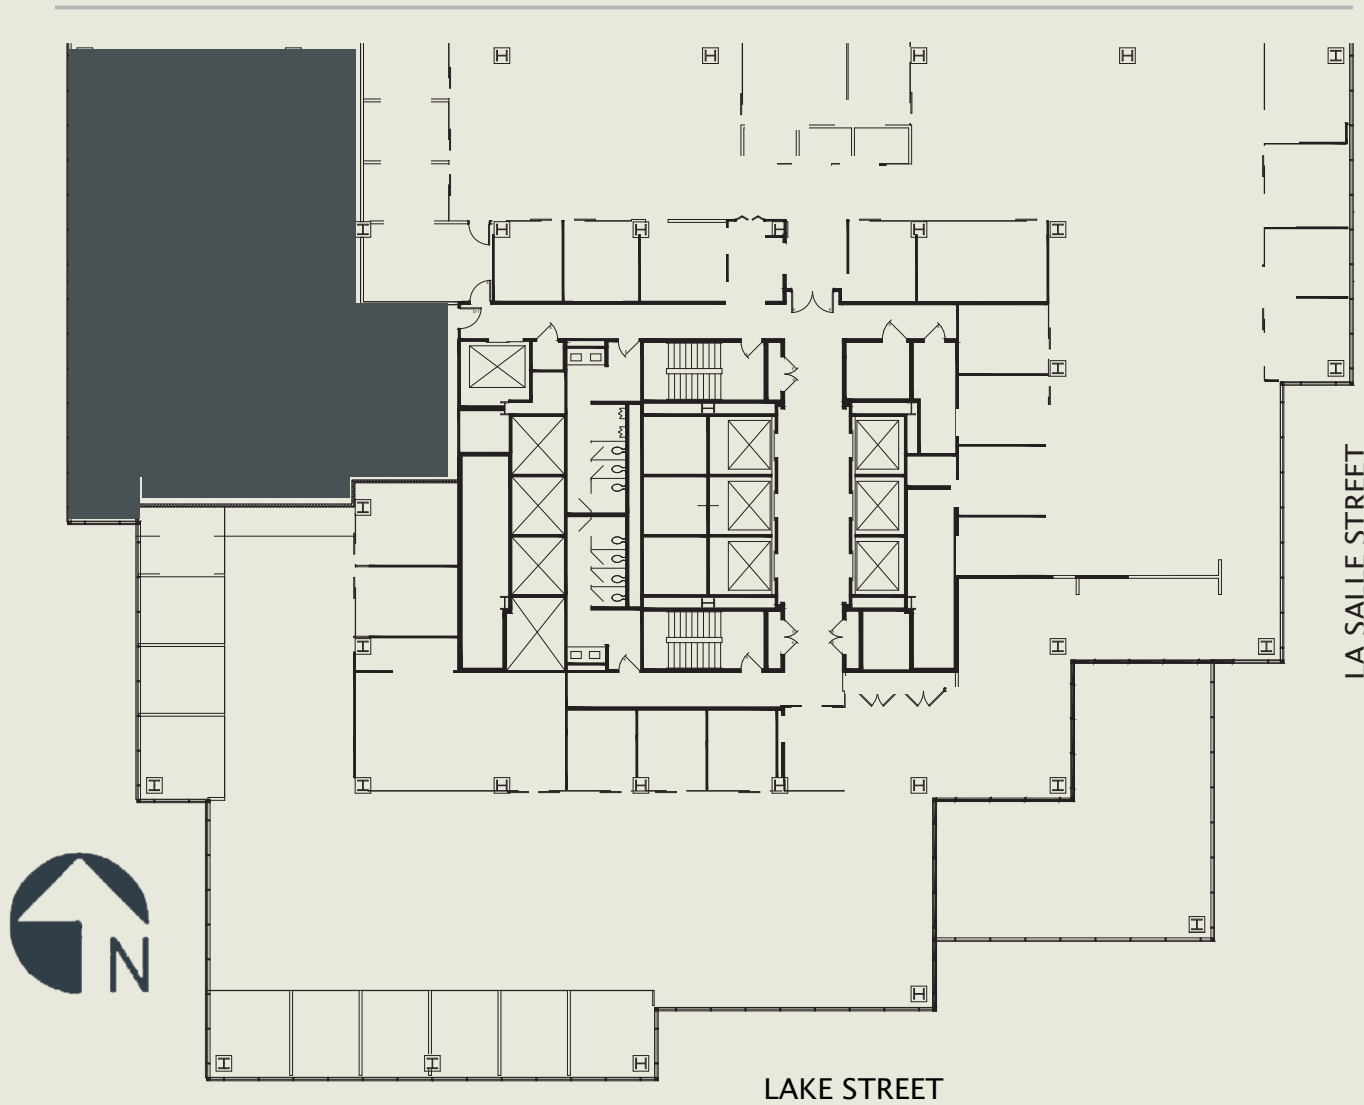

FOR LEASING INFORMATION PLEASE CONTACT:

MARK GUNDERSON  
312 448 8645 | mark.gunderson@streamrealty.com

BEN CLEVELAND  
312 448 6221 | ben.cleveland@streamrealty.com