

SUITE: 810



RSF: 4,000

AS-BUILT CONFIGURATION

OFFICES.....	2
RECEPTION.....	1
CONFERENCE ROOMS.....	N/A
KITCHEN.....	1
OPEN WORK AREA.....	+/-18

Not to scale, furniture and appliances not included

KEY PLAN

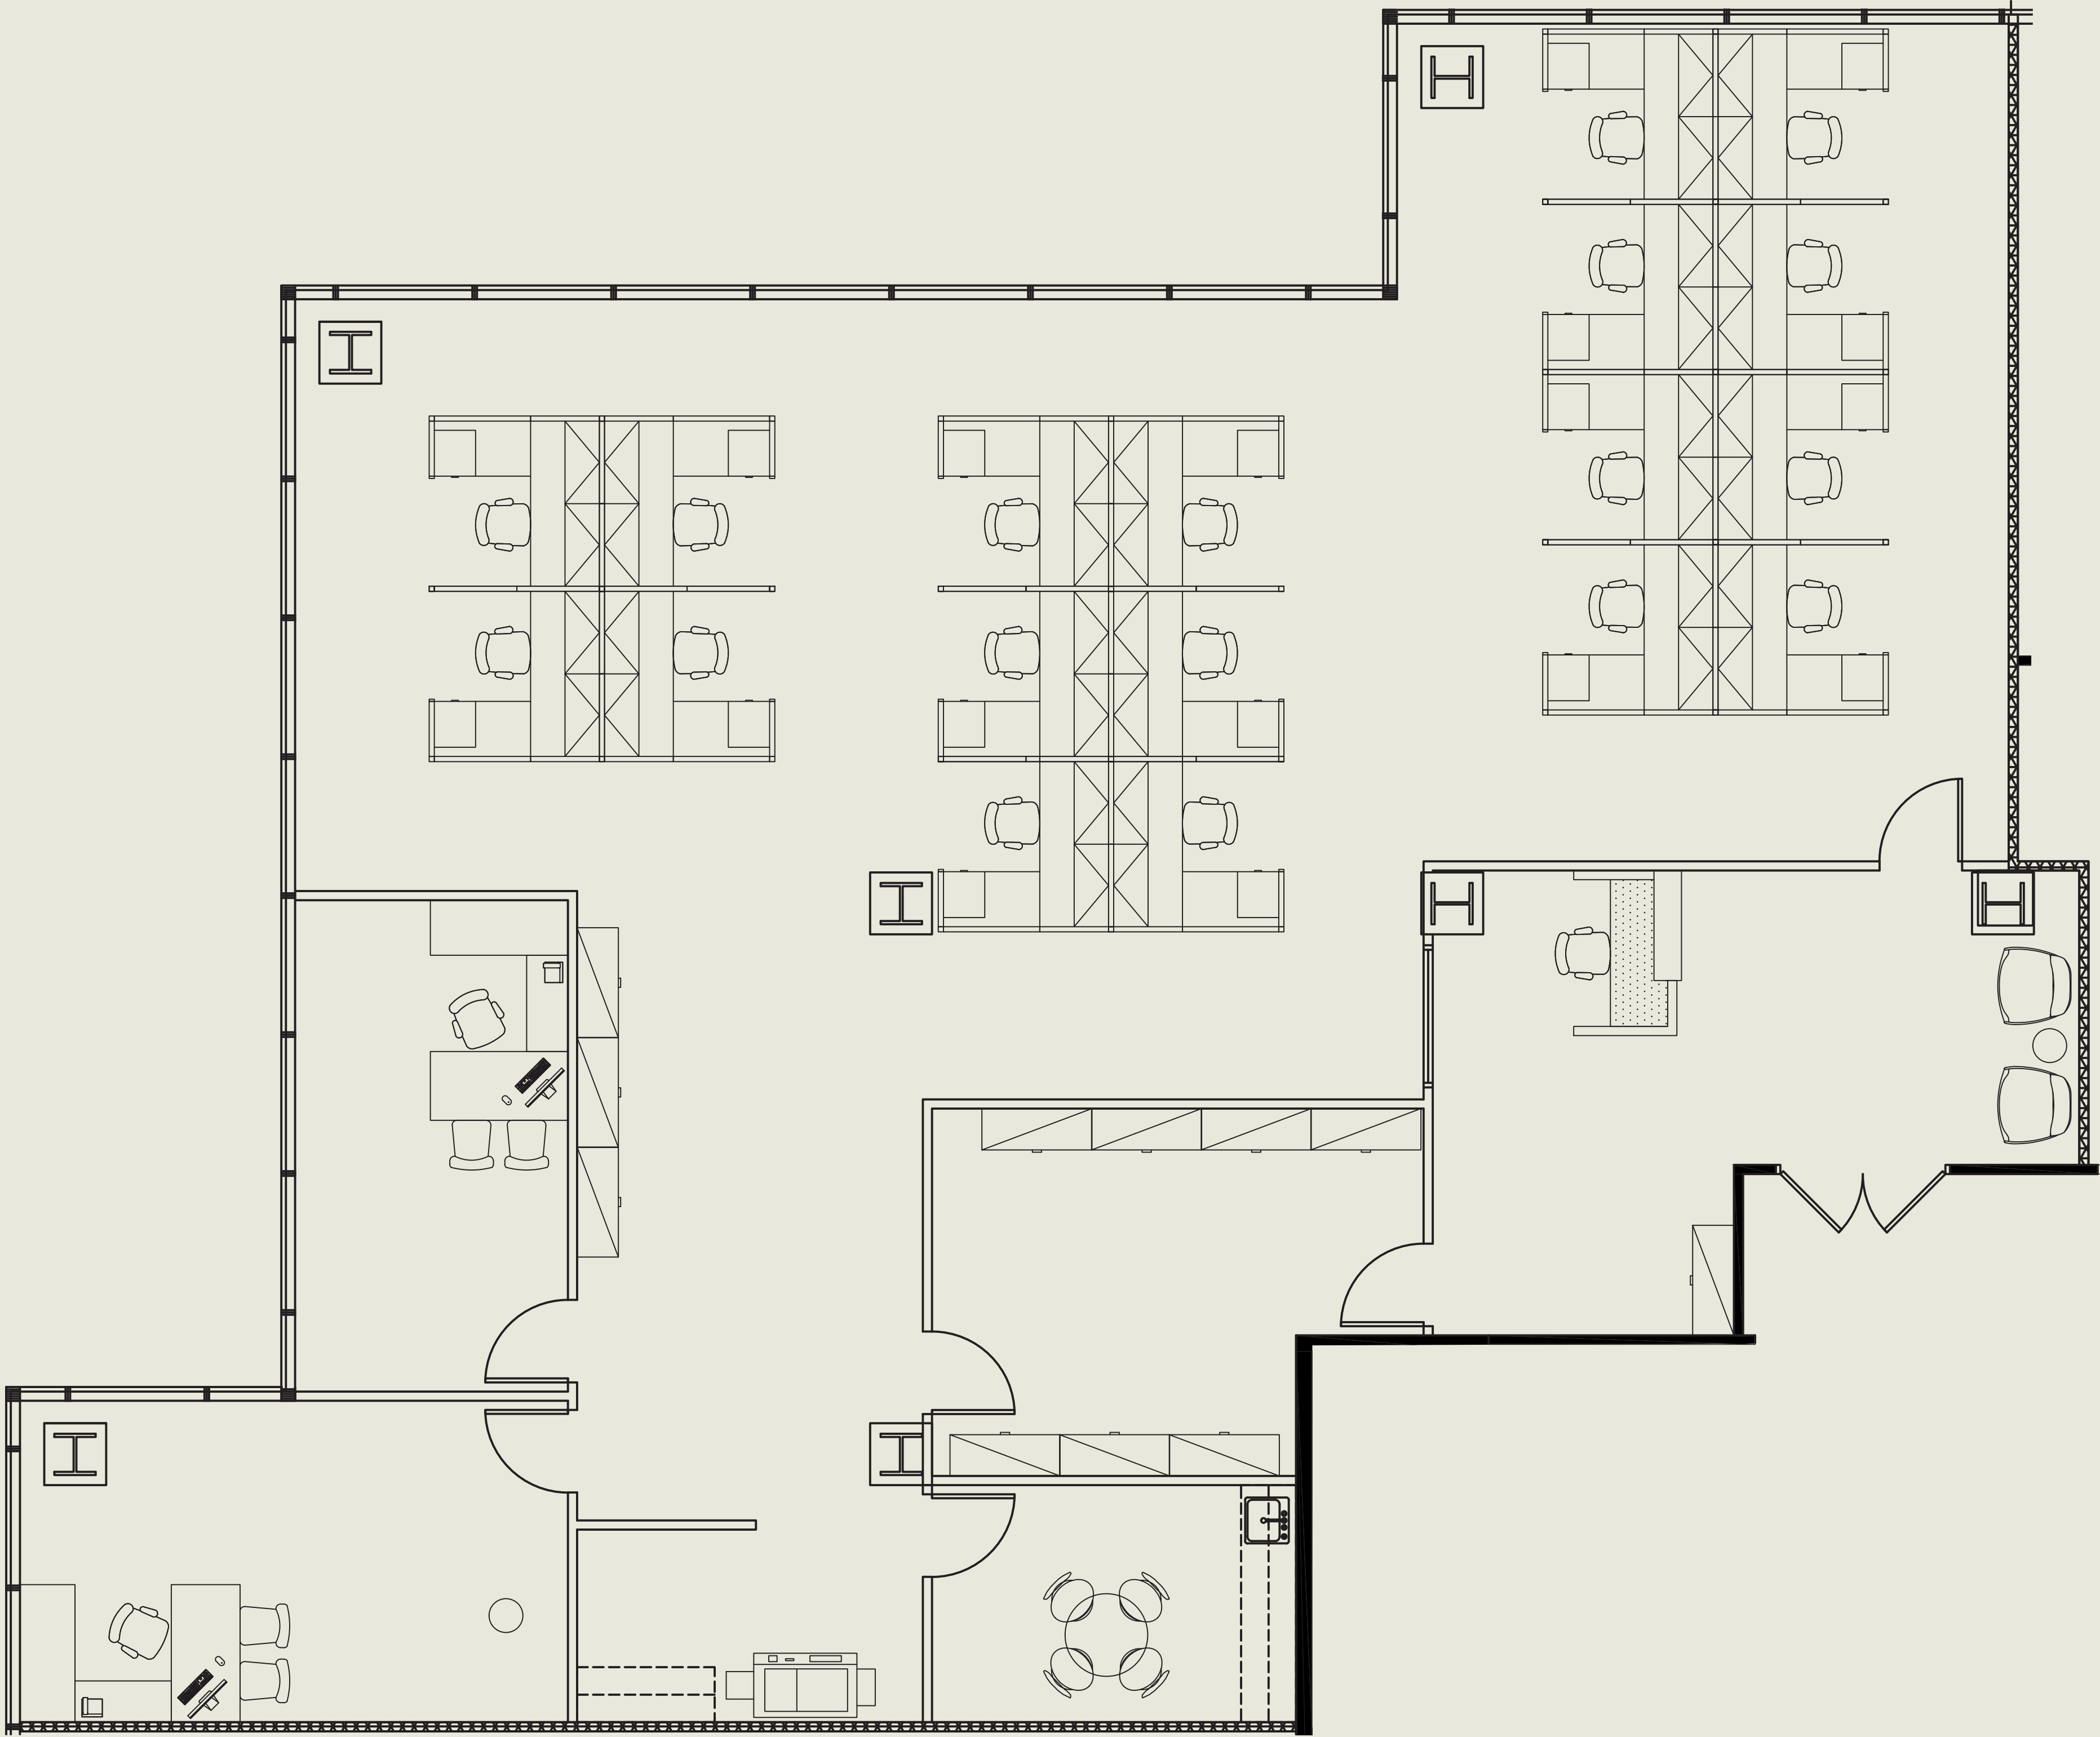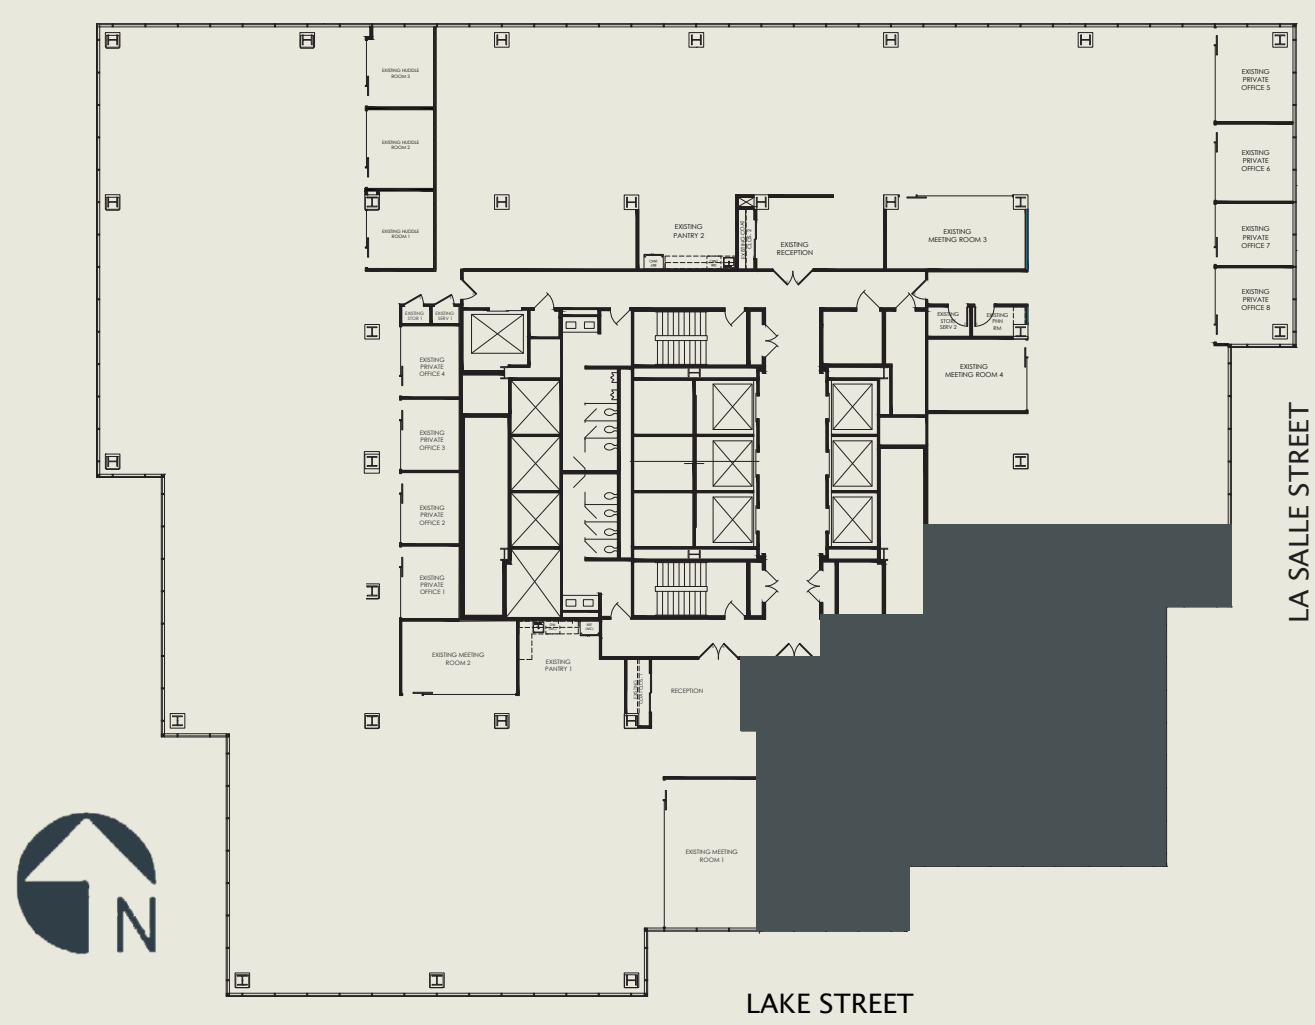

FOR LEASING INFORMATION PLEASE CONTACT:

MARK GUNDERSON
312 448 8645 | mark.gunderson@streamrealty.com

BEN CLEVELAND
312 448 6221 | ben.cleveland@streamrealty.com