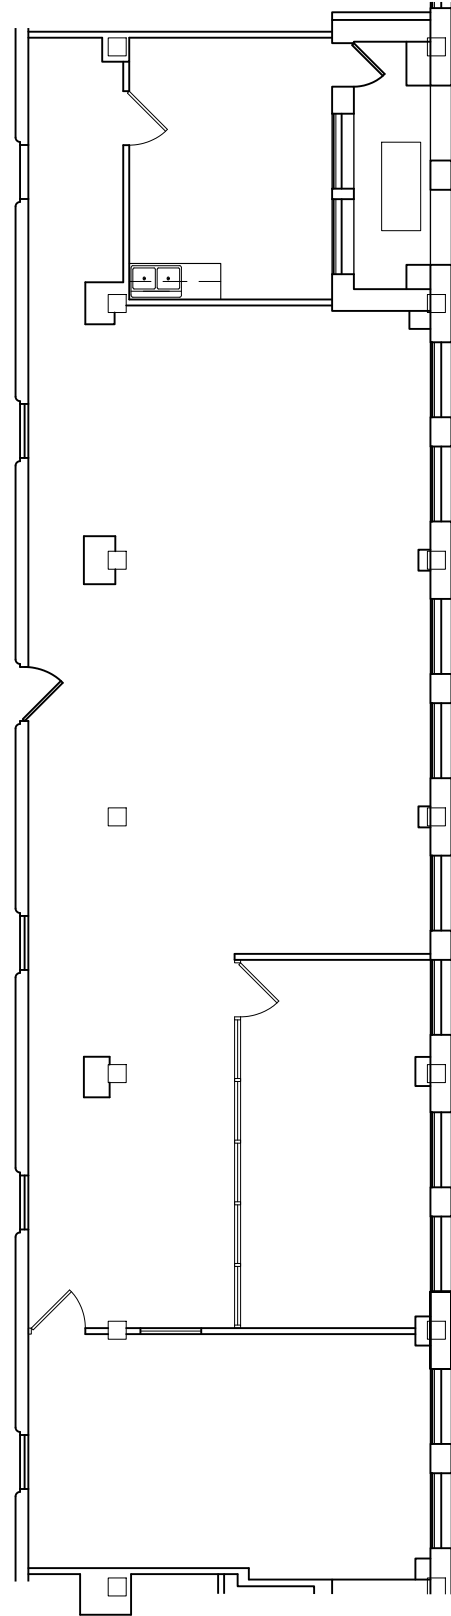




315 W 9TH ST.
SUITE 702
315 W 9TH ST.
LOS ANGELES, CA 90015
RSF: 2,417



 
 
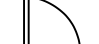
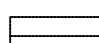
DRAWN BY: TA

ISSUE: 1/15/2021

REVISIONS:

SCALE:

LEGEND:

-  SEE WALL SCHEDULE
-  SEE GLAZING SCHEDULE
-  SEE DOOR SCHEDULE
-  BUILDING STANDARD MILLWORK

SHEET TITLE:

FLOOR PLAN

SHEET:

ID1.01