

# FULL FLOOR OPPORTUNITY!

RSF: 11,368

# 315



WEST 9TH

## AS-BUILT CONFIGURATION

OFFICES.....	6
RECEPTION.....	1
CONFERENCE ROOMS.....	4
KITCHEN/BREAKOUT .....	1
OPEN WORK AREA.....	70

*Not to scale, furniture and appliances not included*

## KEY PLAN

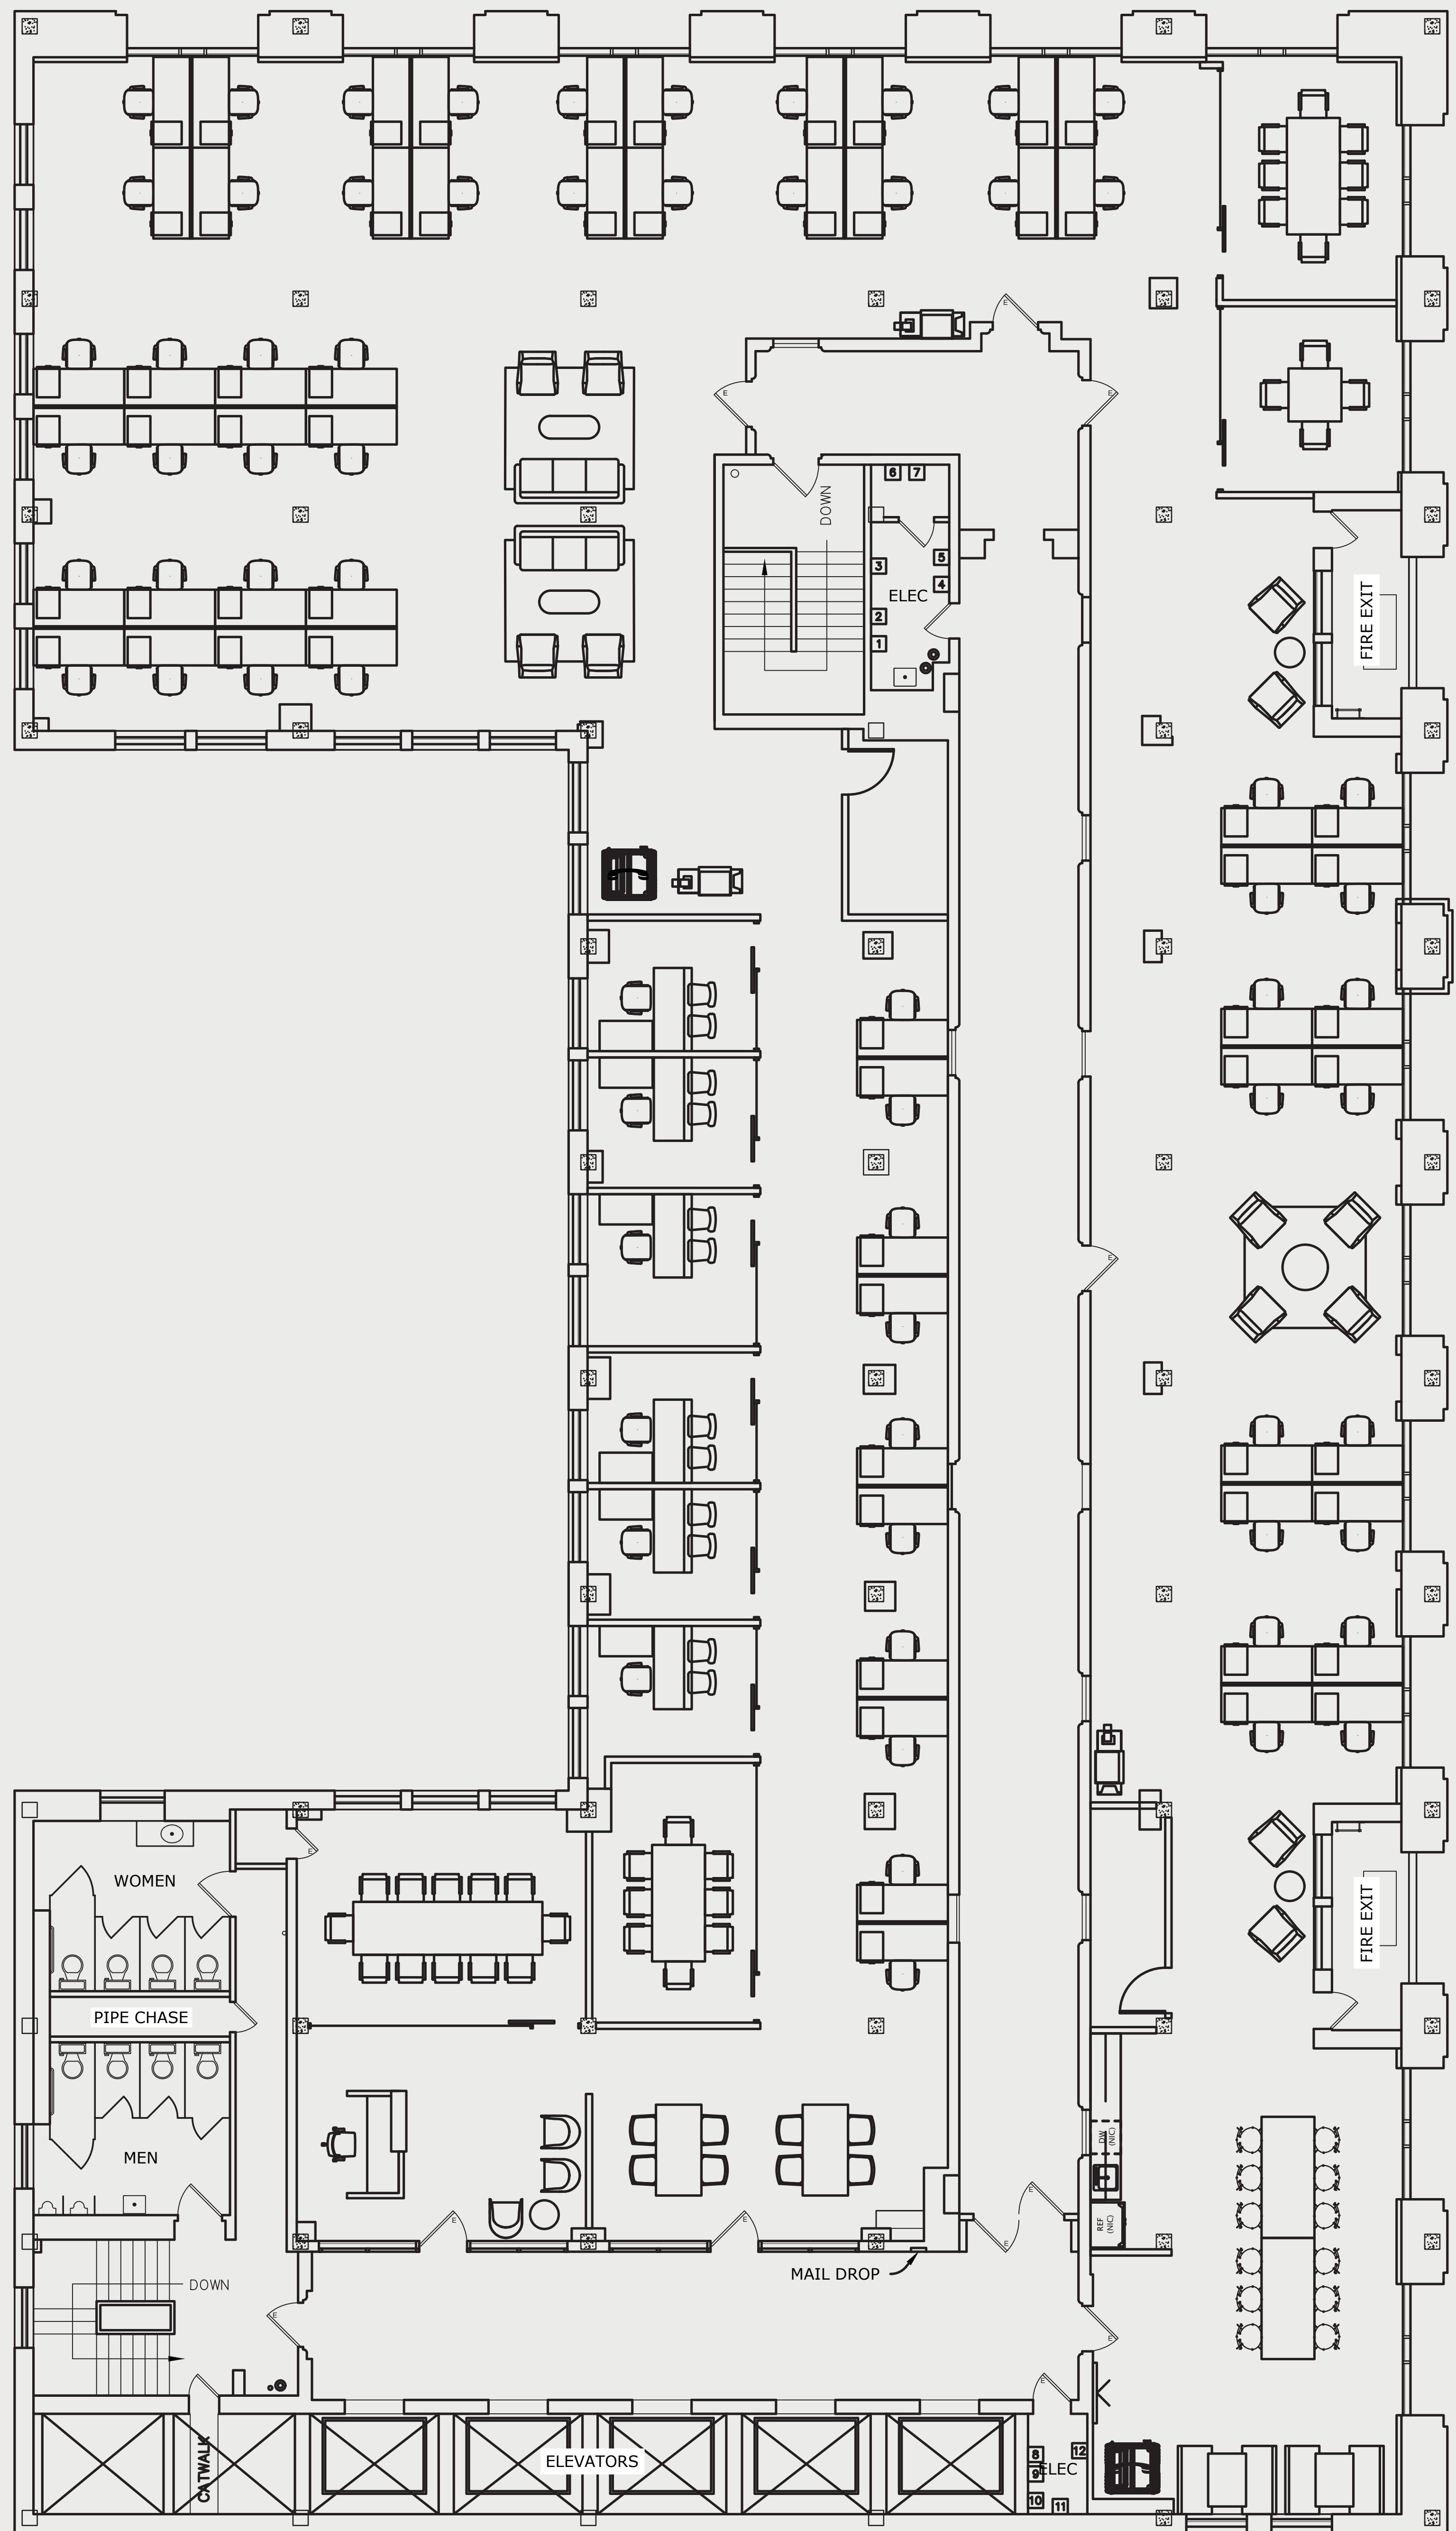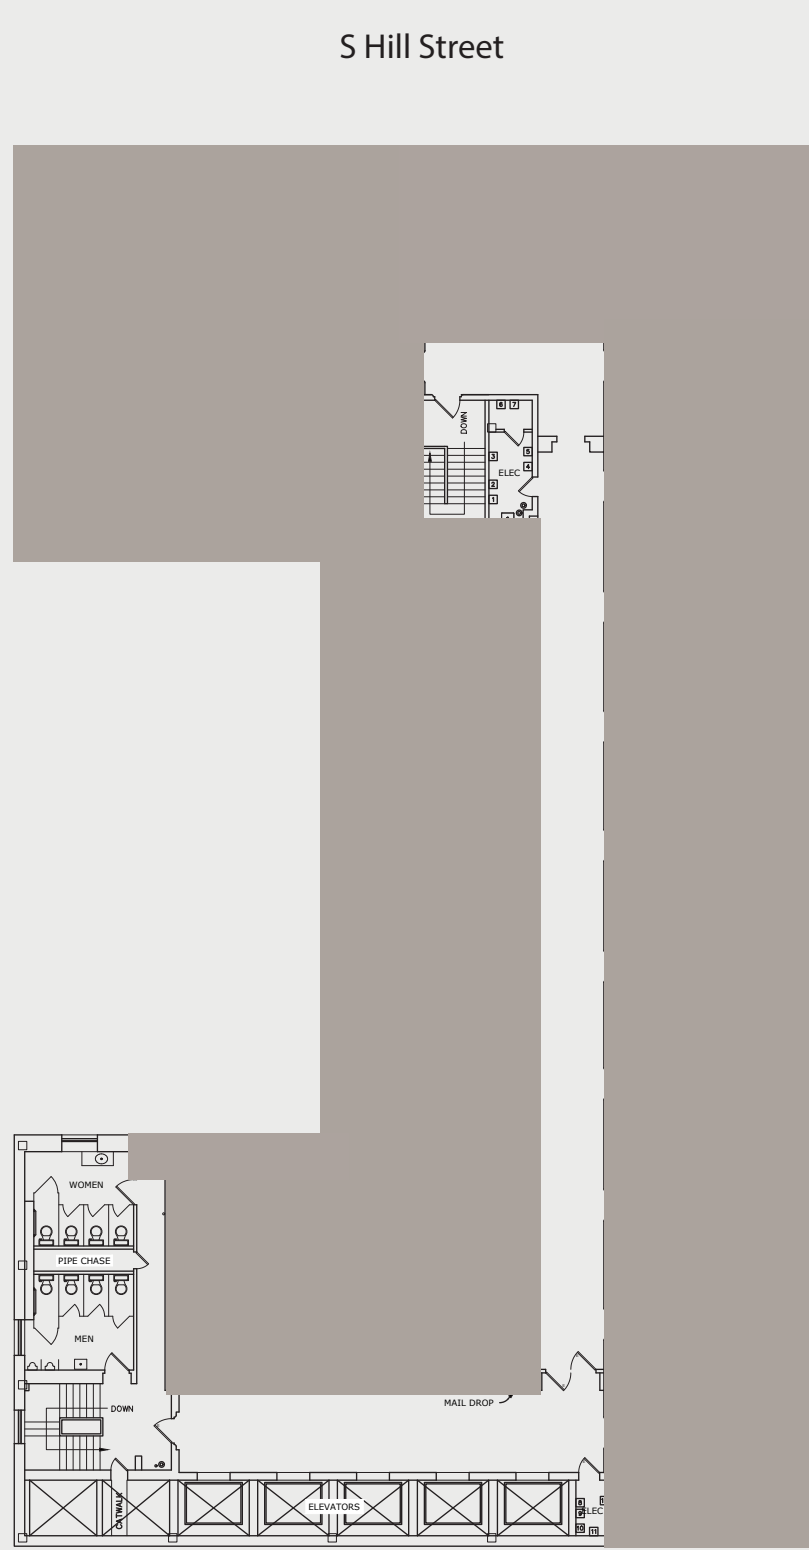

For leasing information please contact:  
 Alex Bergeson  
 213.596.2240 | alex.bergeson@ngkf.com

