
SUITE: 1250 RSF: 4,926




AS-BUILT CONFIGURATION


PRIVATE OFFICES	TBD
CONFERENCE ROOMS	TBD
OPEN WORK AREA	TBD
RECEPTION	TBD
KITCHEN/BREAKOUT	TBD

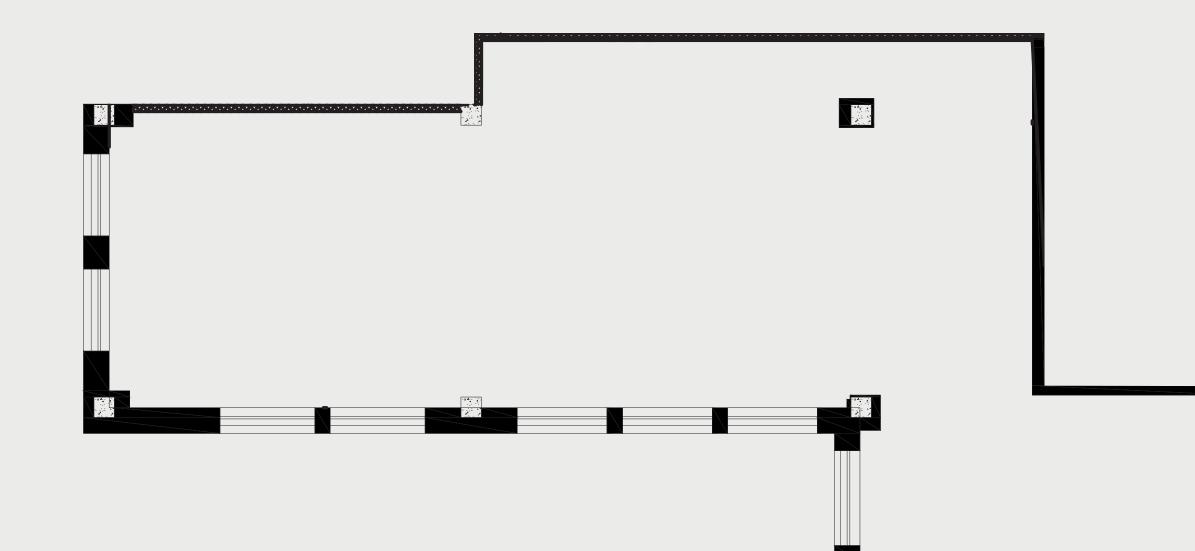

Not to scale, furniture and appliances not included

KEY PLAN

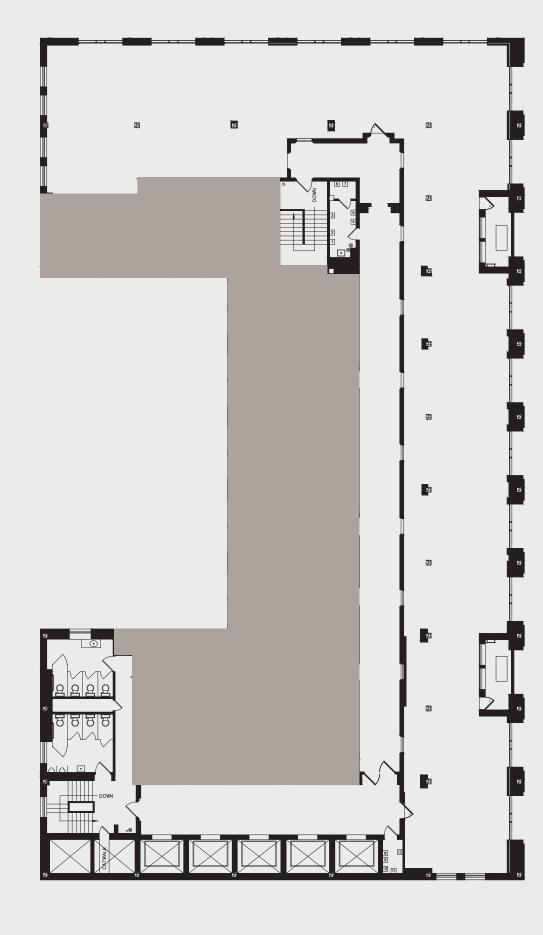

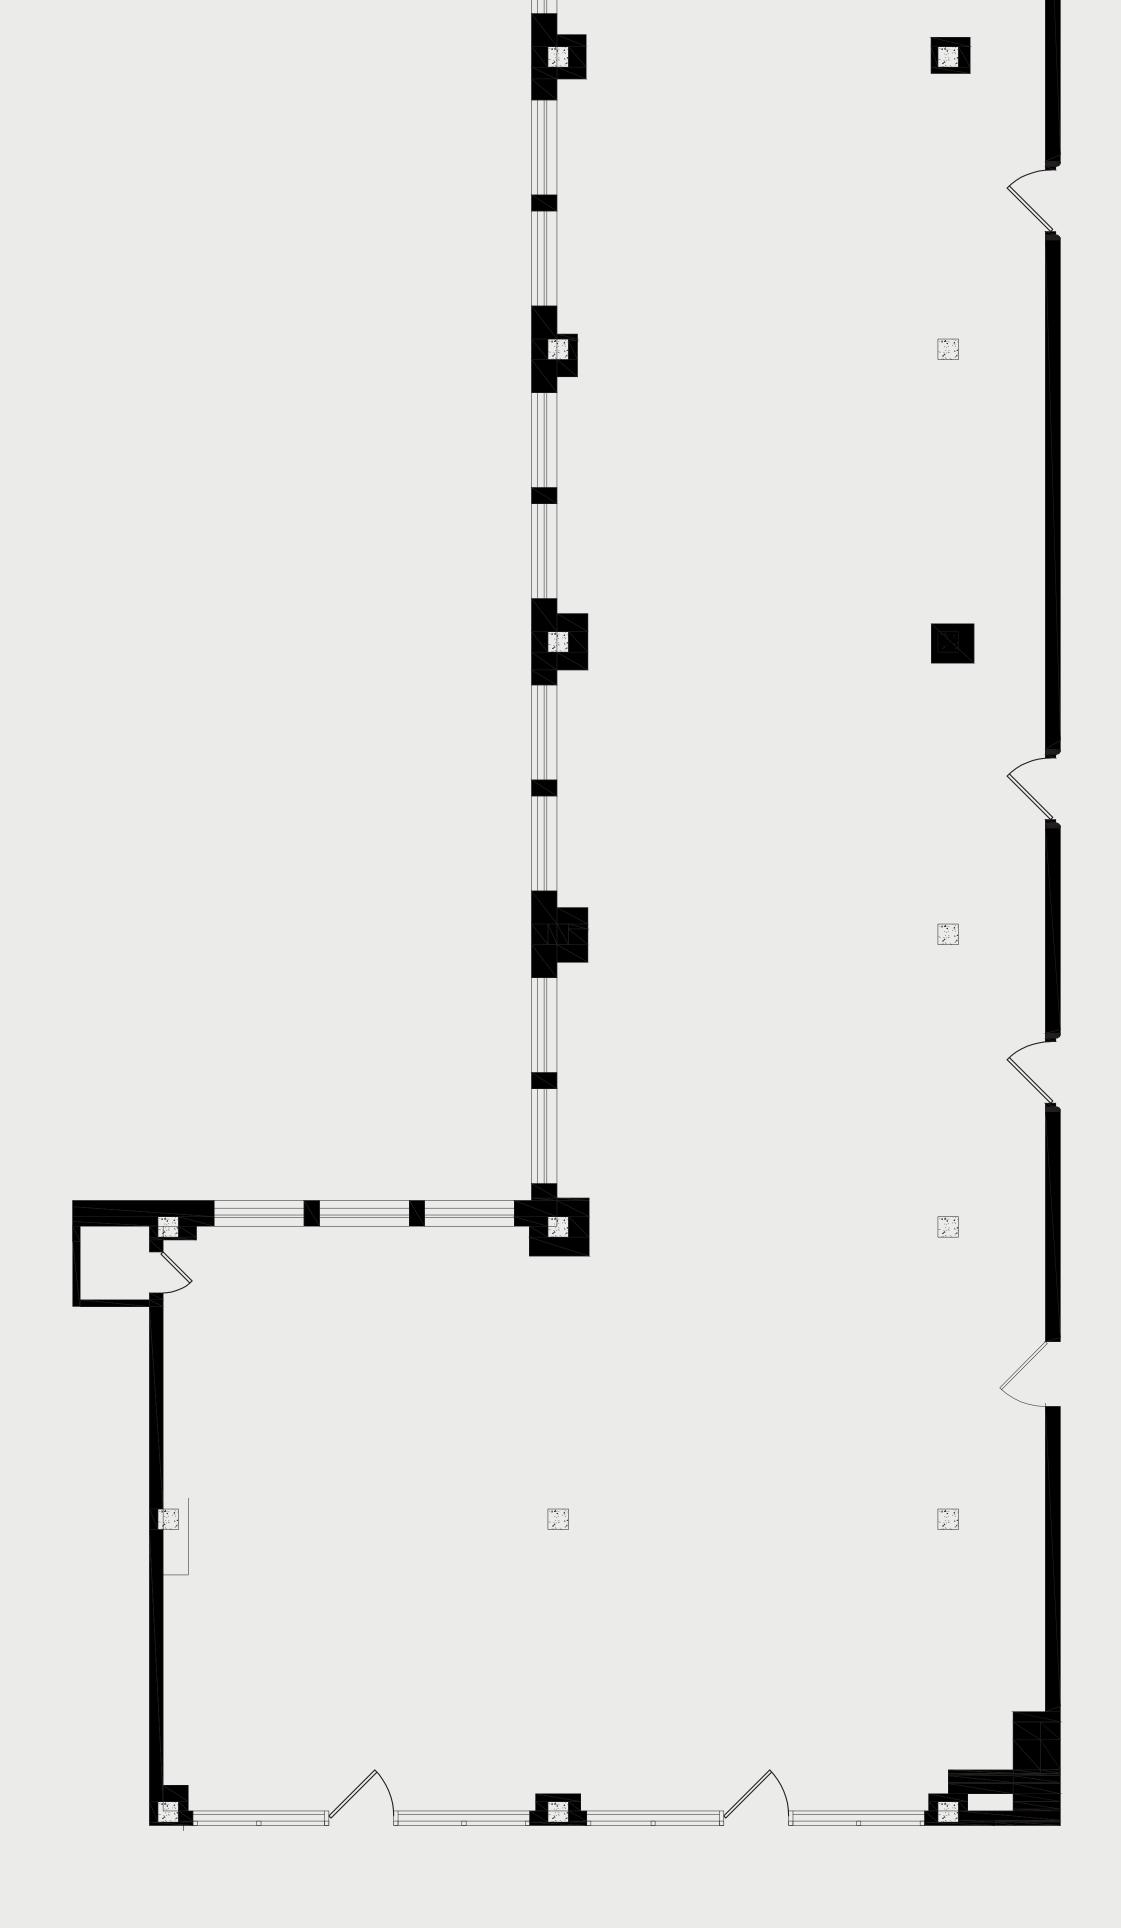

PLEASE CONTACT: USALEASING@ONNI.COM (213) 629 - 2041