SUITE: 200







AS-BUILT CONFIGURATION



KEY PLAN

S Hill Street

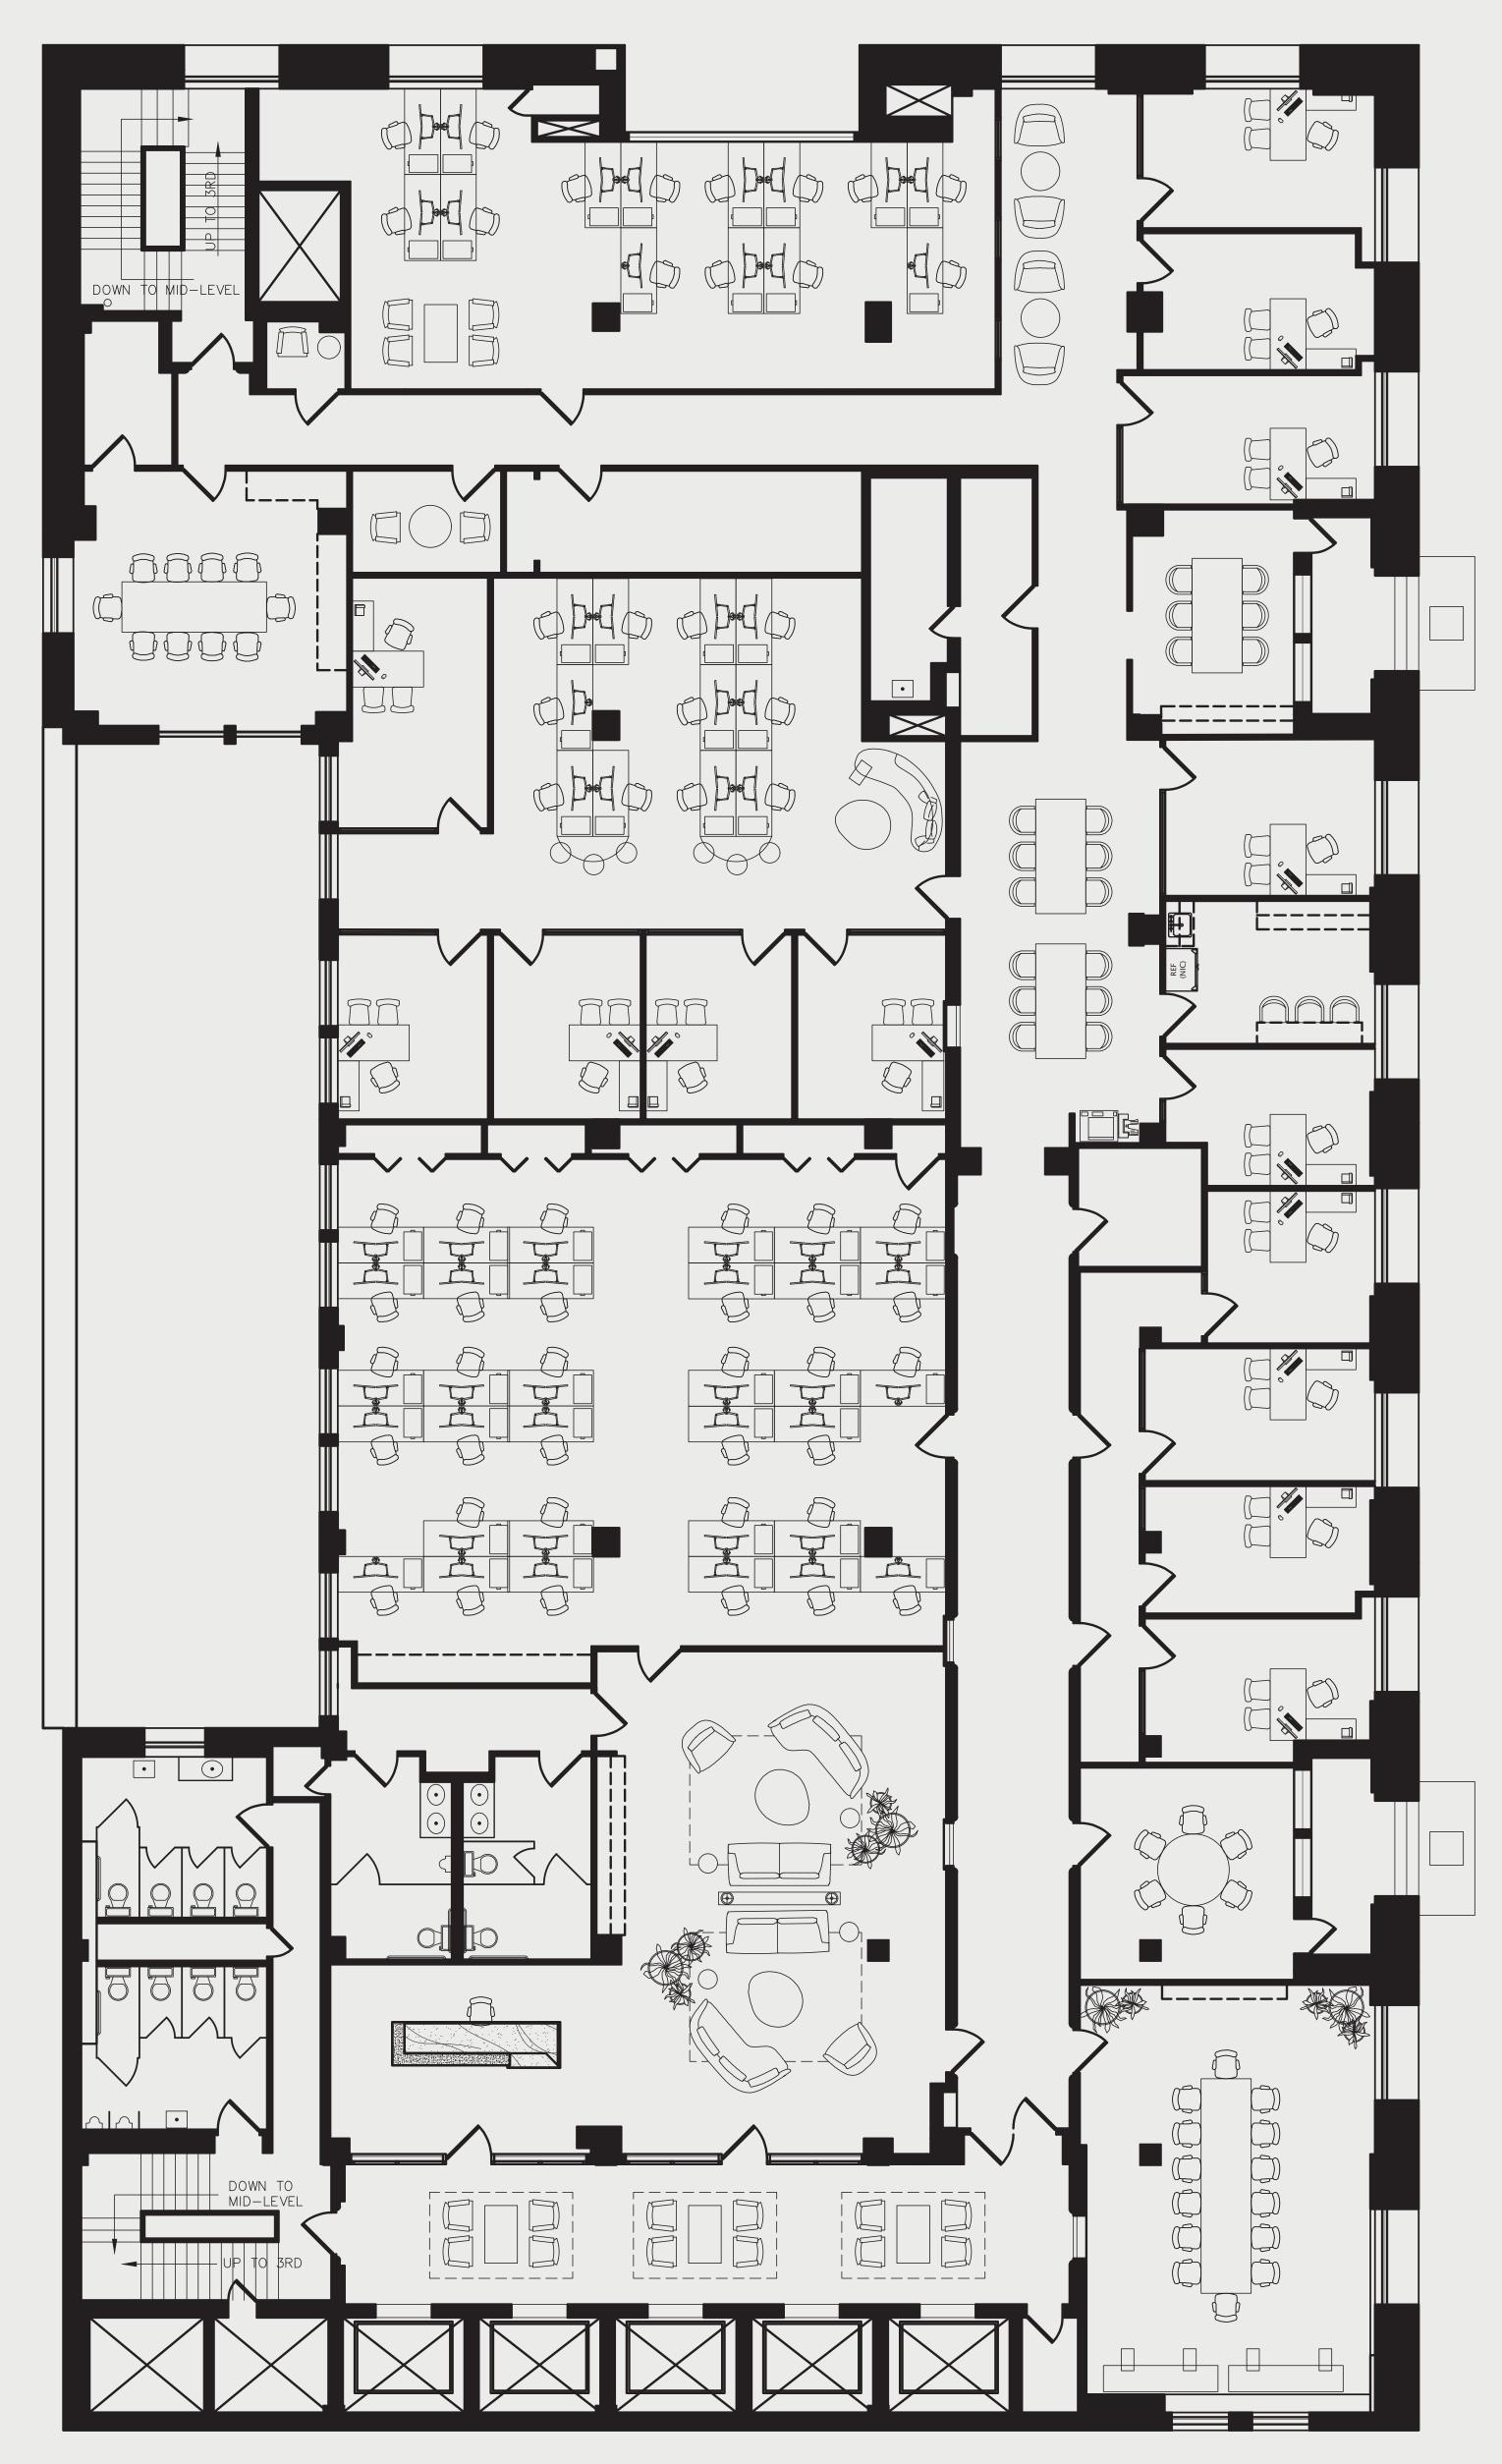

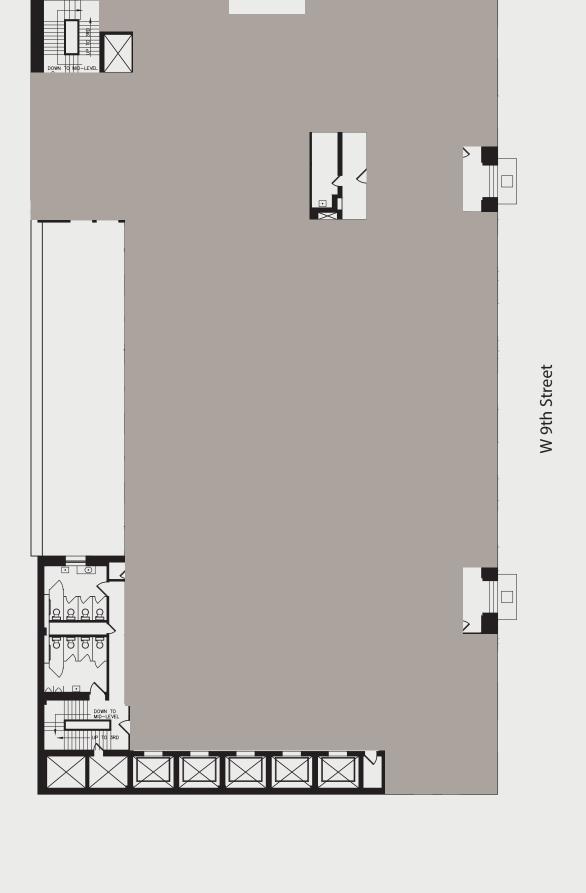

For leasing information please contact: USALEASING@ONNI.COM (213) 629-2041

