
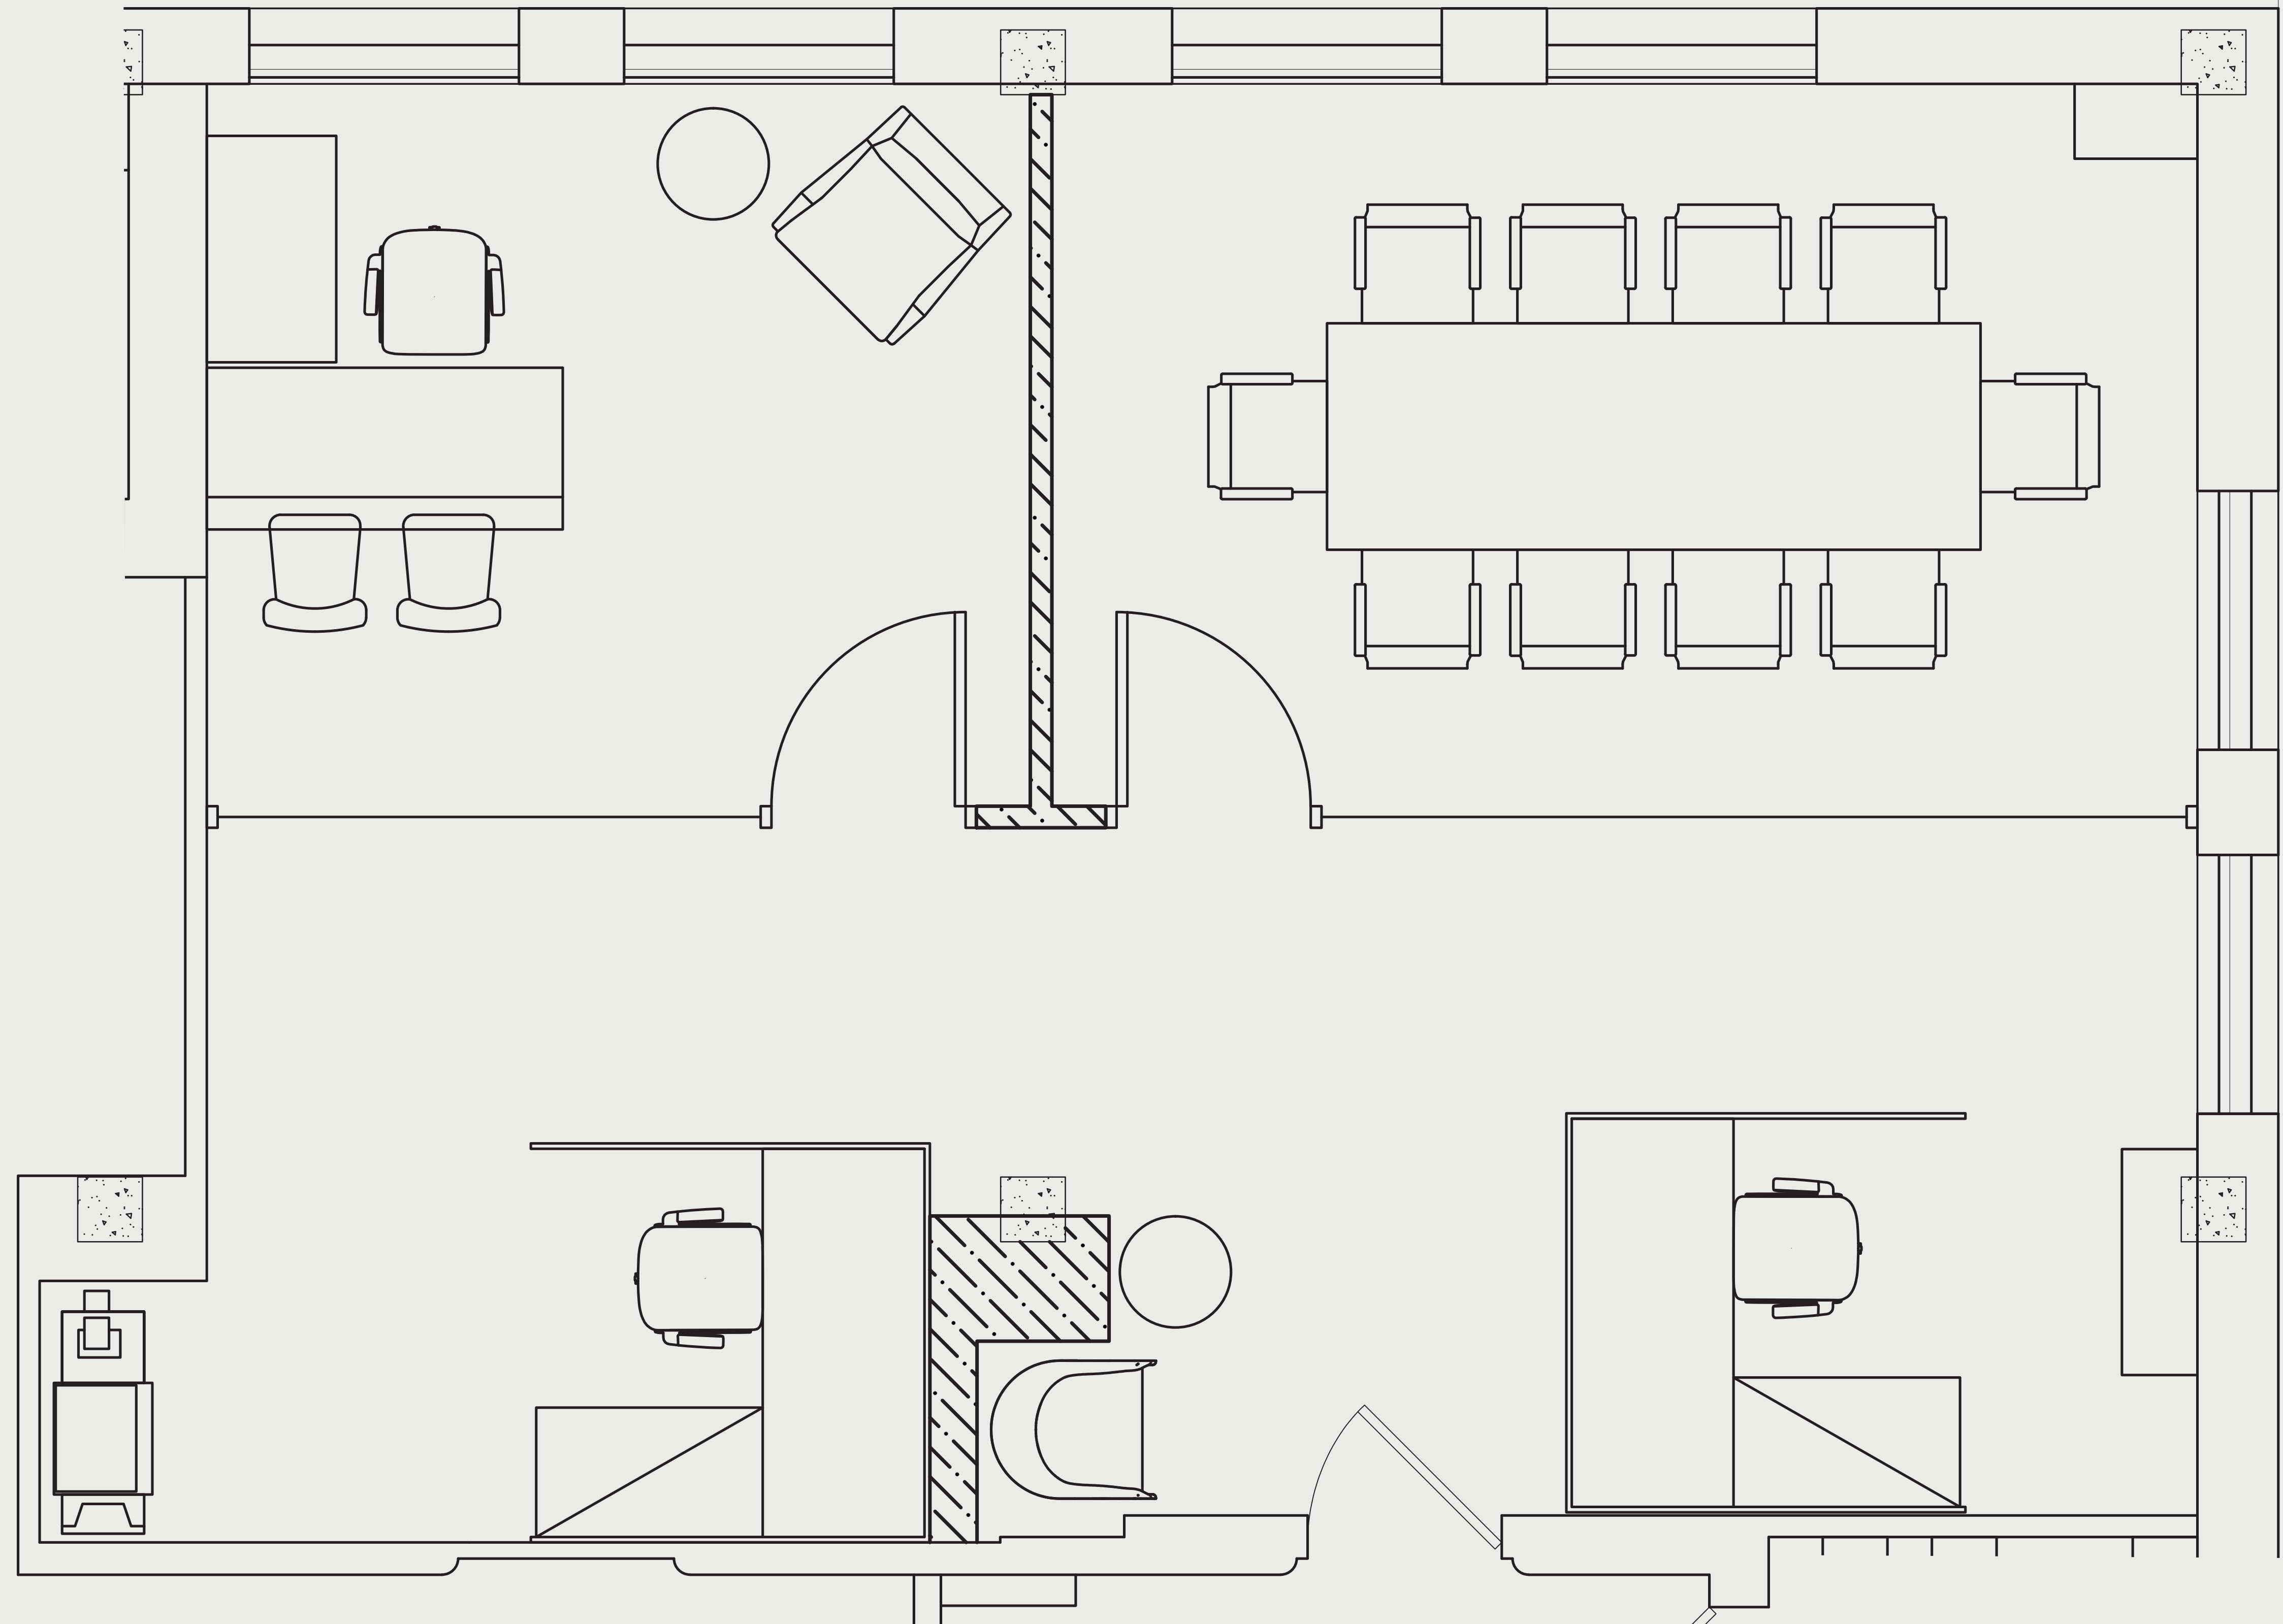


### AS-BUILT CONFIGURATION

OFFICES.....	1
RECEPTION.....	1
CONFERENCE ROOMS.....	1
KITCHEN/BREAKOUT .....	-
OPEN WORK AREA.....	2

*Not to scale, furniture and appliances not included*

### KEY PLAN

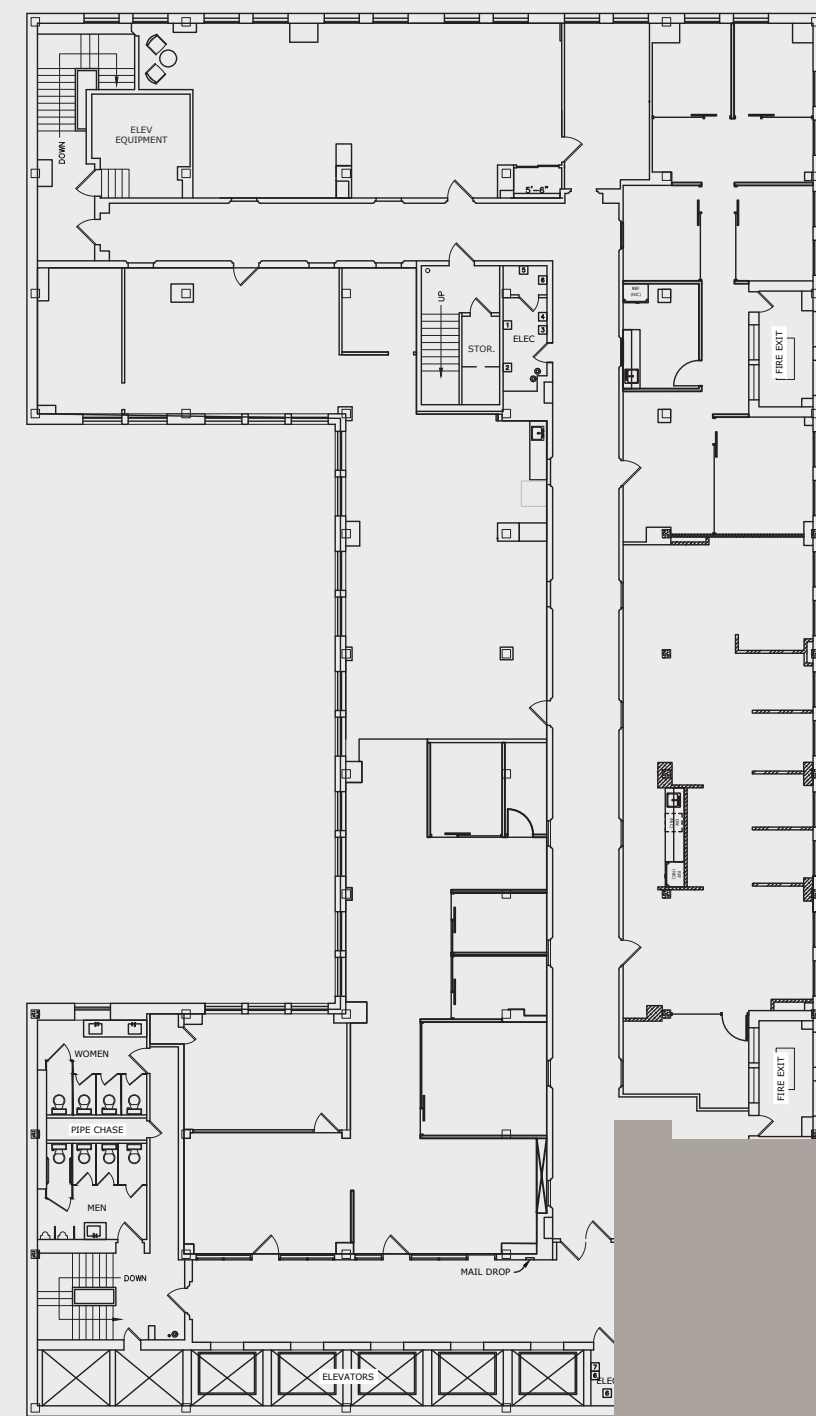

For leasing information please contact:  
Andrew Tashjian  
213.955.5148 | [andrew.tashjian@cushwake.com](mailto:andrew.tashjian@cushwake.com)