
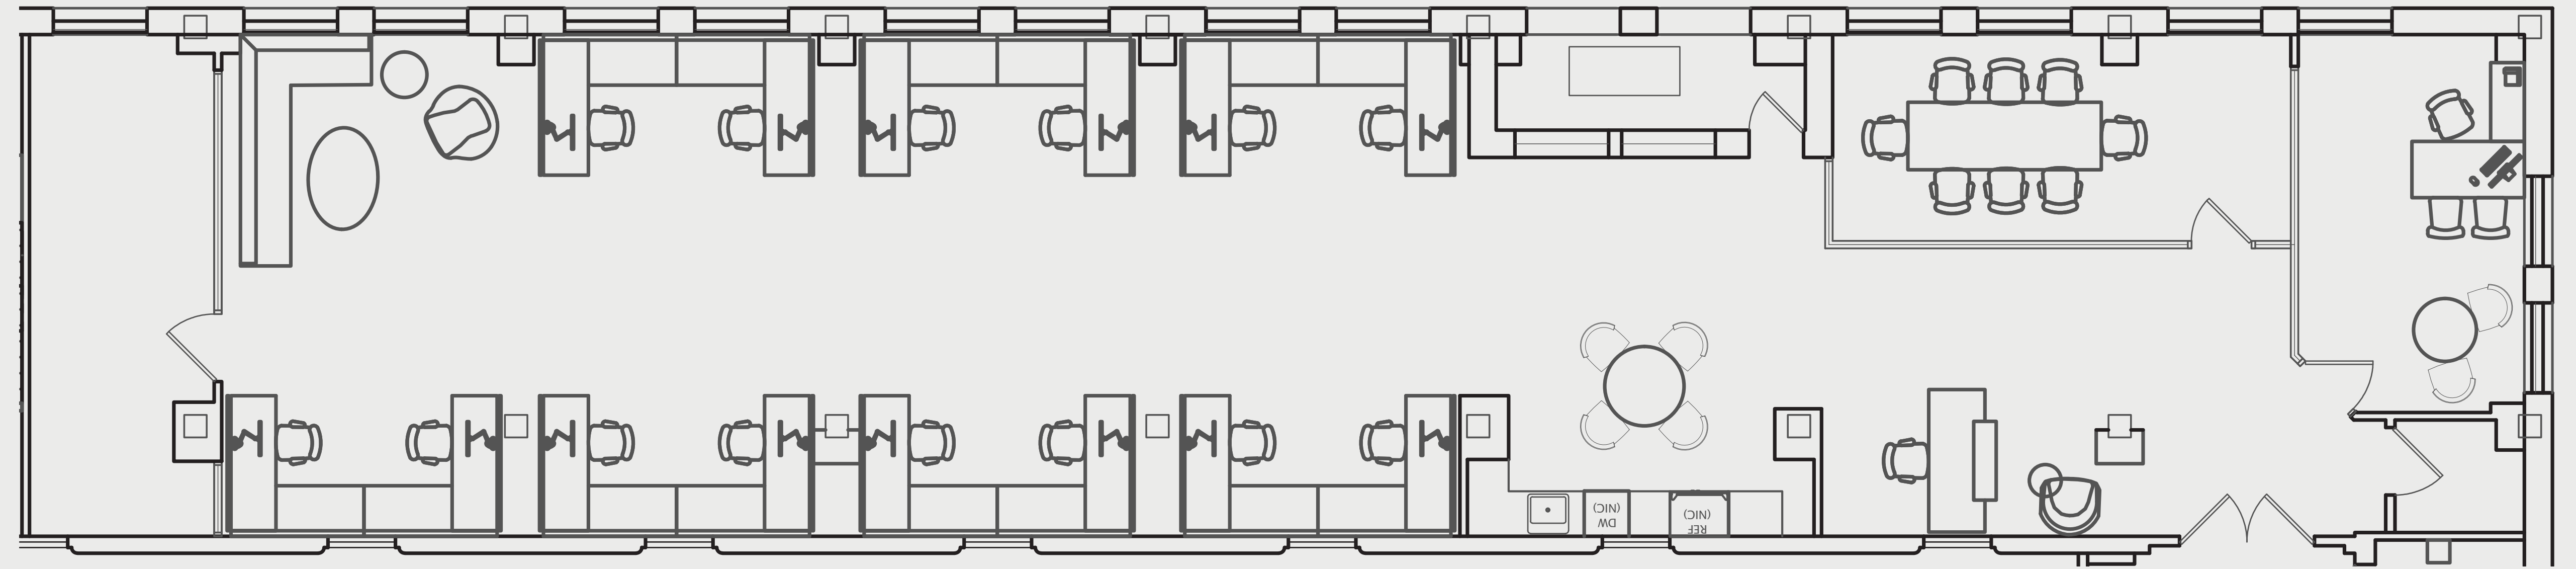


AS-BUILT CONFIGURATION

- OFFICES..... 1
- RECEPTION..... 1
- CONFERENCE ROOMS..... 1
- KITCHEN/BREAKOUT 1
- OPEN WORK AREA..... +/- 14

Not to scale, furniture and appliances not included

KEY PLAN

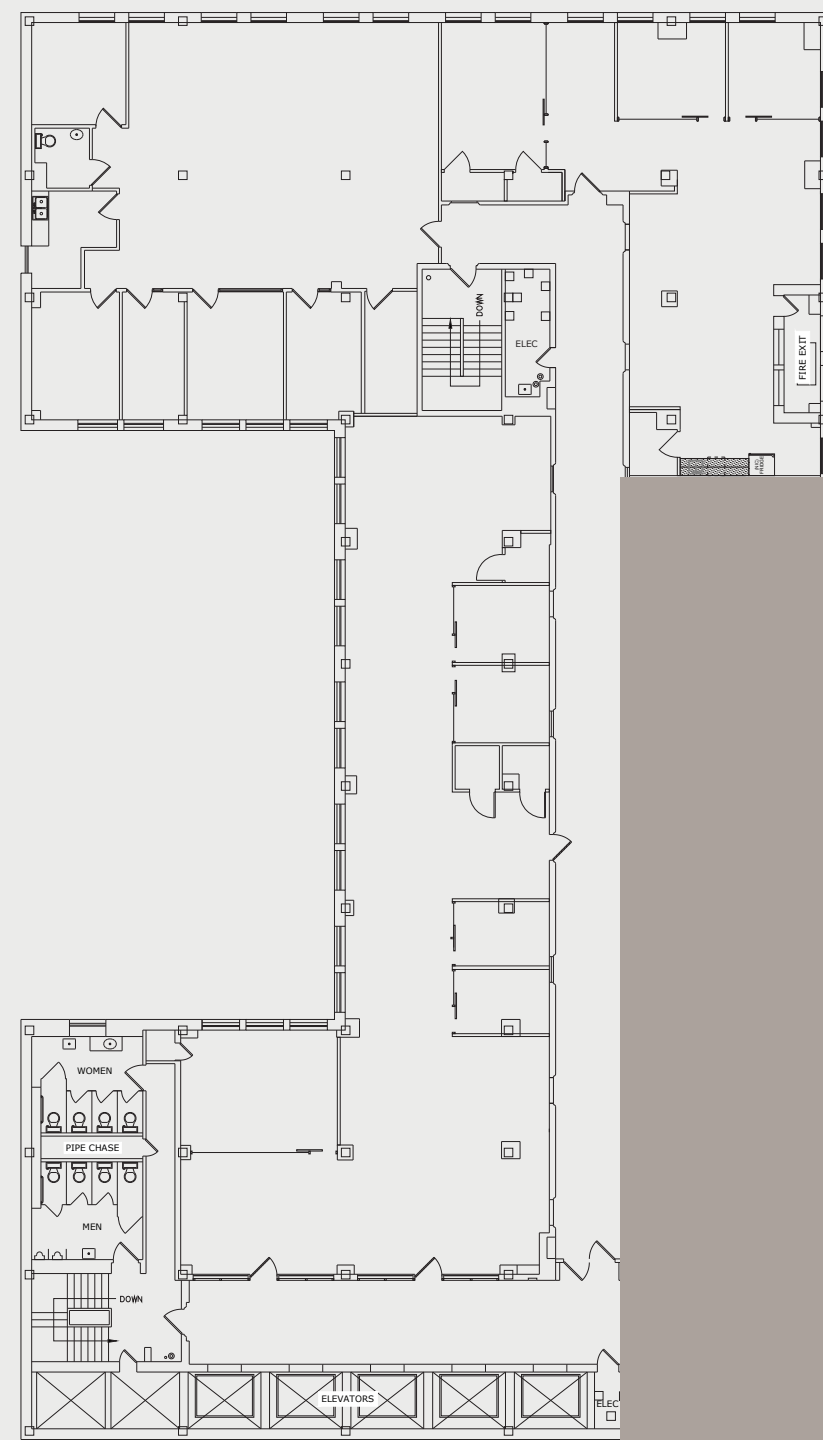

For leasing information please contact:
Andrew Tashjian
213.955.5148 | andrew.tashjian@cushwake.com