

SUITE: 410


RSF: 2,094

AS-BUILT CONFIGURATION

| | |
|------------------------|-------|
| OFFICES..... | 2 |
| RECEPTION..... | 1 |
| CONFERENCE ROOMS..... | 1 |
| KITCHEN/BREAKOUT | 1 |
| OPEN WORK AREA..... | +/- 4 |

Not to scale, furniture and appliances not included

KEY PLAN

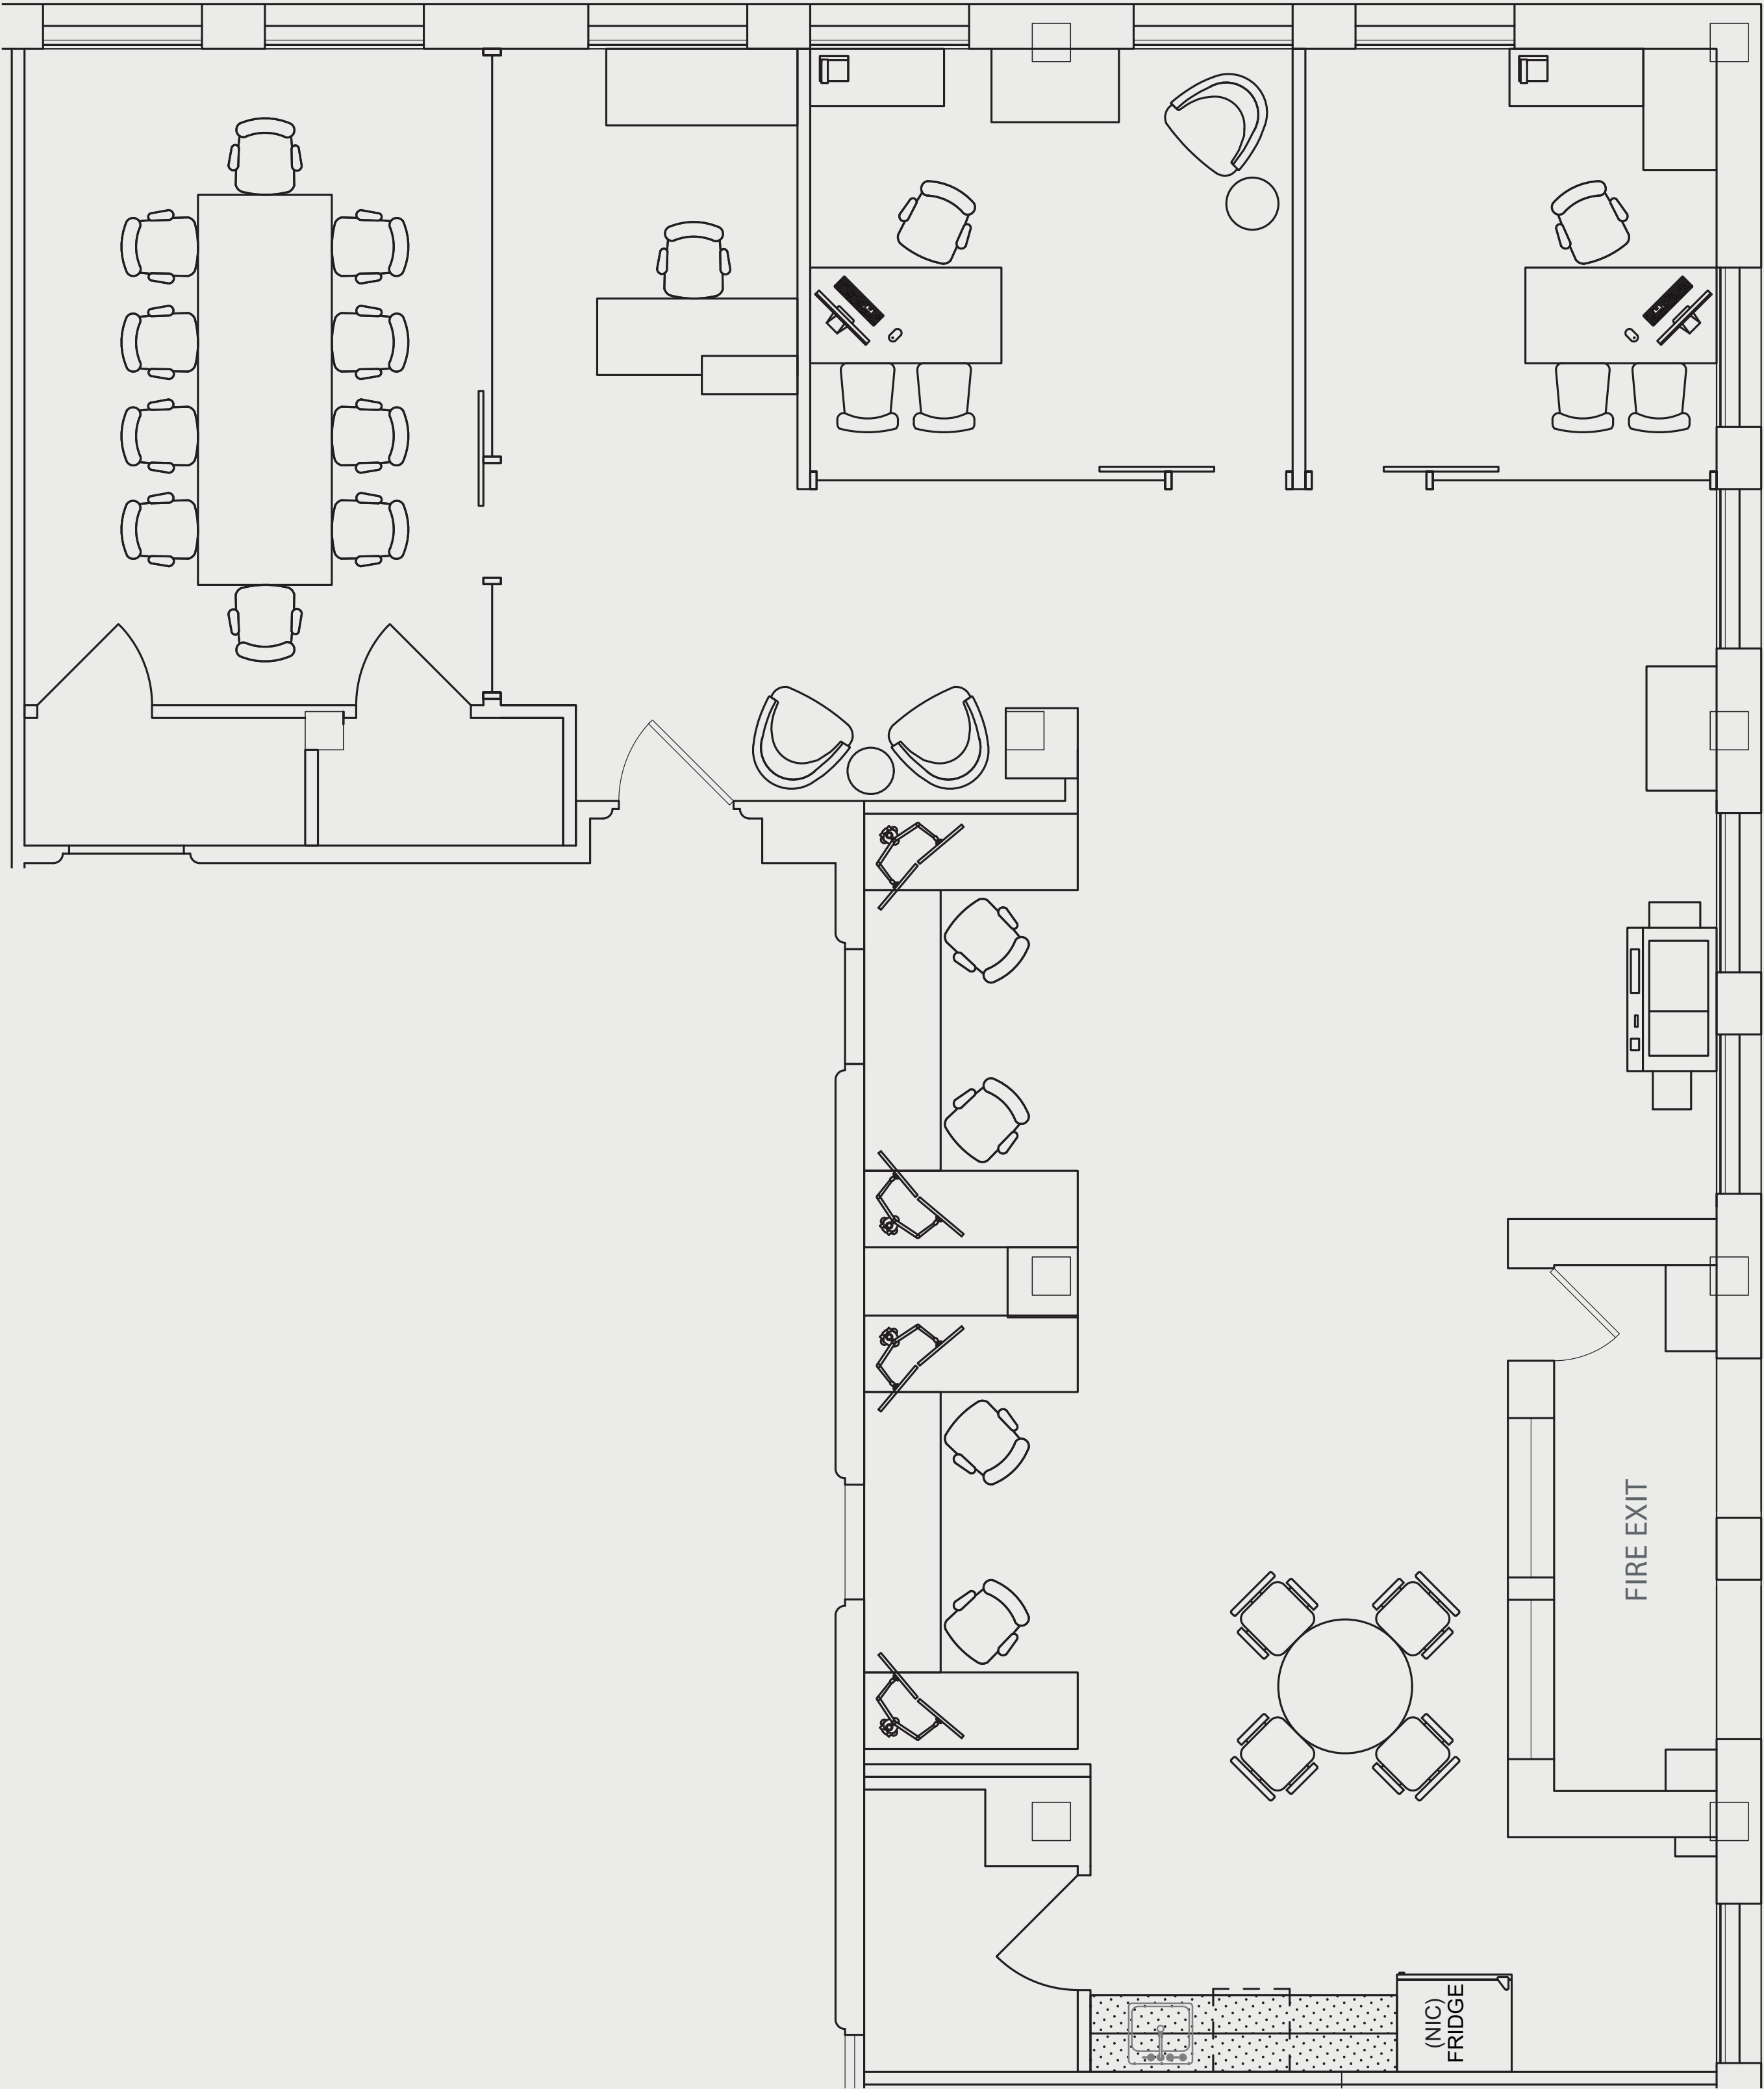

For leasing information please contact:
USALEASING@ONNI.COM
(213) 629-2041