



2 TYPICAL PARKING ISLAND DETAIL
SCALE: 1/4"=1'-0"

CODE	DESCRIPTION	SIZE	QUANTITY
A	PLANTING	12" DIA	10
B	PLANTING	18" DIA	5
C	PLANTING	24" DIA	3
D	PLANTING	36" DIA	2
E	PLANTING	48" DIA	1
F	PLANTING	60" DIA	1
G	PLANTING	72" DIA	1
H	PLANTING	84" DIA	1
I	PLANTING	96" DIA	1
J	PLANTING	108" DIA	1
K	PLANTING	120" DIA	1
L	PLANTING	132" DIA	1
M	PLANTING	144" DIA	1
N	PLANTING	156" DIA	1
O	PLANTING	168" DIA	1
P	PLANTING	180" DIA	1
Q	PLANTING	192" DIA	1
R	PLANTING	204" DIA	1
S	PLANTING	216" DIA	1
T	PLANTING	228" DIA	1
U	PLANTING	240" DIA	1
V	PLANTING	252" DIA	1
W	PLANTING	264" DIA	1
X	PLANTING	276" DIA	1
Y	PLANTING	288" DIA	1
Z	PLANTING	300" DIA	1


1 PROPOSED SITE PLAN
SCALE: 1"=50'

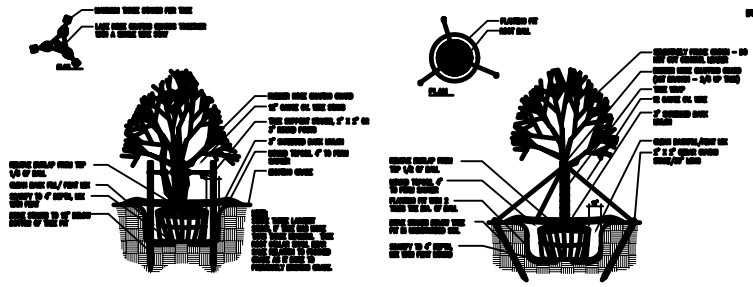


3 PLANTING DETAILS
NOT TO SCALE

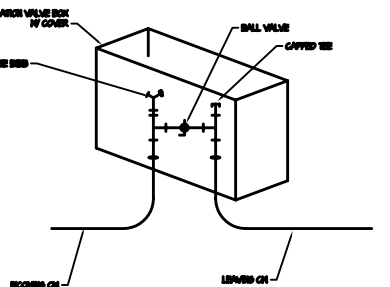

4 SITE IRRIGATION VALVE BOX
SCALE: NTS

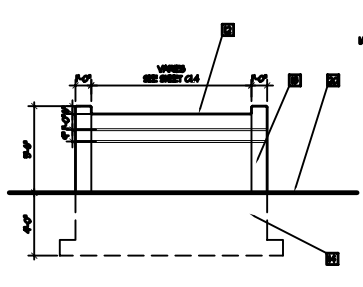

5 TYPICAL PRIVACY WALL ELEVATION
SCALE: 1/4"=1'-0"

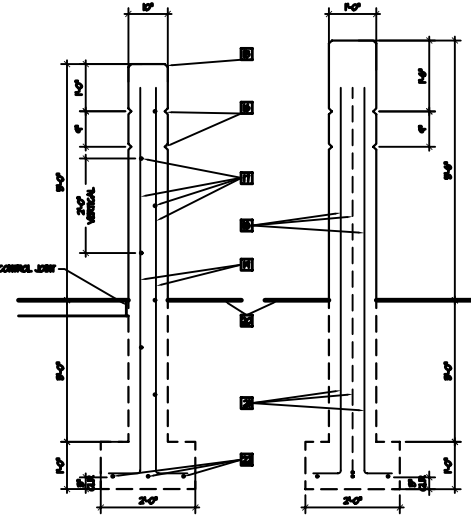

6 PRIVACY WALL SECTIONS
SCALE: 3/4"=1'-0"

- ### KEYNOTES
1. SEE PLAN - GRASS
 2. SURFACE
 3. REINFORCED CONCRETE
 4. REINFORCED CONCRETE
 5. FLAG POLES - SEE ACCESS FOR DETAIL
 6. FINISHED SURFACE
 7. FINISH STOPS AT SIDES OF PLANNED AREA
 8. KEY HOLE
 9. GRADED DOCK
 10. FINANCY WALL APPROX. 1'-0" - SEE BAZEL FOR DETAIL
 11. 2" DEEP BRUSHED IRON 4" WIDE CURB FLANK FINISH AT PERIMETER OF BUILDING AS SHOWN
 12. FINISH CONCRETE SURFACE TO BE GRATED
 13. CONCRETE FOOT
 14. CONCRETE FOOTING 4' PERIMETER BELONG GARAGE
 15. 1/2" COVER (TYP)
 16. 1/2" DEEP FINISH
 17. 1/4" FINISH
 18. 1/4" FINISH VERTICAL @ 2' O.C.
 19. 1/4" @ 12" FINISH
 20. FINISH GRADE
 21. @ 12" SPACED
 22. @ 12" CONCRETE
 23. KEY HOLE
 24. FINANCY VALVE BOX W/ COVER
 25. FINANCY W/ 1/2" WELCH
 26. CONCRETE PAVED

- ### GENERAL NOTES
1. ALL FINISHES IN UNDERGROUND SHALL BE FINISH, SEE EXISTING TELEPHONE PLANNING.
 2. THE FINISHES PROVIDED PLAN TO INDICATED SPECIES.
 3. THE CONTRACTOR RESPONSIBLE TO EXIST FINISHES TO FINISH 1'-0" OF THE BUILDING FOOTPRINT.
 4. BUILDING CONTRACTOR RESPONSIBLE TO INSTALL THE FINISHES BELIEVED FROM A POINT 1'-0" OUTSIDE THE BUILDING FOOTPRINT.
 5. REMOVE ALL UNDERGROUND UTILITY BY 1'-0" OF BUILDING OR FINISH IT COMPLETE WITH THE FINISHES LEVEL, FINISH, OR OTHER PROVISIONS.
 6. ALL FINISHED AREAS EXCEPT WHERE INDICATED FINISH OR TELEPHONE SHALL BE FINISH.

LEGEND

GRASS LANDSCAPING	[Symbol]
CONCRETE SHALL BE FINISHED VIA REINFORCED CONCRETE	[Symbol]
OTHER FINISH AREAS TO BE FINISHED	[Symbol]
FINANCY VALVE BOX	[Symbol]

ARCHITECTURAL SPECTRUM

PROFESSIONAL DESIGN FIRM LICENSE NO. 184-000216 © 2003
 201 W. SPRINGFIELD AVE., SUITE 300 CHAMPAIGN, IL 61820
 phone: (217) 959-4283 fax: 352-6570

COLWELL SYSTEMS

NEW PLANT AND FACILITY - AS BUILT

3310 NORTH DUNCAN ROAD
 CHAMPAIGN, IL 61822

LANDSCAPE PLAN

No.:	Revisions:
Date:	Date:
Drawn: J.L.	Reviewed: NES
Date: 4-19-04	Proj. No. 20346
Sheet:	C2.1