
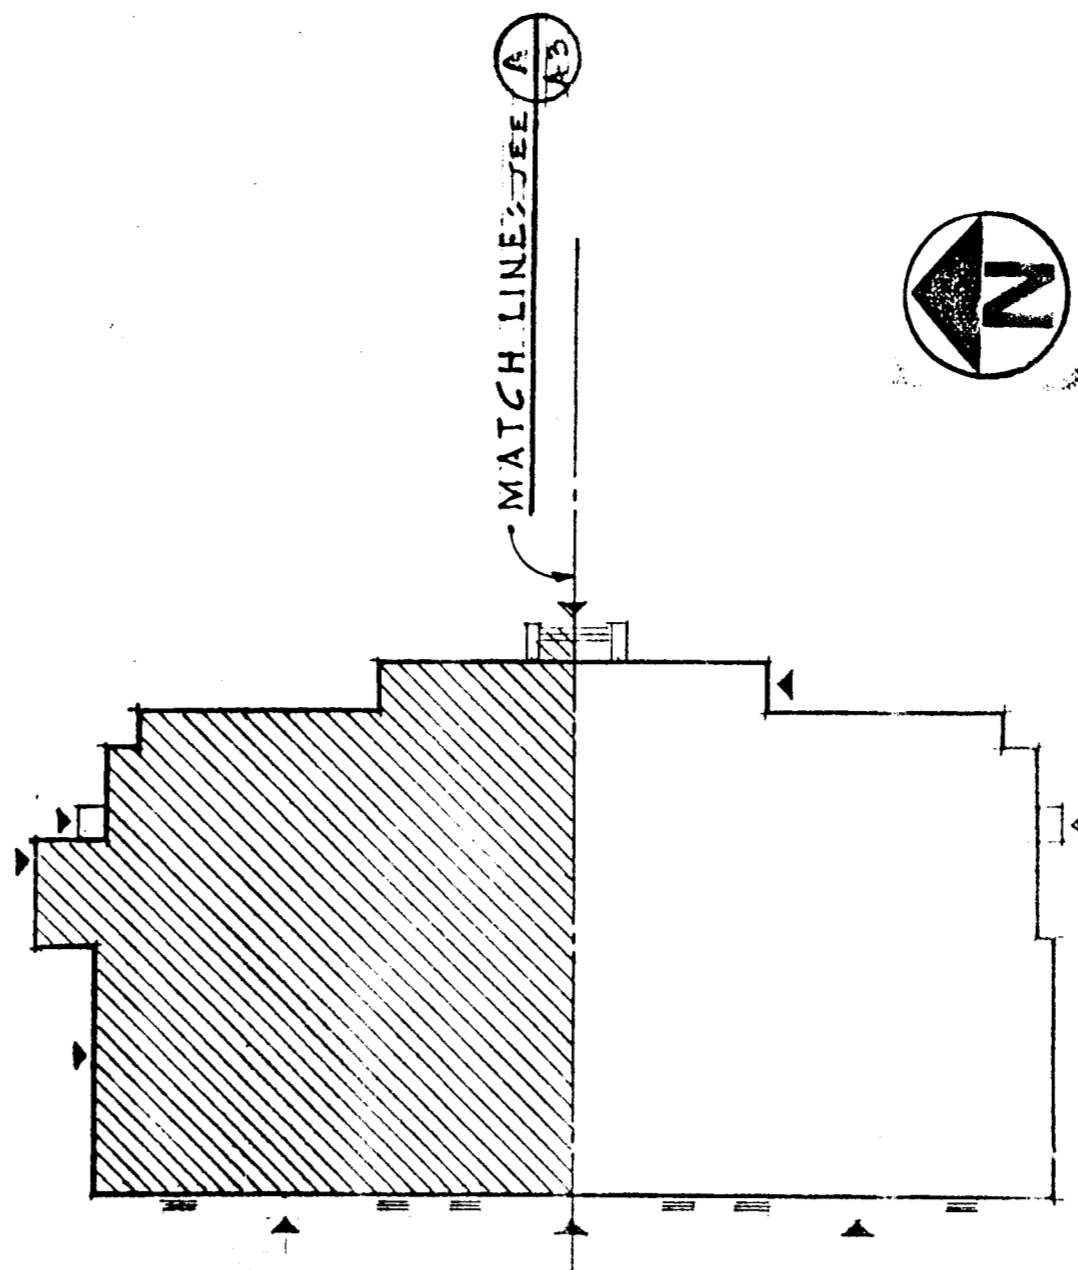


SKETCH TITLE

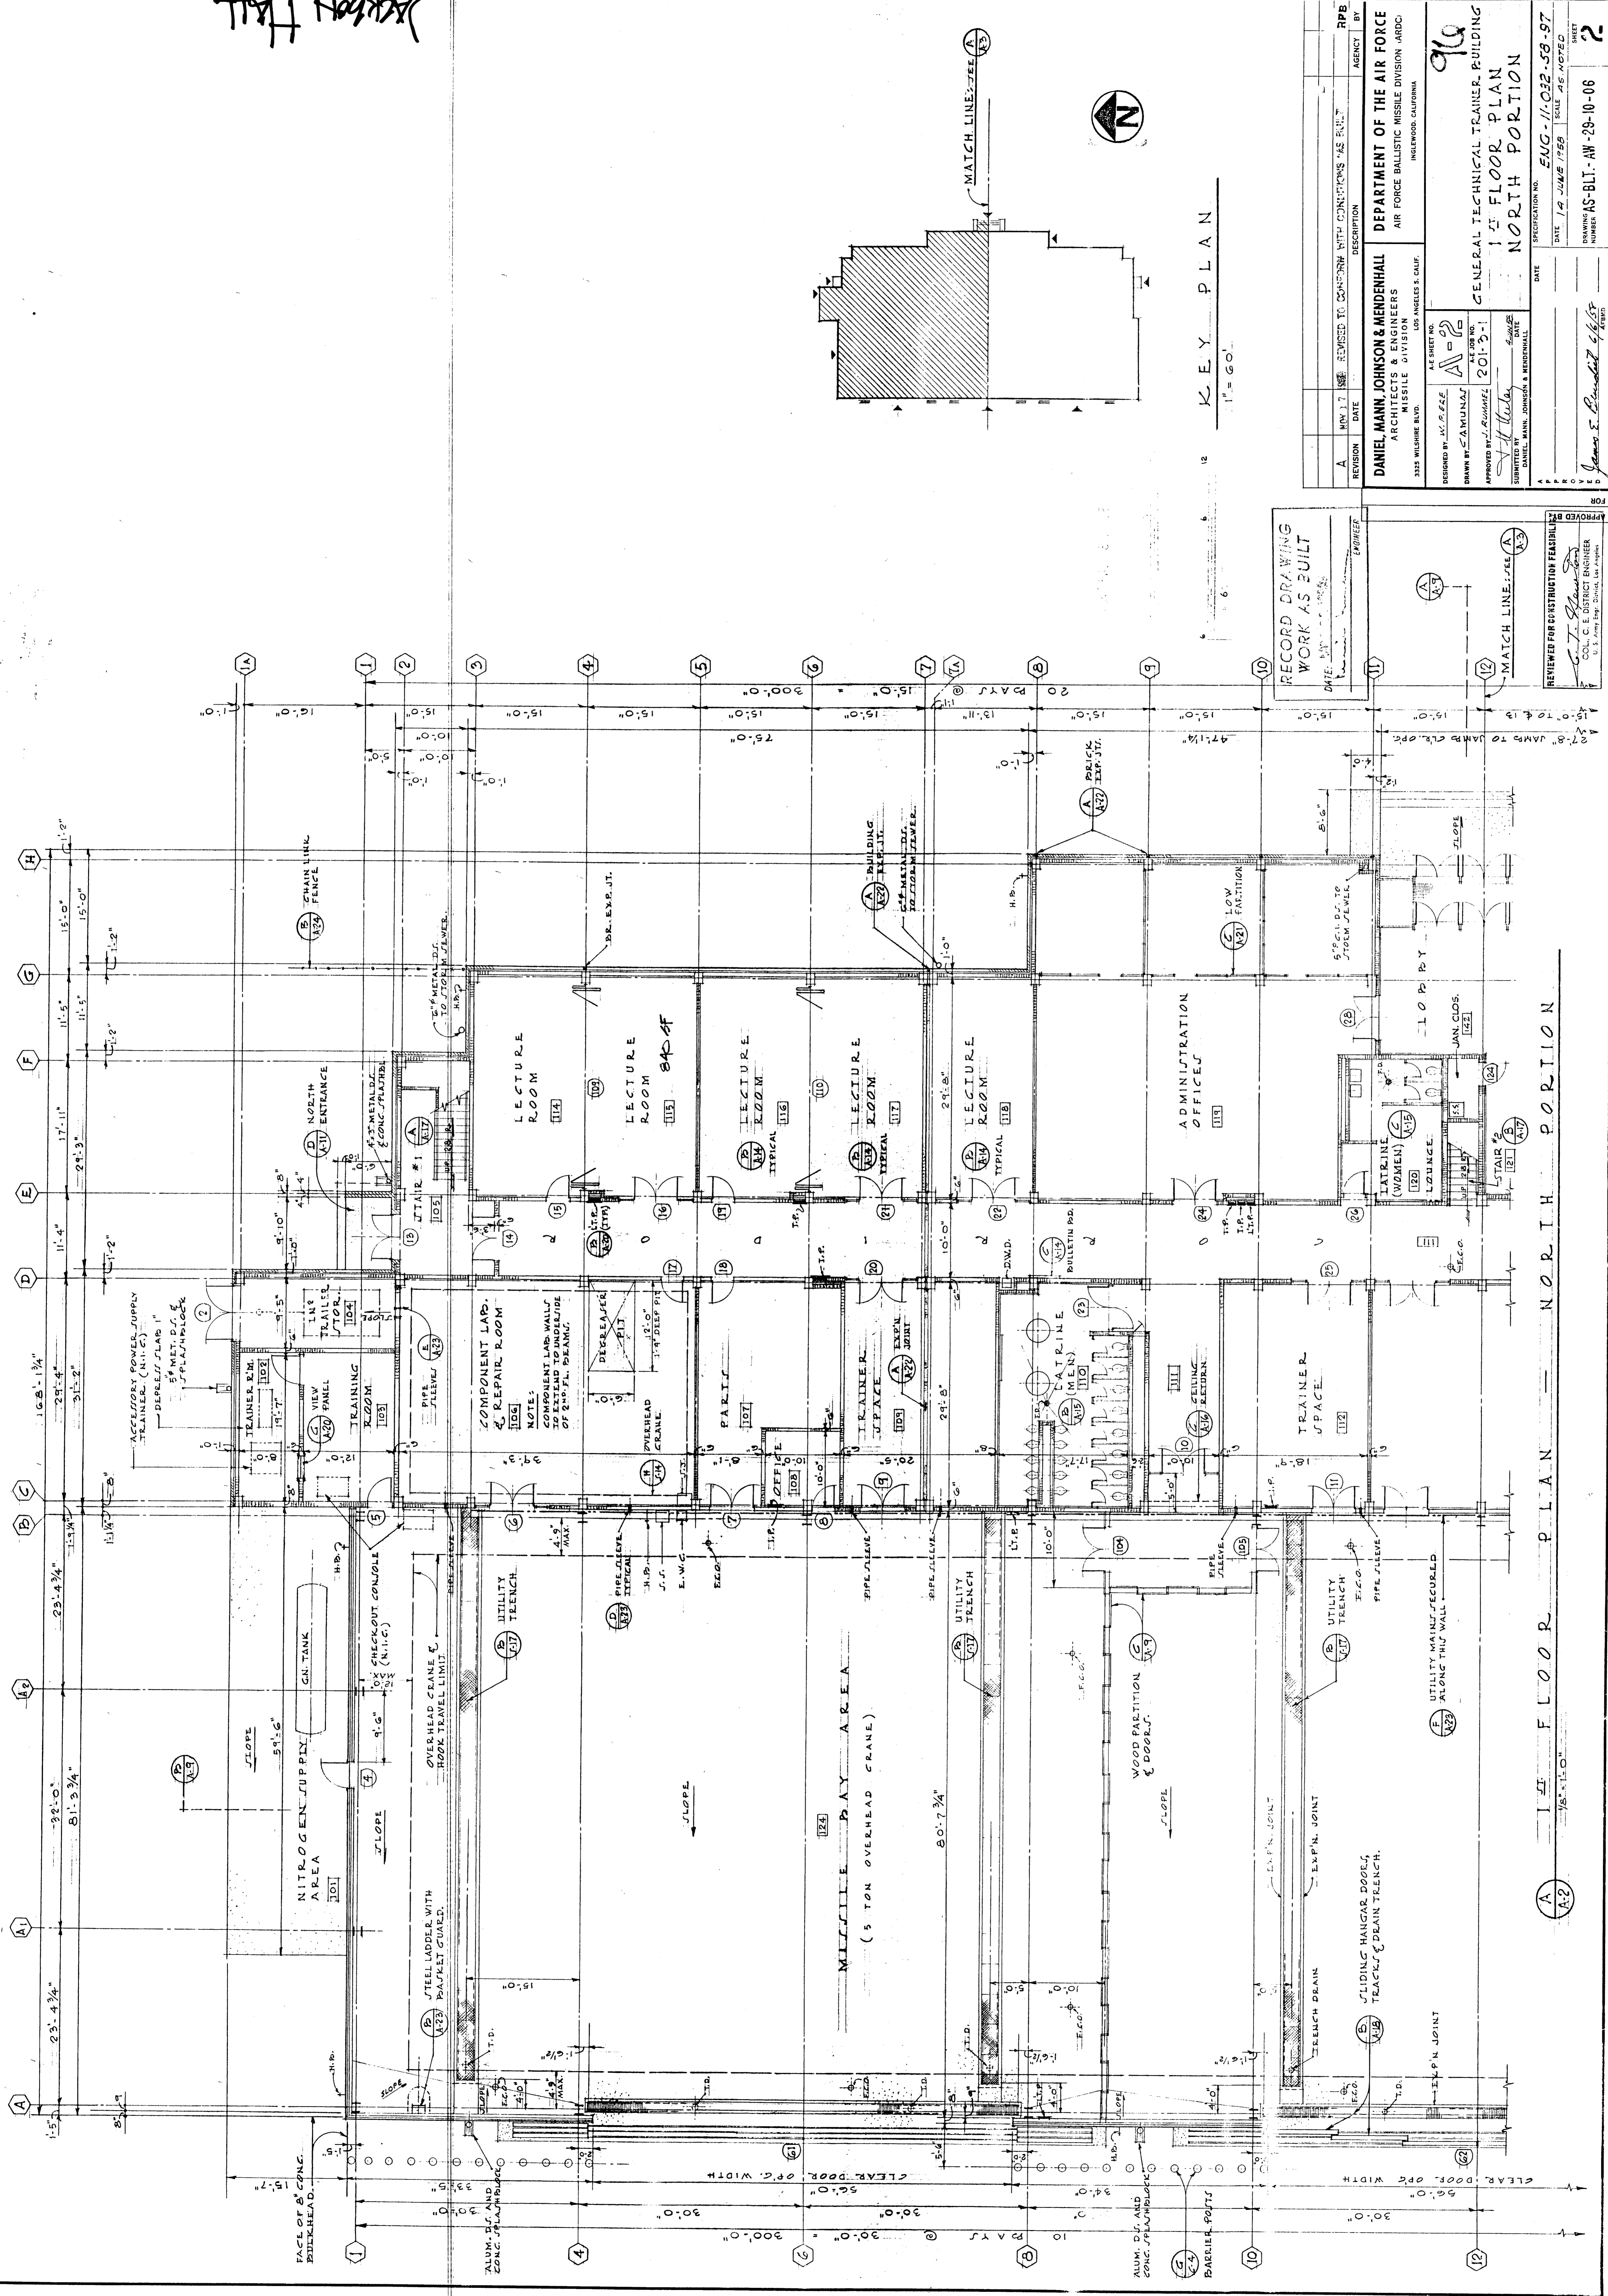

KEY PLAN  
1" = 60'

RECORD DRAWING  
WORK AS BUILT

DATE: 1/2/58  
DRAWN BY: J. R. HARRIS  
CHECKED BY: J. R. HARRIS  
REVIEWER FOR CONSTRUCTION FEASIBILITY: [Signature]  
COL. C. E. DISTRICT ENGINEER  
U.S. AIR FORCE, WRIGHT-PATTERSON AIR FORCE BASE, OHIO

REVISION	DATE	DESCRIPTION	BY
A	APR 17 1958	REVISED TO CONFORM WITH CONDITIONS 'AS BUILT'	RFB

**DANIEL MANN JOHNSON & MENDENHALL**  
ARCHITECTS & ENGINEERS  
MISSILE DIVISION  
333 WILSHIRE BLVD. LOS ANGELES 5, CALIF.  
INDEPENDENT CONTRACTORS

DESIGNED BY: J. R. HARRIS  
DRAWN BY: J. R. HARRIS  
APPROVED BY: J. R. HARRIS  
DATE: 1/2/58

PROJECT: GENERAL TECHNICAL TRAINER BUILDING  
1<sup>ST</sup> FLOOR PLAN  
NORTH PORTION

AGENCY: DEPARTMENT OF THE AIR FORCE  
AIR FORCE BALLISTIC MISSILE DIVISION (ARDC)  
INDEPENDENT CONTRACTORS

DATE: 1/2/58  
SPECIFICATION NO.: ENG-11-032-58-97  
DRAWING NUMBER: AS-BLT-AW-29-10-06  
SHEET: 2

1<sup>ST</sup> FLOOR PLAN - NORTH PORTION