

EQUIPMENT & FACILITIES MAINTENANCE BUILDING

PORT OF TACOMA



PORT OF TACOMA COMMISSION, P.O. BOX 1837, TACOMA, WASHINGTON 984
COMMISSIONERS

COMMISSIONERS

PRESIDENT - - - - ROBERT G. EARLEY
VICE-PRESIDENT - - - - WALTER R. GOTTEH
SECRETARY - - - - RICHARD D. SMITH

GENERAL MANAGER--E. L. PERRY
CHIEF ENGINEER--P. L. MOSMAN

ARCHITECT - KRONA, ZIEGLER & ASSOC., 3502 S. 15TH ST., TACOMA, WA. 98405
STRUCTURAL ENGINEER - NOEL R. ADAMS, P.E. & ASSOC. INC., 2719 ROCHESTER ST. W., TACOMA, WA. 98406
MECH. & ELEC. ENGINEER - ARNOLD N. BOGUE & ASSOC., 4041 RUSTON WAY, TACOMA, WA. 98408

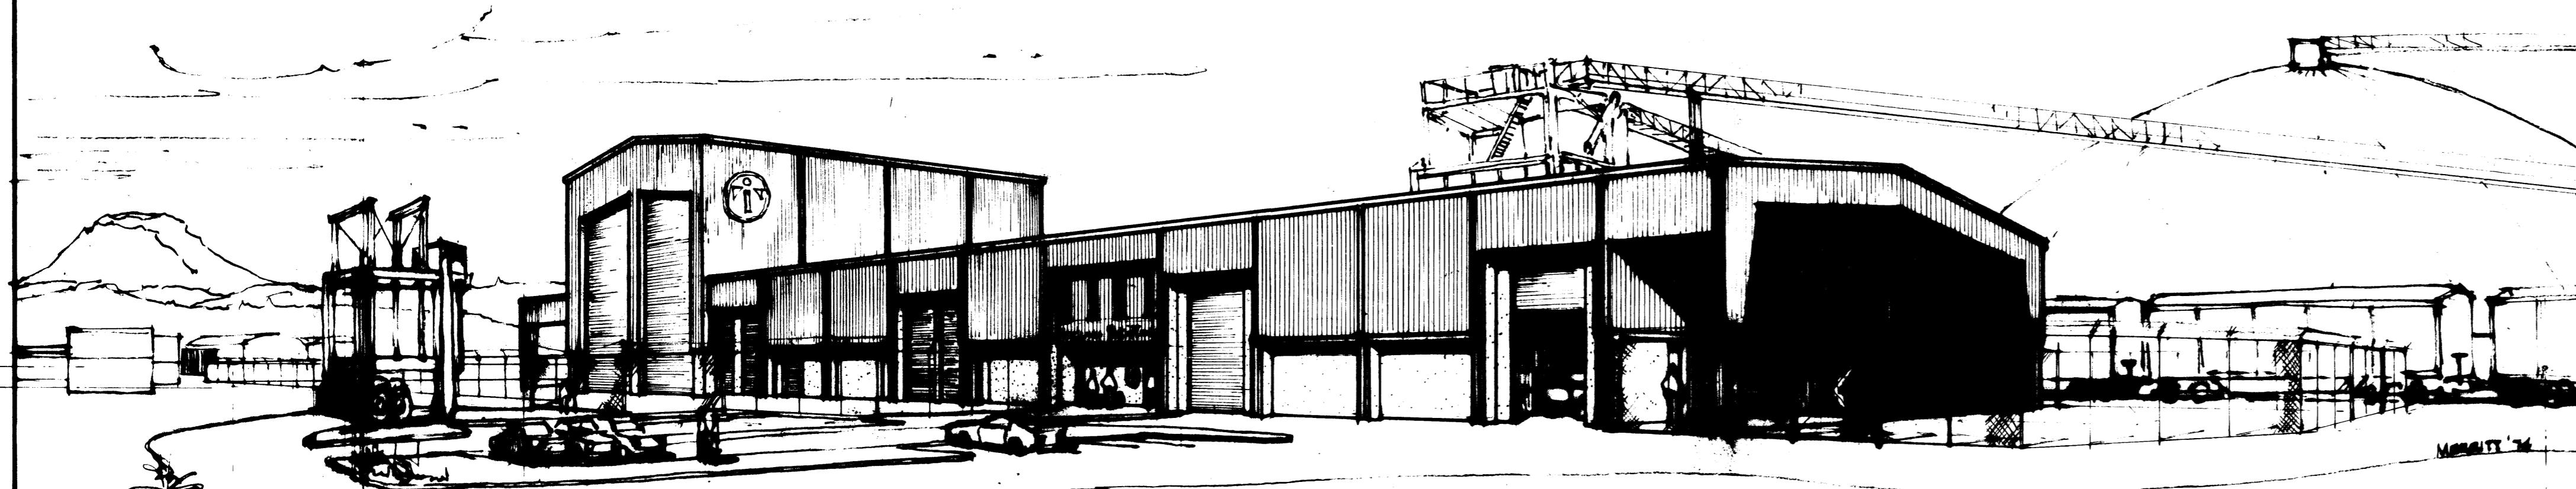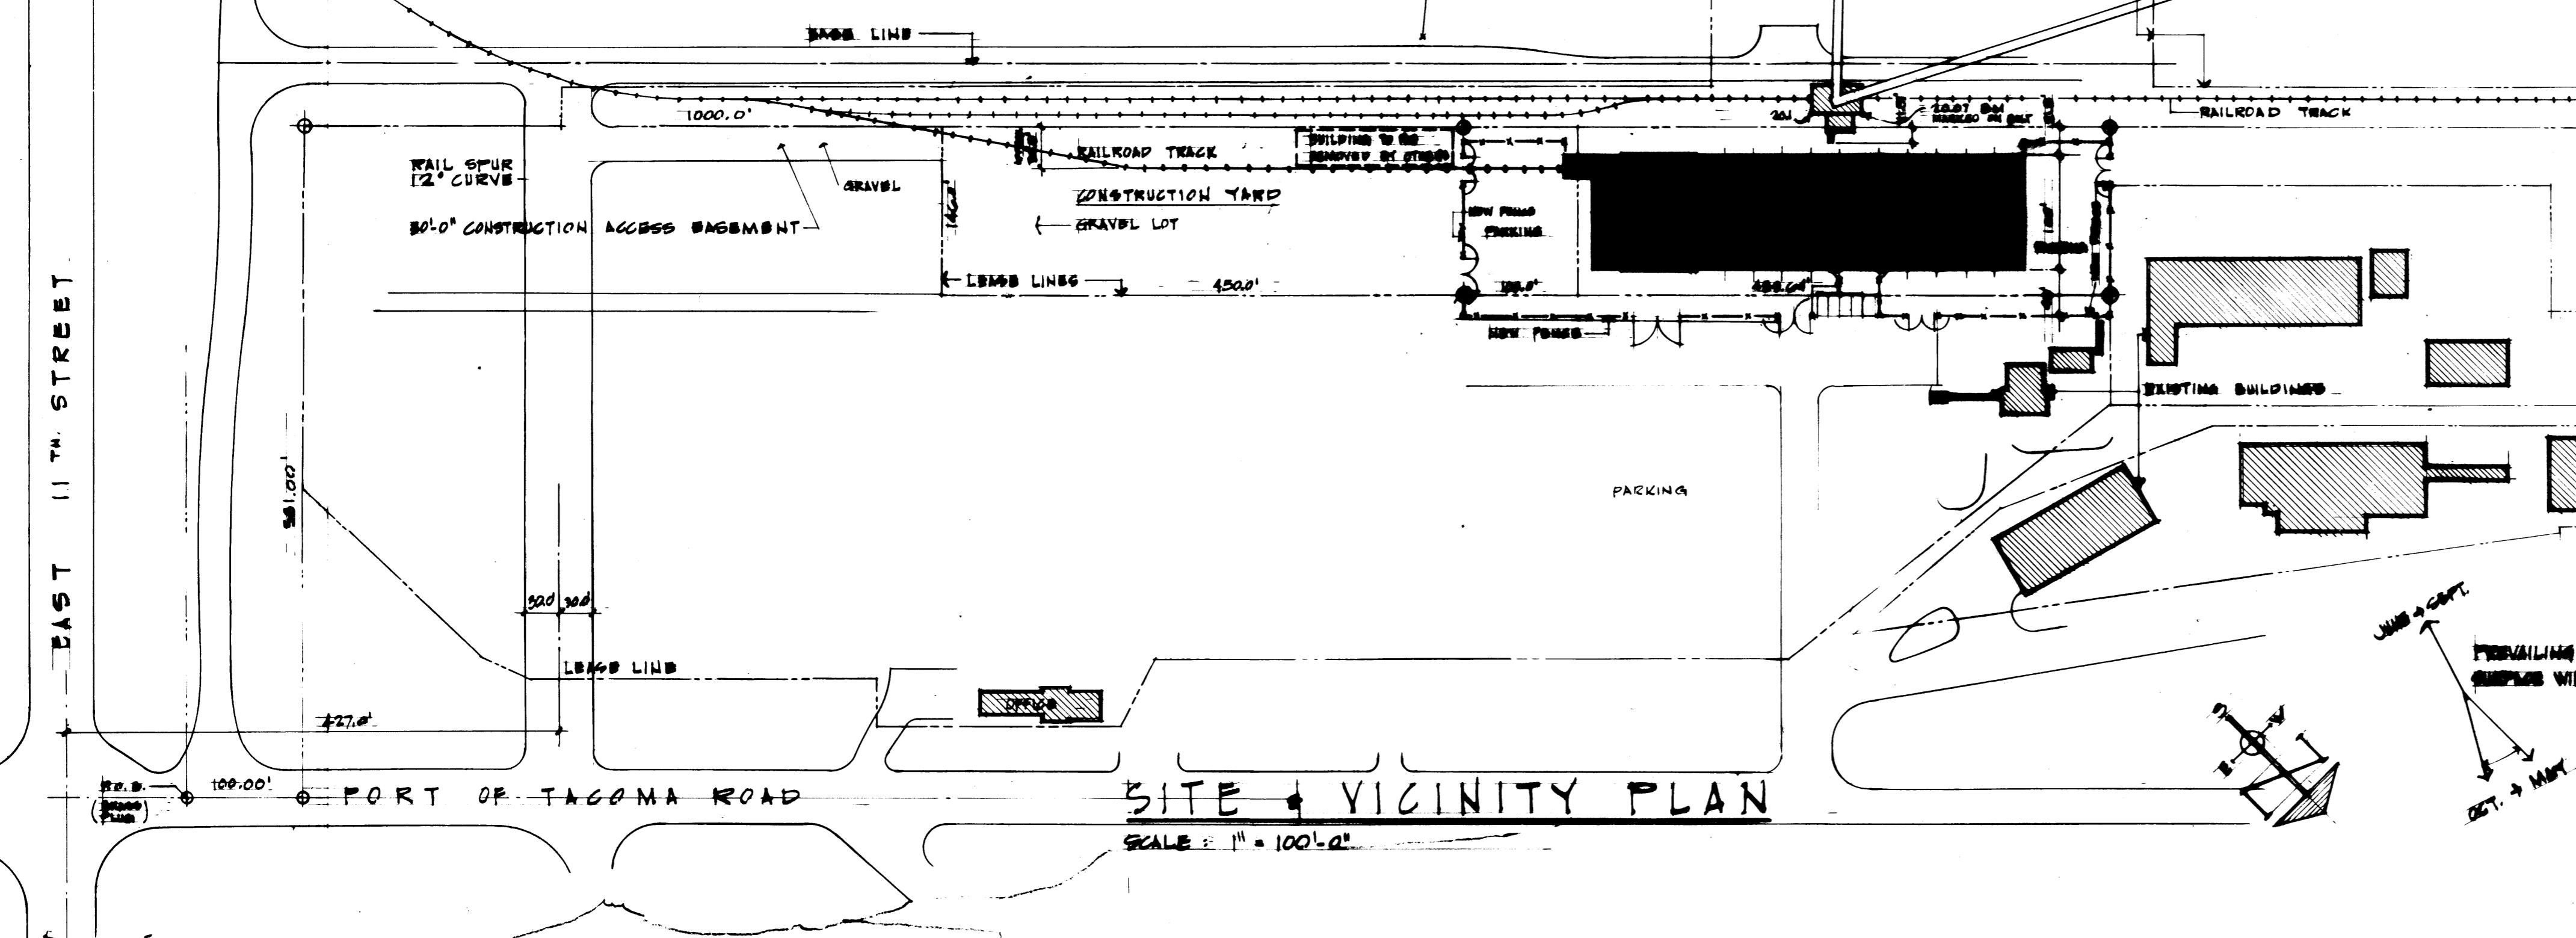



VIEW FROM NORTH
PORT OF TACOMA ROAD


PROJECT INFORMATION

INDEX OF DRAWINGS

GENERAL		PHASE
1. PROJECT LOCATION: 1000 FIRST AV TACOMA BLD.		
2. OWNER ADDRESS: 1000 FIRST AV TACOMA, WA 98401		
3. LAND DESCRIPTION: ONE ACRE		
4. TYPE OF PROJECT: BUILDING FOR MAINT.		
PLUS PARKING IN YARD AREA, THREE		
BUILDING FEATURES:		
I. EQUIPMENT MAINTENANCE		
II. OFFICES, LUNCHROOM, LOUNGE ROOM.		
III. FACILITIES MAINTENANCE		
5. PLOT SIZE: 161.5 FT. X 339.64 FT. = 53,581.86 SF.		
6. ADDITIONAL AREA FOR CONSTRUCTION:		
PARKING: 146.0 FT. X 480.0 FT. = 69,760.0 SF.		
7. ENVIRONMENTAL ASSESSMENT		
SUMMITTED: JULY 25, 1974		
NEGATIVE DECLARATION: SEPT. 19, 1974		
DESIGN CRITERIA		
1. BUILDING CODE: U.B.C. (1975) AS AMENDED		
BY CITY OF TACOMA.		
2. OCCUPANCY		
P-1: I. EQUIP. MAINT.		
P-2: II. OFFICES, ETC.		
P-3: III. FACILITIES MAINT.		
3. ZONING: M-5		
4. SETBACKS: NONE REQUIRED		
PROVIDED: S.W. = 21.5', N.E. = 24.5',		
N.W. = 75.0', S.E. = 112.64'		
5. LOT COVERAGE: 47.2%		
6. FIRE ZONE: 3		
7. FIRE PROTECTION: SPRINKLERED, FIRE ALARM SYSTEM.		
8. TYPE OF CONSTRUCTION: III		
9. FIRE RESISTANCE: 1 HOUR		
10. TYPE OF SOIL: ORIGINAL, UNDISTURBED.		
11. HEATING:		
I & III: RADIANT GAS SYSTEM, PERTURBED		
W/ MAKE-UP AIR SYSTEM.		
II: HOT & COLD W/ AIR PERTURBED		
W/ MAKE-UP AIR & MULTI-ZONE UNIT.		
12. FLOOR AREAS:		
I. EQUIP. MAINT. 19,989.0 SF.		
CANOPY 3,000.0 SF		
II. UPPER FLOOR 3,200.0 SF.		
LOWER FLOOR 3,000.0 SF		
III. P.M. MAINT. 11,000.0 SF.		
CANOPY 3,500.0 SF		
TOTALS: 51,225.0 SF. 35,500.0 SF.		
13. BUILDING CAPACITY:		
CODE: 375 ACTUAL: 100		
14. PARKING: SHOPS PER FLOOR + 1/5 = 25		
OFFICES 35 PER 1000 S.F. = 02		
REQUIRED: 47 PROVIDED: 54		
DESIGN LOADS		
1. DESIGN SOIL PRESSURE: 2000 P.S.F. (ASSUMED		
BY ATTITUDE, ANALYSIS WAIVED)		
2. SEISMIC ZONE: 5		
3. EARTHQUAKE LOADING: DUCTILE FRAMING		
4. WIND LOADS: LESS THAN 30' = 20 P.S.F.,		
30'-40' = 25 P.S.F., 50' = 30 P.S.F.		
5. ROOF LIVE LOAD: 25 P.S.F.		
6. FLOOR LIVE LOADS:		
OFFICES: 50 P.S.F. + PARTITIONS 20 P.S.F.		
SHOP IN SHOPS: 200 P.S.F.		
LIBRARY SHELF (MISC. STORAGE): 100 P.S.F.		
LUMBER STORAGE: 200 P.S.F.		
HYDRAULIC CLEANING: 100 P.S.F.		
TIRE & PARTS STORAGE: 250 P.S.F.		
7. LISTING OF SYMBOLS (OPTION NO. IS CLOSET NO.)		
— ROOM/AREA	— WALL SECTION	
— DOOR	— BUILDING SECTION	
— INTERIOR PLN.		
— FLOOR		
— DETAIL		
— SECTION		
— WALL & CEIL TYPE		
8. SHEET CONTENTS		
ARCHITECTURAL		
A-1	MAP, SITE, SITE VIGINTY PLAN, PROSPECTIVE	I, II, III
A-2	LOT & SITE PLAN, SITE DETAILS	I, II, III
A-3	FIRST FLOOR PLAN (W), DETAILS	I
A-4	SECOND FLOOR PLAN (W)	I
A-5	THIRD FLOOR PLAN (W)	I, II, III
A-6	FINISH SCHEDULE, RELITES & DOOR DETAILS	I, II, III
A-7	DOOR & PANEL SCHEDULE, DOOR TYPES, ROLL-UP DR. DTS	I, II, III
A-8	EXT. ELEV. ELEVATIONS (W)	I
A-9	EXT. ELEV. ELEVATIONS (W), WINDOW & DOOR DETAILS	I, II, III
A-10	EXT. ELEV. ELEVATIONS (W), WALL SECTION & DETAILS	I, II, III
A-11	INT. ELEV. ELEVATIONS (W), WALL SECTION & DETAILS	I, II, III
A-12	TIPTICAL WALL SECTION & DETAILS	I, II, III
A-13	FLOOR PLANS (W)	I
A-14	PLAN SECTION "A-A", LADDER & HINGE DETAILS	I
A-15	PLAN SECTION "B-B", HINGE DETAILS	I
A-16	PLAN SECTION "C-C" & "D-D", LADDER PLN & DETAILS	I
A-17	PLAN SECTION "E-E" & "F-F", TRAP STAIRS & DETAILS	I
A-18	INTERIOR ELEVATIONS	I
A-19	FLOOR PLANS (W)	II
A-20	PLAN SECTION "G-G", DETAILS	II
A-21	INTERIOR ELEVATIONS	II
A-22	WALL SECTION & DETAILS	II
A-23	PLAN SECTION "H-H", PARTIAL INTERIOR ELEV. & PLANS	III
A-24	MISS. DETAILS & GRAPHICS	I, II, III
1400A	REVISED SECOND FLOOR OFFICES PLAN	
R-1	NEW RAIL SPUR	I
STRUCTURAL		
S-1	GENERAL NOTES & DESIGN CRITERIA	I, II, III
S-2	FOUNDATION PLAN	I
S-3	FOUNDATION PLAN & FOOTING SCHEDULE	I, II, III
S-4	ROOF FRAMING PLAN	I
S-5	ROOF FRAMING PLAN	I, II, III
S-6	STEEL FRAMING ELEVATIONS	I, II, III
S-7	MISS. STEEL DETAILS	I, II, III
S-8	MISS. CONG. DETAILS	I, II, III
S-9	MISS. WALL SECTION	I, II
S-10	MISS. COLUMN DETAILS	I, II
S-11	MISS. COLUMN & CONG. DETAILS	I, II
S-12	MISS. CONG. DETAILS	I, II
S-13	OFFICE FRAMING PLAN & DETAILS	I
S-14	MISS. OFFICE PLANS, ROOF FRAMING PLANS & DETAILS	I, II
S-15	INTERIOR WALL DETAILS	I, II
MECHANICAL		
M-1	SERVICE PLAN & SITE PLAN	I, II, III
M-2	FOUNDATION PLAN	I
M-3	FOUNDATION PLAN	I, II, III
M-4	FIRST FLOOR PLAN, PLN. SECTION A-A	I
M-5	UPPER LEVEL PLAN - PIPING	I
M-6	UPPER LEVEL PLAN - VENTILATION	I
M-7	FIRST FLOOR PLAN - PIPING & VENTILATION	I
M-8	UPPER LEVEL PLAN - PIPING	I
M-9	UPPER LEVEL PLAN - VENTILATION	I
M-10	FIRST FLOOR & SECOND FLOOR PLANS. PIPE & PLN.	I
M-11	PURGED COILING PLANS - OFFICES, LUNCHROOM, LIB.	I
M-12	COIL PLAN & SECTION B-B	I, II
M-13	ROOF & VENT RISER DIAGRAMS	I, II
M-14	SCHEDULES	I, II, III
2400A	REVISED SECOND FLOOR PLAN	
ELECTRICAL		
E-1	SERVICE PLAN	I, II, III
E-2	LOWER LEVEL PLAN - LIGHTING	I
E-3	UPPER LEVEL PLAN - LIGHTING	I
E-4	LOWER & UPPER LEVEL PLANS - POWER	I
E-5	UPPER LEVEL PLAN - MECHANICAL CONNECTIONS	I
E-6	LOWER & UPPER LEVEL PLANS - LIGHTING	I, II, III
E-7	LOWER & UPPER LEVEL PLANS - POWER	I, II, III
E-8	PURGED COILING PLANS & ELECTRICAL DIAGRAMS	I
E-9	UPPER LEVEL PLAN - MECHANICAL CONN. & DETAILS	I
E-10	SECTION PLANS	I, II, III
E-11	FINAL SCHEDULES	I, II, III
E-12	FINAL SCHEDULES	I, II, III
E-13	REVISED SECOND FLOOR PLAN	


<p>ARNOLD H. ADAMS P.E. & ASSOCIATES 1919 Rochester St. W., Tacoma, Wa. 98466 206-3833 Arnold H. Adams and Associates Mech. & Elect. 1901 Rainier Way, Suite A, Tacoma, Wa. 98402 752-7722</p>		<p>Krone, Ziegler and Associates Architects and Planners, A.I.A.</p> <p>3502 2a. 15th St. Tacoma, Wa. 98406 752-0604</p>	
<p>AS BUILT</p>			
MARK	REVISION	BY	APR. DATE

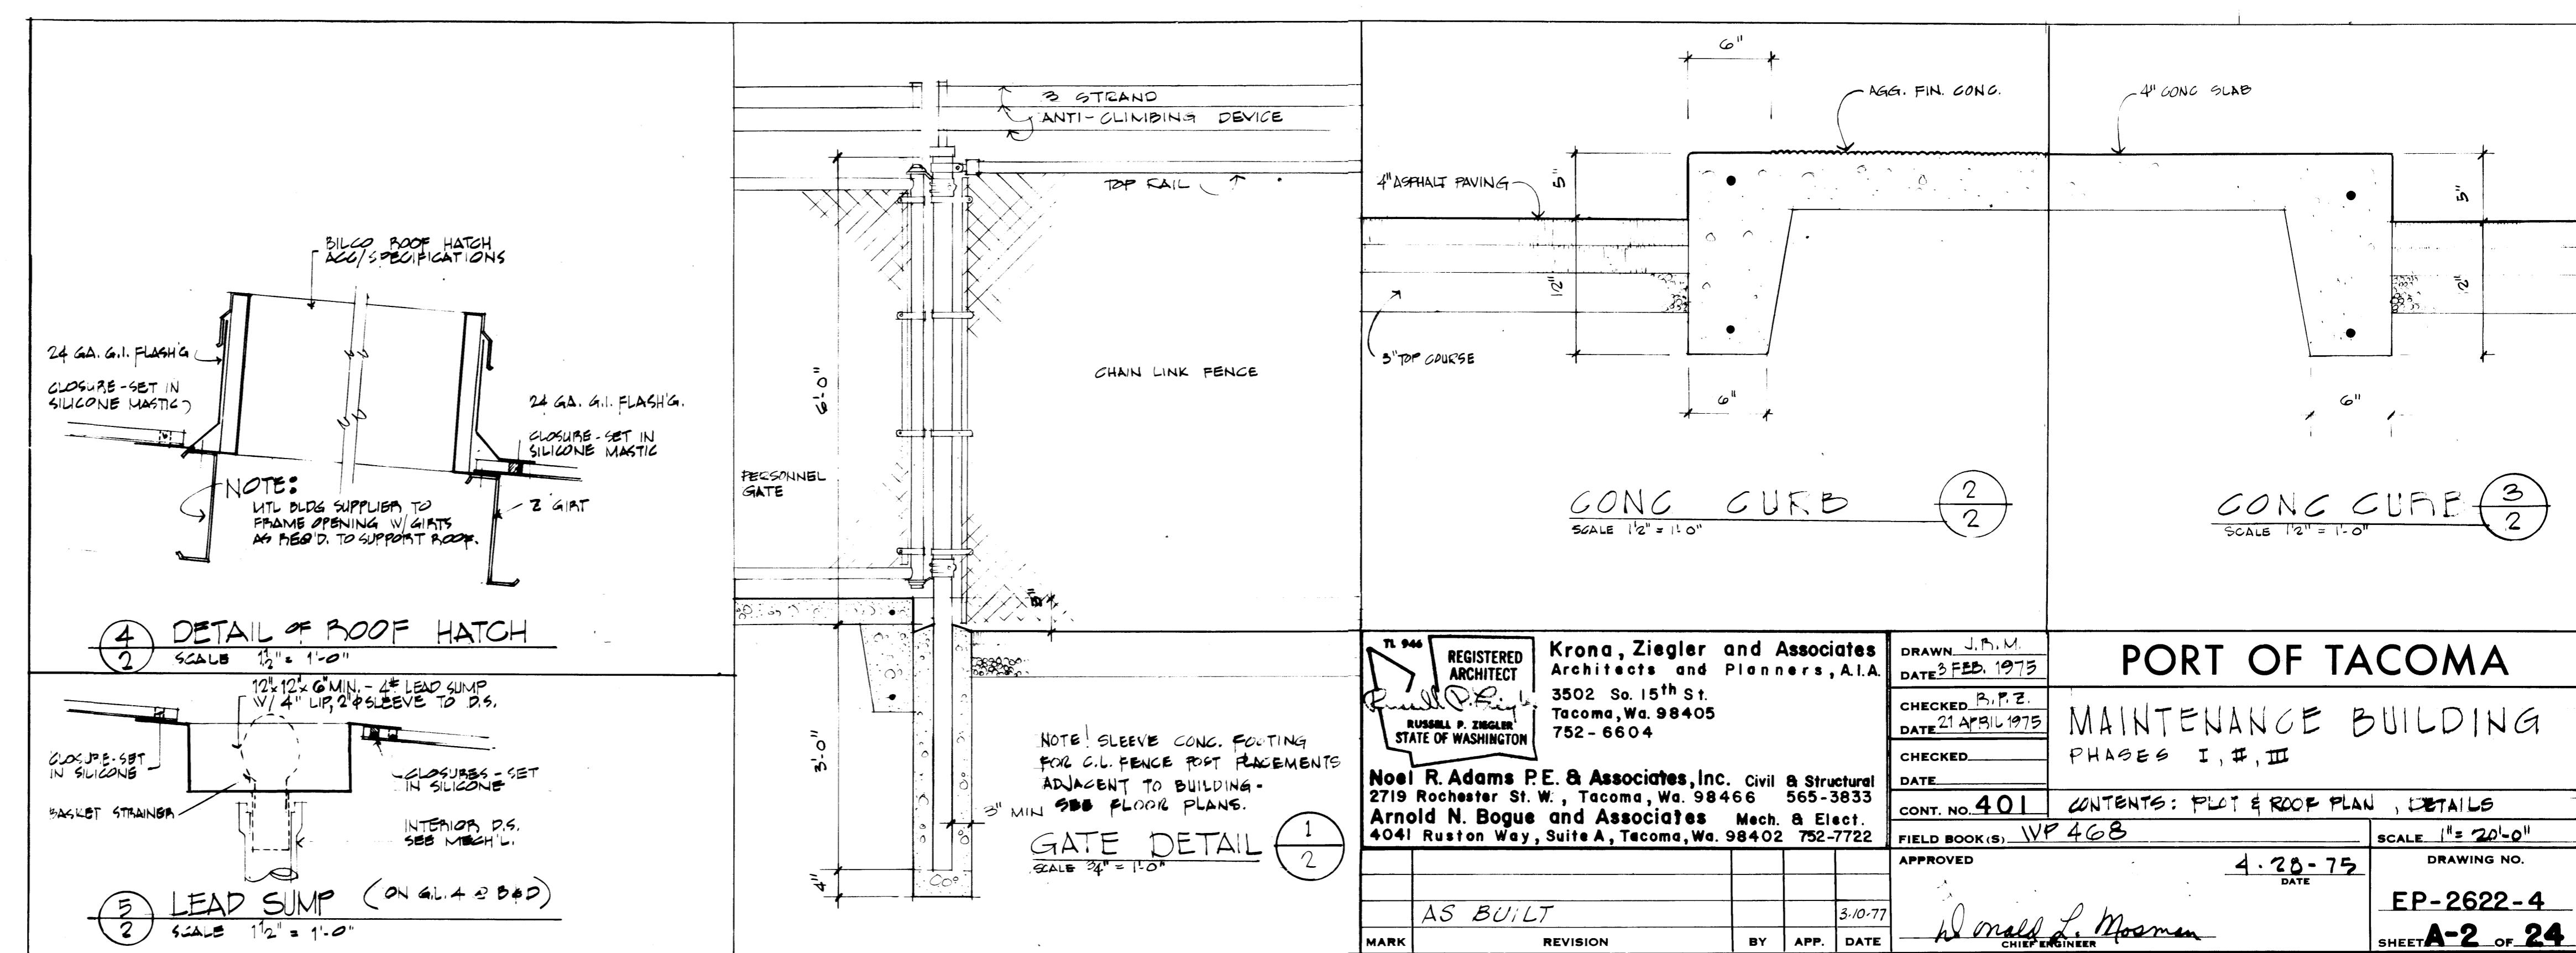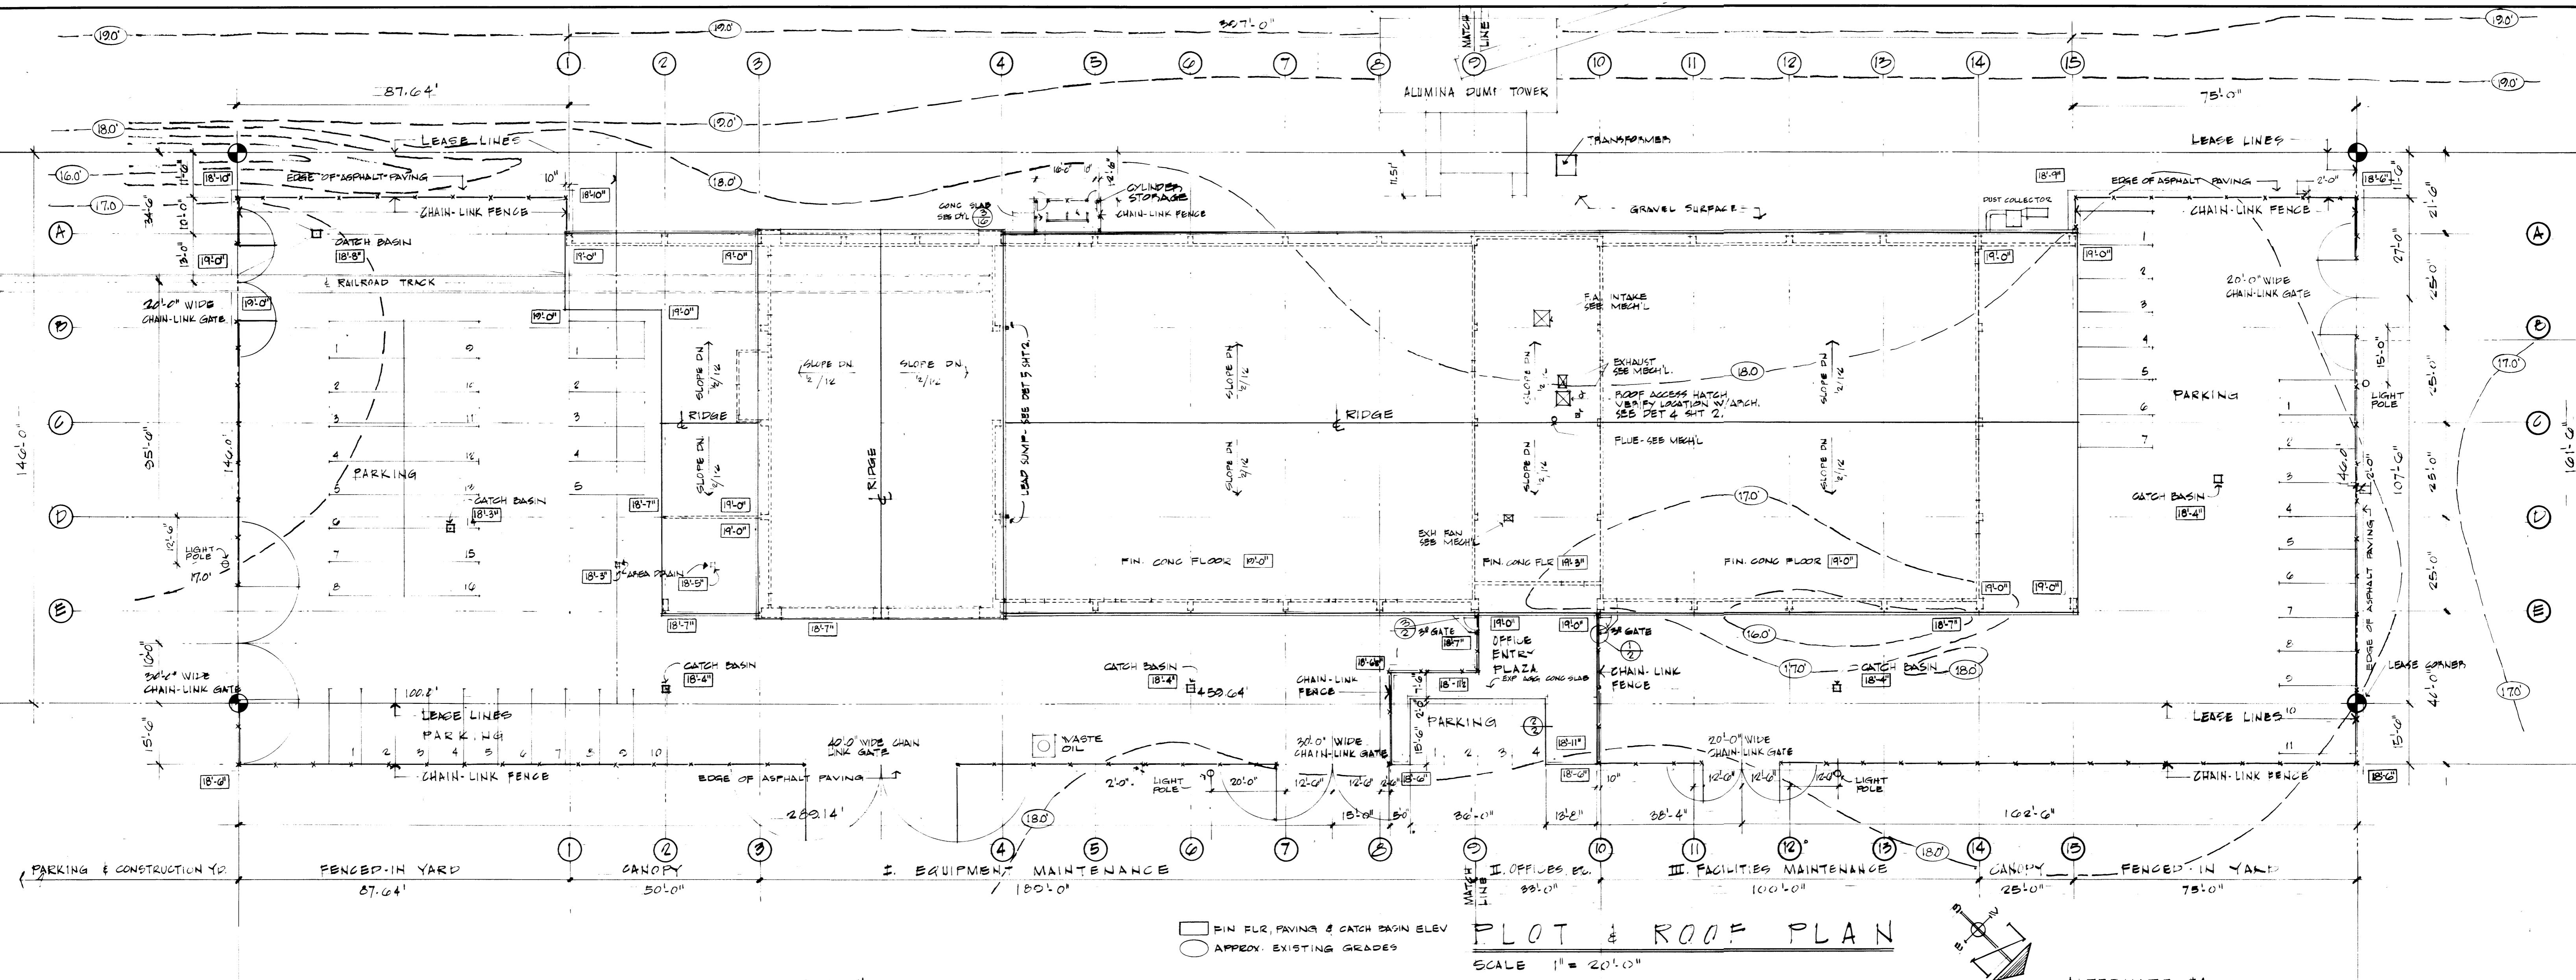

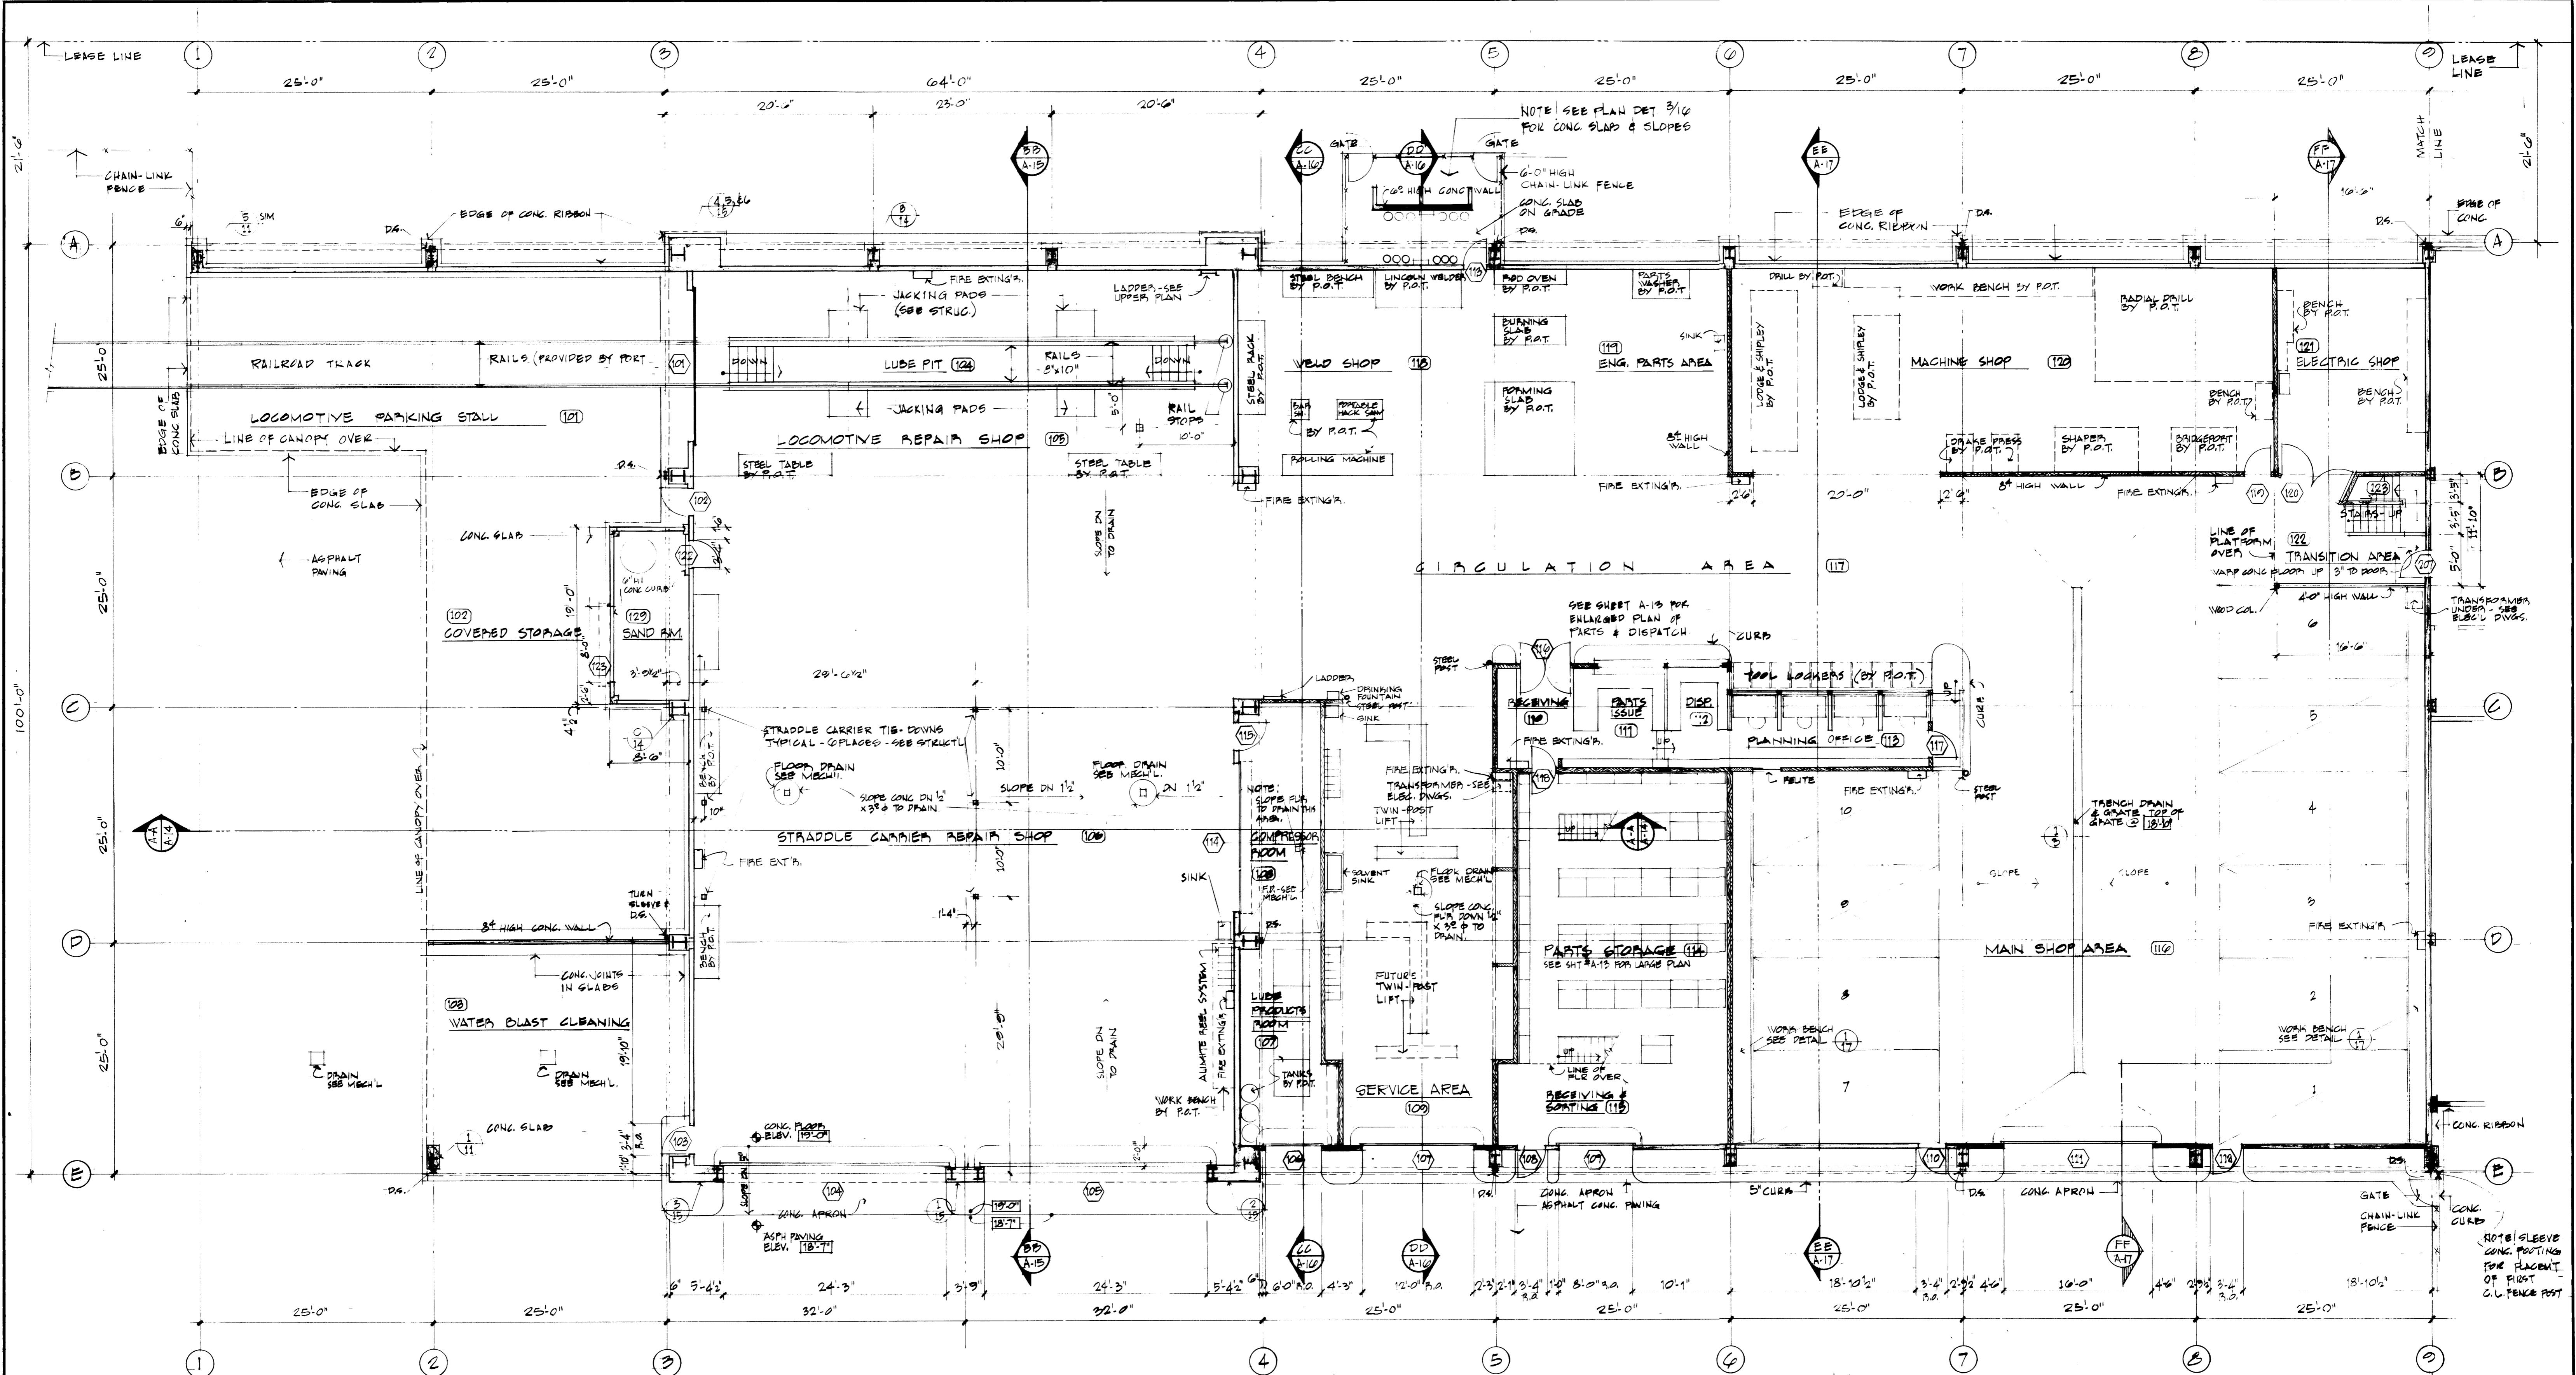


FIRST FLOOR PLAN
I. EQUIPMENT MAINTENANCE

TL 946	REGISTERED ARCHITECT Paul L. Ziegler Krona, Ziegler and Associates Architects and Planners, A.I.A. 3502 So. 15th St. Tacoma, Wa. 98405 STATE OF WASHINGTON	DRAWN J. S. M. 3 FEB 1975
Arnold N. Bogus and Associates Mech. & Elect. 4041 Ruston Way, Suite A, Tacoma, Wa. 98402 752-7722	CHECKED S. P. E. DATE 21 APRIL 1975	
Noel R. Adams P.E. & Associates, Inc. Civil & Structural 2719 Rochester St. W., Tacoma, Wa. 98466 565-3833	CHECKED DATE	
CONT. NO. 401	APPROVED 4-28-75 DATE	
FIELD BOOK (S)		
CONTENTS: FIRST FLOOR PLAN, DETAILS		
DRAWING NO. EP-2622-4		
APPROVED Donald J. Moerman CHIEF ENGINEER		

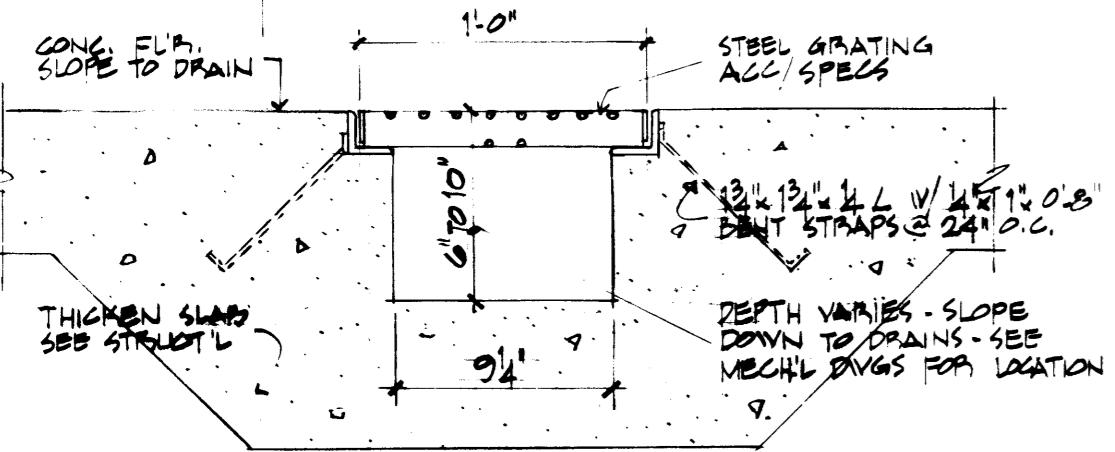


DETAIL OF TRENCH DRAIN
SCALE 1/8" = 1'-0"

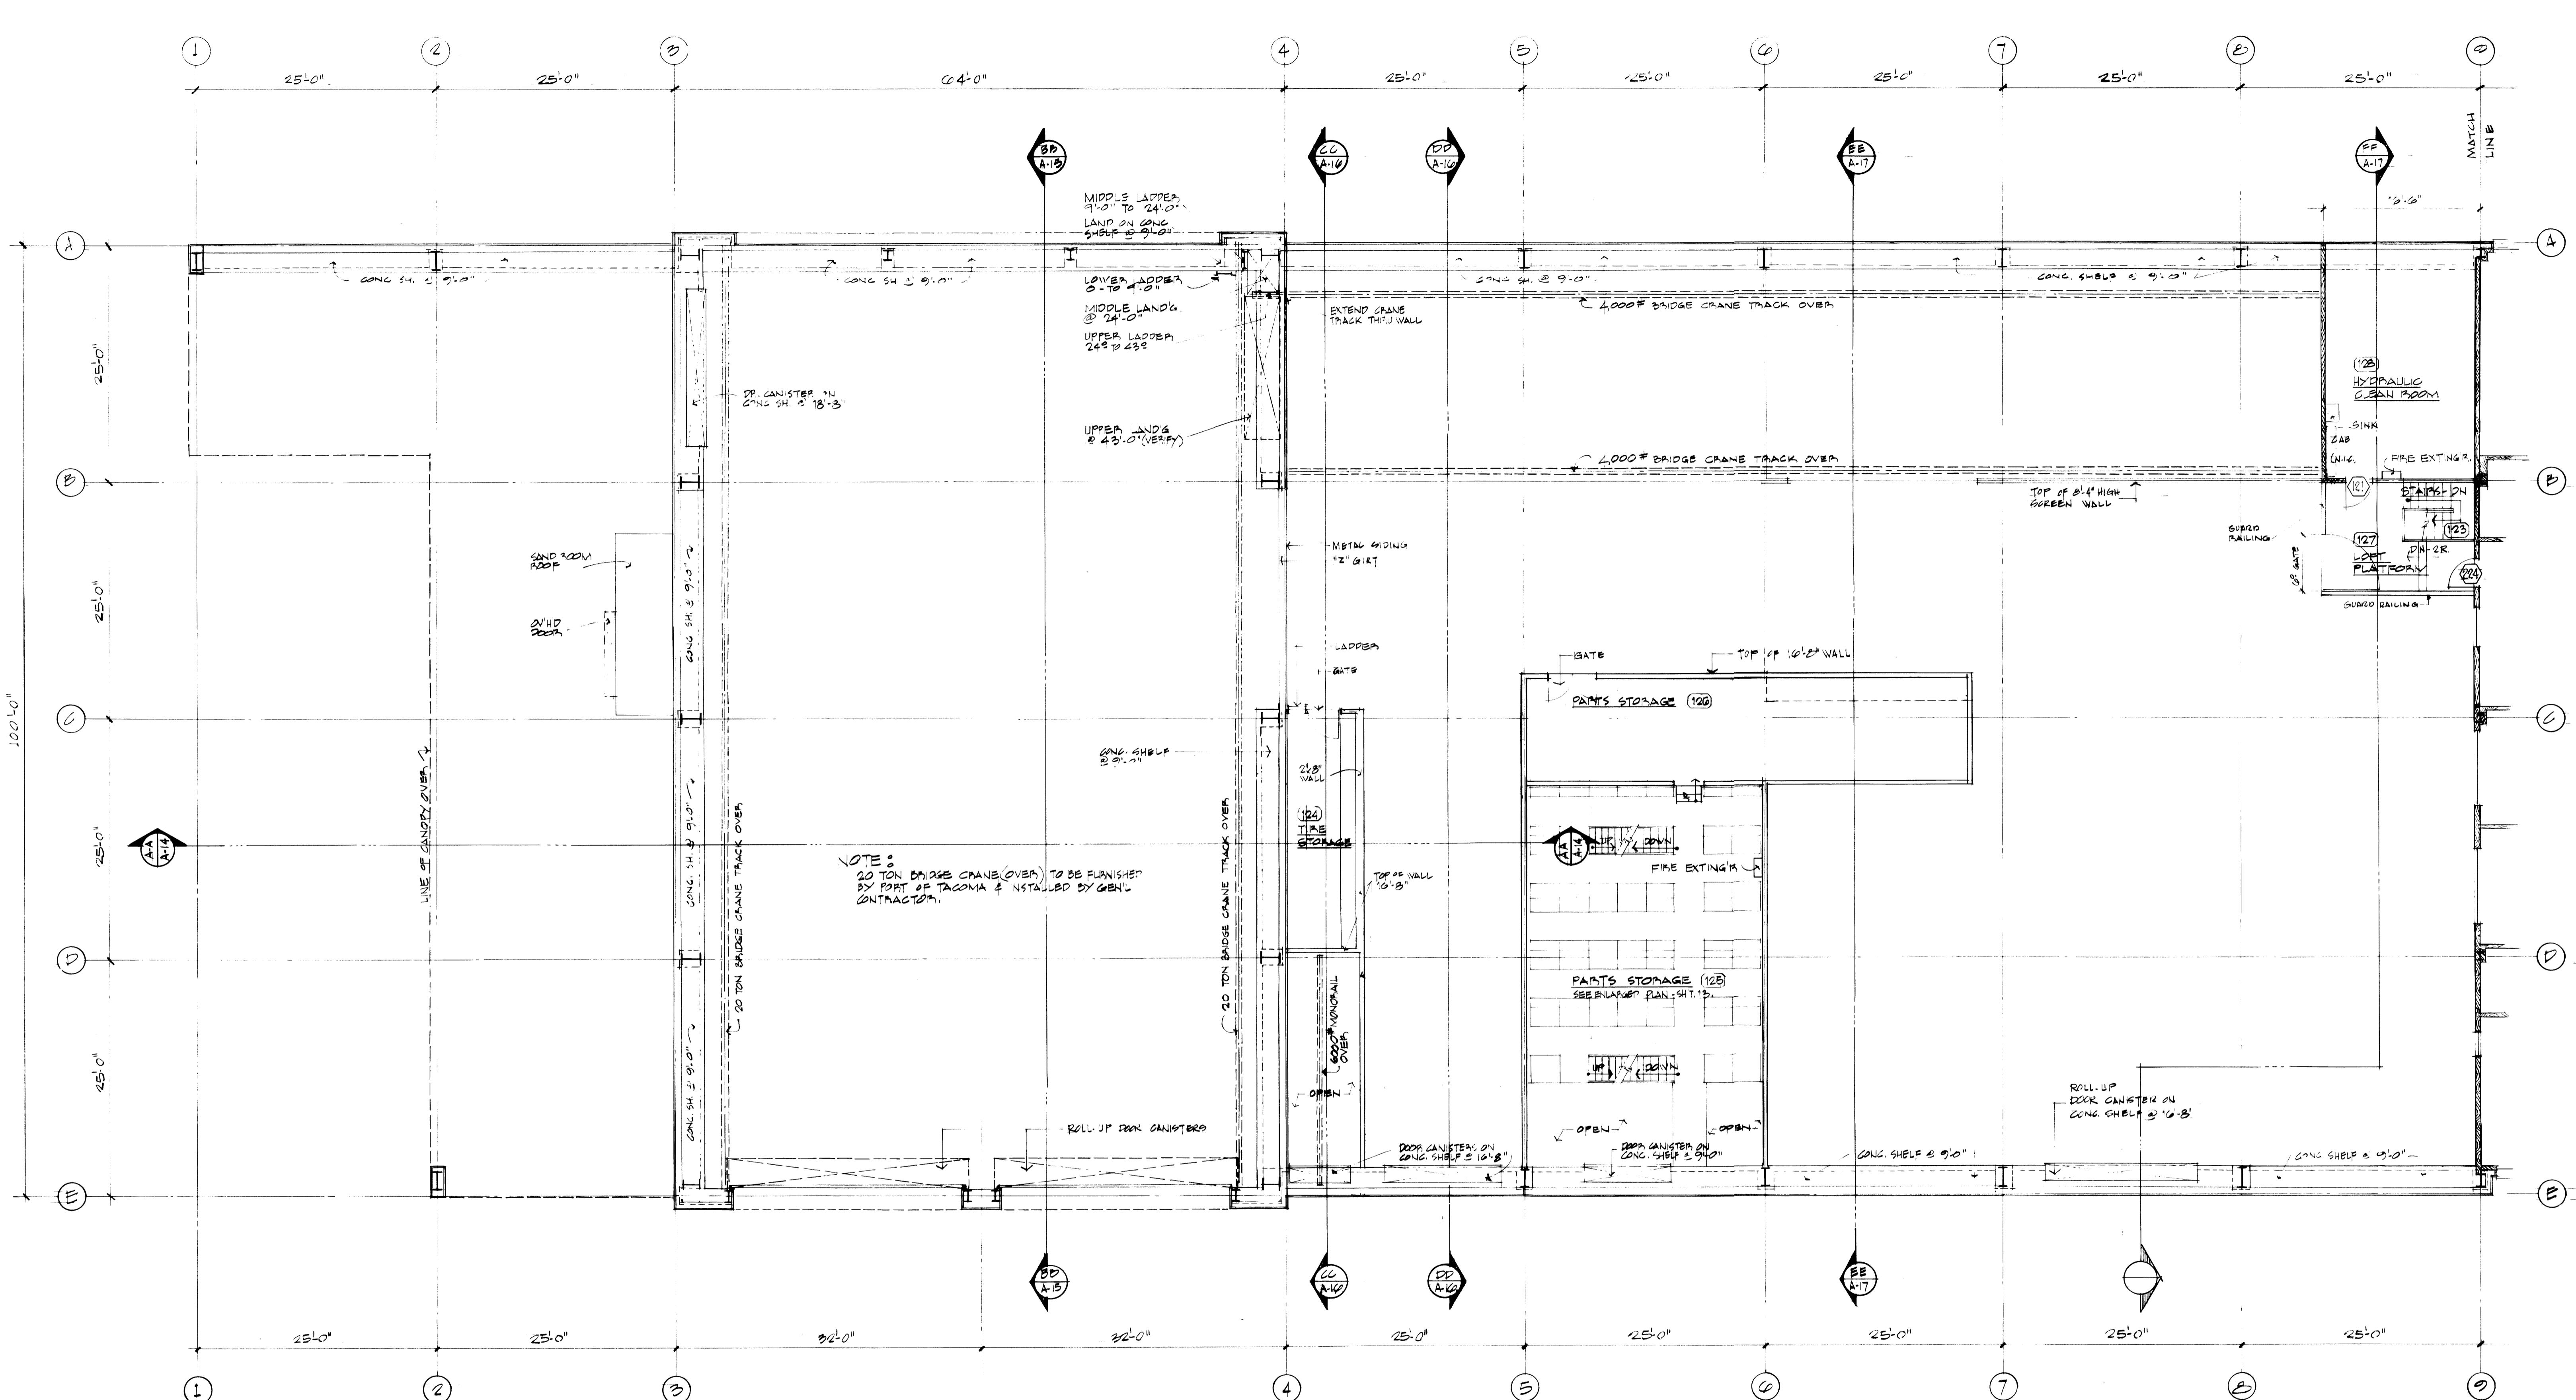

SECOND FLOOR PLAN
I. EQUIPMENT MAINTENANCE

SCALE $\frac{1}{8}$ " = 1'-0"

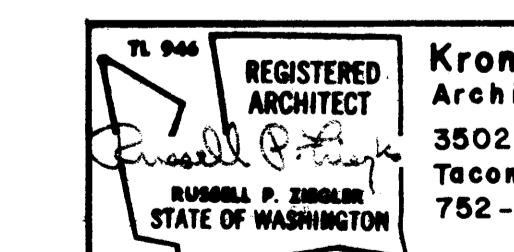

Noel R. Adams P.E. & Associates, Inc. Civil & Structural
2719 Rochester St. W., Tacoma, Wa. 98466 565-3833
Arnold N. Bogue and Associates Mech. & Elect.
4041 Ruston Way, Suite A, Tacoma, Wa. 98402 752-7722

CONT. NO. 401

CONTENTS: SECOND FLOOR PLAN

FIELD BOOK(S):

APPROVED: 4-28-75

DRAWING NO. EP-2622-4

MAINTENANCE BUILDING
PHASE I. EQUIP. MAINT.

SCALE $\frac{1}{8}$ " = 1'-0"

DRAWN: CTA
DATE: 3 FEB 1975

CHECKED: R.P.Z.
DATE: 21 APRIL 1975

CHECKED: _____
DATE: _____

CONT. NO. 401

AS BUILT


REVISION

BY APP. DATE

MARK

CHIEF ENGINEER: Donald L. Moesman

SHEET A-4 OF 24

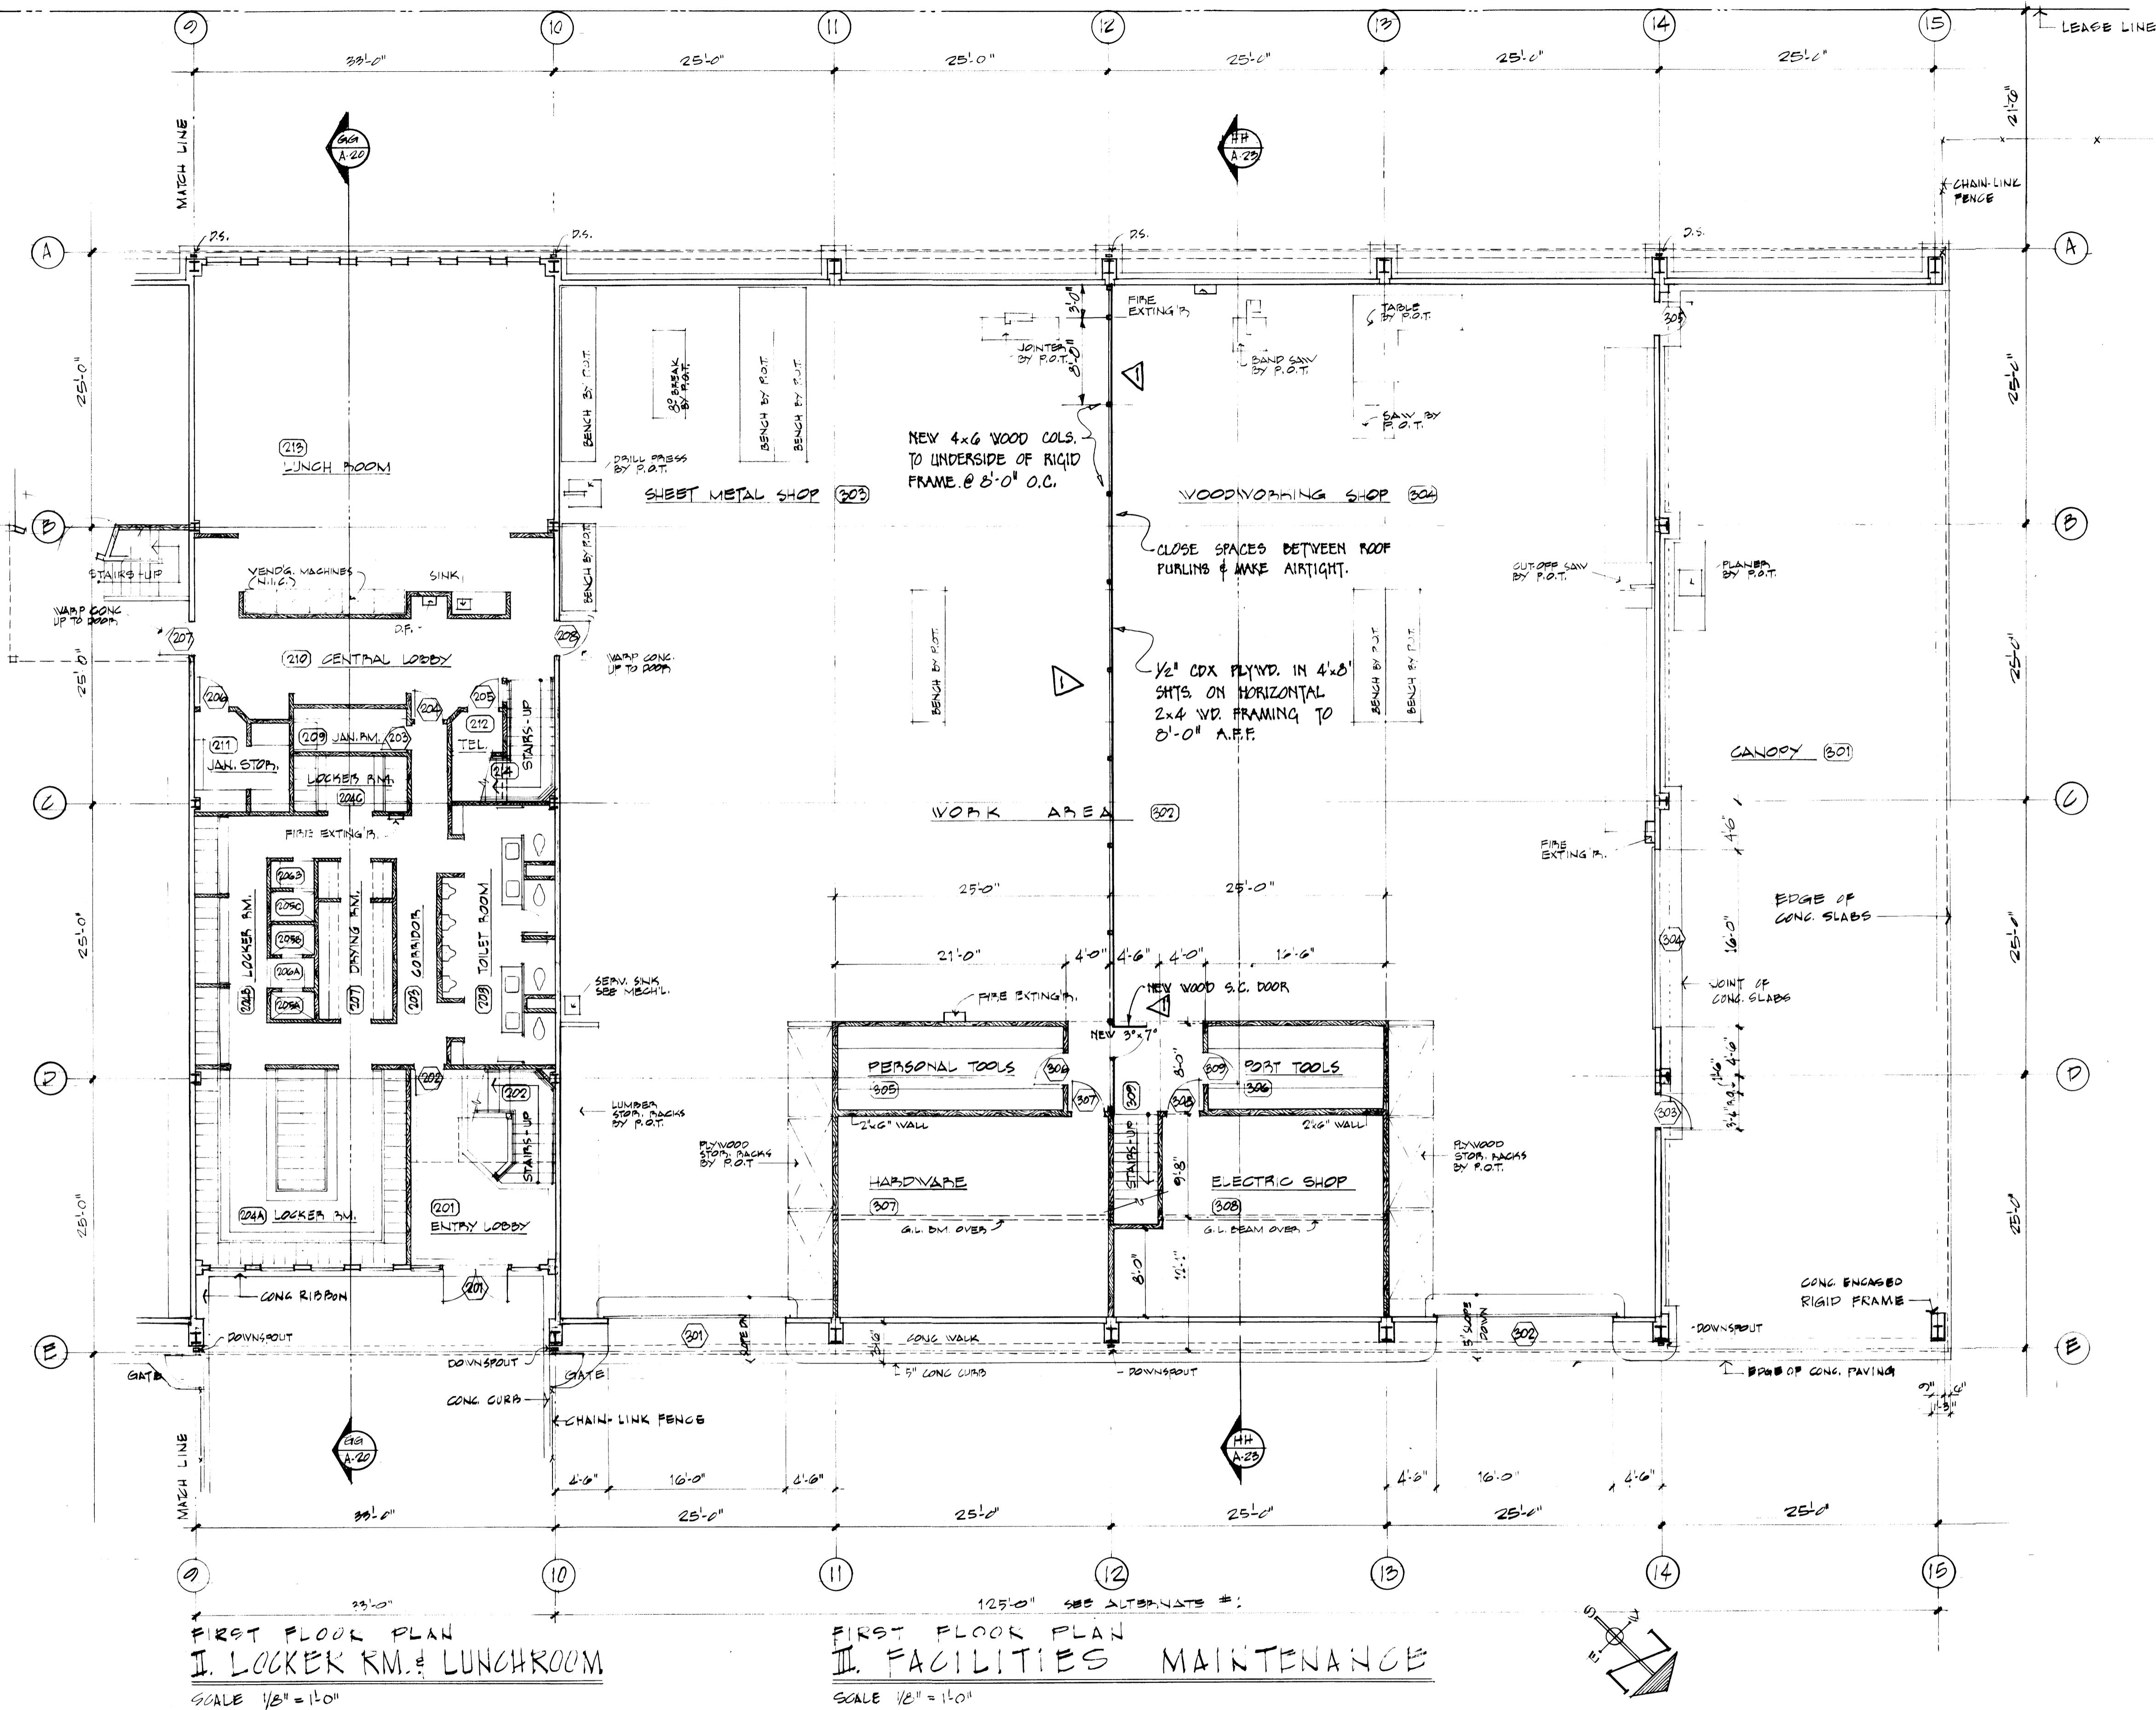


FIRST FLOOR PLAN
I. LOCKER RM. & LUNCHROOM
SCALE 1/8" = 1'-0"

FIRST FLOOR PLAN
II. FACILITIES MAINTENANCE
SCALE 1/8" = 1'-0"


1946		Krona, Ziegler and Associates Architects and Planners, A.I.A. Arnold P. Ziegler STATE OF WASHINGTON		DRAWN <u>S.T.G.</u> DATE 3 FEB 1975
Noel R. Adams P.E. & Associates, Inc. Civil & Structural 2719 Rochester St. W., Tacoma, Wa. 98466 565-3833 Arnold N. Bogue and Associates Mech. & Elect. 4041 Ruston Way, Suite A, Tacoma, Wa. 98402 752-7722		REGISTERED ARCHITECT		CHECKED <u>P.P.E.</u> DATE 21 APRIL 1975
CONT. NO. 401		MAINTENANCE BUILDING PHASES II. OFFICES ETC., III. FAC. MAINT.		CHECKED DATE
FIELD BOOK(S):		CONTENTS: FIRST FLOOR PLAN		APPROVED DATE 4-28-75
APPROVED		DRAWING NO. EP-2622-4		SCALE 1/8" = 1'-0"
AS BUILT		REV. BY RJS 6-4-76		DATE
T.O.E. MODIFICATIONS		REVISION		BY APP. DATE
MARK				CHIEF ENGINEER <u>Noel R. Adams</u>

PORT OF TACOMA
MAINTENANCE BUILDING
PHASES II. OFFICES ETC., III. FAC. MAINT.
CONTENTS: FIRST FLOOR PLAN
FIELD BOOK(S):
APPROVED
DRAWING NO. EP-2622-4
SCALE 1/8" = 1'-0"
DATE 4-28-75
CHIEF ENGINEER Noel R. Adams
SHEET A-5 OF 24

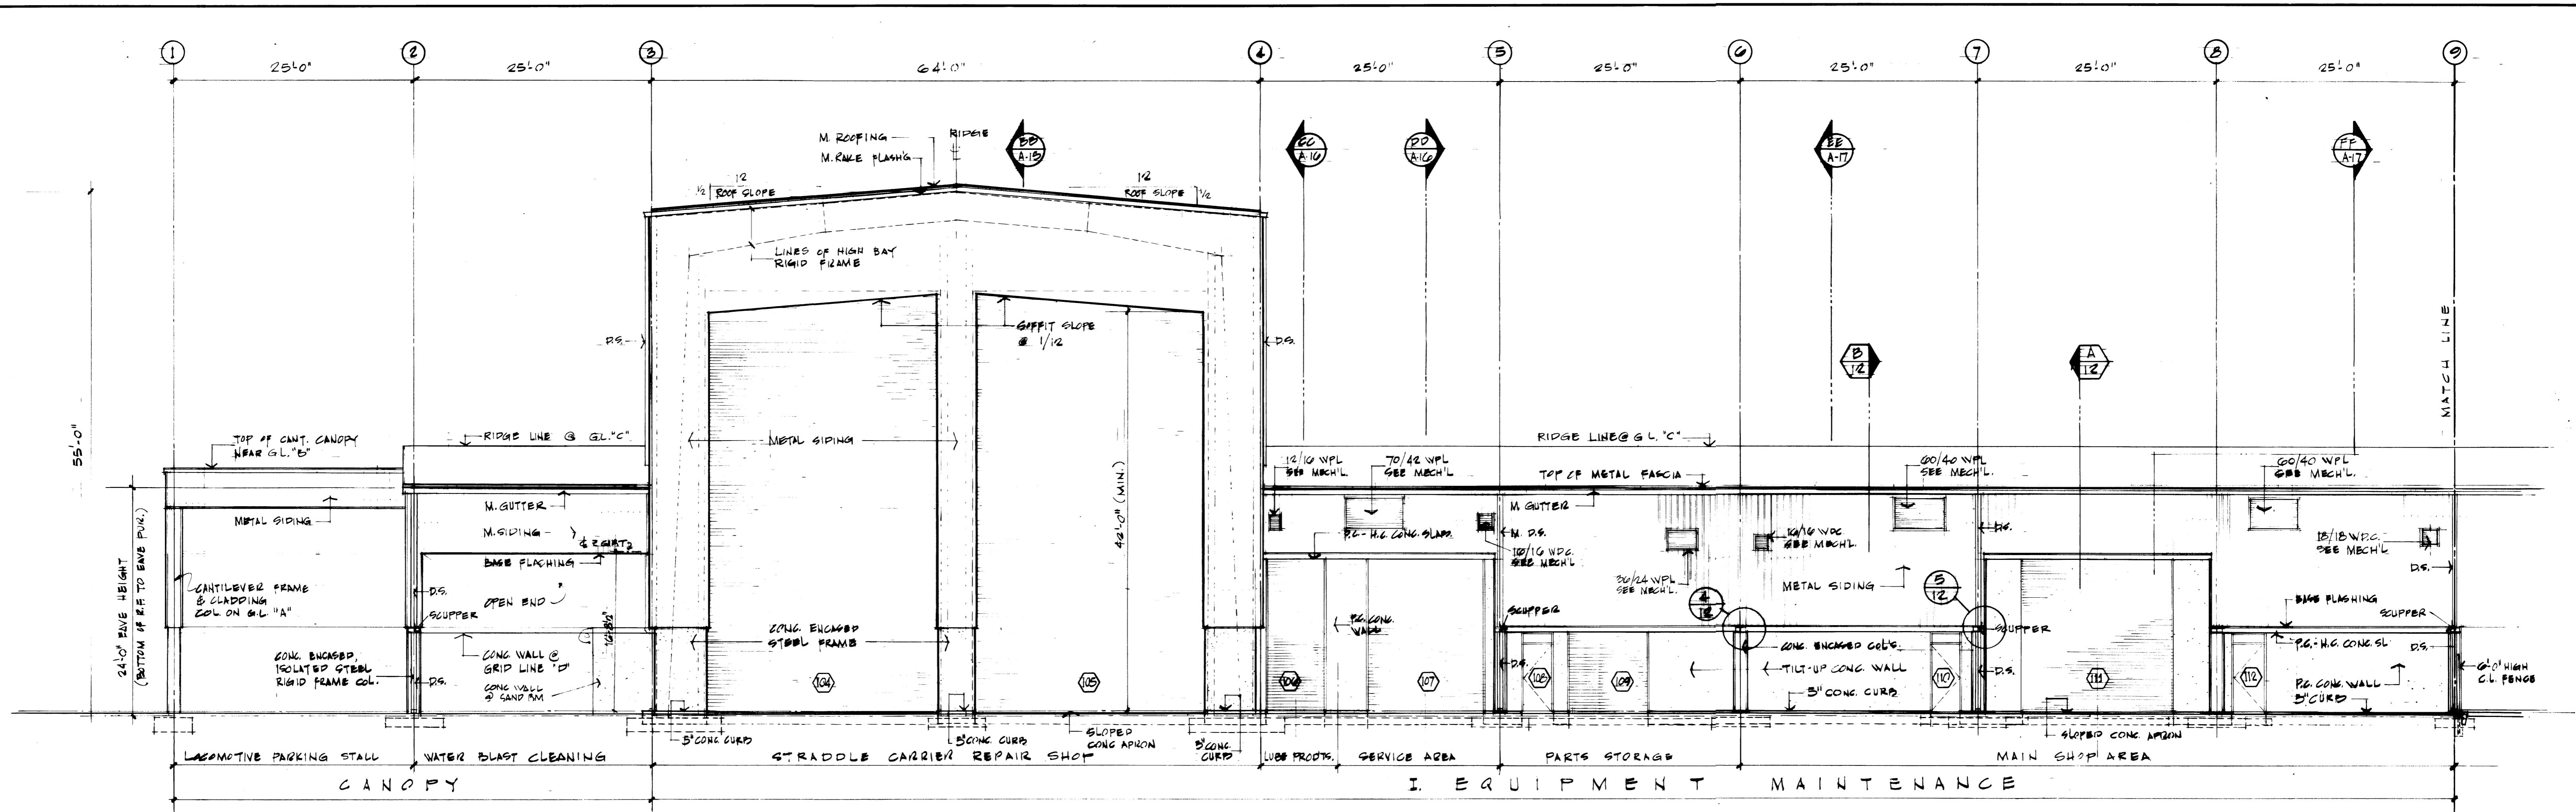

NORTHEAST ELEVATION

SCALE 1/8" = 1'-0"

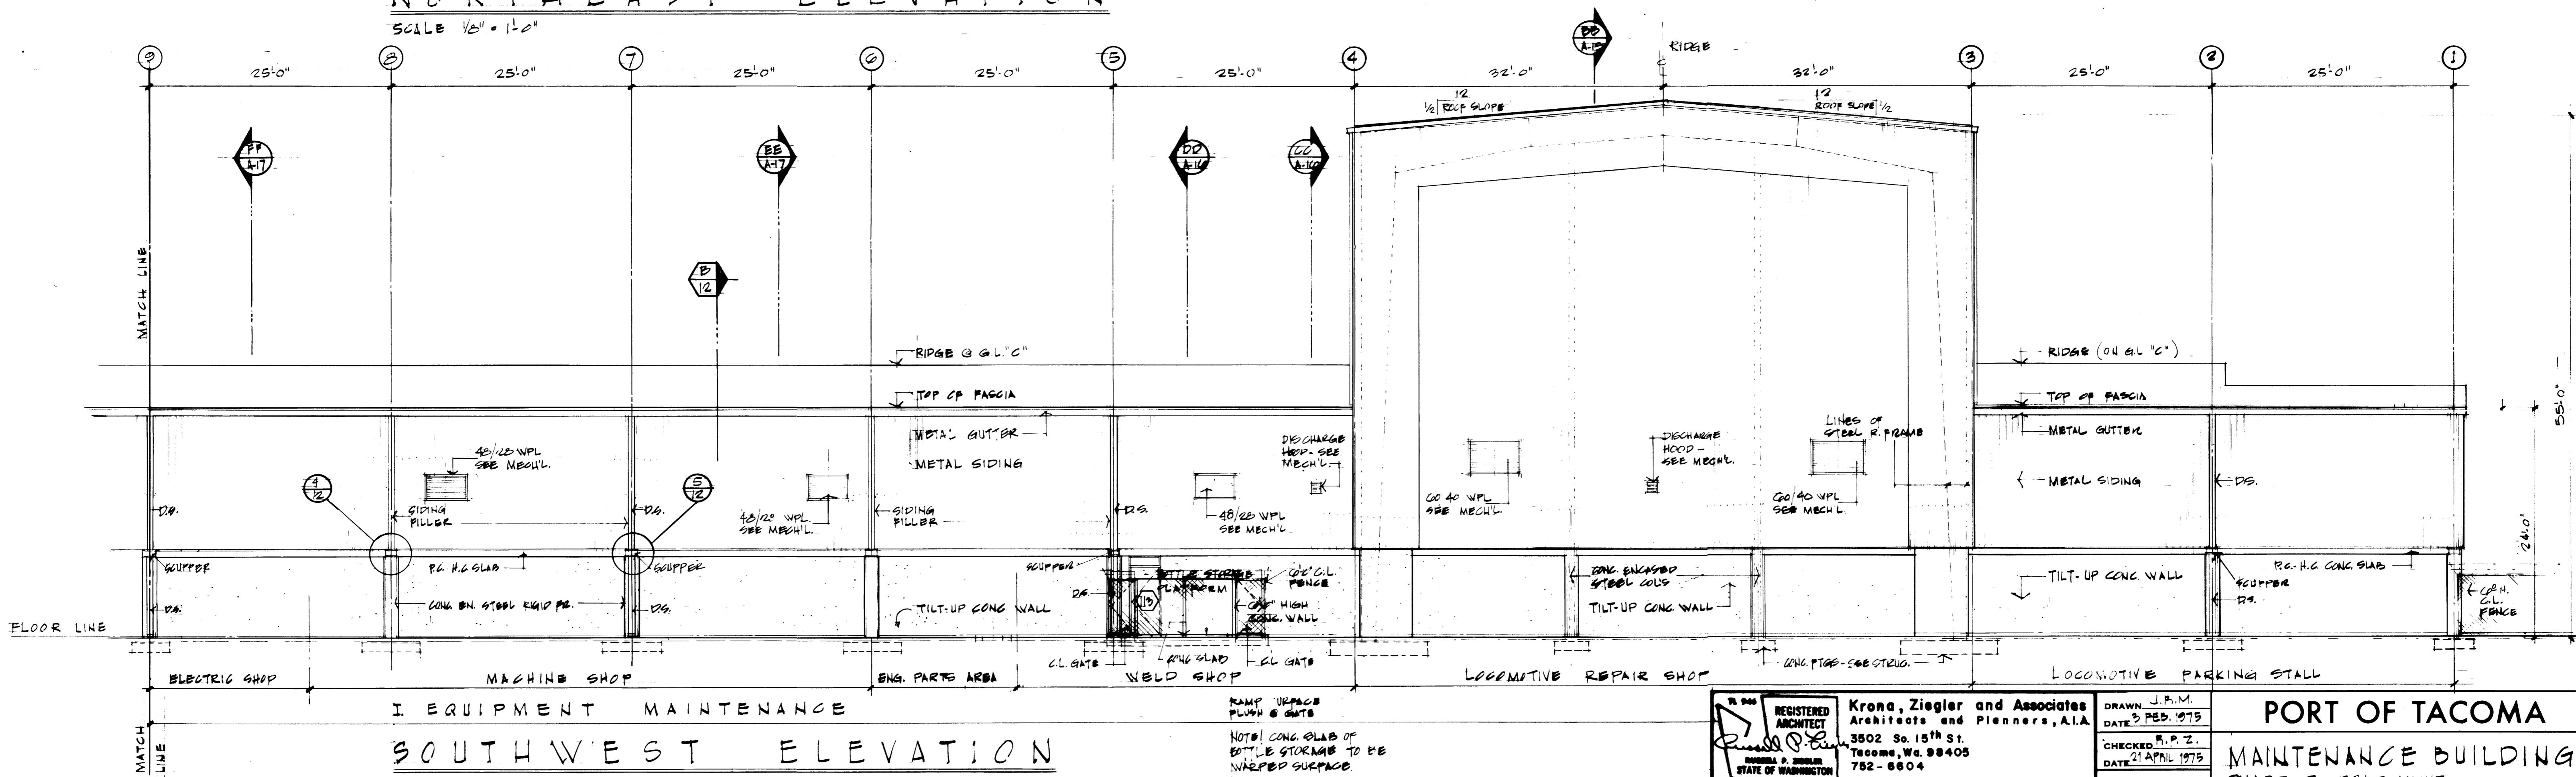

SOUTHWEST ELEVATION

SCALE 1/8" = 1'-0"

NOTE: CONCRETE OF
BOTTLE STORAGE TO BE
WRAPPED SURFACE
SEE CH. A-16 FOR
DETAILS.

71-006
REGISTERED
ARCHITECT
Krona, Ziegler and Associates
Architects and Planners, A.I.A.
3502 So. 15th St.
Tacoma, Wa. 98405
752-6604
Arnold N. Bogue and Associates
Mech. & Elect.
4041 Ruston Way, Suite A, Tacoma, Wa. 98402 752-7722

Noel R. Adams P.E. & Associates, Inc. Civil & Structural
2719 Rochester St. W., Tacoma, Wa. 98466 565-3833

Arnold N. Bogue and Associates Mech. & Elect.
4041 Ruston Way, Suite A, Tacoma, Wa. 98402 752-7722

CONT. NO. 401

FIELD BOOK(S)

APPROVED

4-28-75

DATE

DRAWING NO.

EP-2622-4

SHEET A-9 OF 24

PORT OF TACOMA

MAINTENANCE BUILDING
PHASE I EQUIP. MAINT.



CONTENTS: EXT. BLDG. ELEVATIONS

SCALE 1/8" = 1'-0"

DRAWING NO.


EP-2622-4

SHEET A-9 OF 24

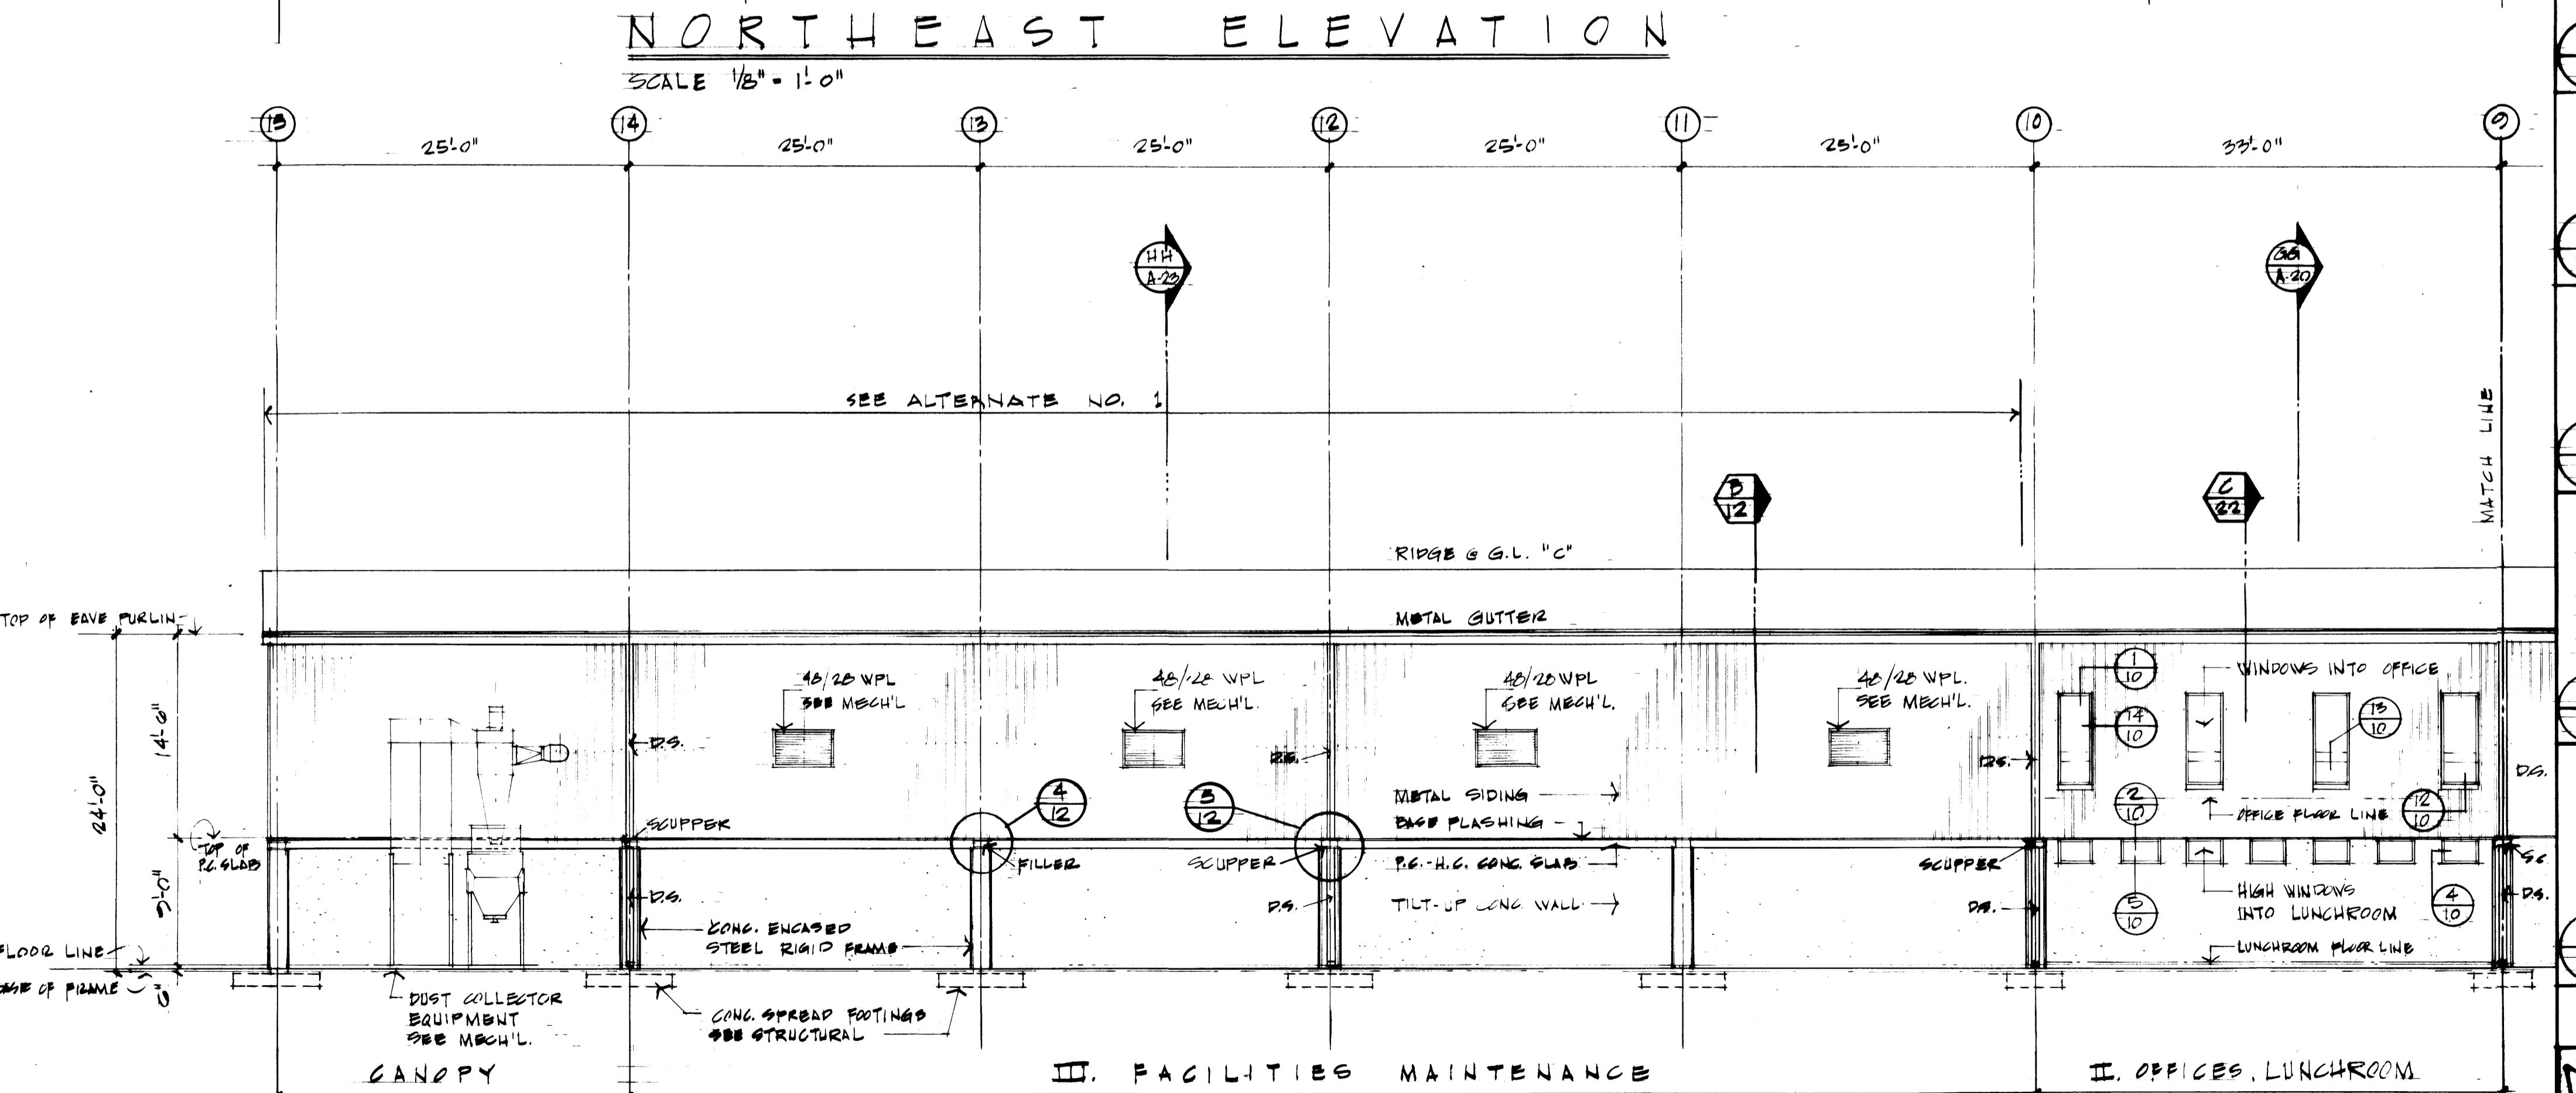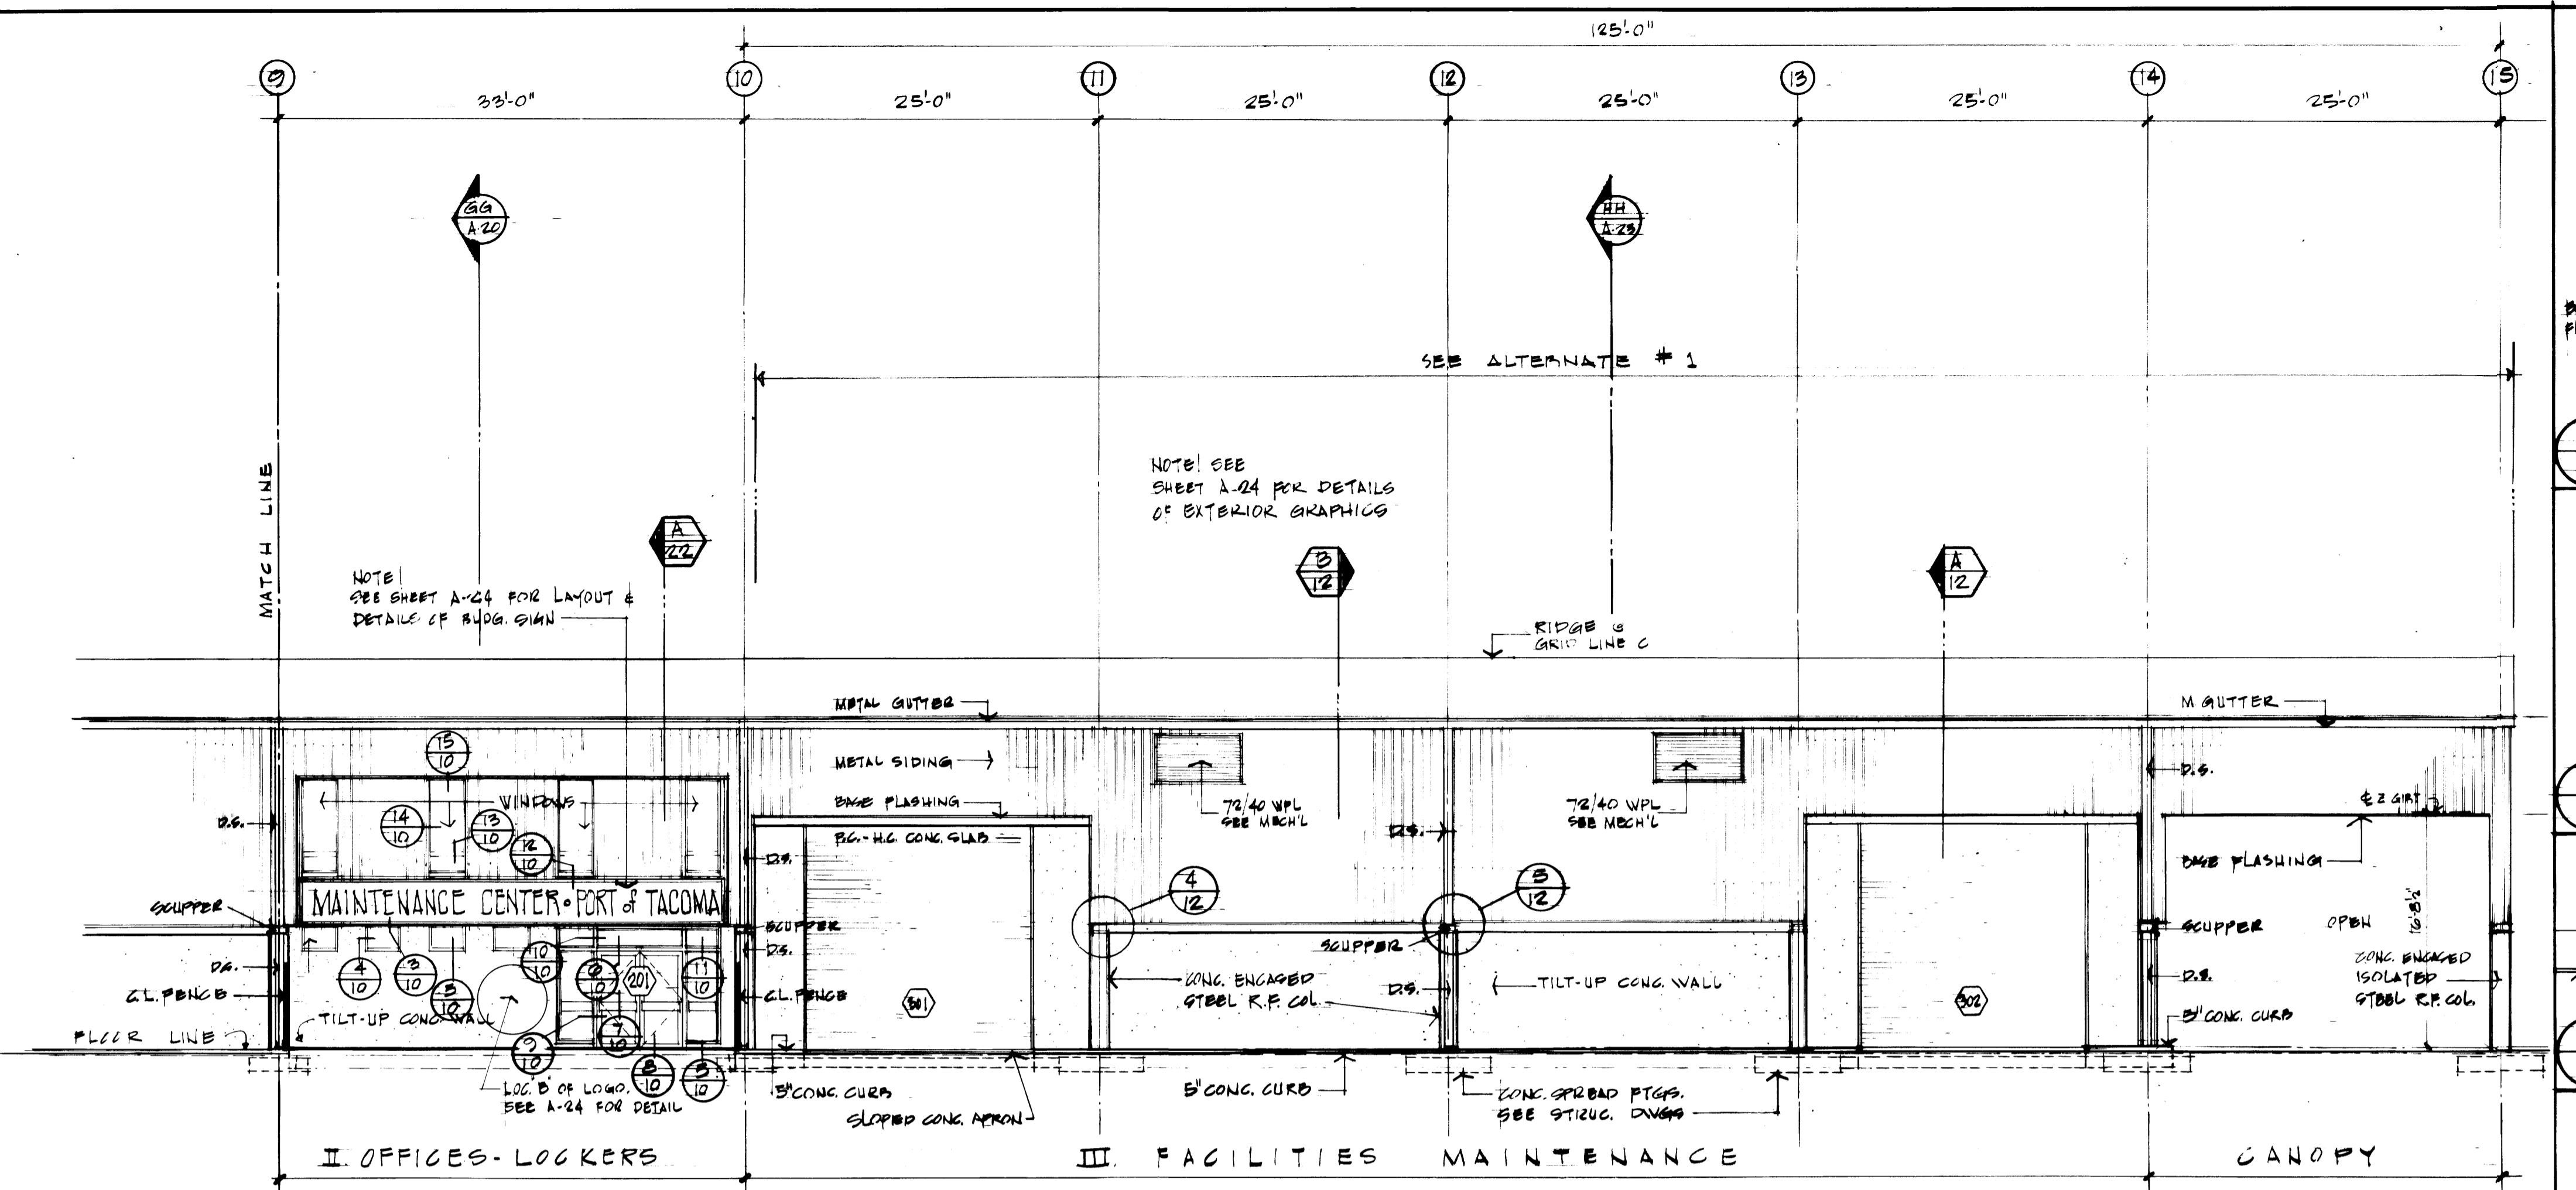

SOUTHWEST ELEVATION

SCALE 1/8" = 1'-0"

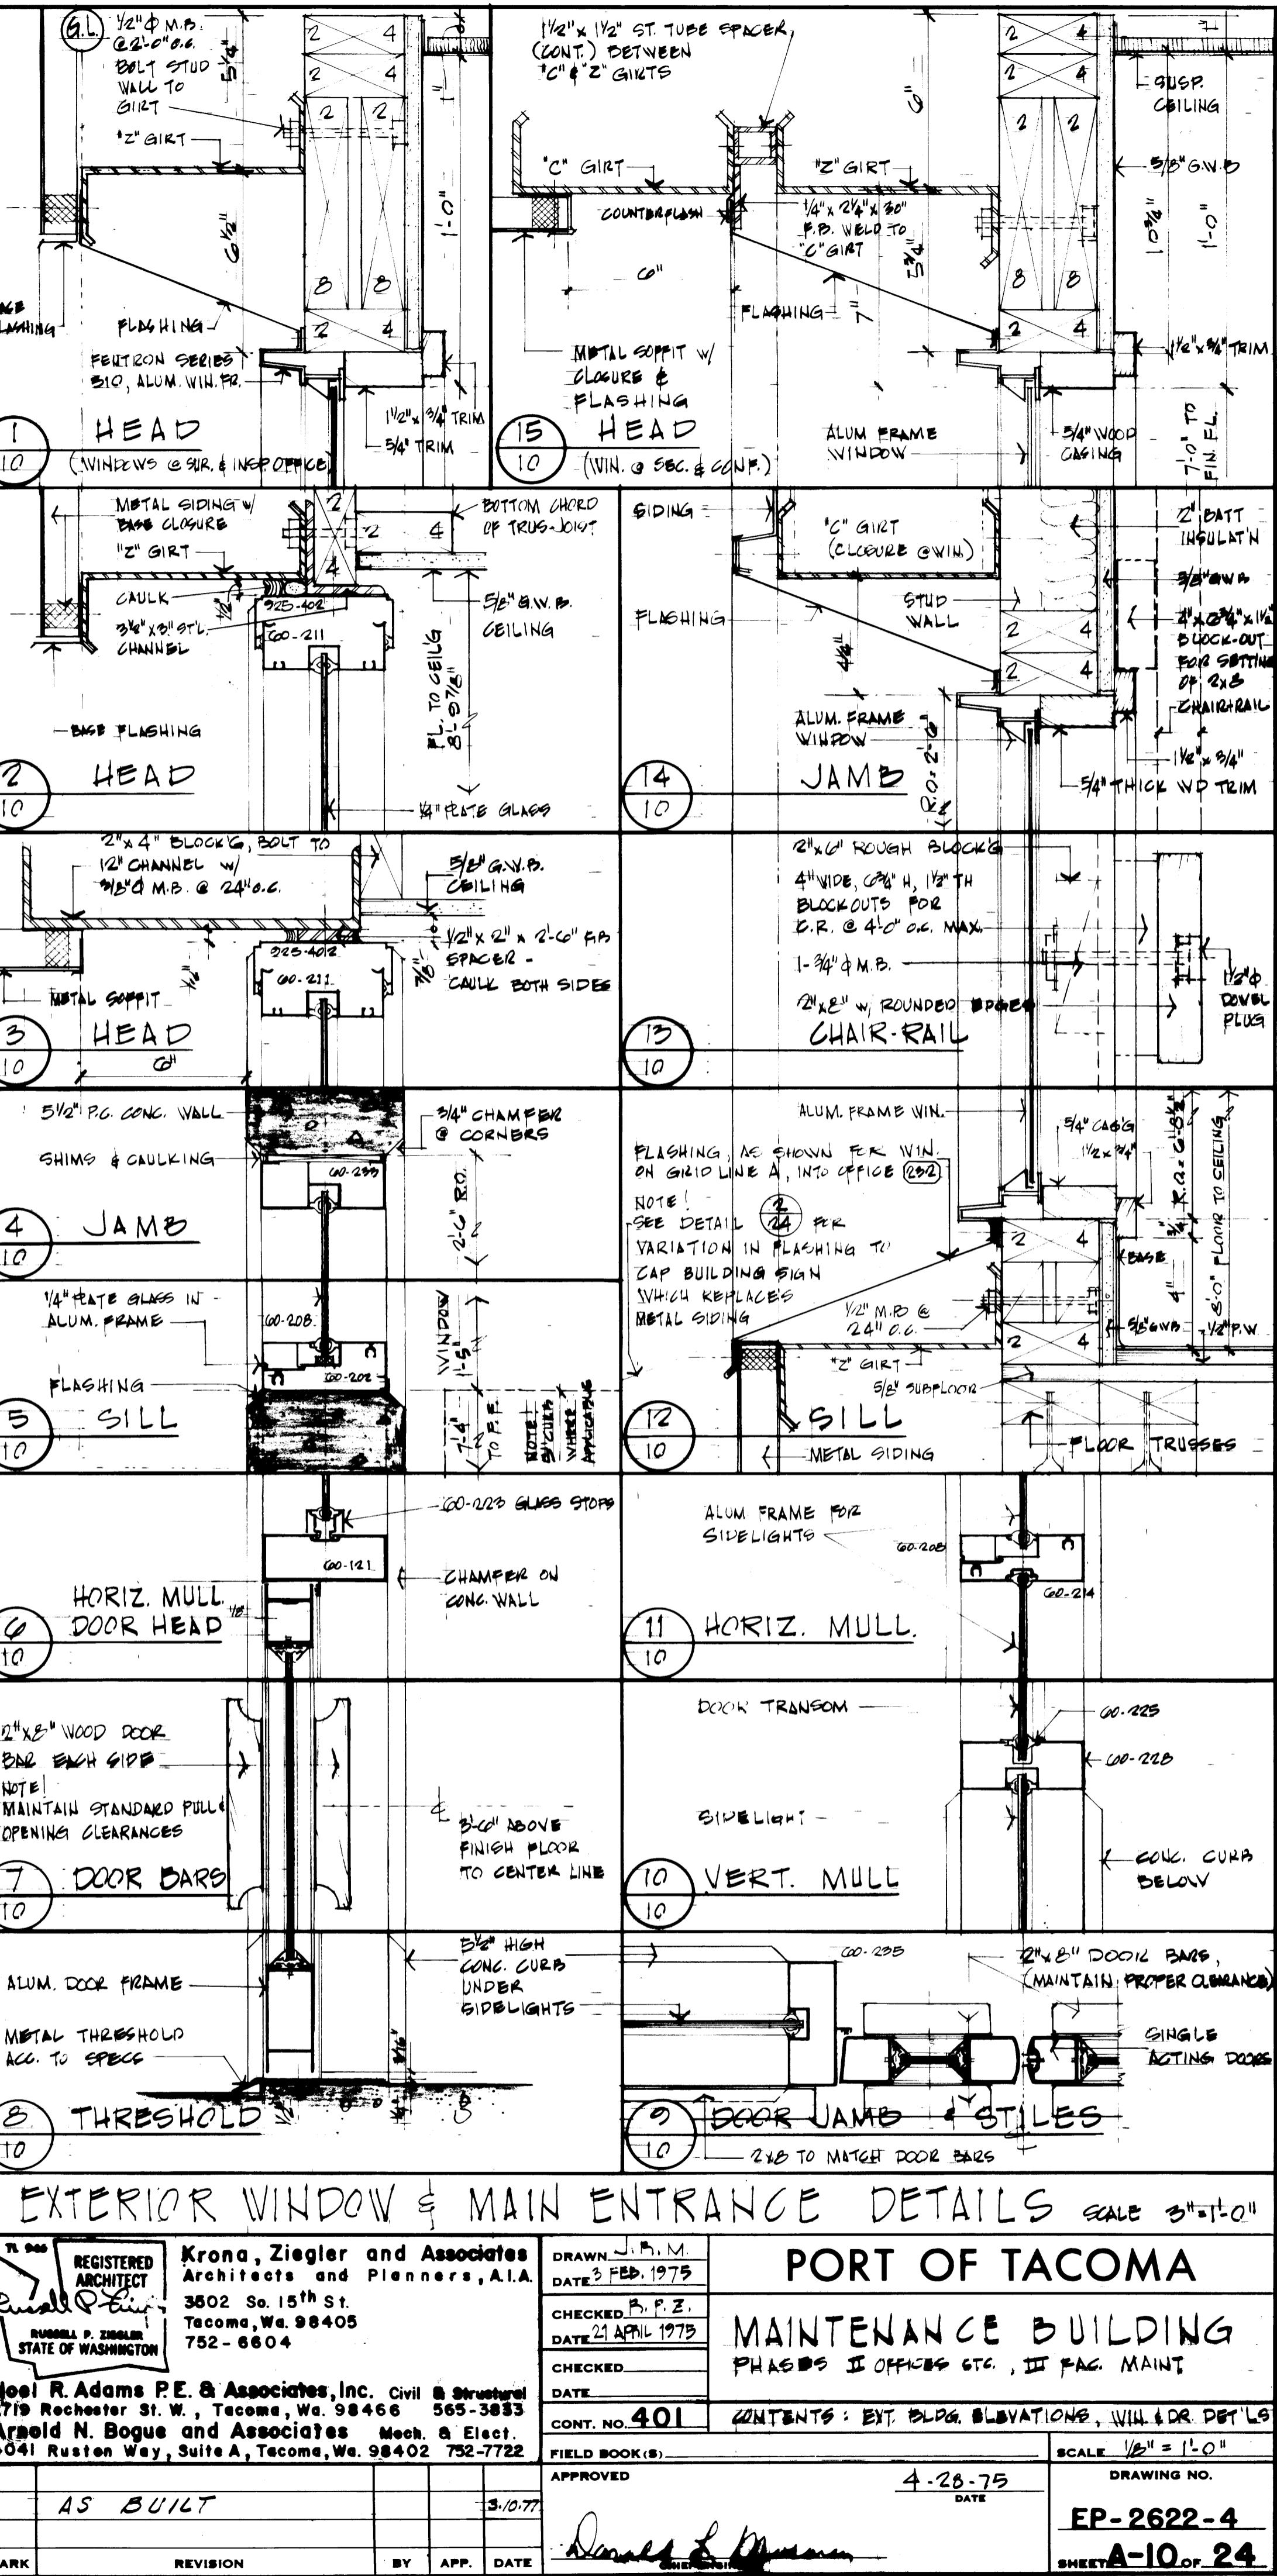

REGISTERED
ARCHITECT
Krona, Ziegler and Associates
Architects and Planners, A.I.A.
3602 So. 15th St.
Tacoma, Wa. 98405
ARMAND P. ZIEGLER
STATE OF WASHINGTON
CONT. NO. 401


DRAWN J. R. M.
DATE 2 FEB. 1975
CHECKED B. P.Z.
DATE 24 APRIL 1975
CHECKED
DATE
APPROVED
4-28-75
DATE
Drew L. Munro

MAINTENANCE BUILDING
PHASES I OFFICES ETC., II FAC. MAINT

CONTENTS: EXT. BLDG. ELEVATIONS, WIL & DR. DETLS
FIELD BOOK (8)
SCALE 1/8" = 1'-0"


DRAWING NO.
EP-2622-4

SHEET A-10 OF 24

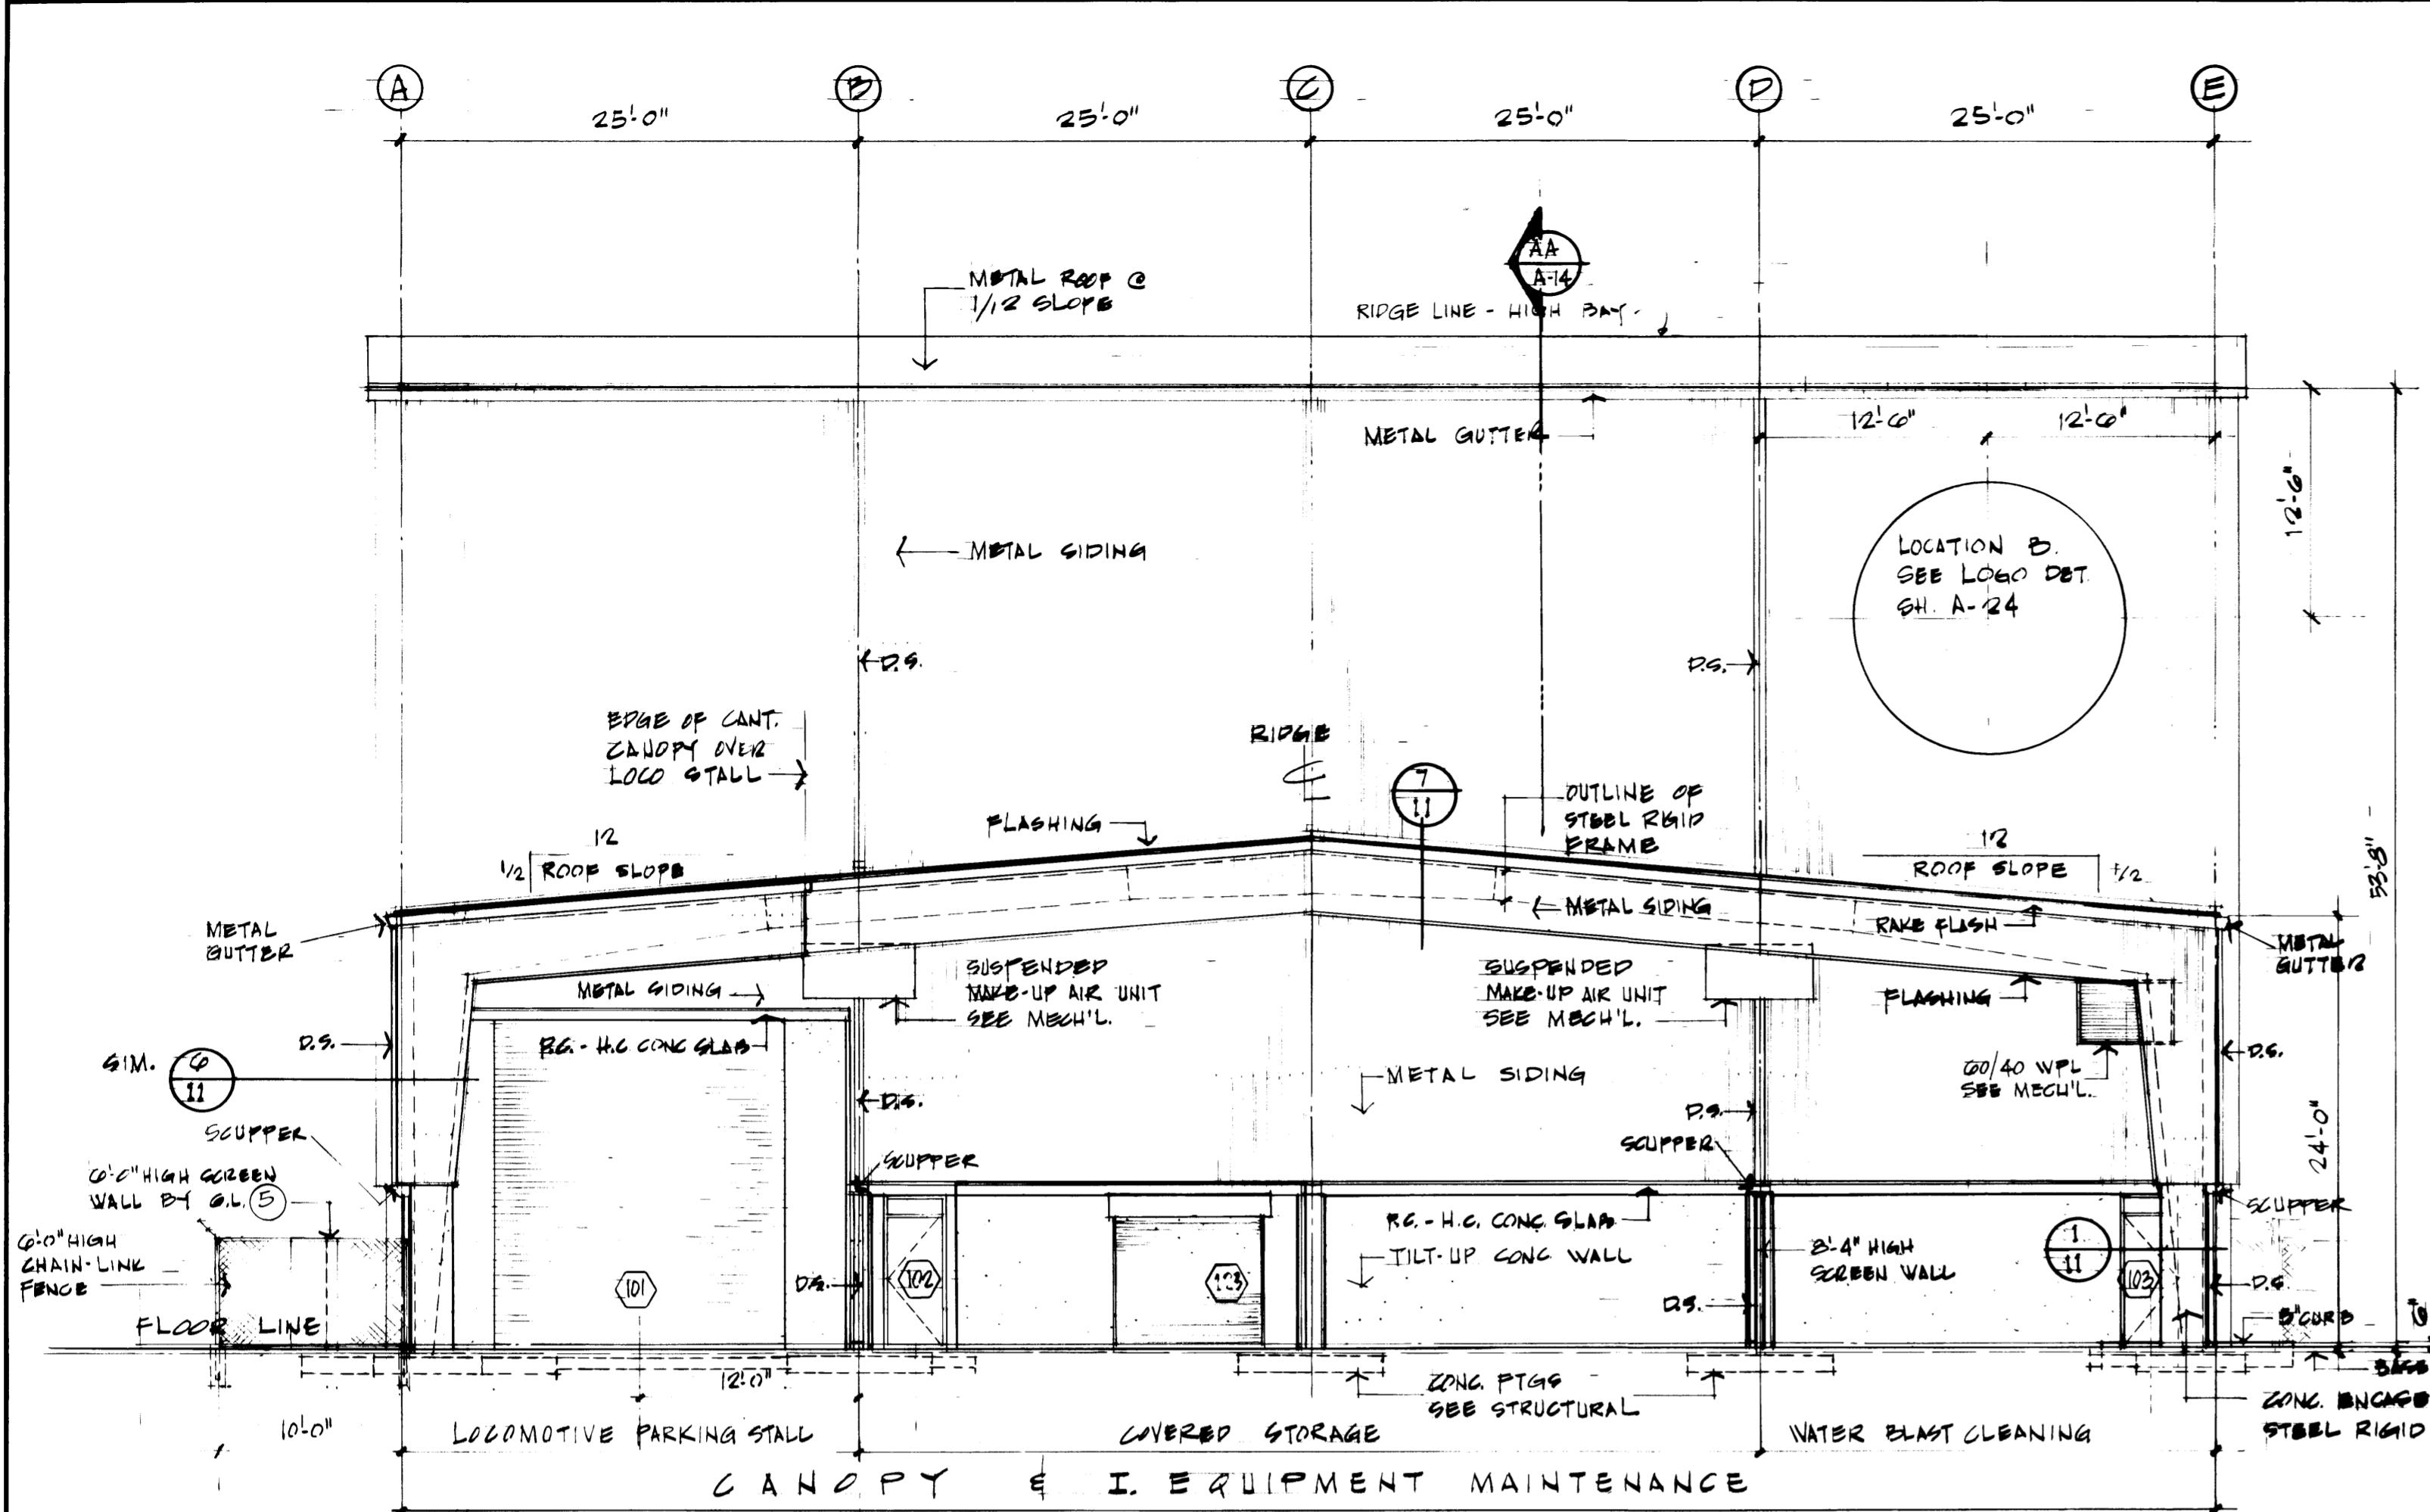

SOUTHEAST ELEVATION


SCALE 1/8" = 1'-0"

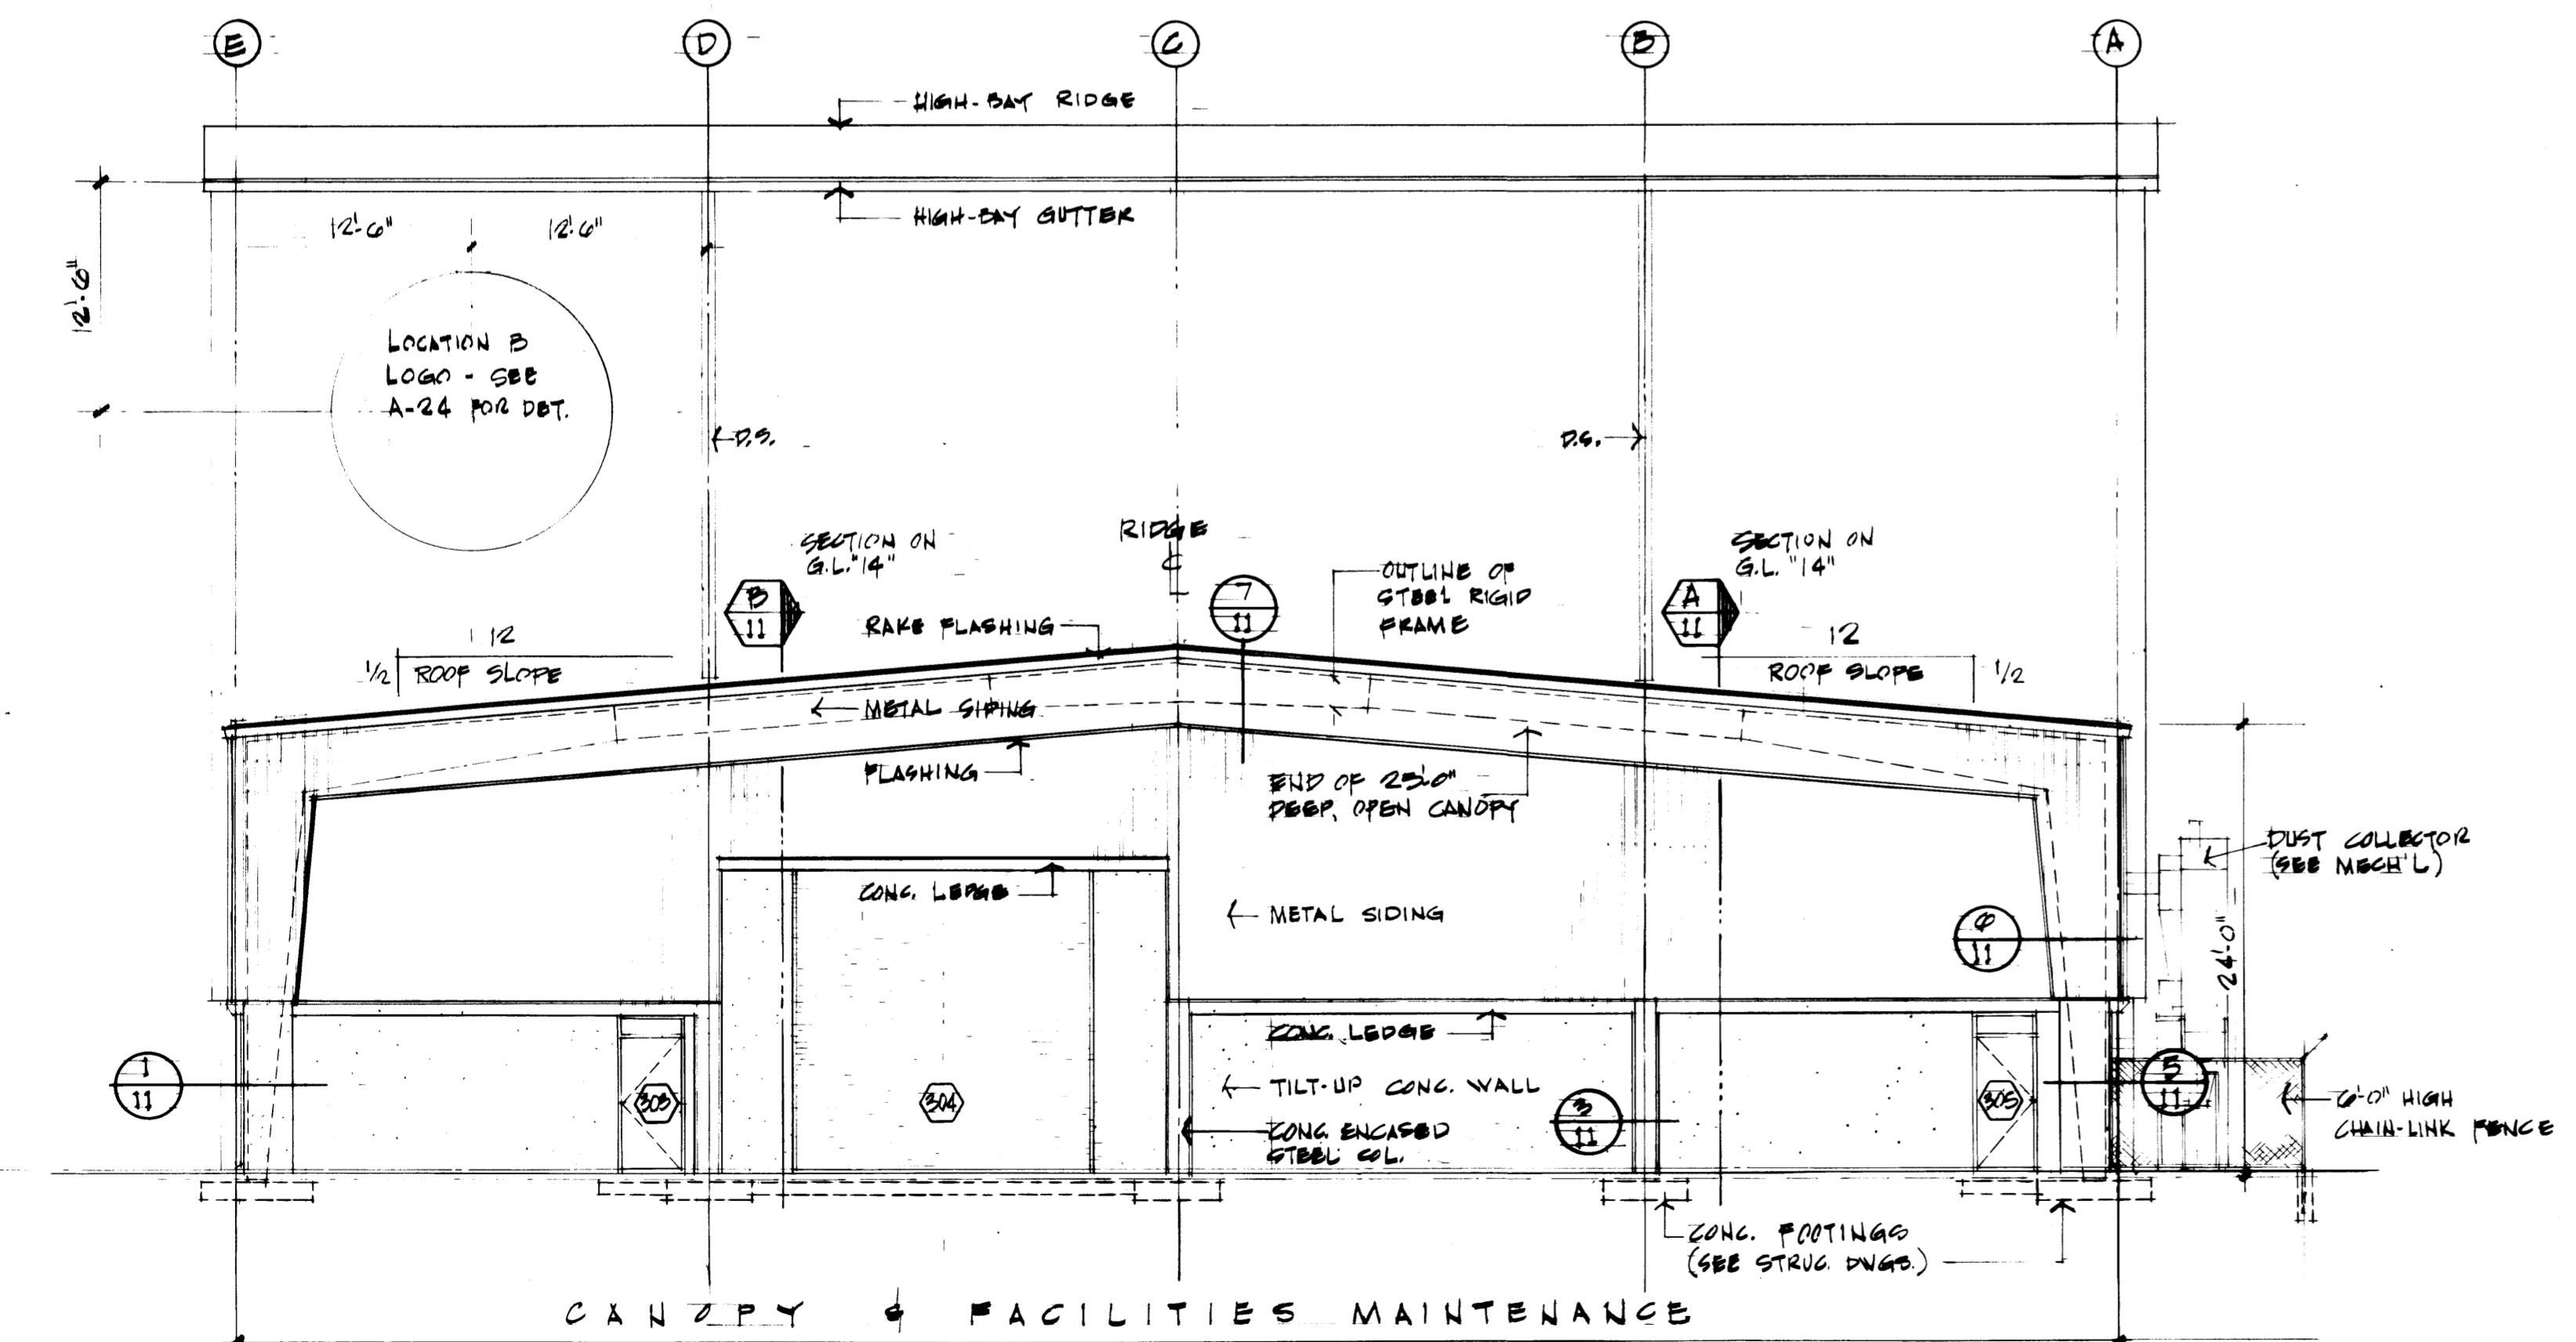

NORTHWEST ELEVATION

SCALE 1/8" = 1'-0"

NOTE: FOR EXTERIOR GRAPHICS
SEE SHEET A-24

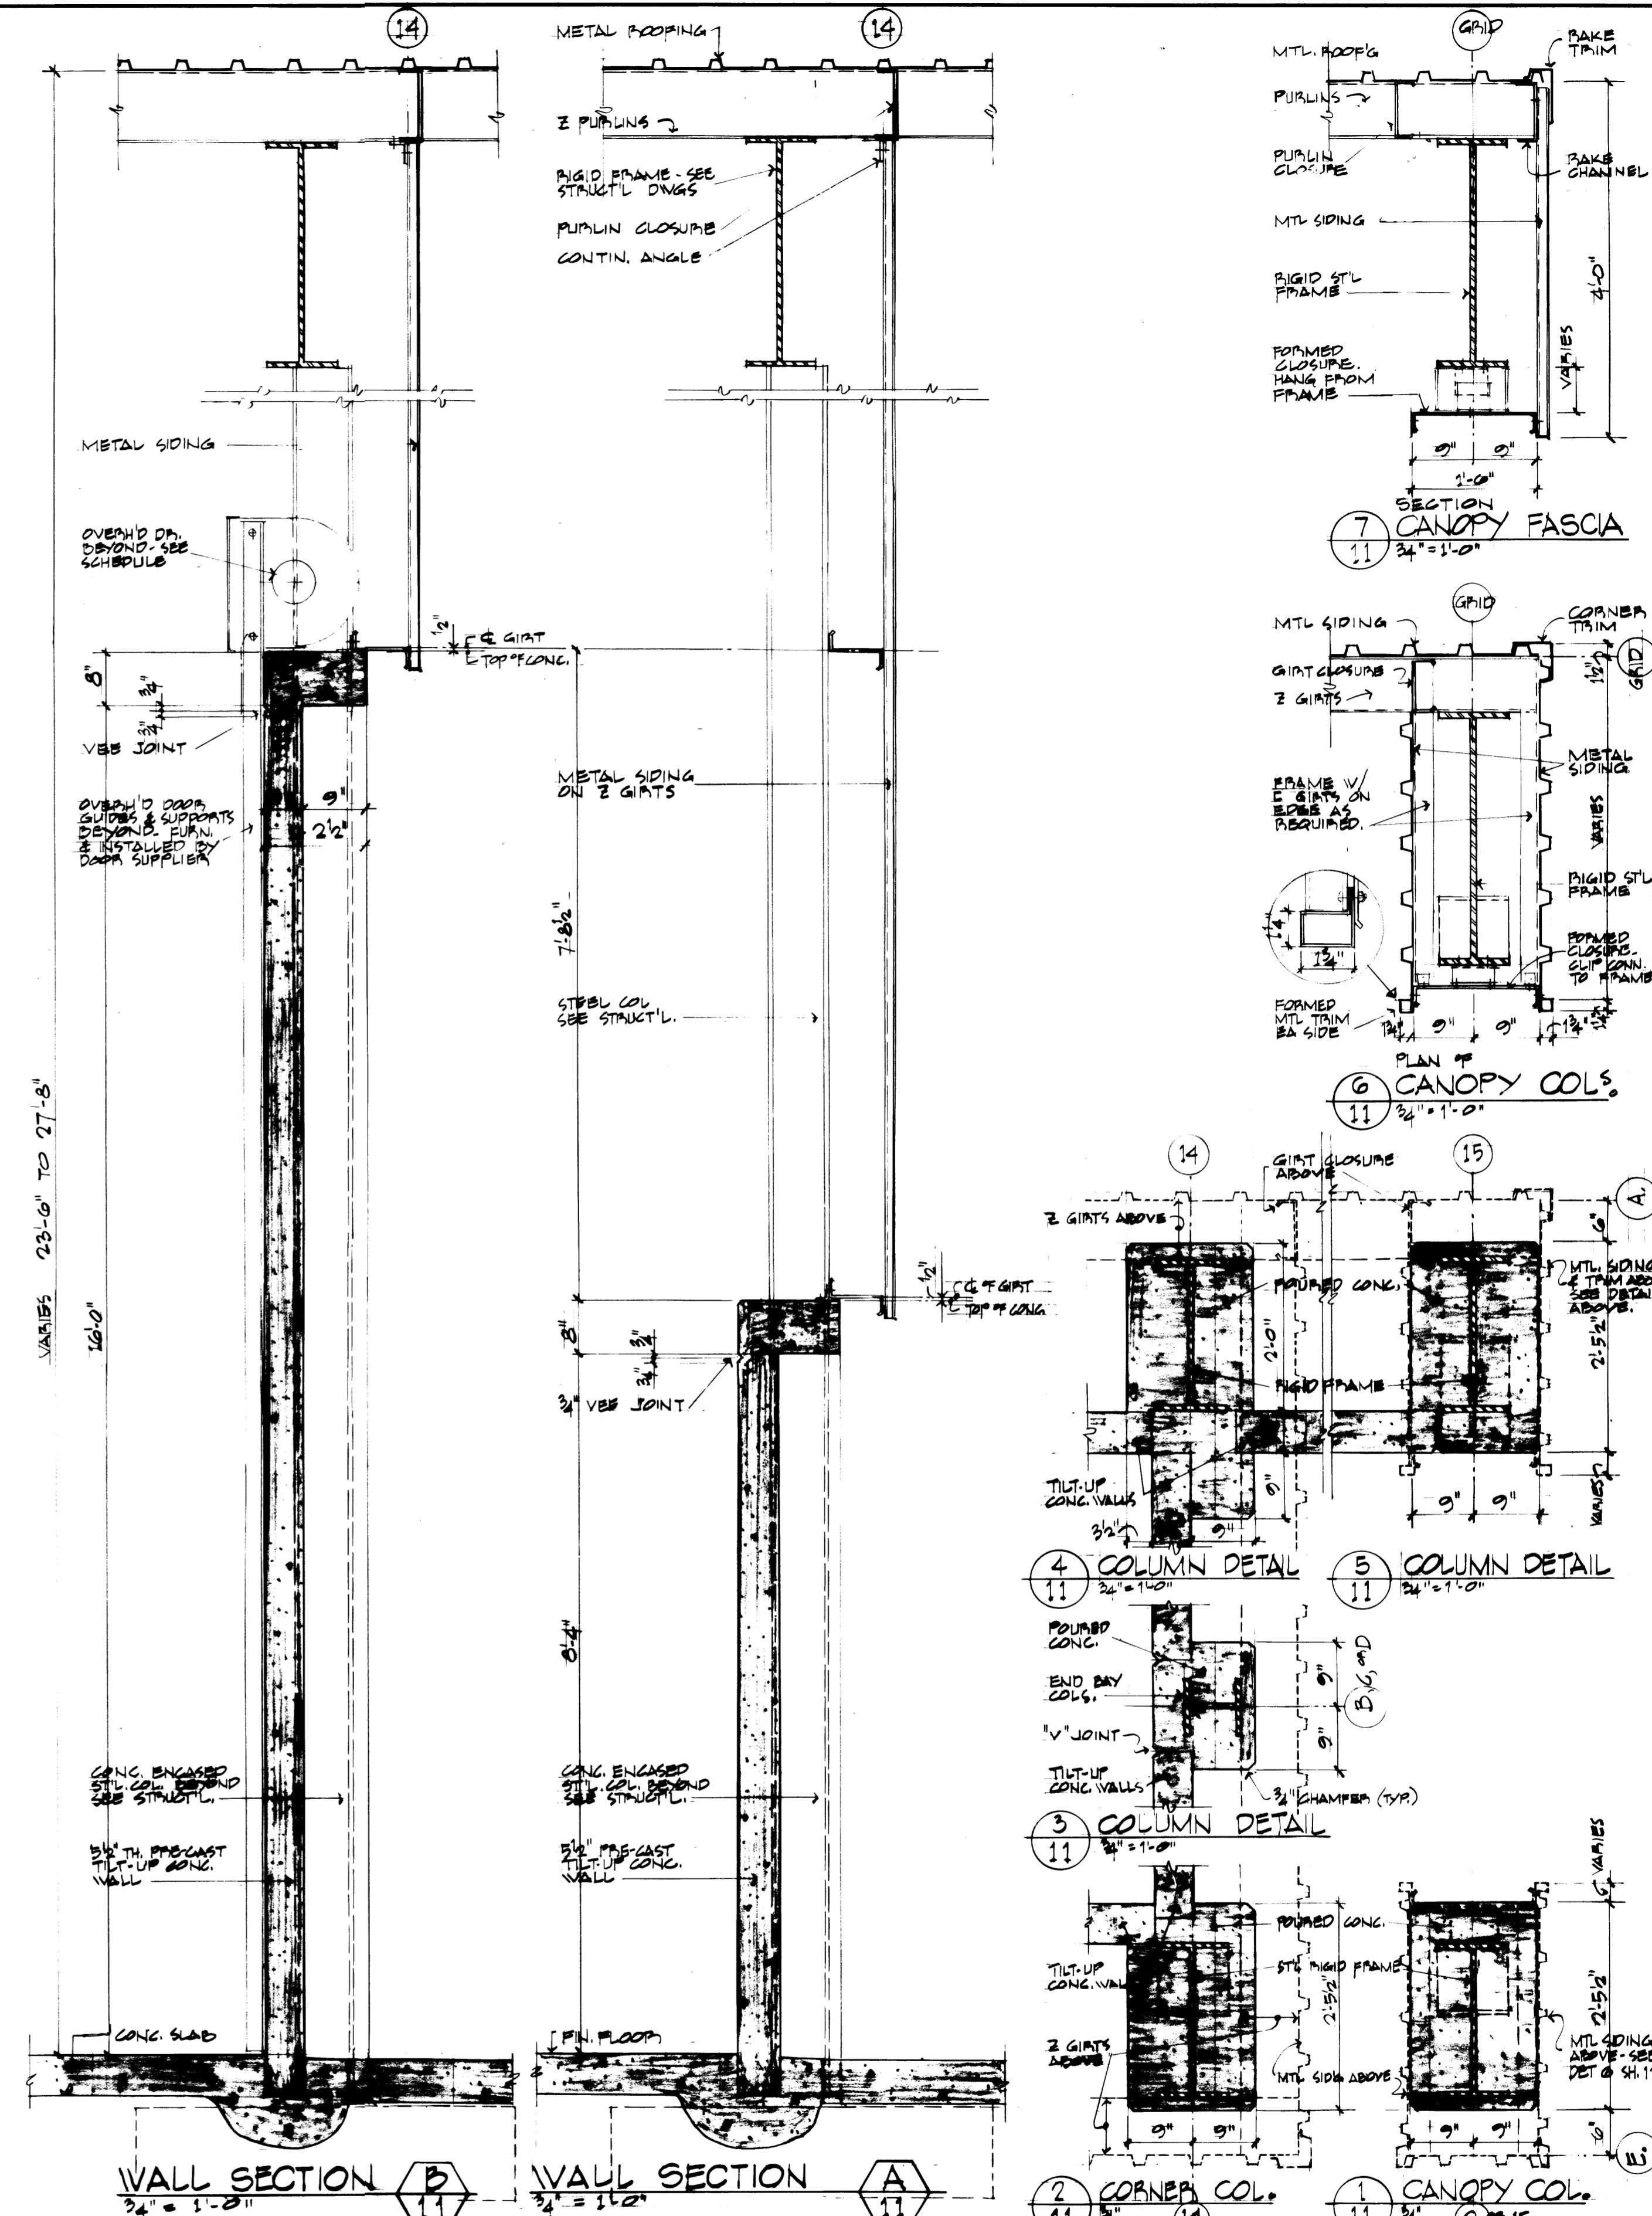

71-946
REGISTERED
ARCHITECT
Paul P. Ziegler
MARSHALL P. ZIEGLER
STATE OF WASHINGTON

Noel R. Adams P.E. & Associates, Inc. Civil & Structural
2719 Rochester St. W., Tacoma, Wa. 98466 565-3833

Arnold N. Bogus and Associates Mech. & Elect.
4041 Ruston Way, Suite A, Tacoma, Wa. 98402 752-7722

DATE 3 FEB. 1975
CHECKED B.P.E.
DATE 21 APRIL 1975
CHECKED
DATE
CONT. NO. 401

FIELD BOOK(S)
APPROVED
4-28-75
DATE

AS BUILT
REVISION
BY APP. DATE

MARK
CHIEF ENGR.

PORT OF TACOMA

MAINTENANCE BUILDING
PHASES I EQUIP. MAINT., II. FACILITIES MAINT
CONTENTS: ELEV. BL. ELEVATIONS, WALL SECTIONS & DET.







SCALE 1/8" = 1'-0"

DRAWING NO.
EP-2622-4

DATE 4-28-75

CHIEF ENGR.

SHEET A-11 OF 24

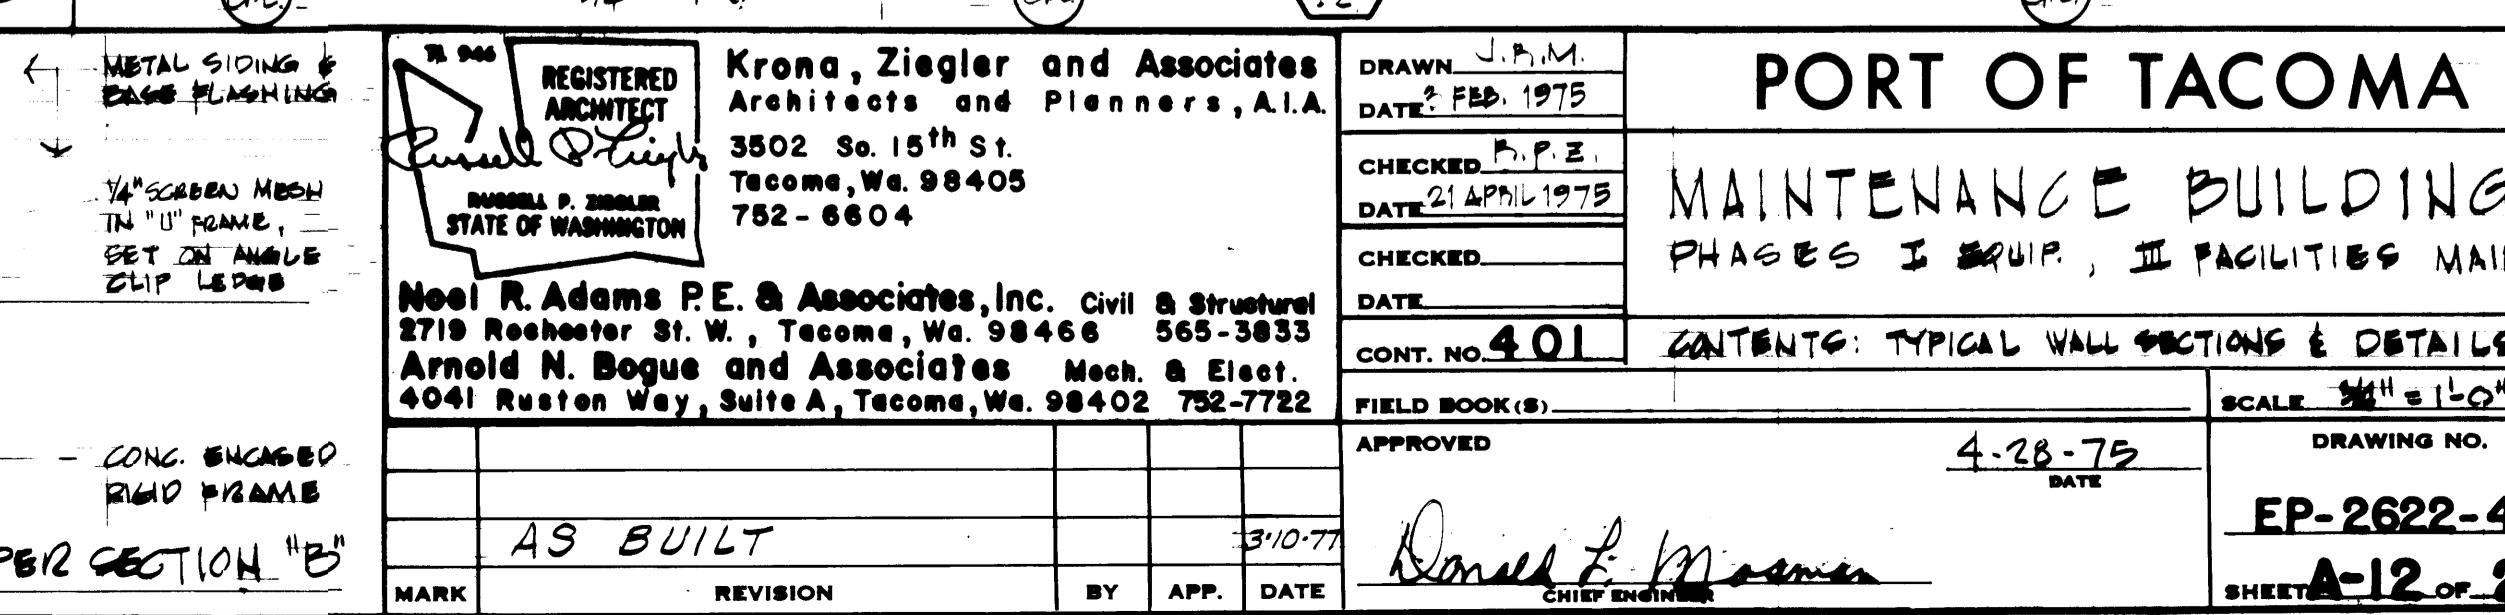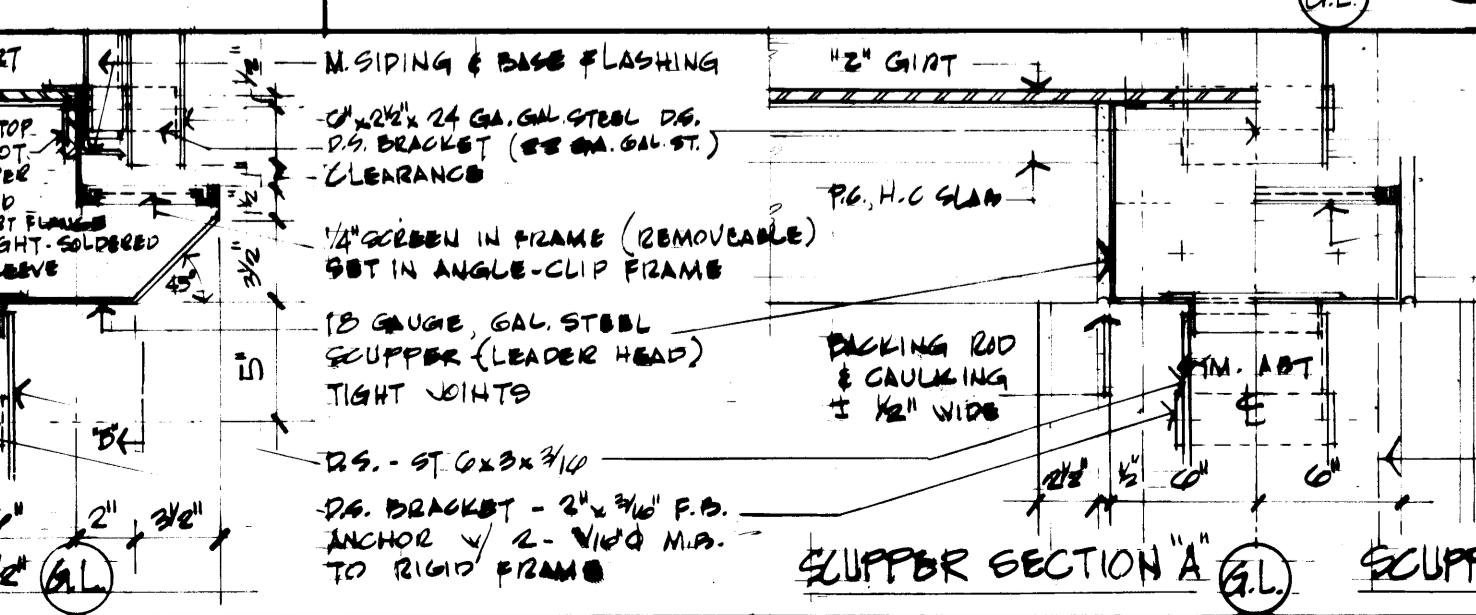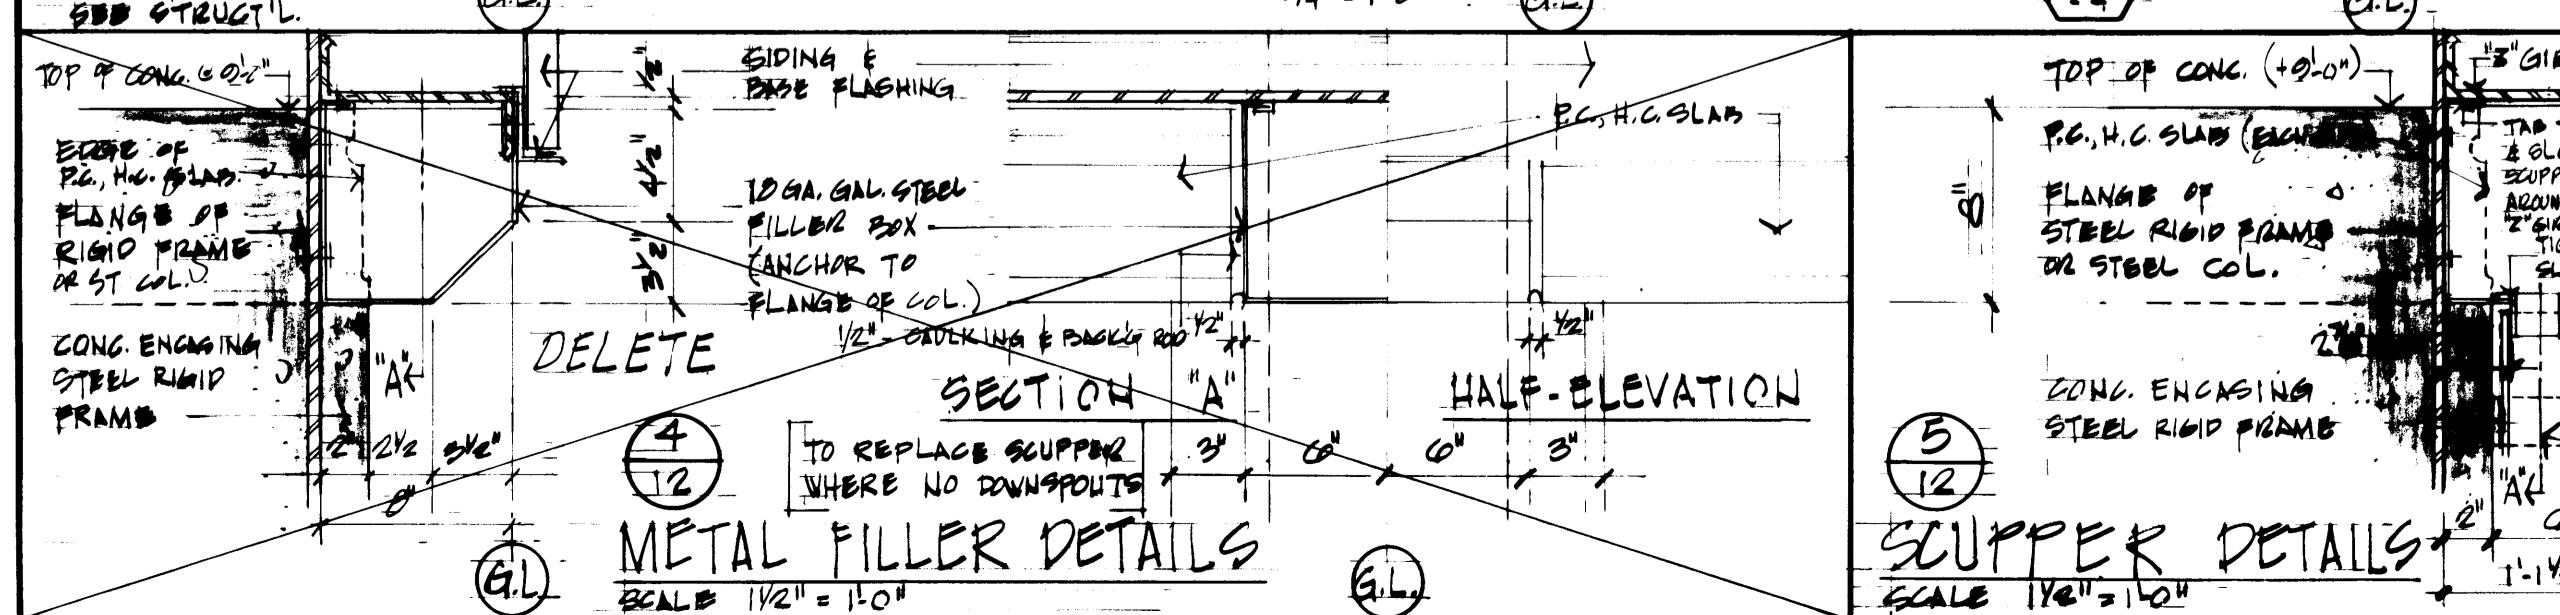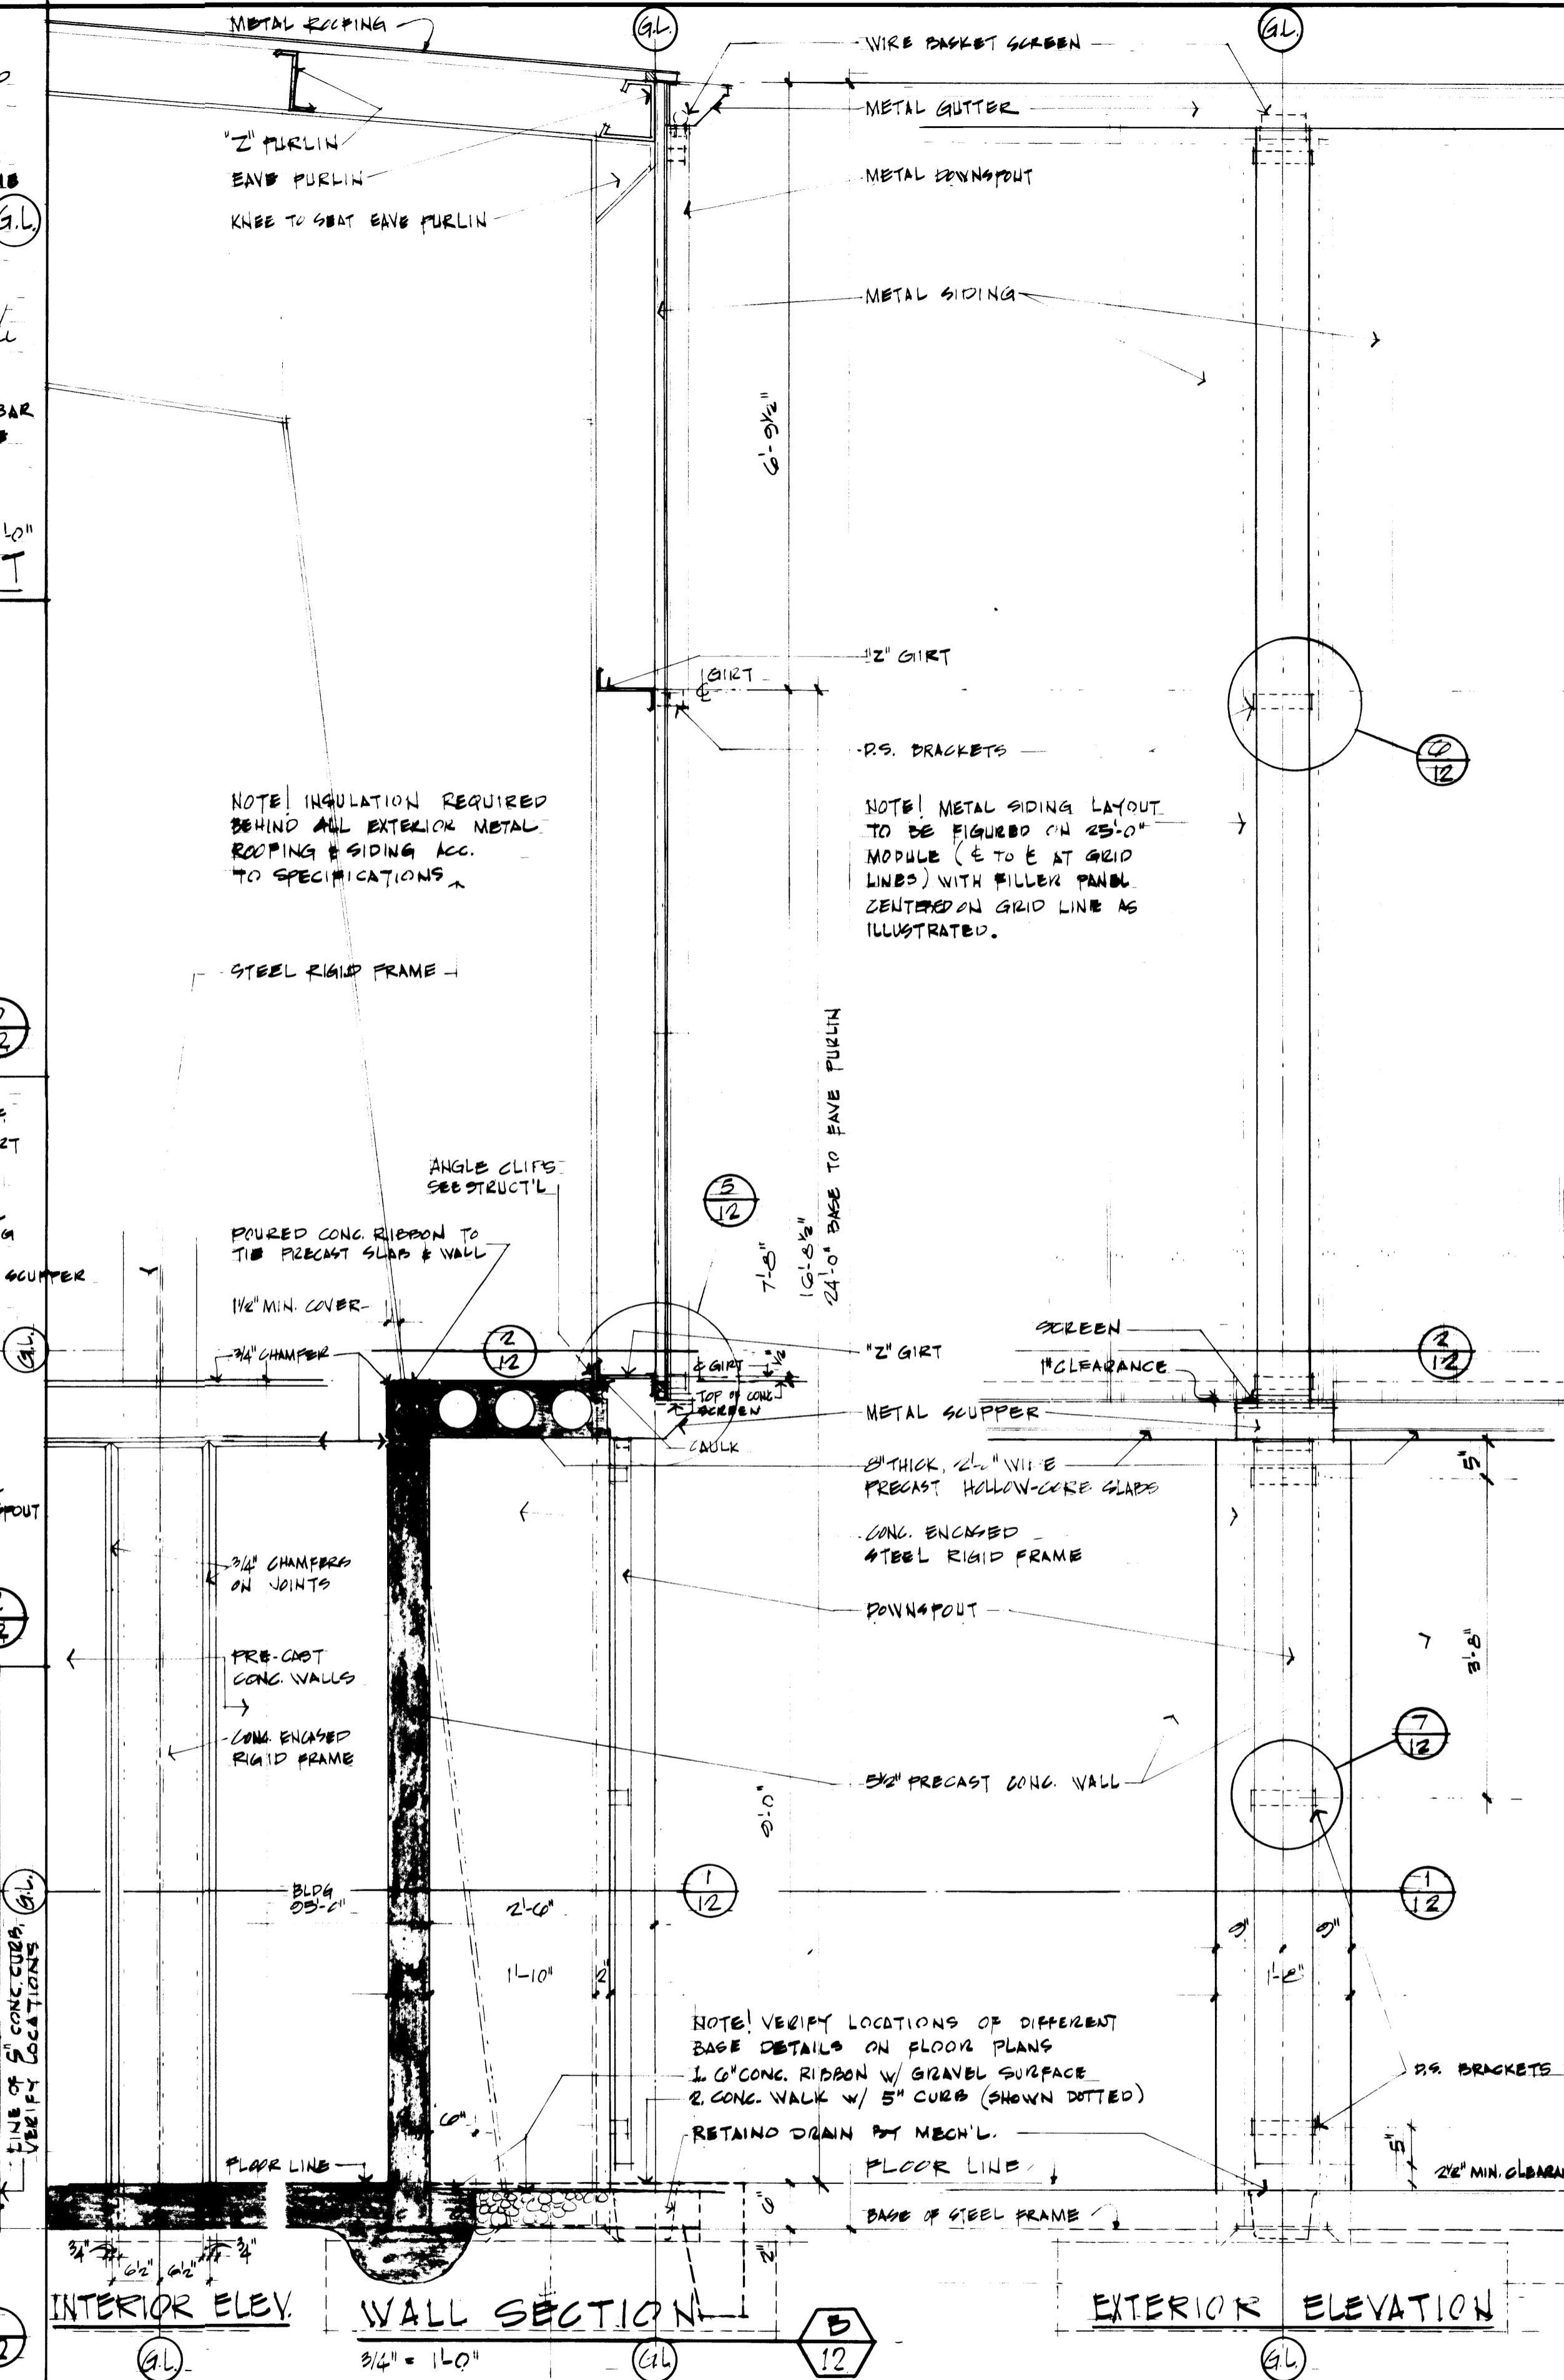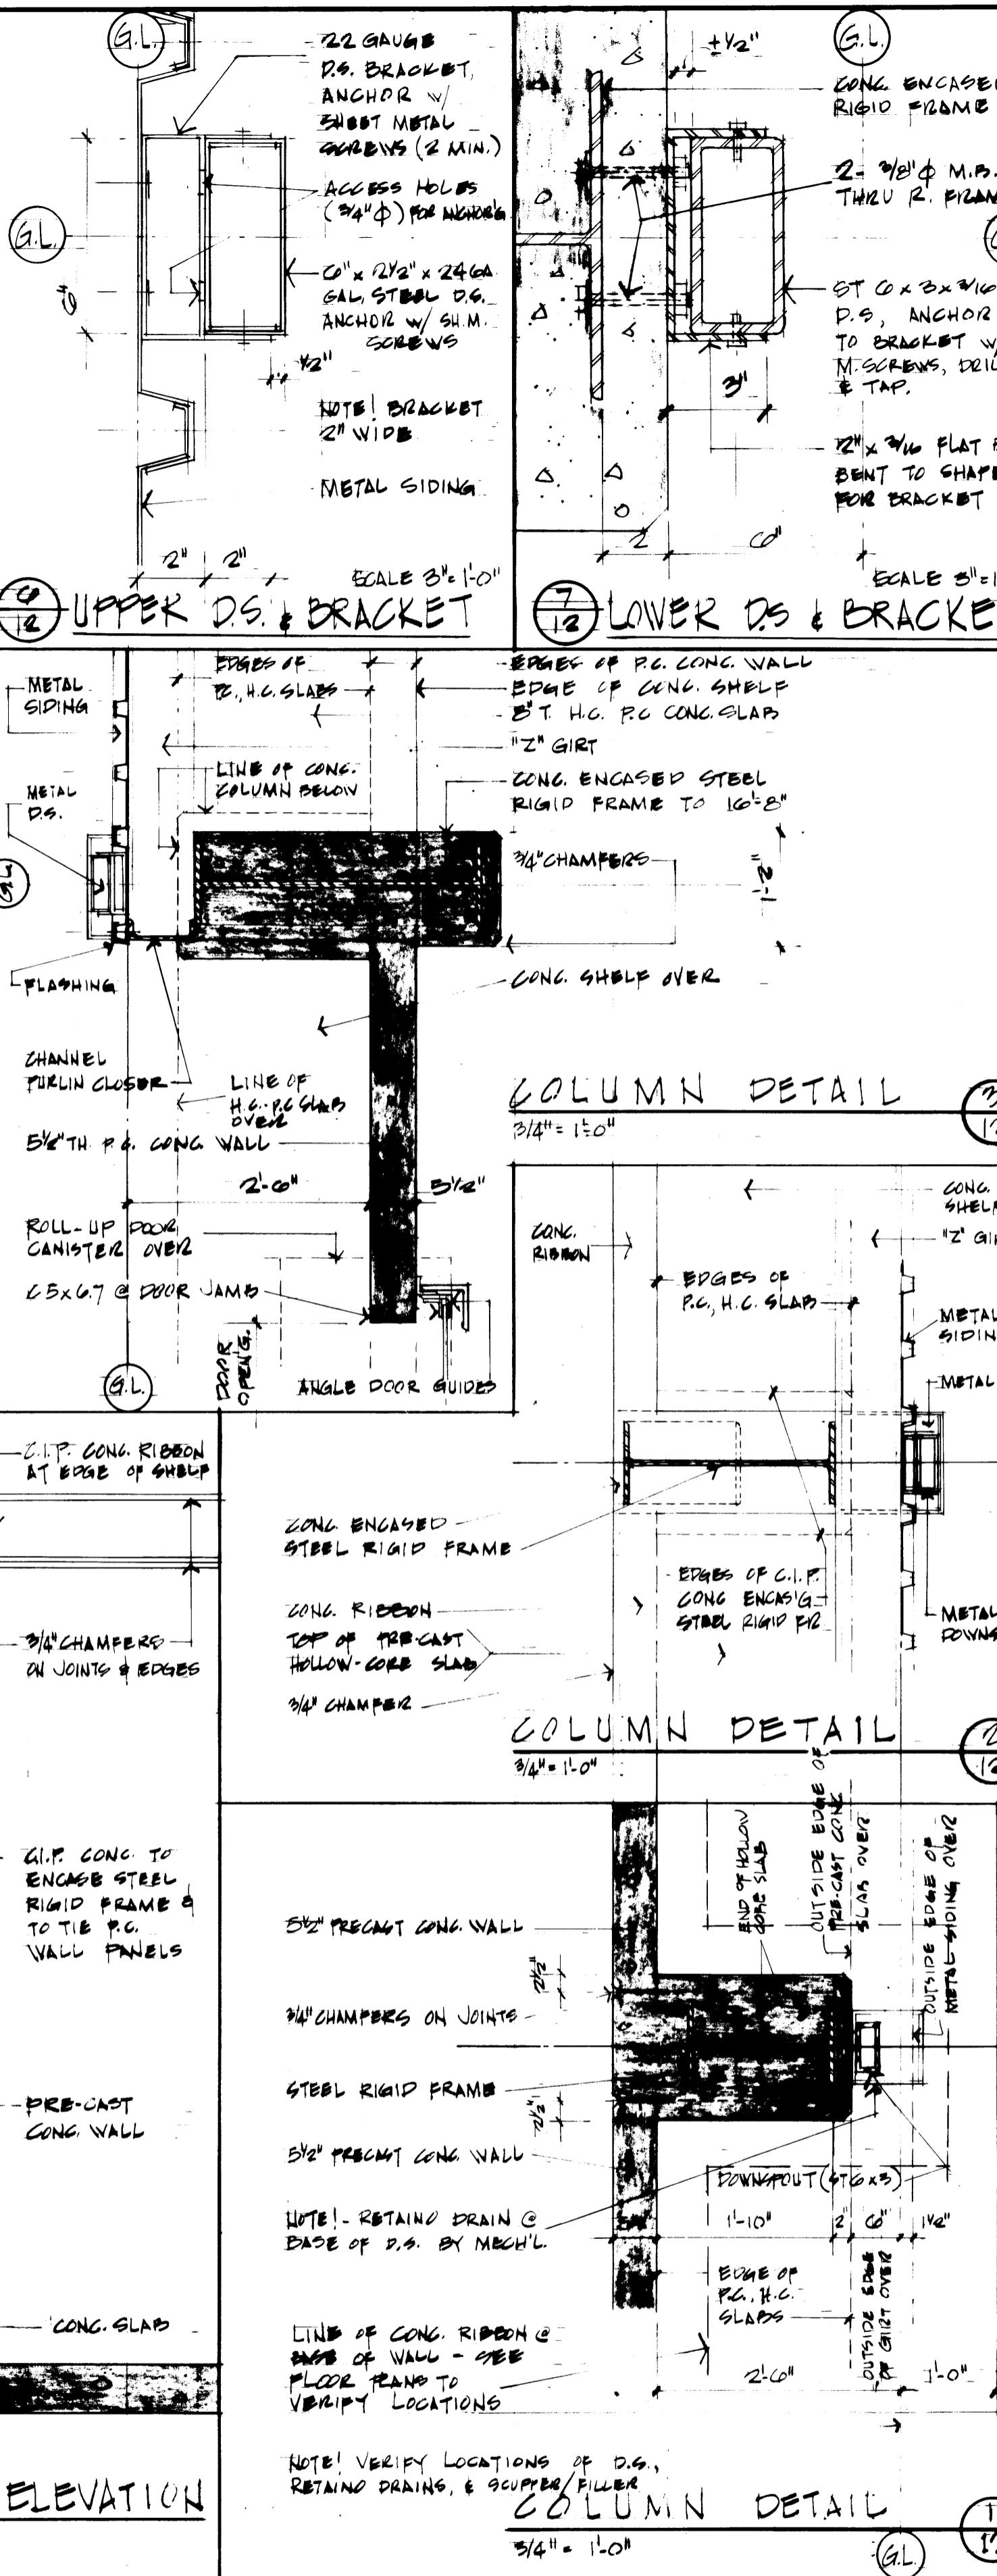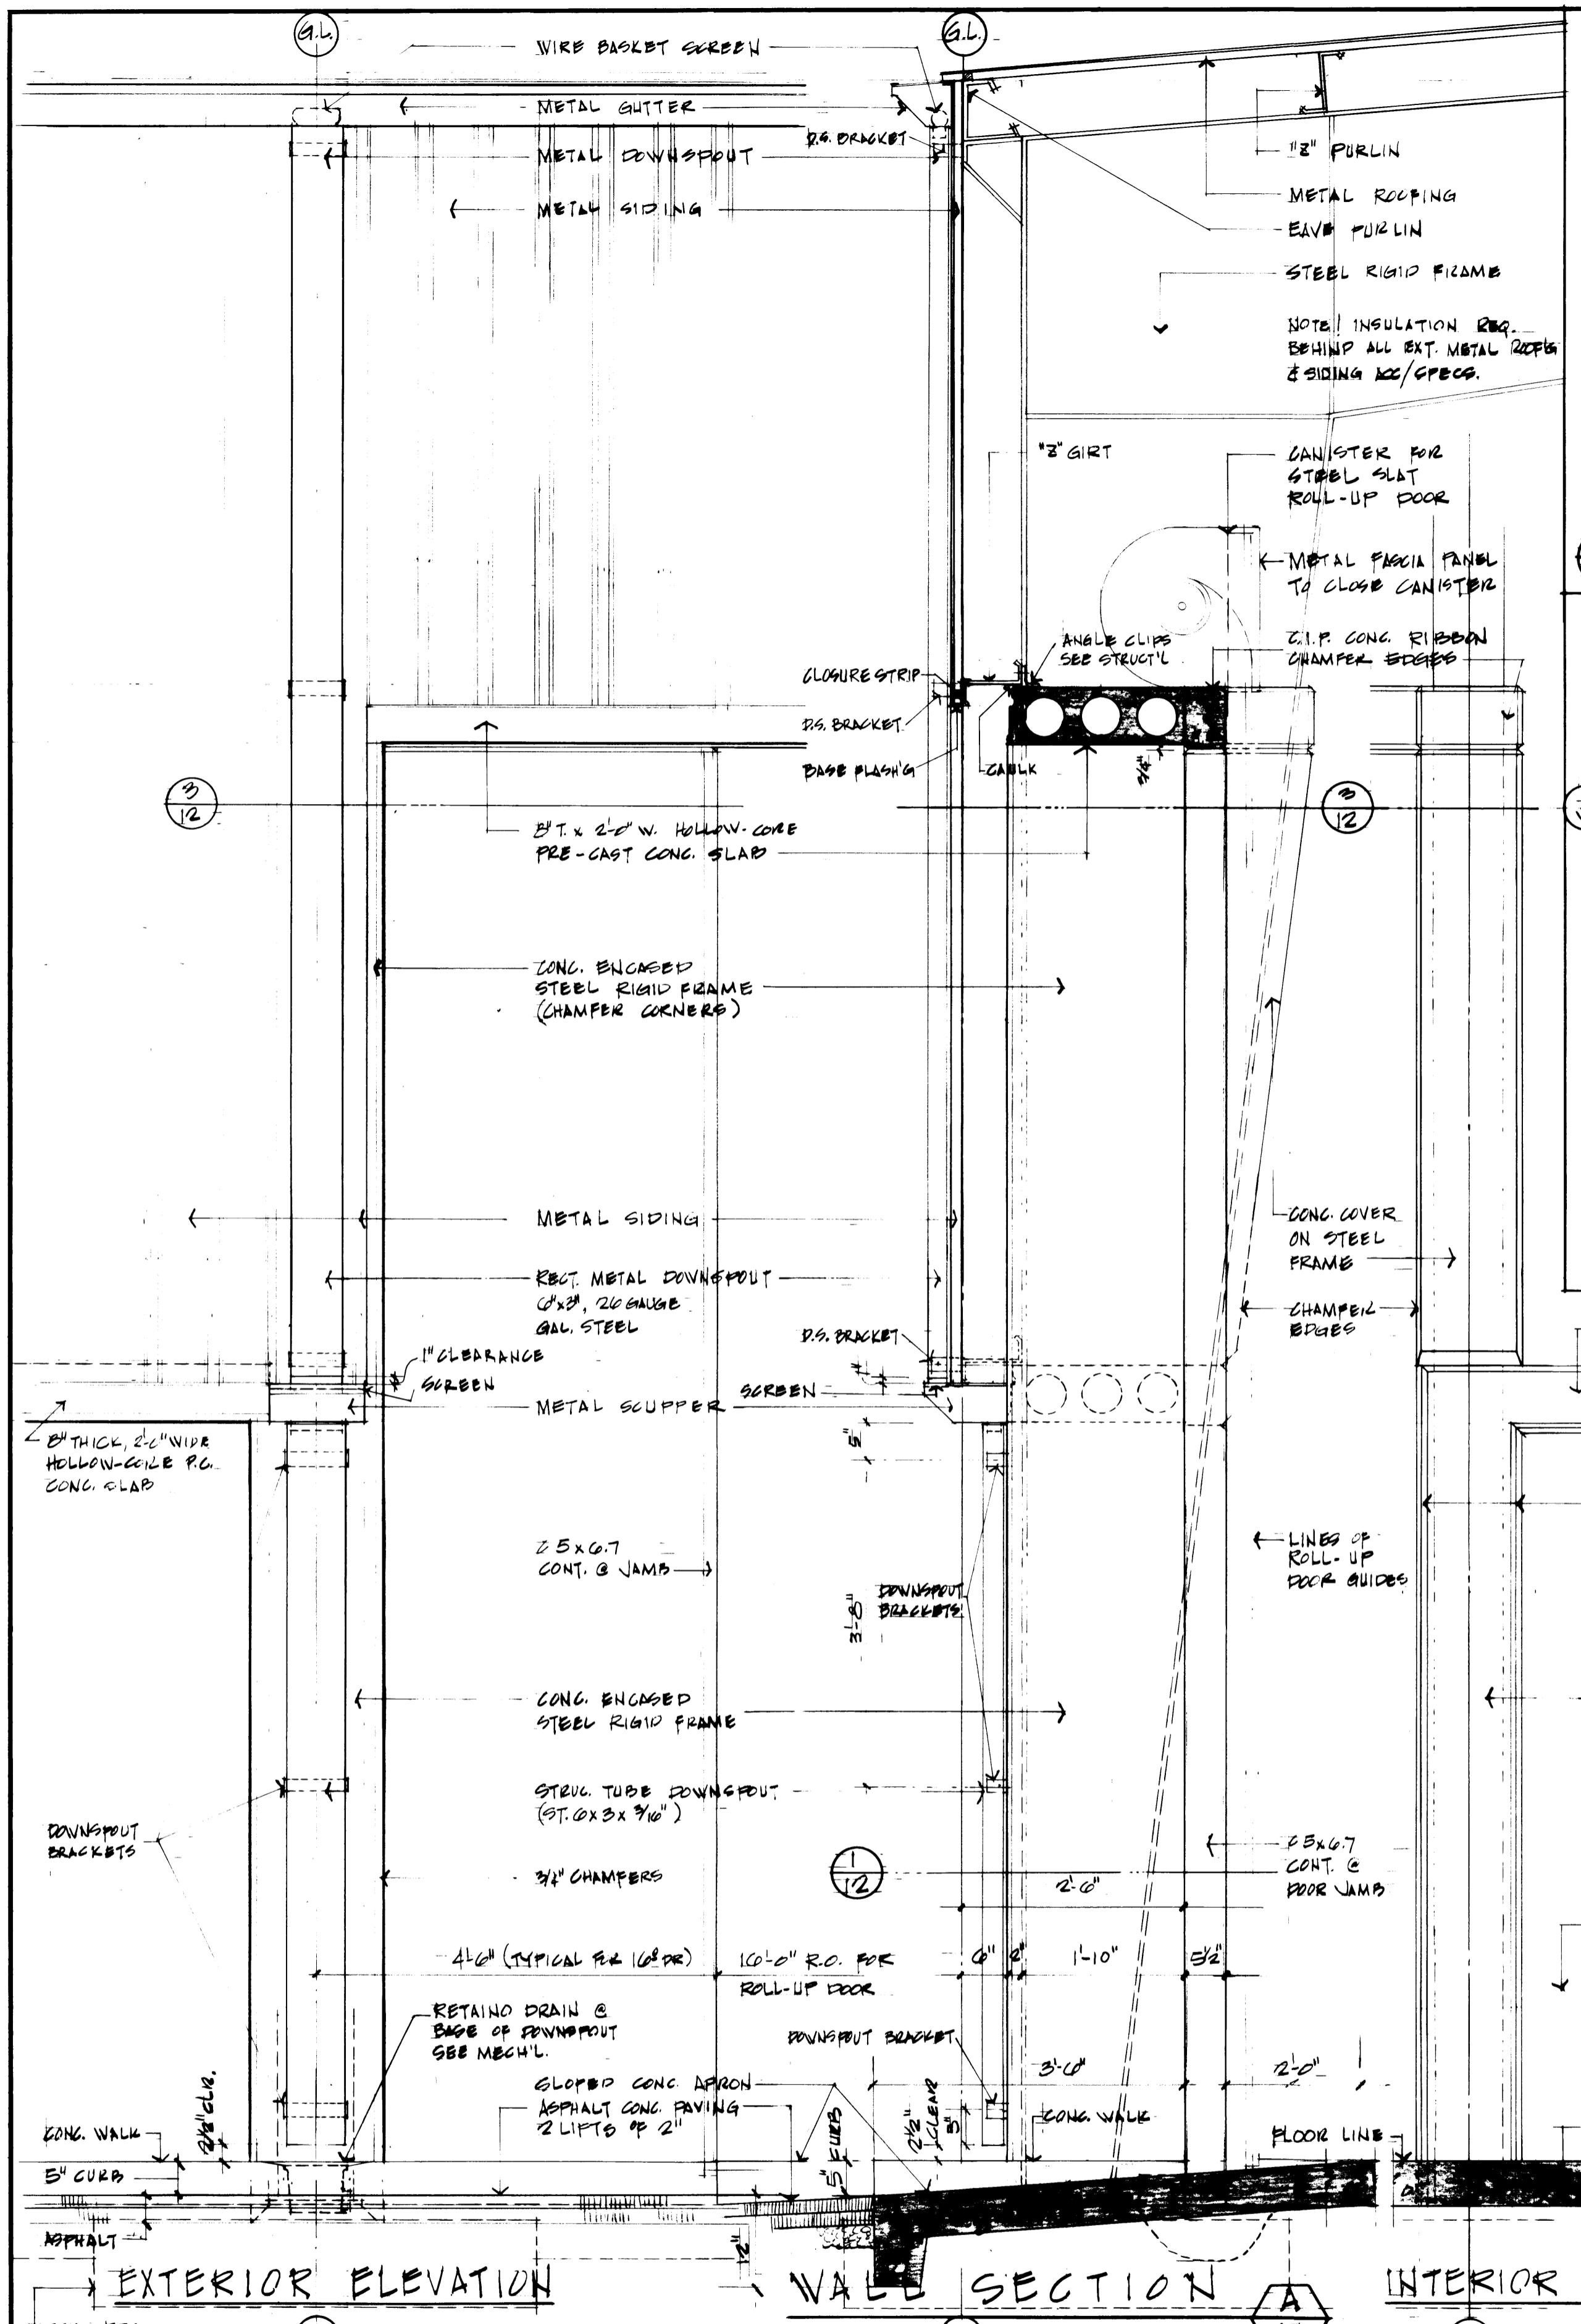

PORT OF TACOMA

MaintenancE BUILDING CASES I EQUIP., III FACILITIES MAINT.


INTENTS: TYPICAL WALL SECTIONS & DETAILS

SCALE $\frac{1}{100}^{\text{H}} = 1^{\text{L-Q}}^{\text{H}}$

4-28-75

EP-2622-4

asmen SHEET A-12 OF 24

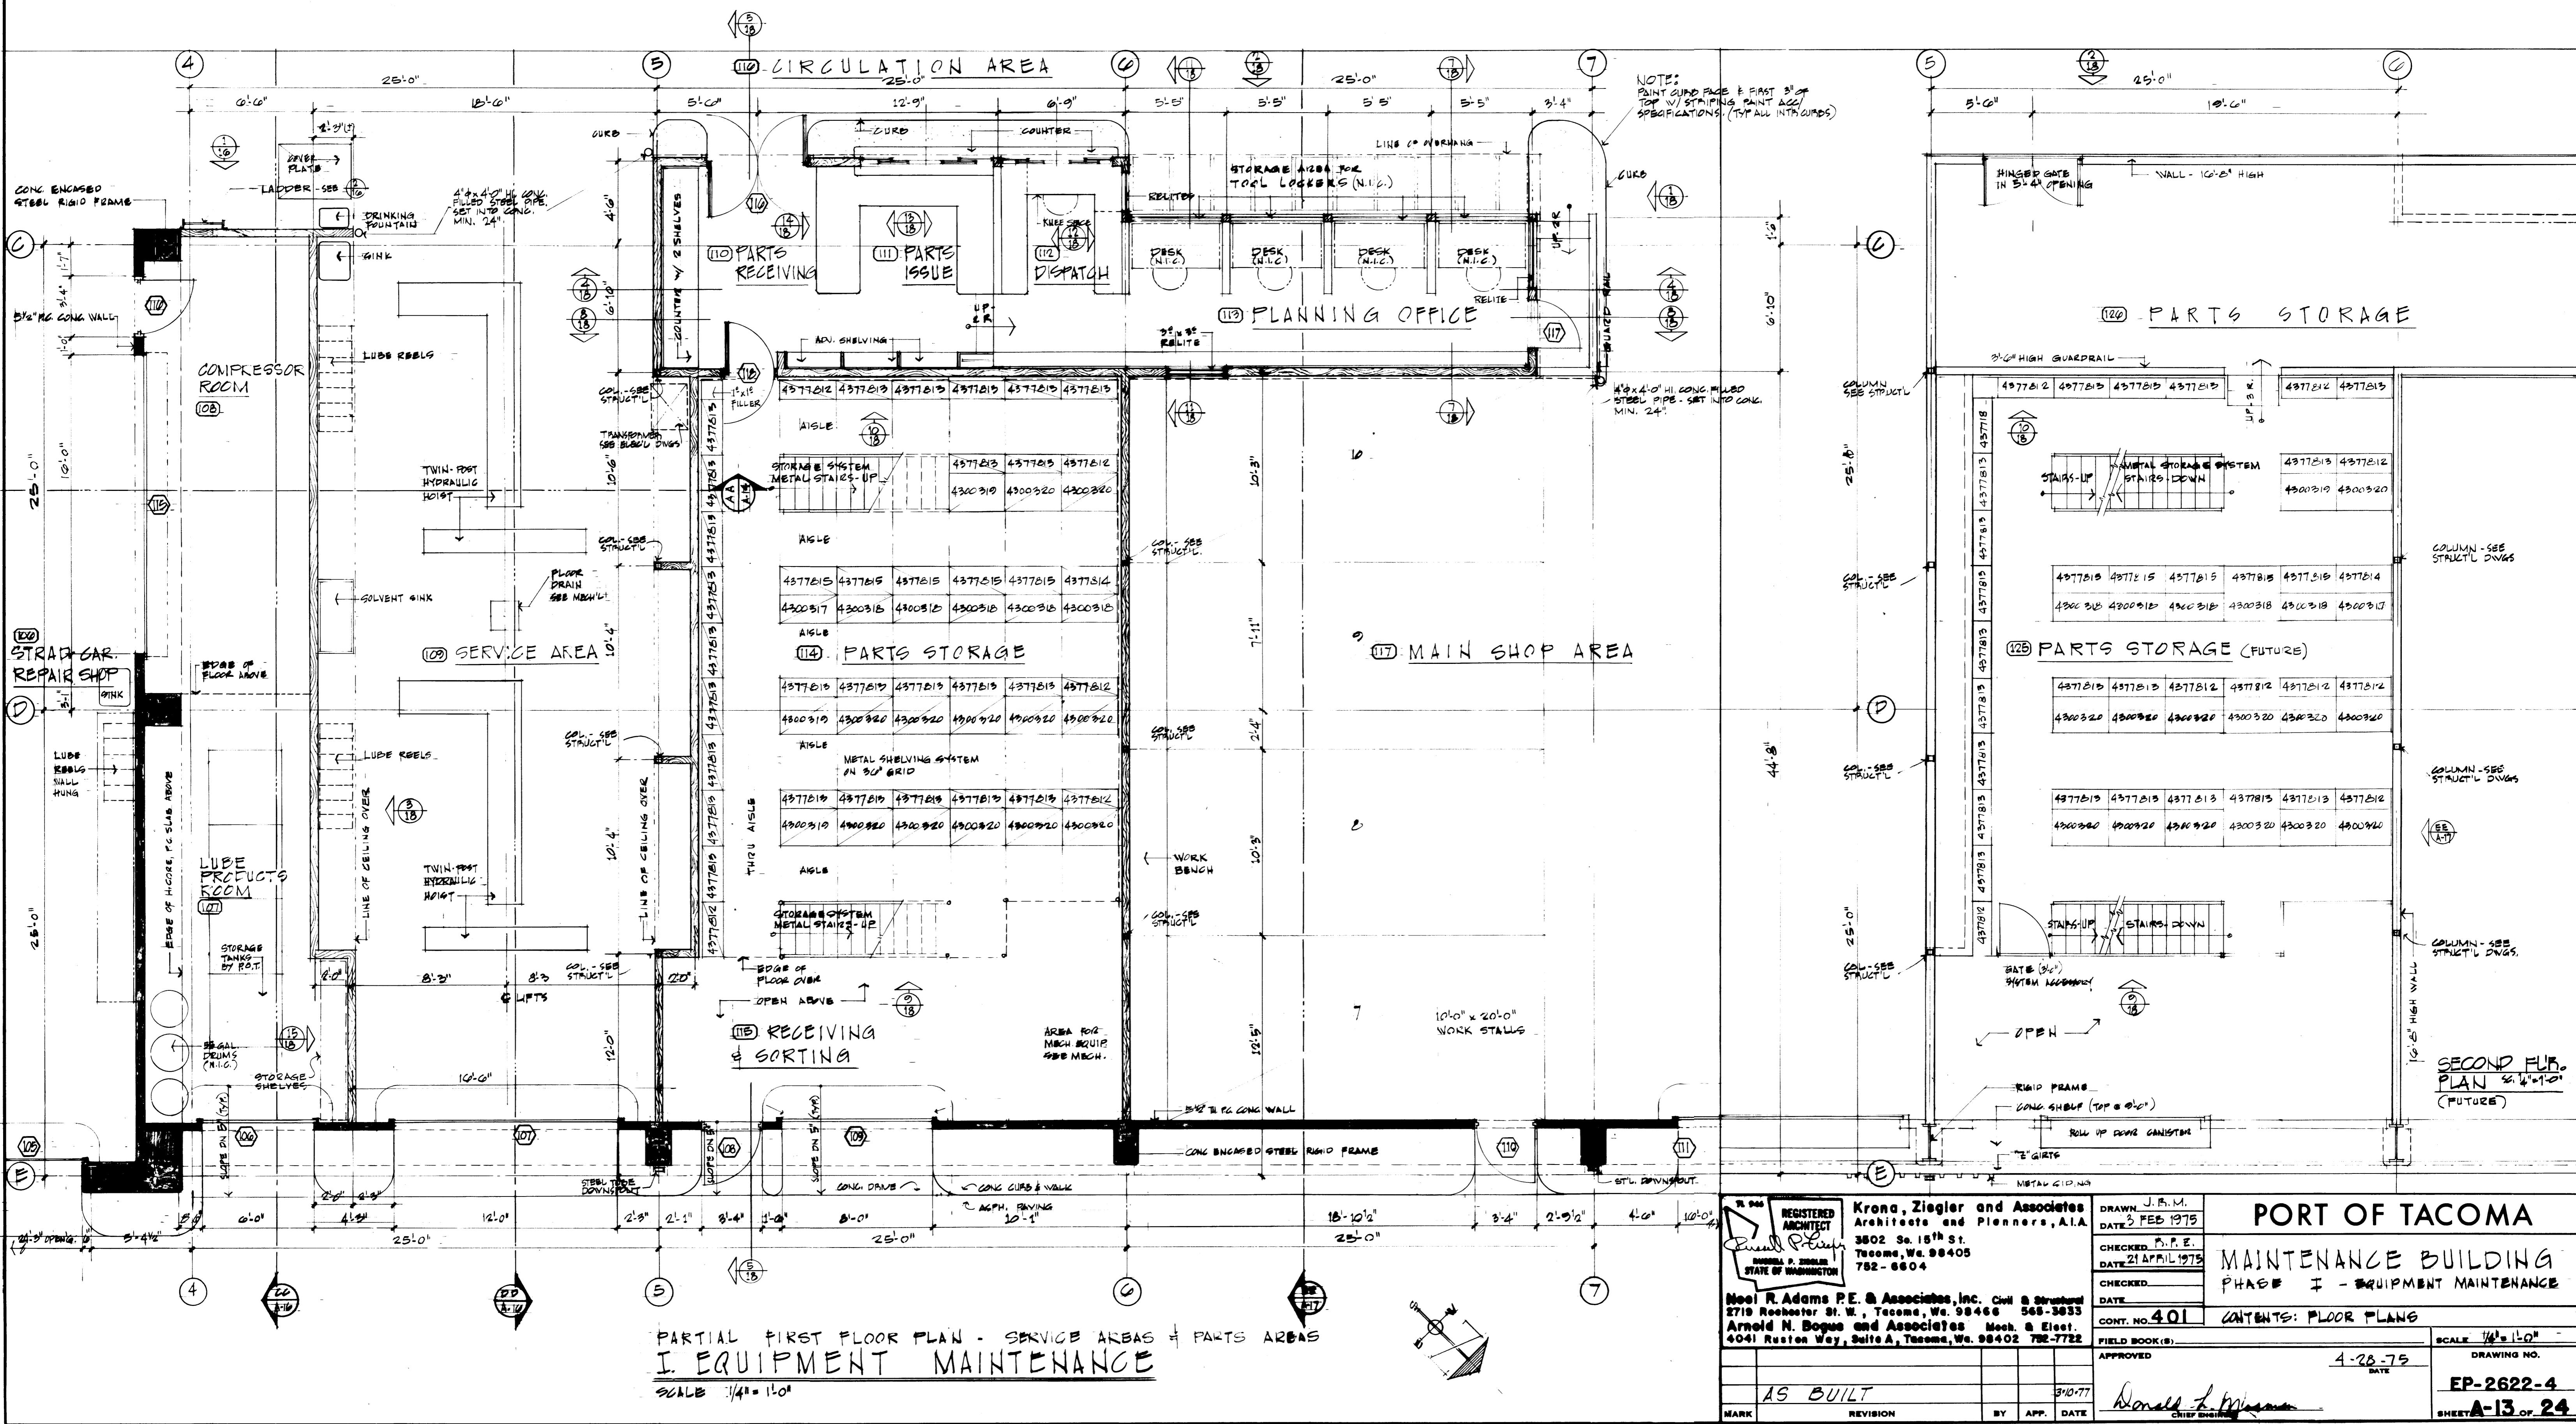

PARTIAL FIRST FLOOR PLAN - SERVICE AREAS & PARTS AREAS

I. EQUIPMENT MAINTENANCE

SCALE 1/4" = 100

Neel R. Adams P.E. & Associates, Inc. Civil & Structural
2719 Rochester St. W., Tacoma, Wa. 98466 565-3833
Arnold N. Boggs and Associates Mech. & Elect.
4041 Ruston Way, Suite A, Tacoma, Wa. 98402 752-7722

				APPROVED
16 BUILT		3/12/77		C

AS BUILT		5/10/11			Donald	
MARK	REVISION	BY	APP.	DATE	CHARGE	

PORT OF TACOMA

MAINTENANCE BUILDING

PHASE I - EQUIPMENT MAINTENANCE



CONTENTS: FLOOR PLANS

SCALE $\frac{1}{4}^{\text{in}} = 1'-0^{\text{in}}$


4-28-75 DRAWING NO.

EP-2622-4

SHEET A-13 OF 24

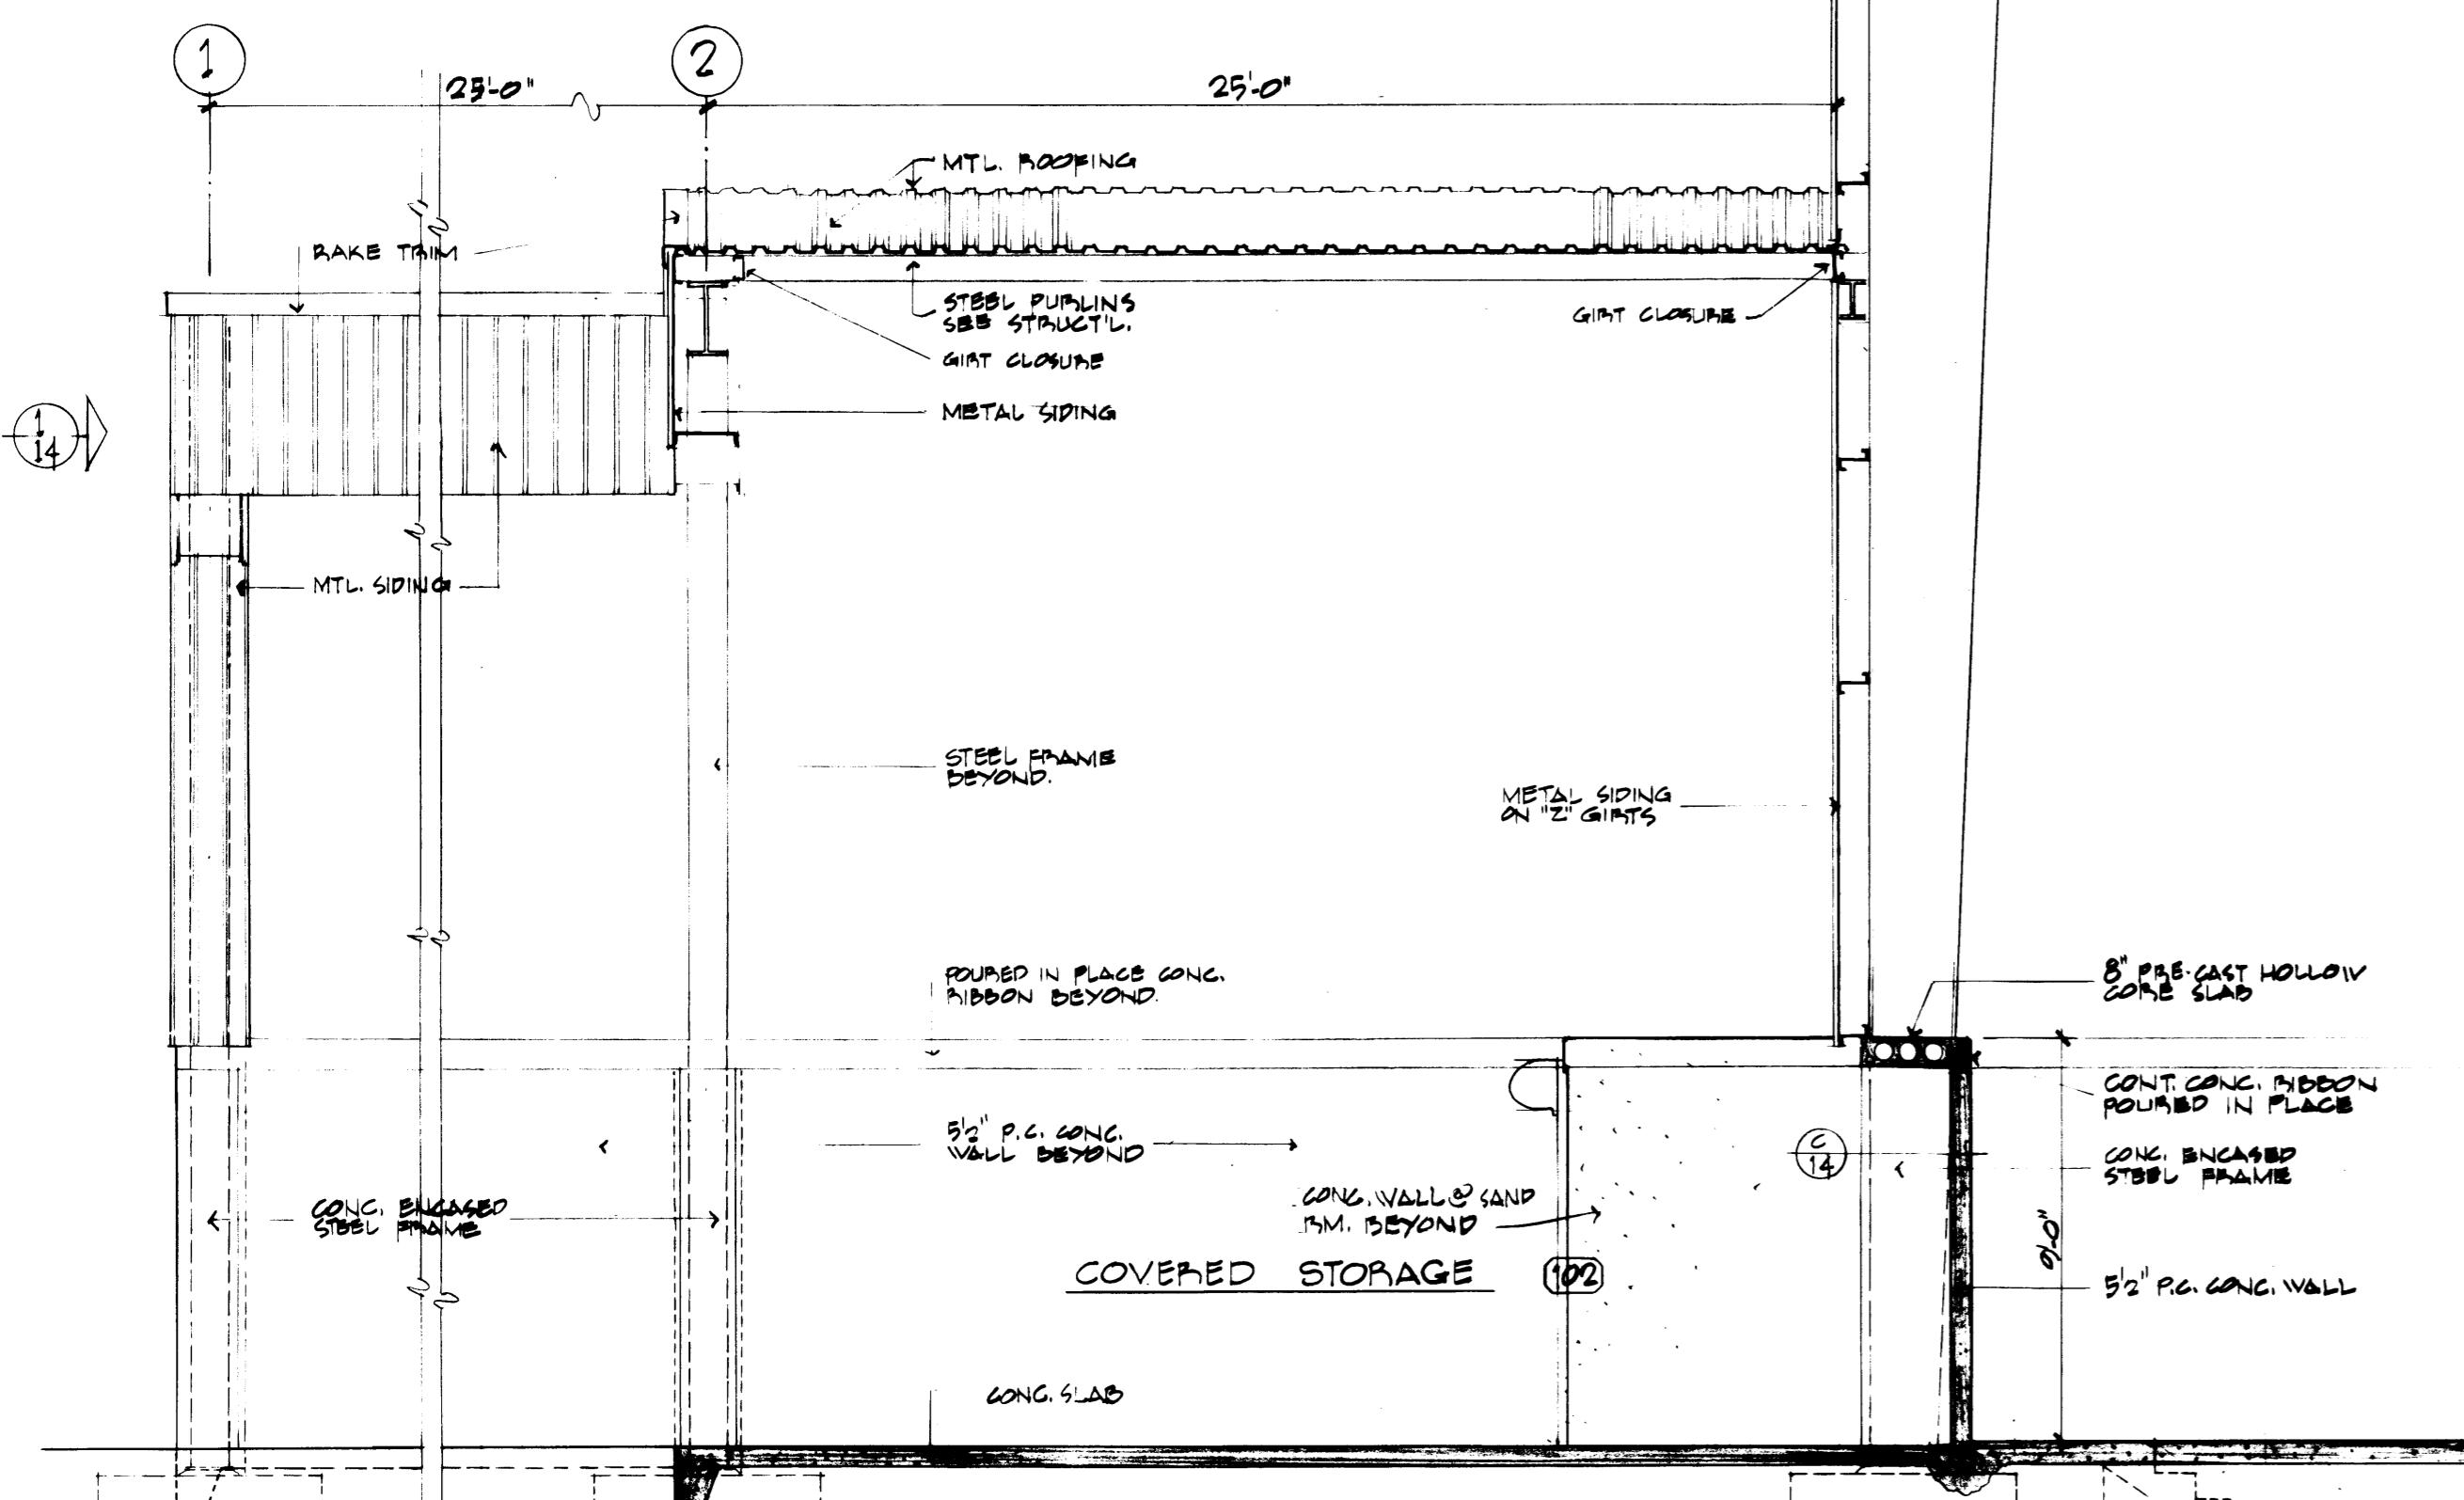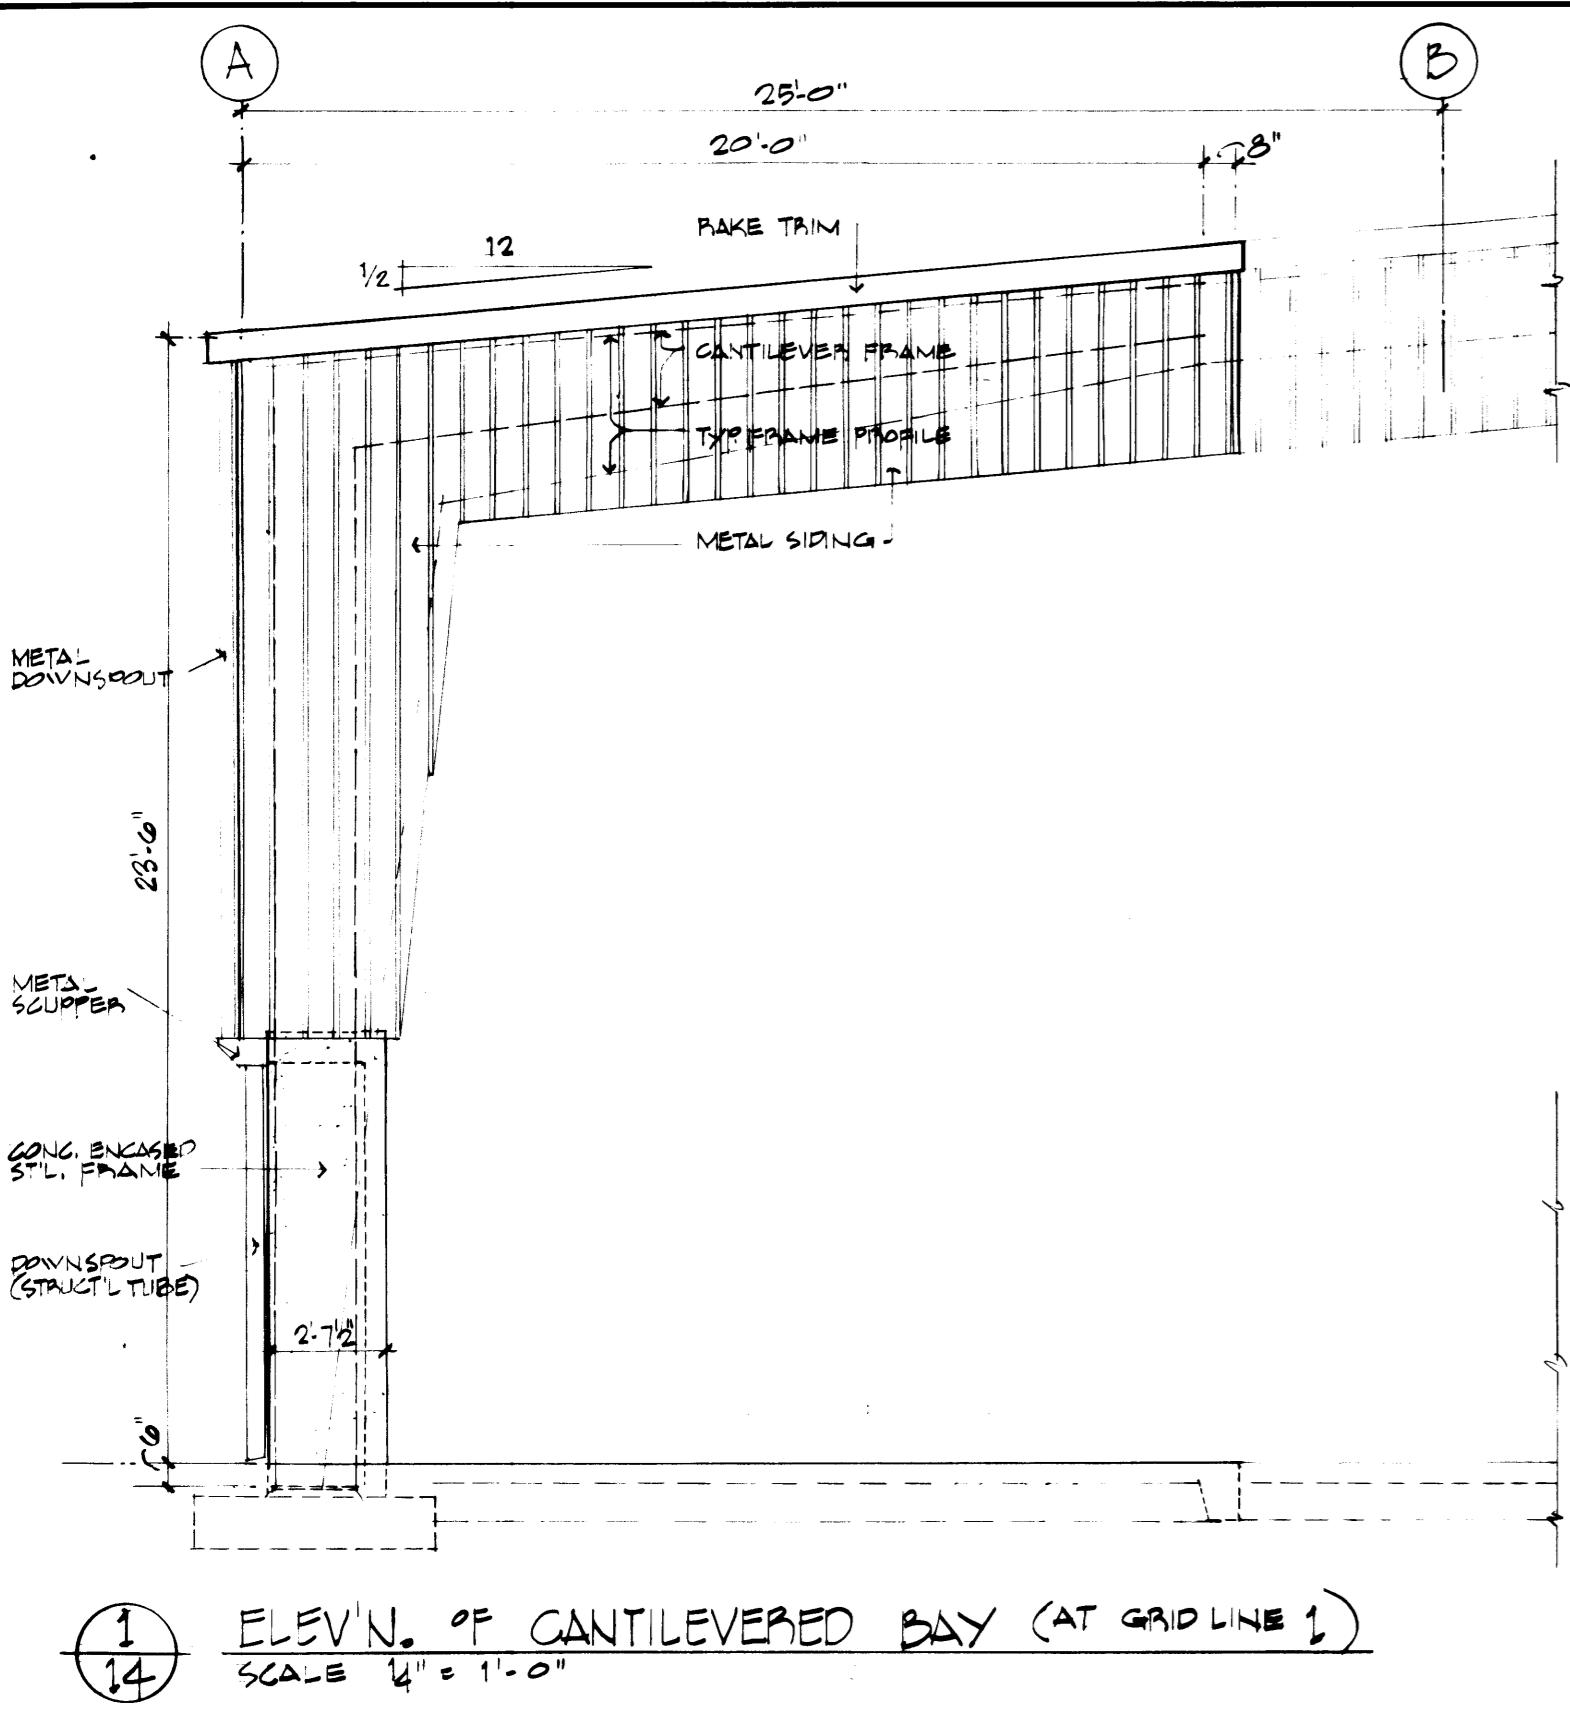

BUILDING SECTION "A-A"
SCALE $\frac{1}{4}$ " = 1'-0"

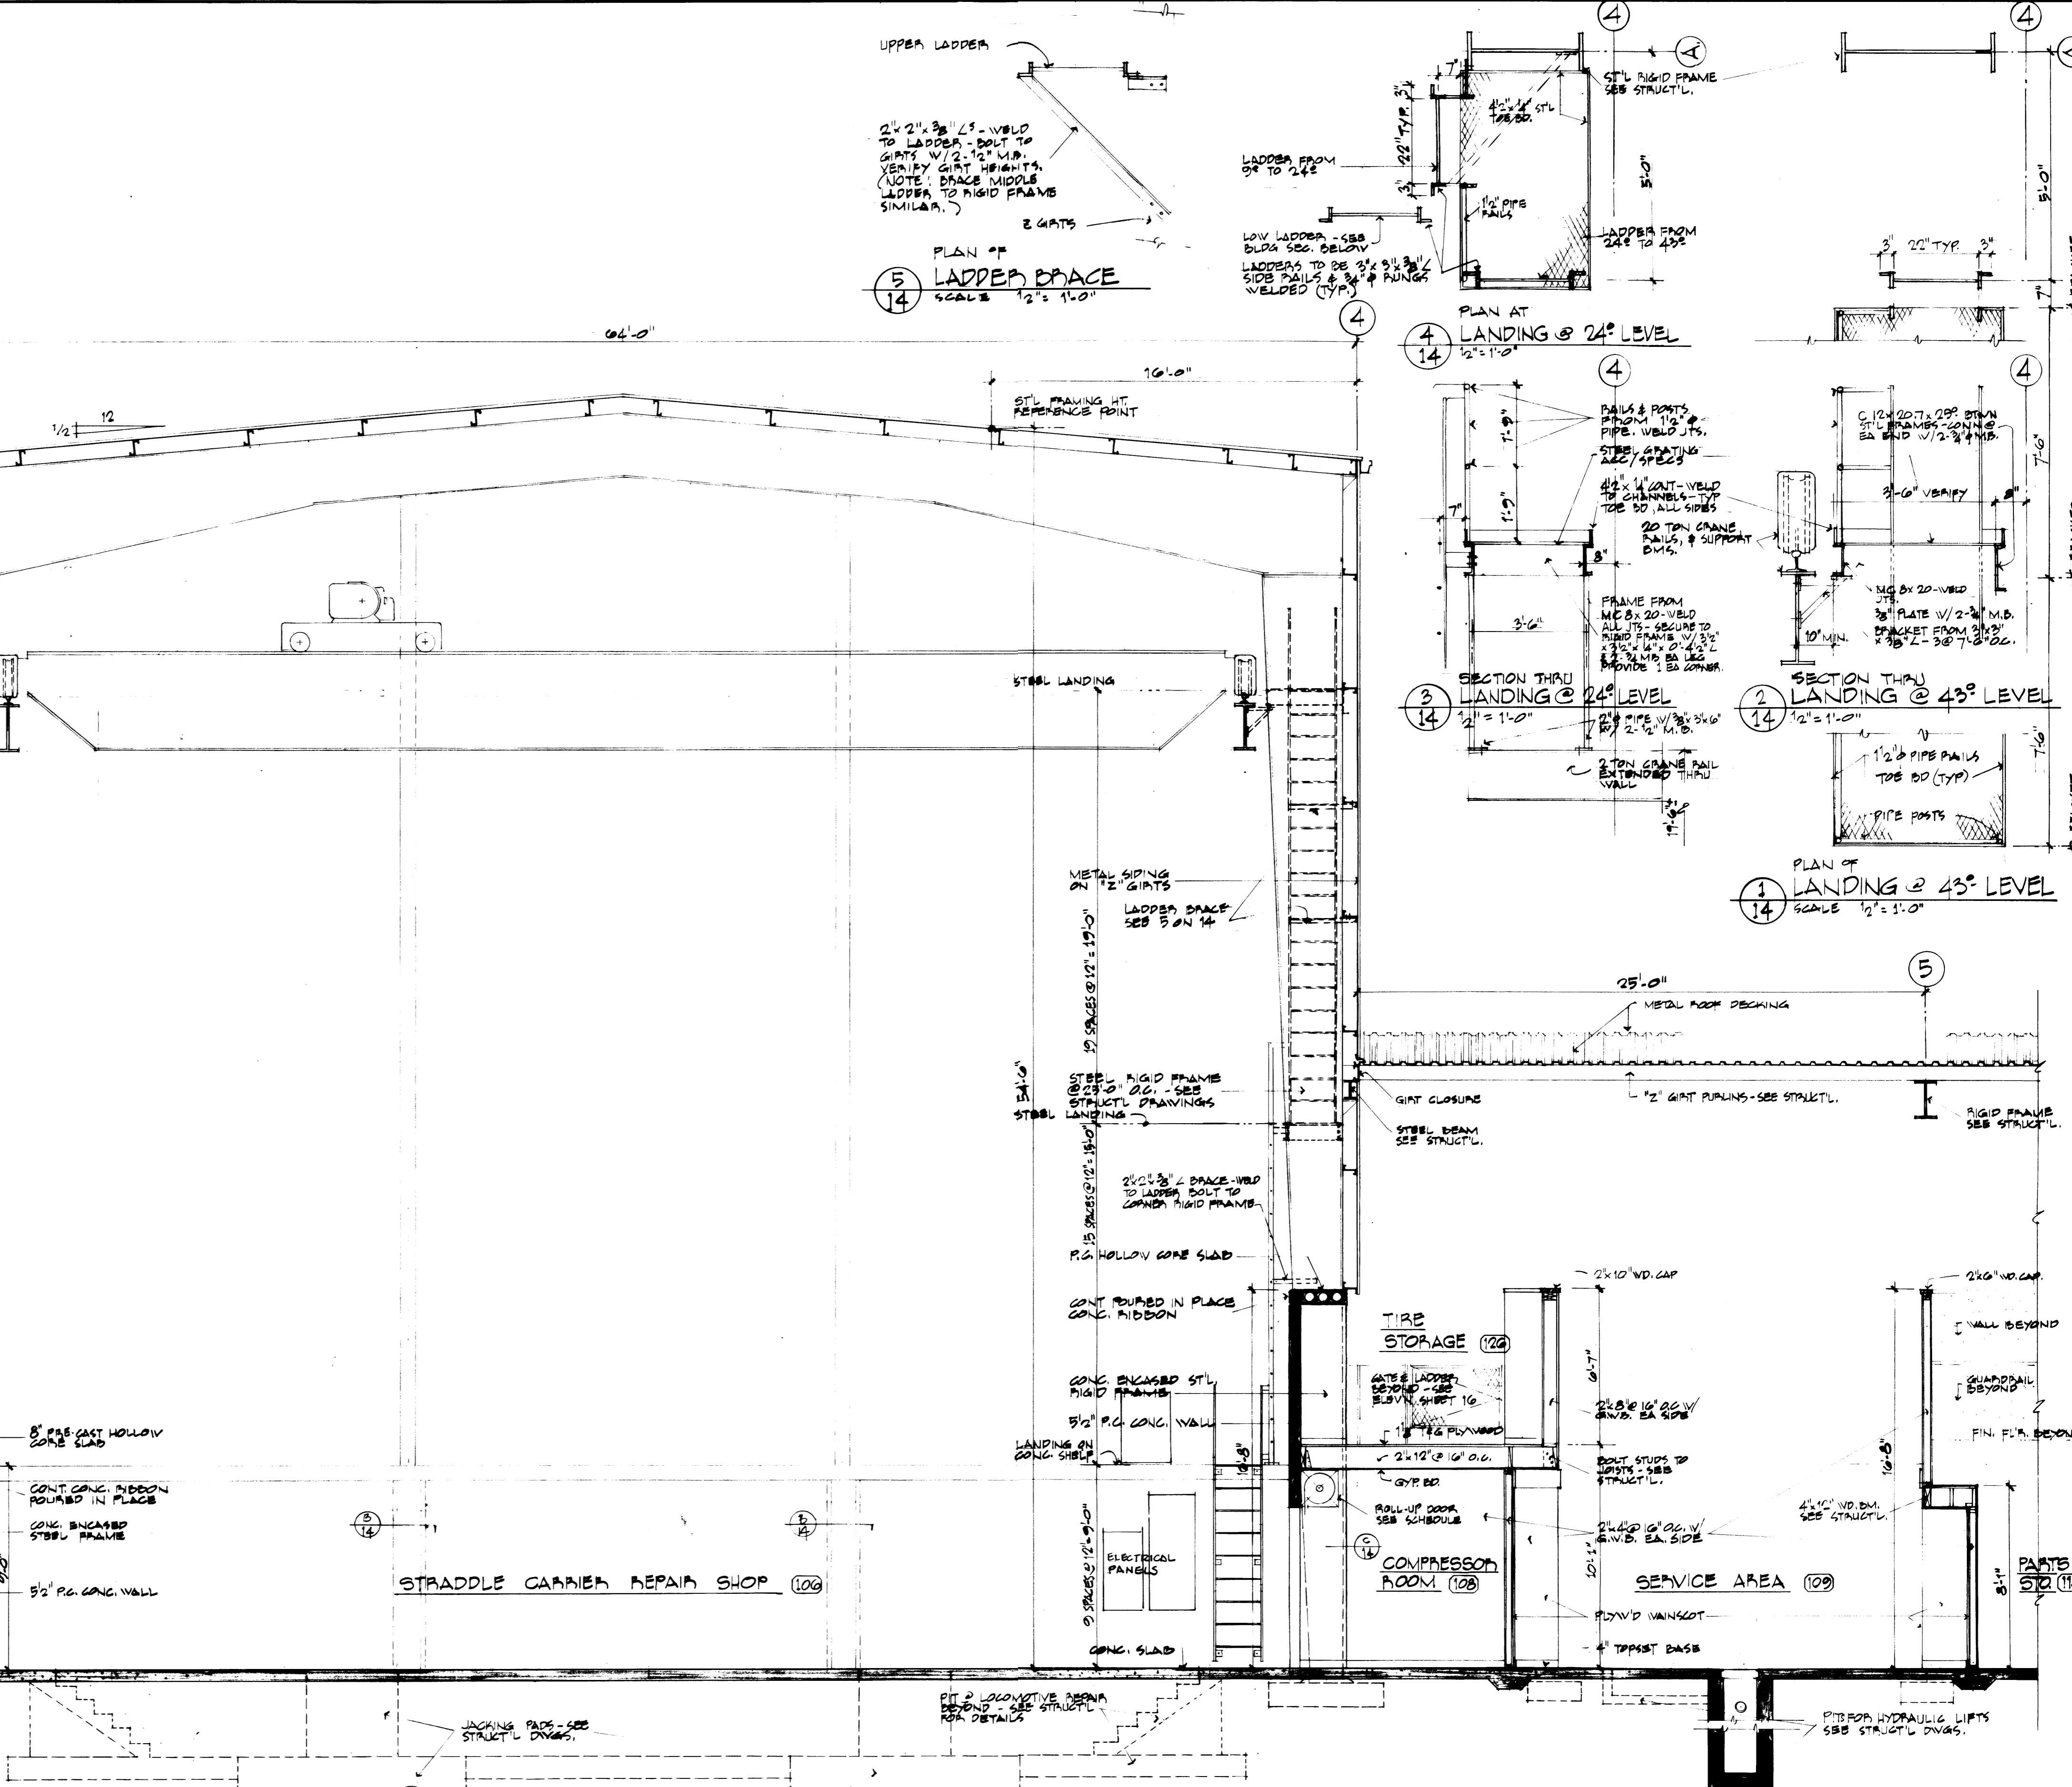

**C COLUMN DETAIL (HIGH BAY SIDE WALL)
INTERMEDIATE COLUMNS**

3 COLUMN DETAIL (^{HIGH BAY} _{END WALL})

Noel R. Adams P.E. & Associates, Inc.
2719 Rochester St. W., Tacoma, Wa. 98407

Arnold N. Bogue and Associates

4041 Ruston Way, Suite A, Tacoma, Wa. 98404

AS BUILT

MARK	REVISION
-------------	-----------------

Digitized by srujanika@gmail.com

PORT OF TACOMA

PORT OF TACOMA

MAINTENANCE BUILDING

PHASE I: EQUIPMENT MAINTENANCE


CONTENTS: 11 PG SECTION & DETAILS



SCALE $1/4" = 1'-0"$ DRAWING NO. 1

4-28-75
DATE





EP-2022-5
SHEET A-14 OF 2

Digitized by srujanika@gmail.com

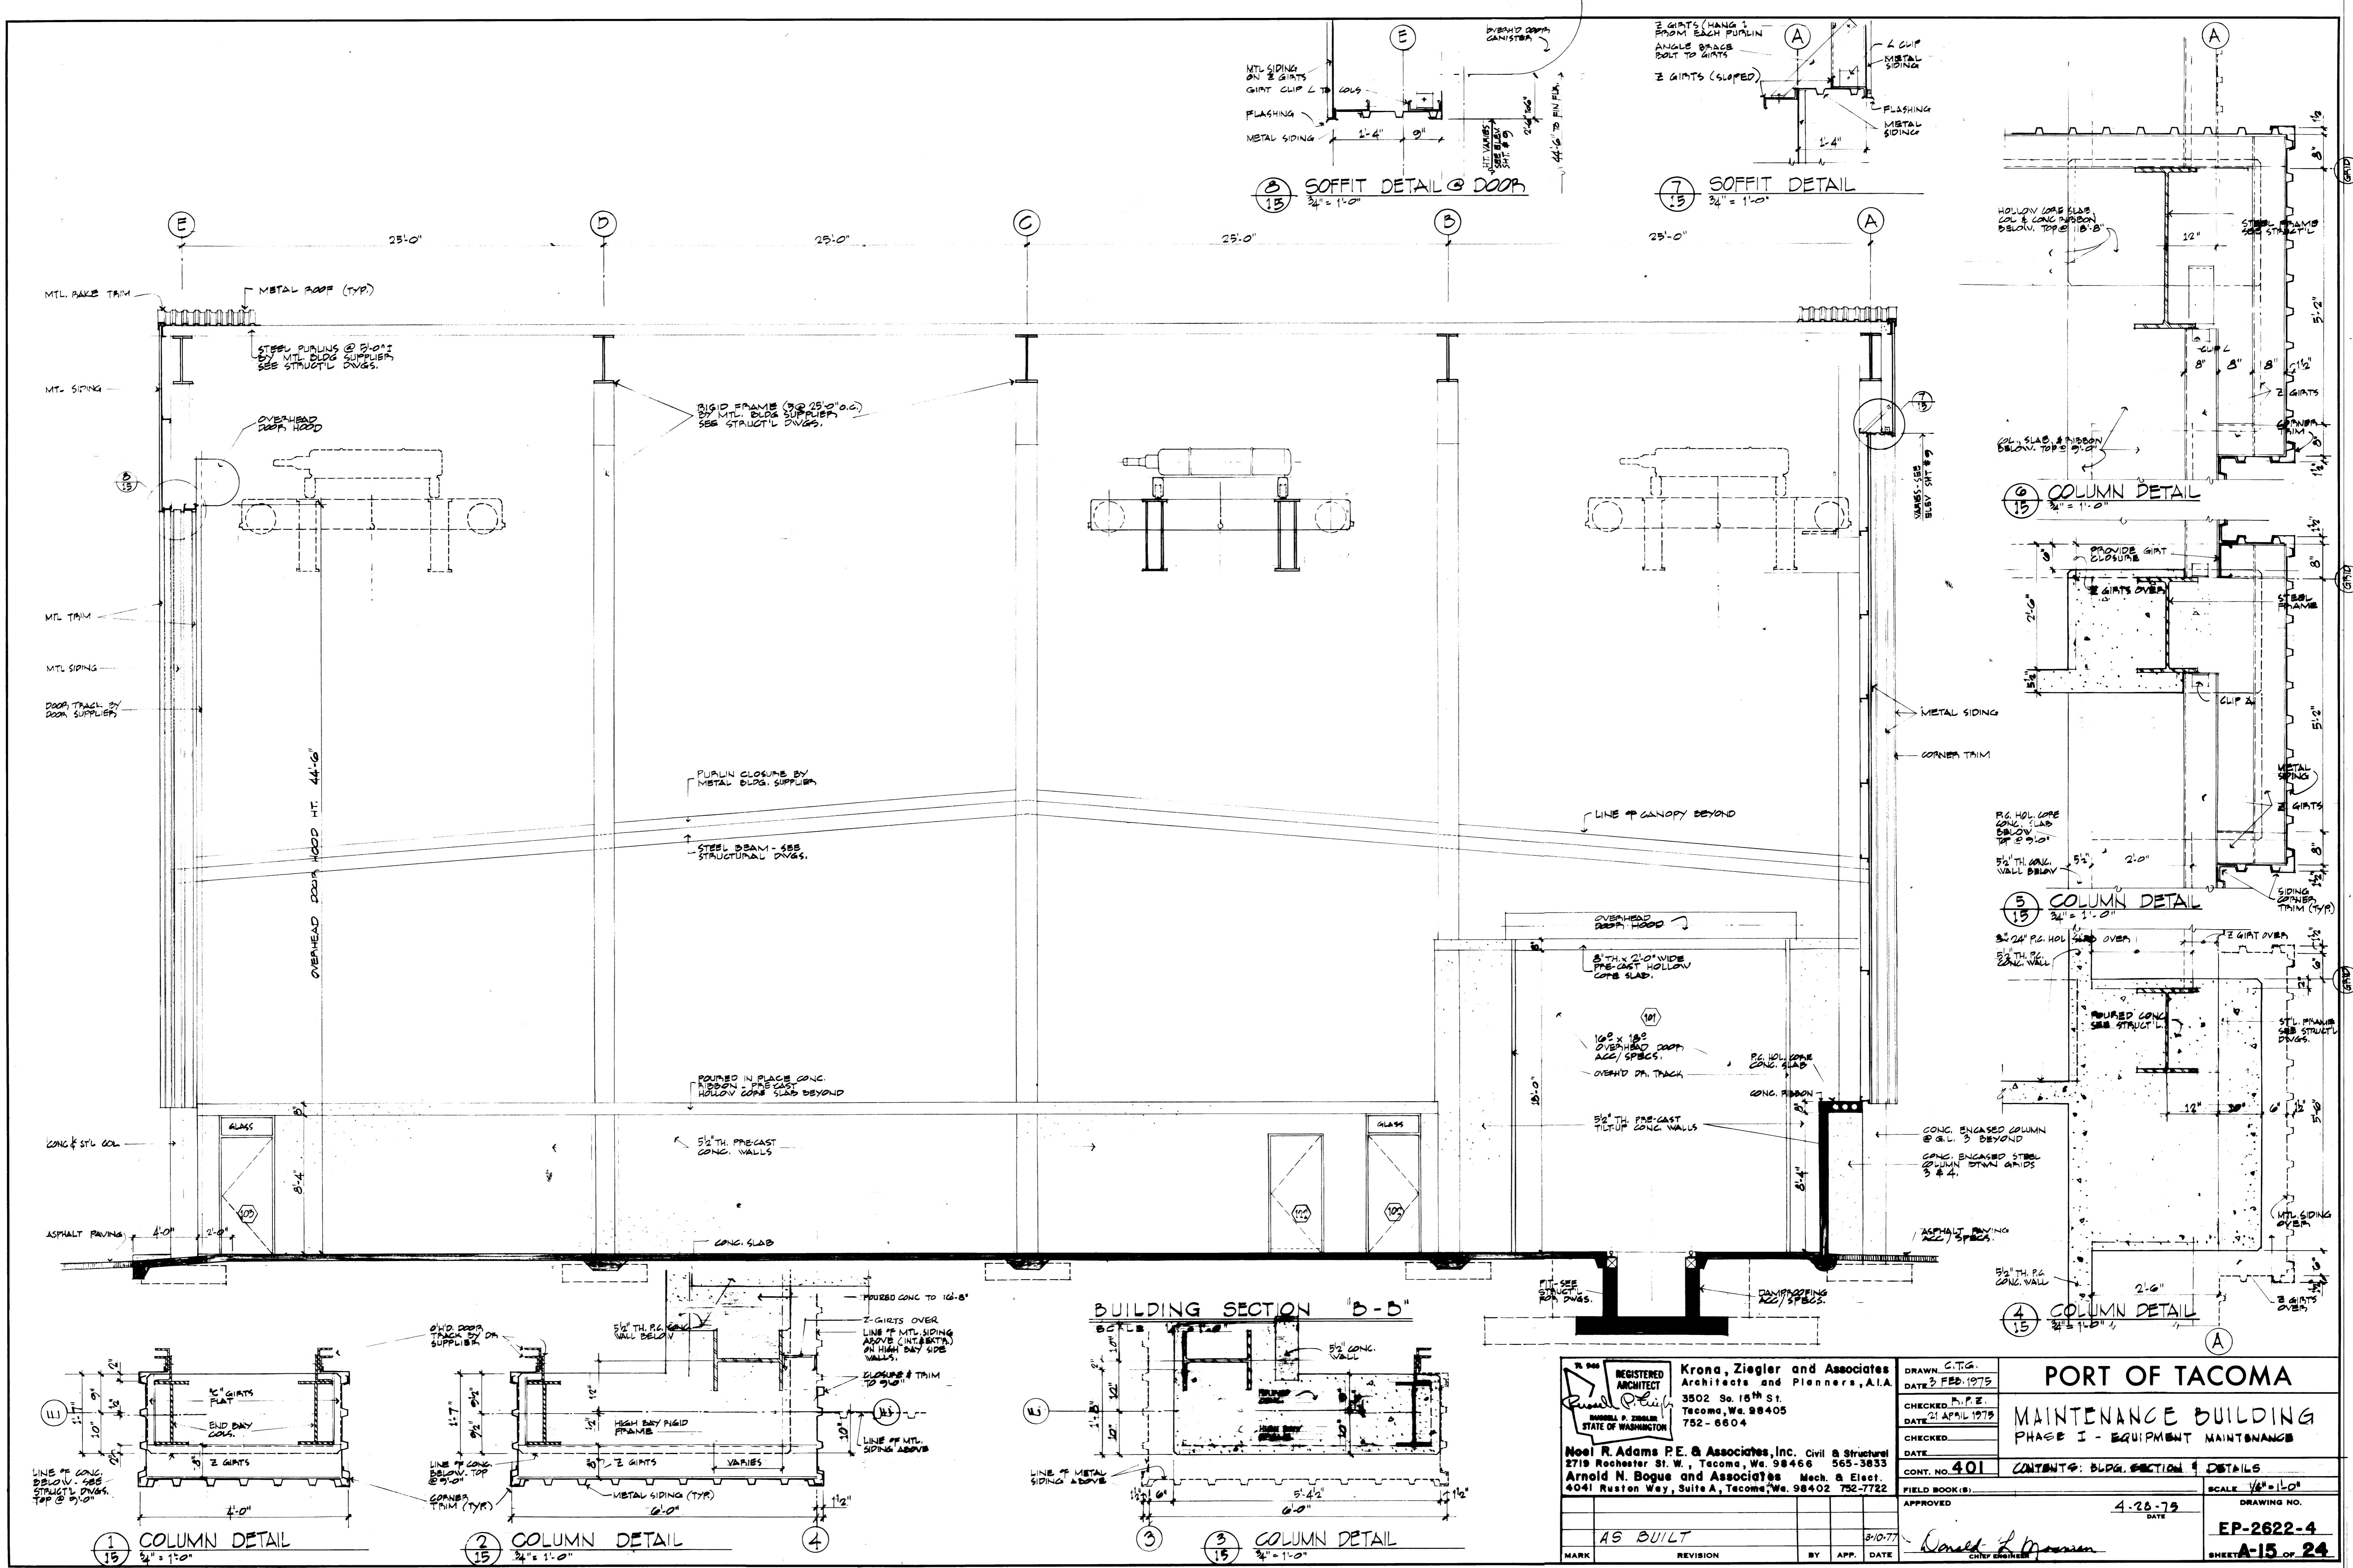


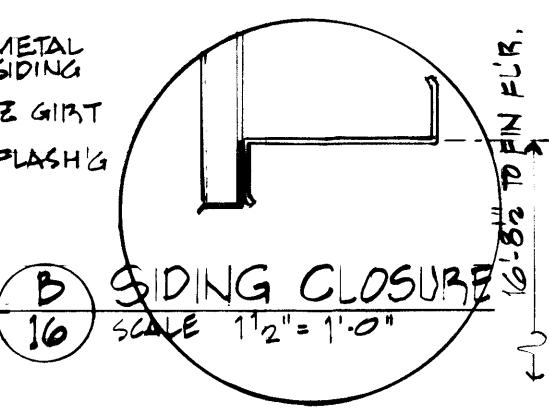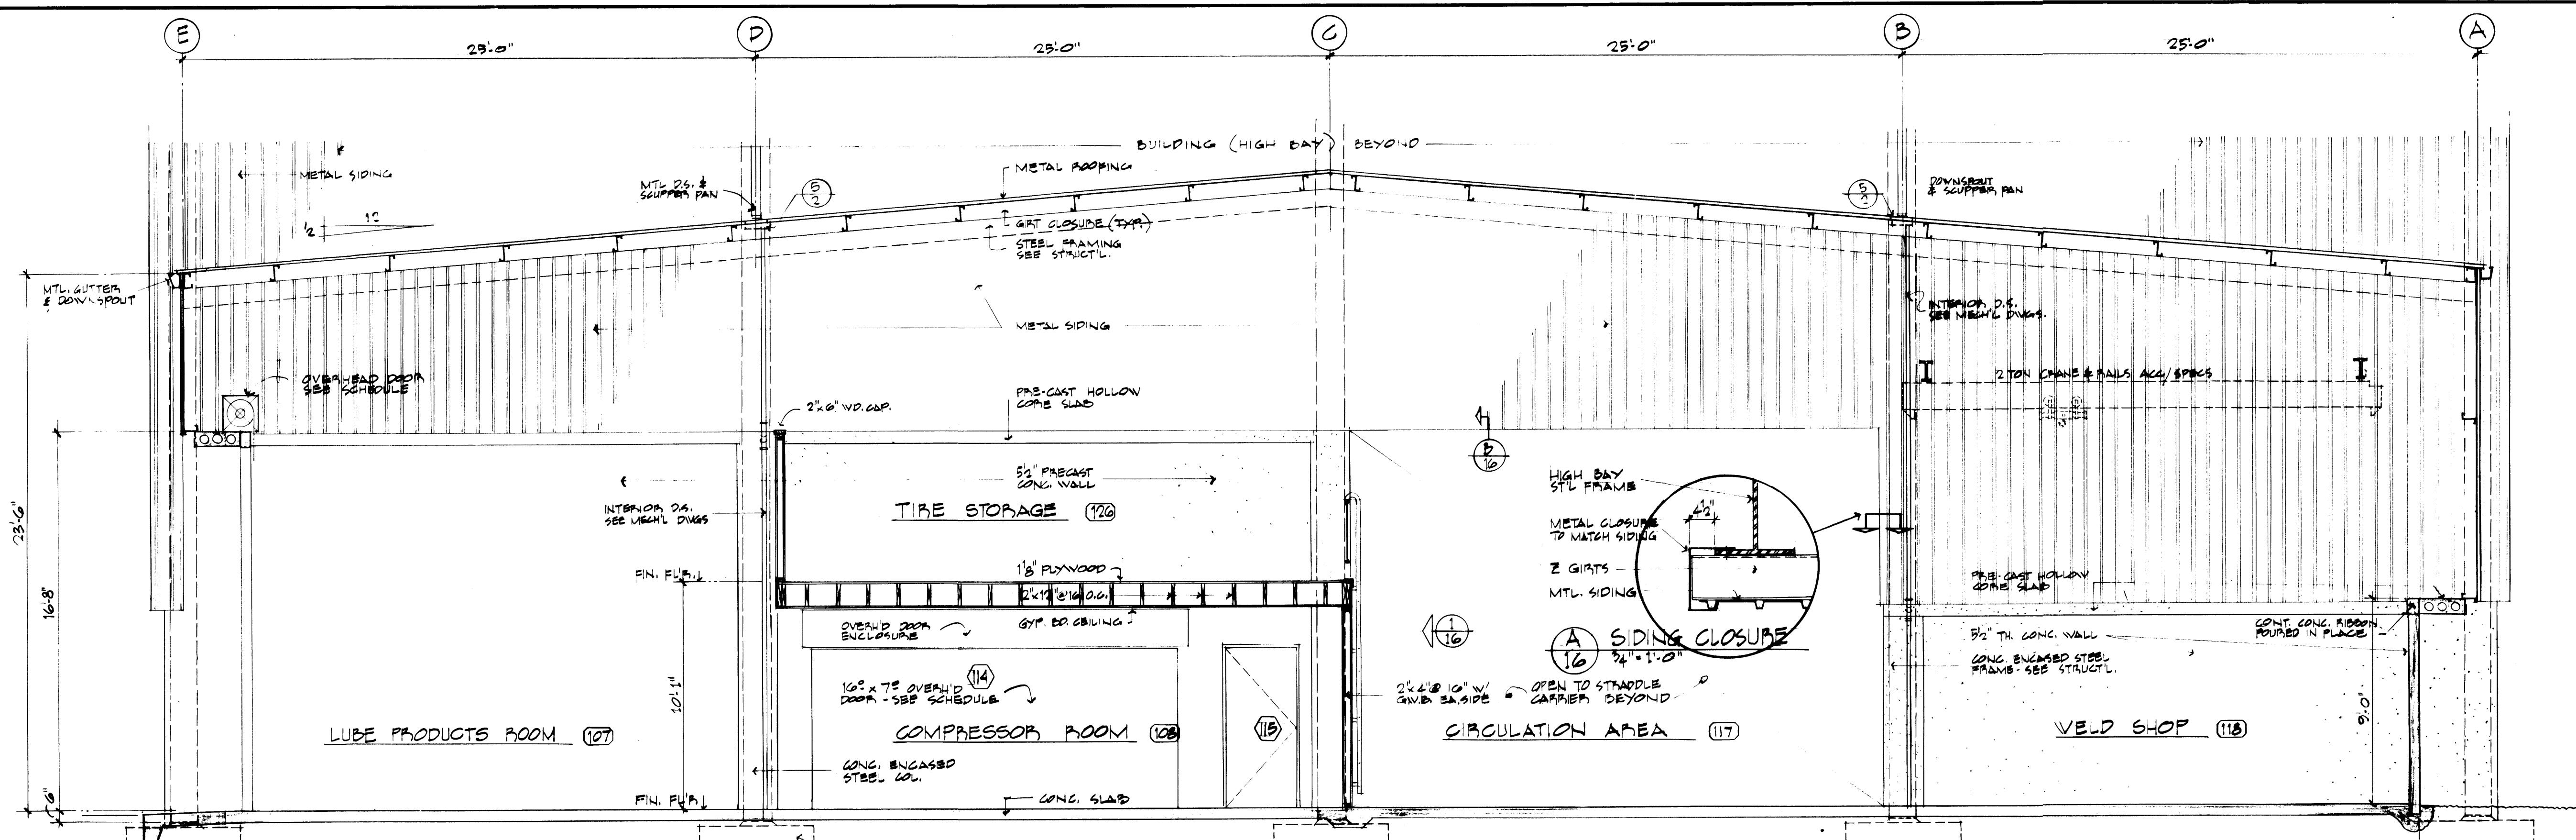


BUILDING SECTION "C-C" SCALE 1"=1'-0"

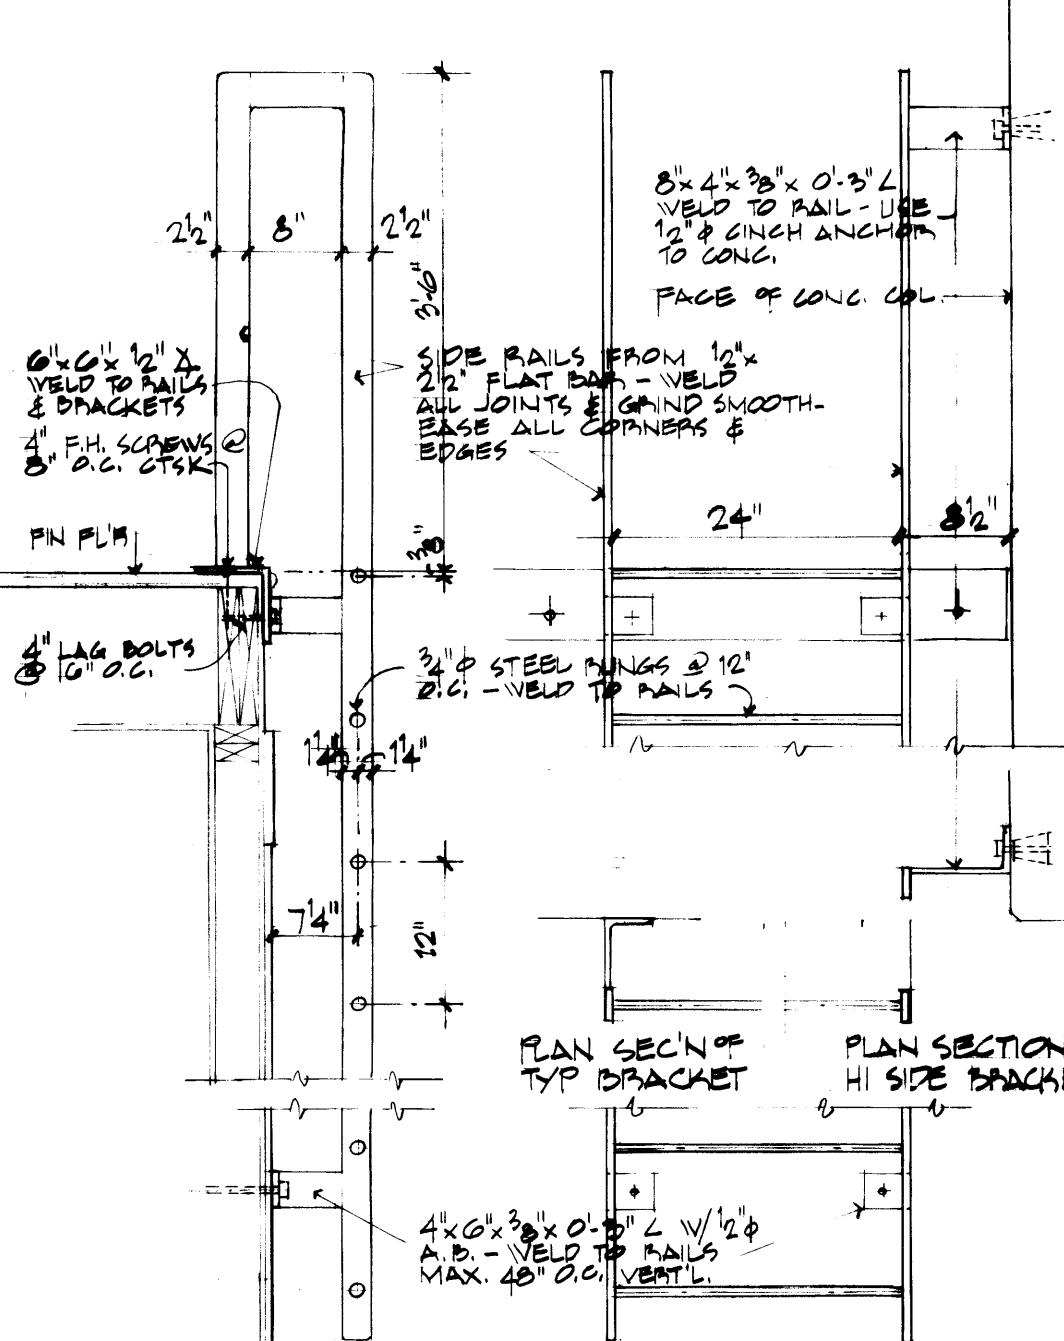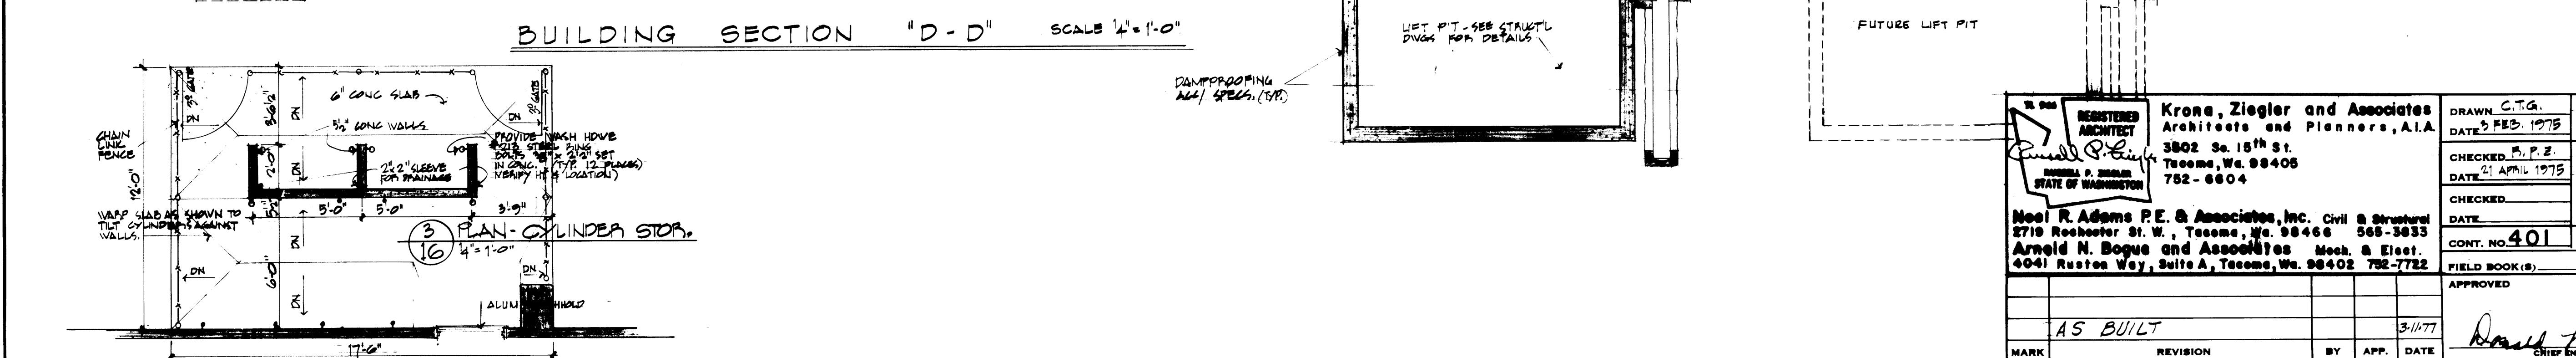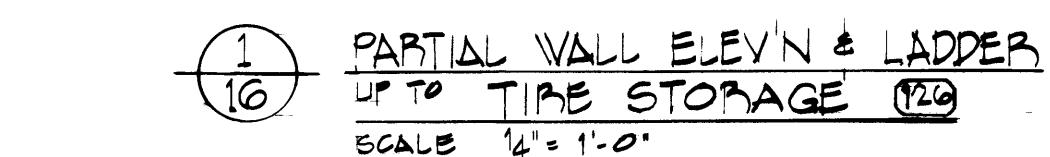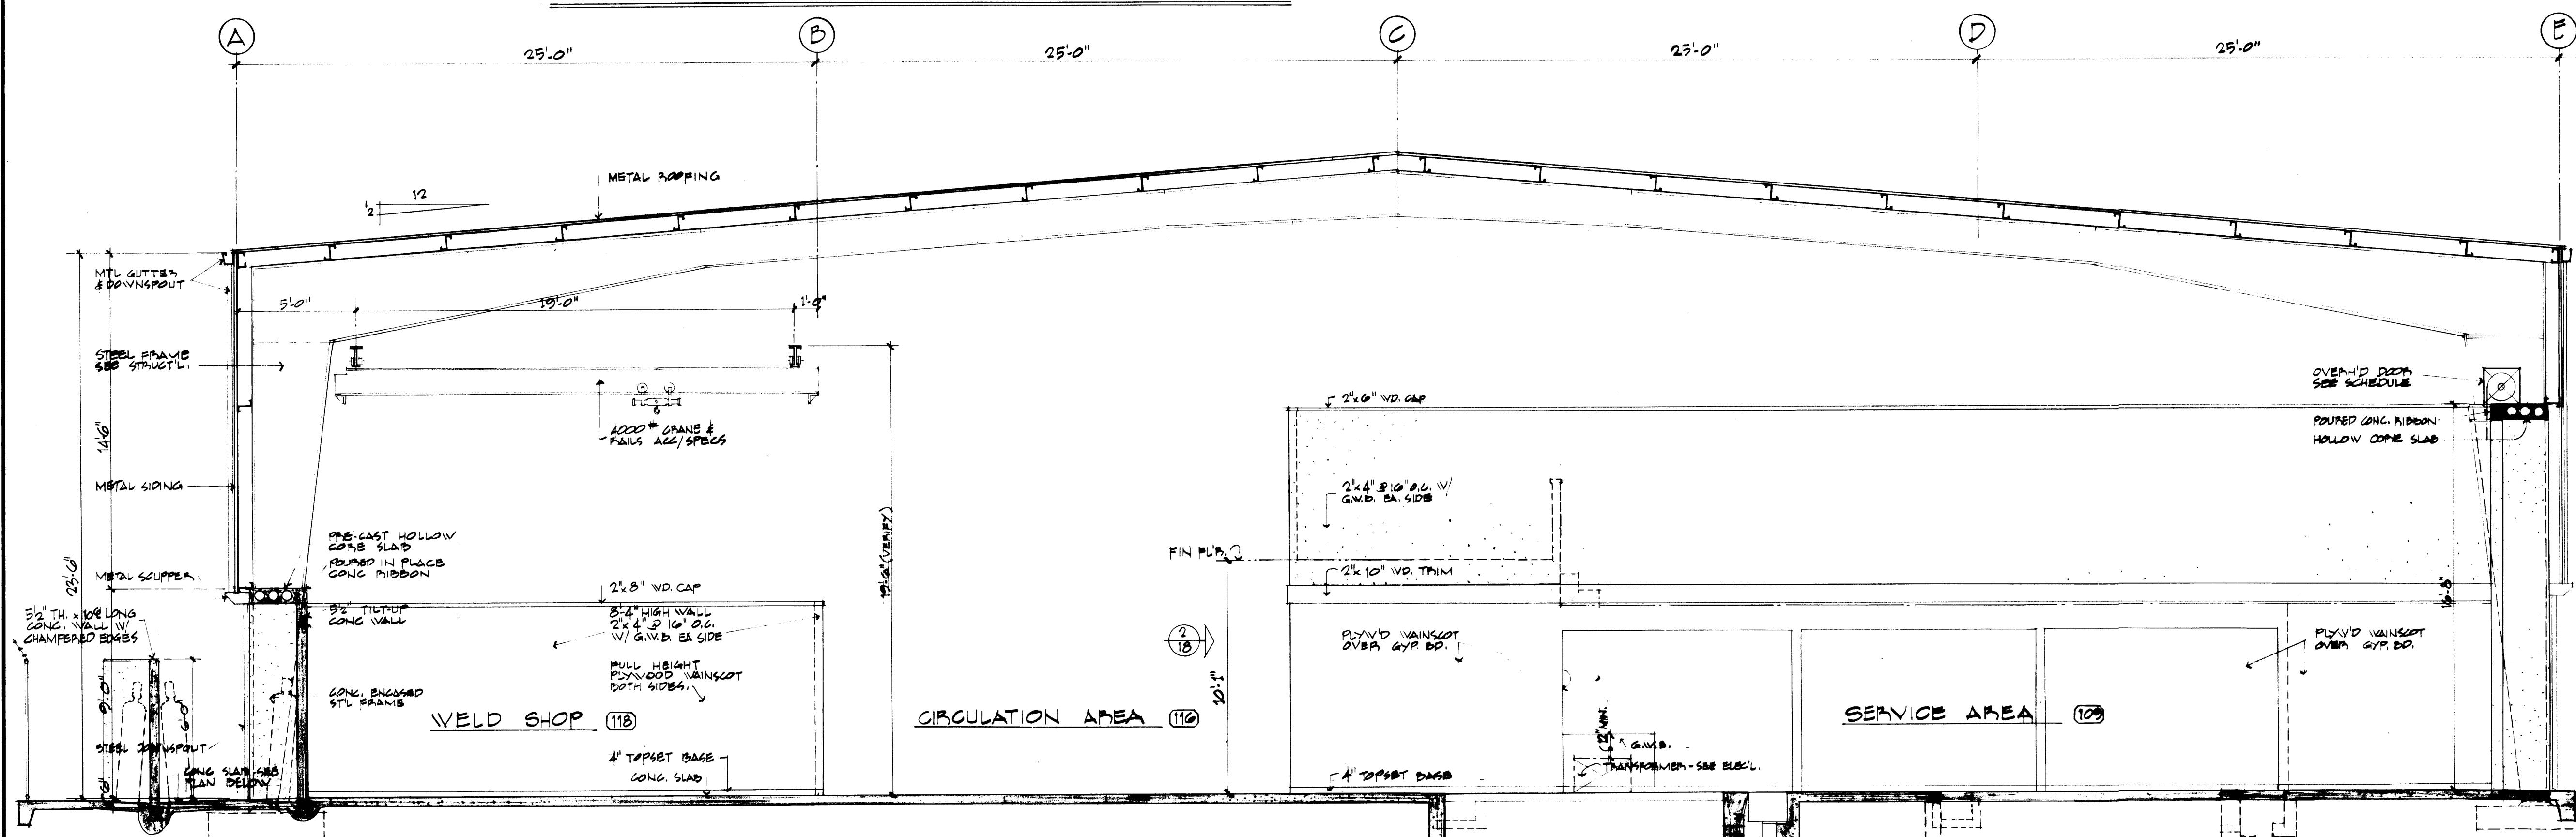

LADDER DETAILS

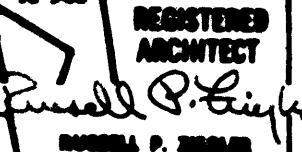12 905	REGISTERED ARCHITECT	Krone, Ziegler and Associates Architects and Planners, A.I.A. 3802 So. 15th St. Tacoma, Wa. 98406 752-6604	DR DA CH DA CH DA CO FIE APP	
 RUSSELL P. ZIEGLER STATE OF WASHINGTON				
Noel R. Adams P.E. & Associates, Inc. Civil & Structural 2719 Rochester St. W., Tacoma, Wa. 98466 565-3833 Arnold N. Bogue and Associates Mech. & Elect. 4041 Ruston Way, Suite A, Tacoma, Wa. 98402 752-7722				
<i>AS BUILT</i>		3-11-77		
MARK	REVISION	BY	APP.	DATE

PORT OF TACOMA
MAINTENANCE BUILDING
PHASE I - EQUIPMENT MAINTENANCE
CONTENTS: BUILDING SECTIONS, LIPPER DET.

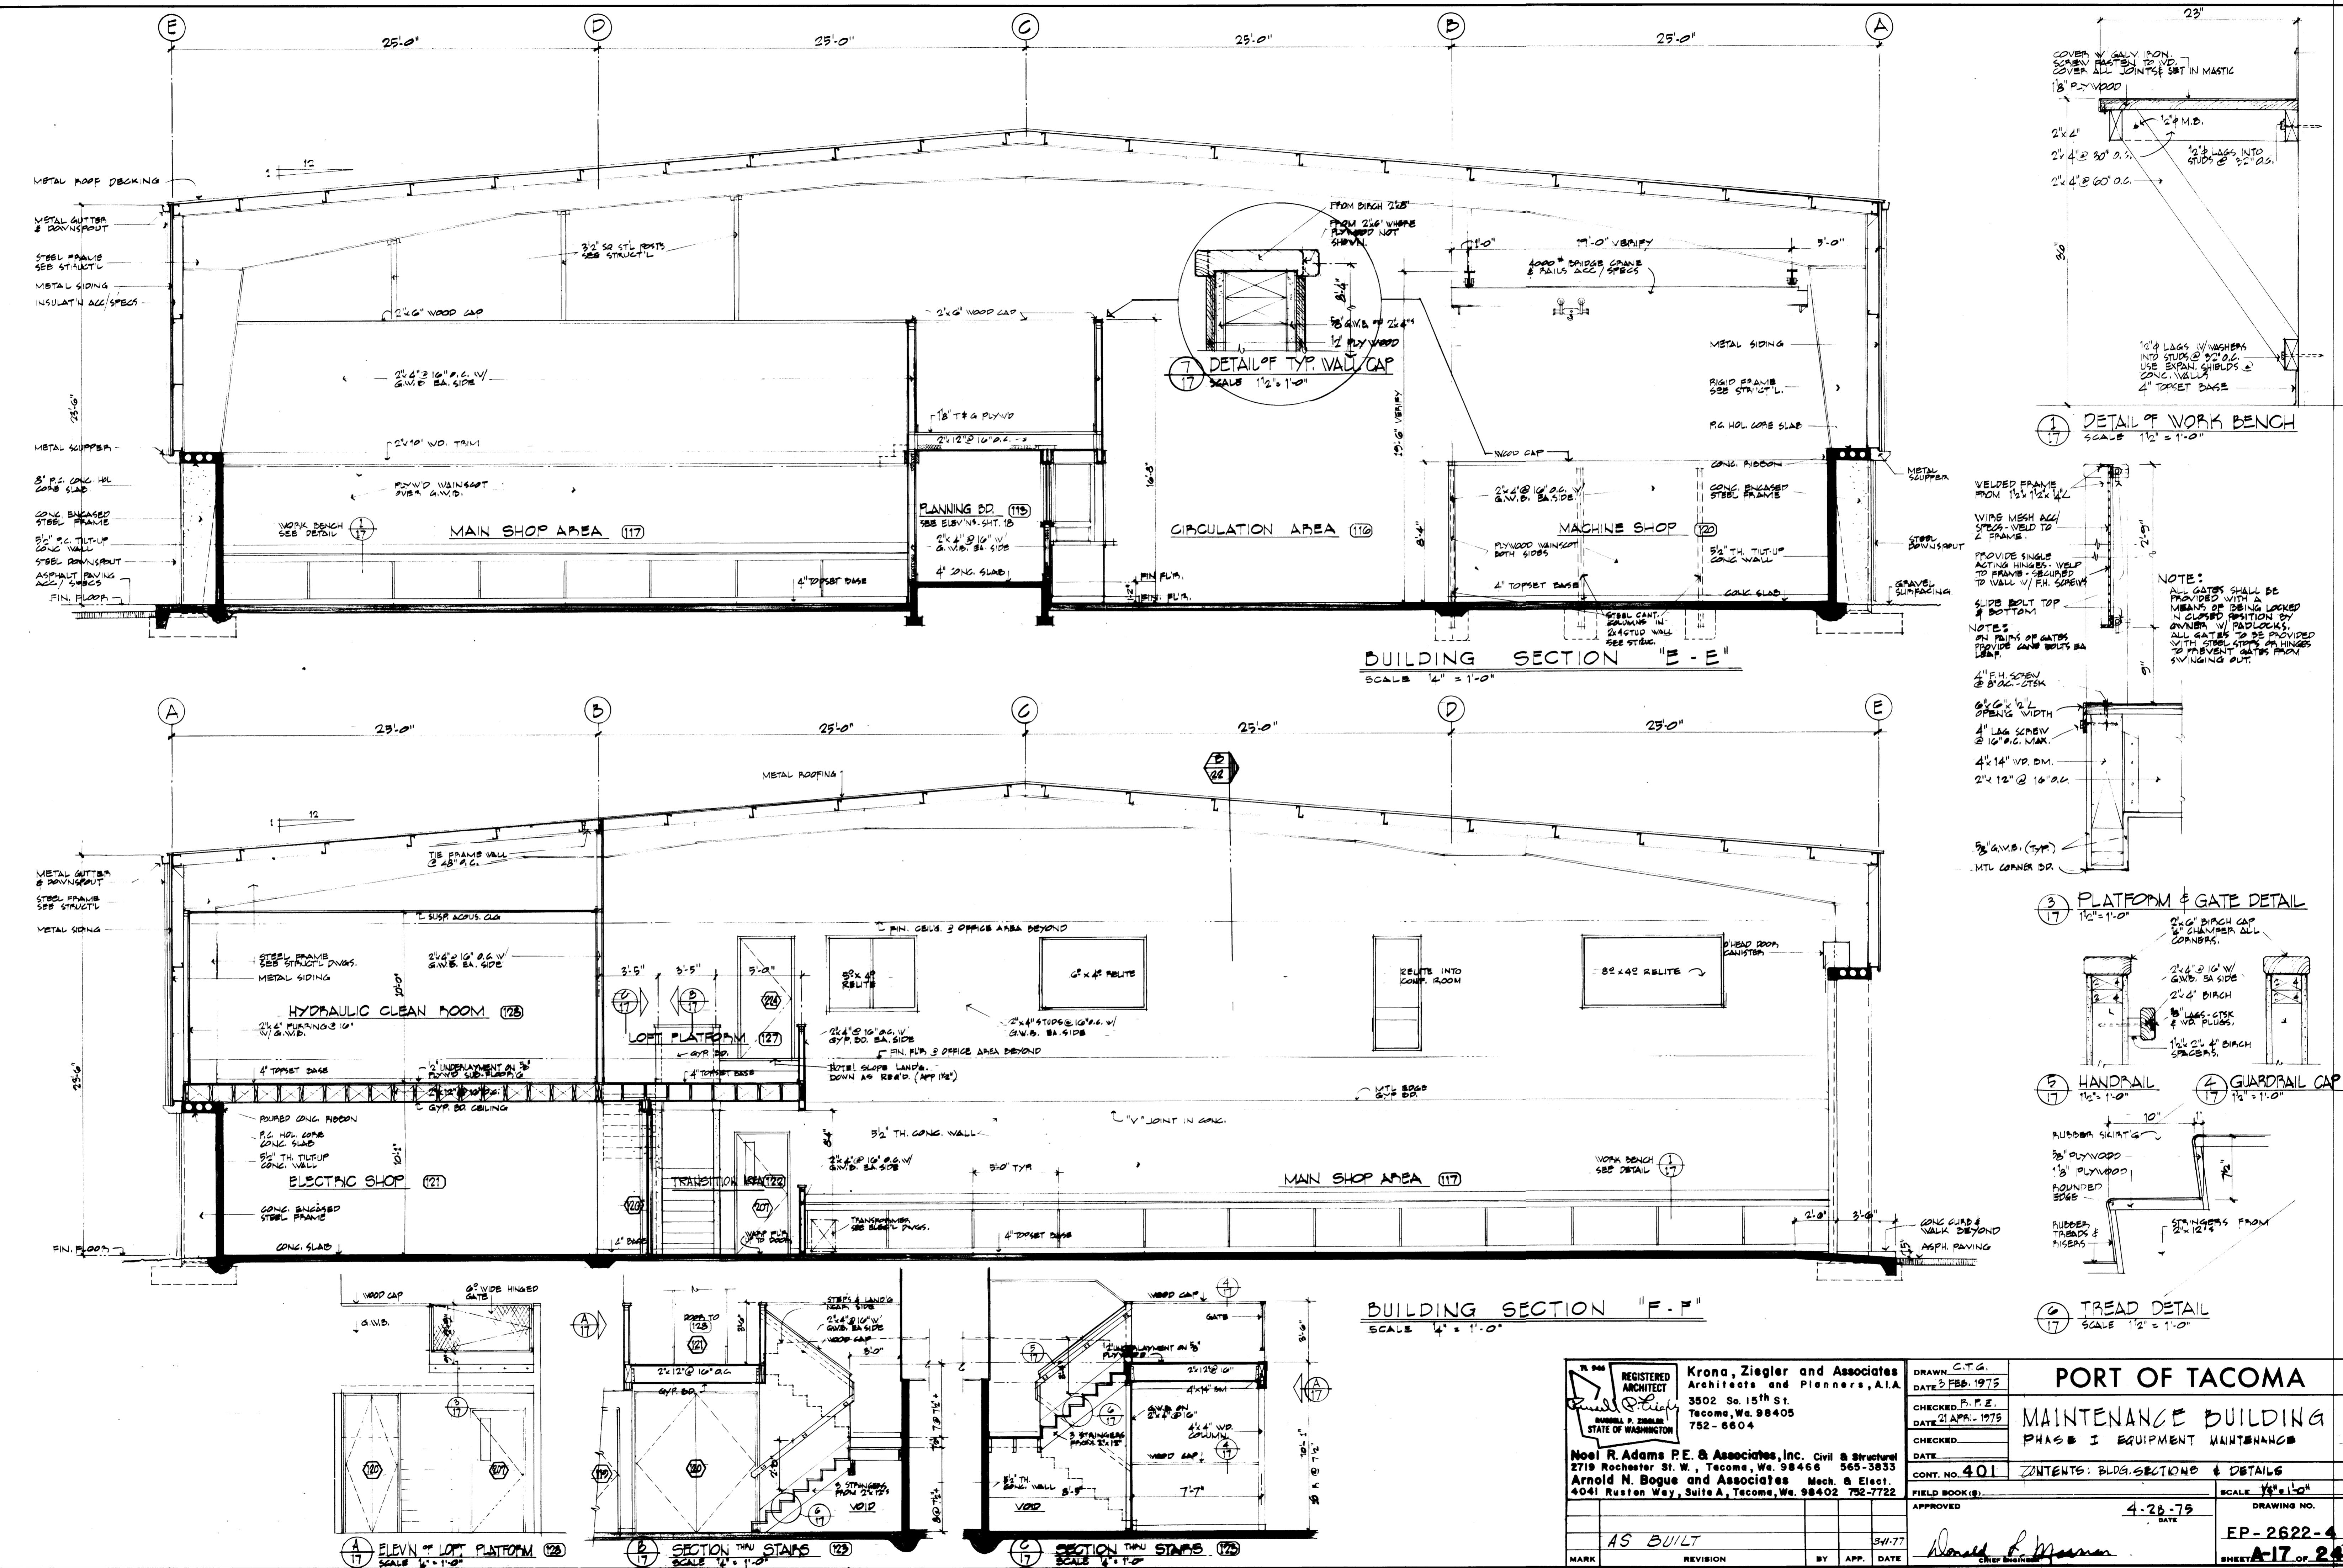

PORT OF TACOMA

MAINTENANCE BUILDING

HAS ■ I EQUIPMENT MAINTENANCE ■

71-946

REGISTERED
ARCHITECT

Russell P. Ziegler

RUSSELL P. ZIEGLER
STATE OF WASHINGTON

Krona, Ziegler and Associates
Architects and Planners, A.I.A.
3502 So. 15th St.
Tacoma, Wa. 98405
752-6604

DRAWN
DATE 3


CHECKED
DATE 21



CHECKED

**Noel R. Adams P.E. & Associates, Inc. Civil & Structural
2719 Rochester St. W., Tacoma, Wa. 98466 565-3833**
**Arnold N. Bogue and Associates Mech. & Elect.
4041 Ruston Way, Suite A, Tacoma, Wa. 98402 752-7722**

					APPROV
	AS BUILT			3-11-77	
MARK	REVISION	BY	APP.	DATE	


<u>4-28-75</u> DATE	DRAWING NO. <u>EP-2622-4</u>
SHEET <u>A-17</u> OF <u>24</u>	

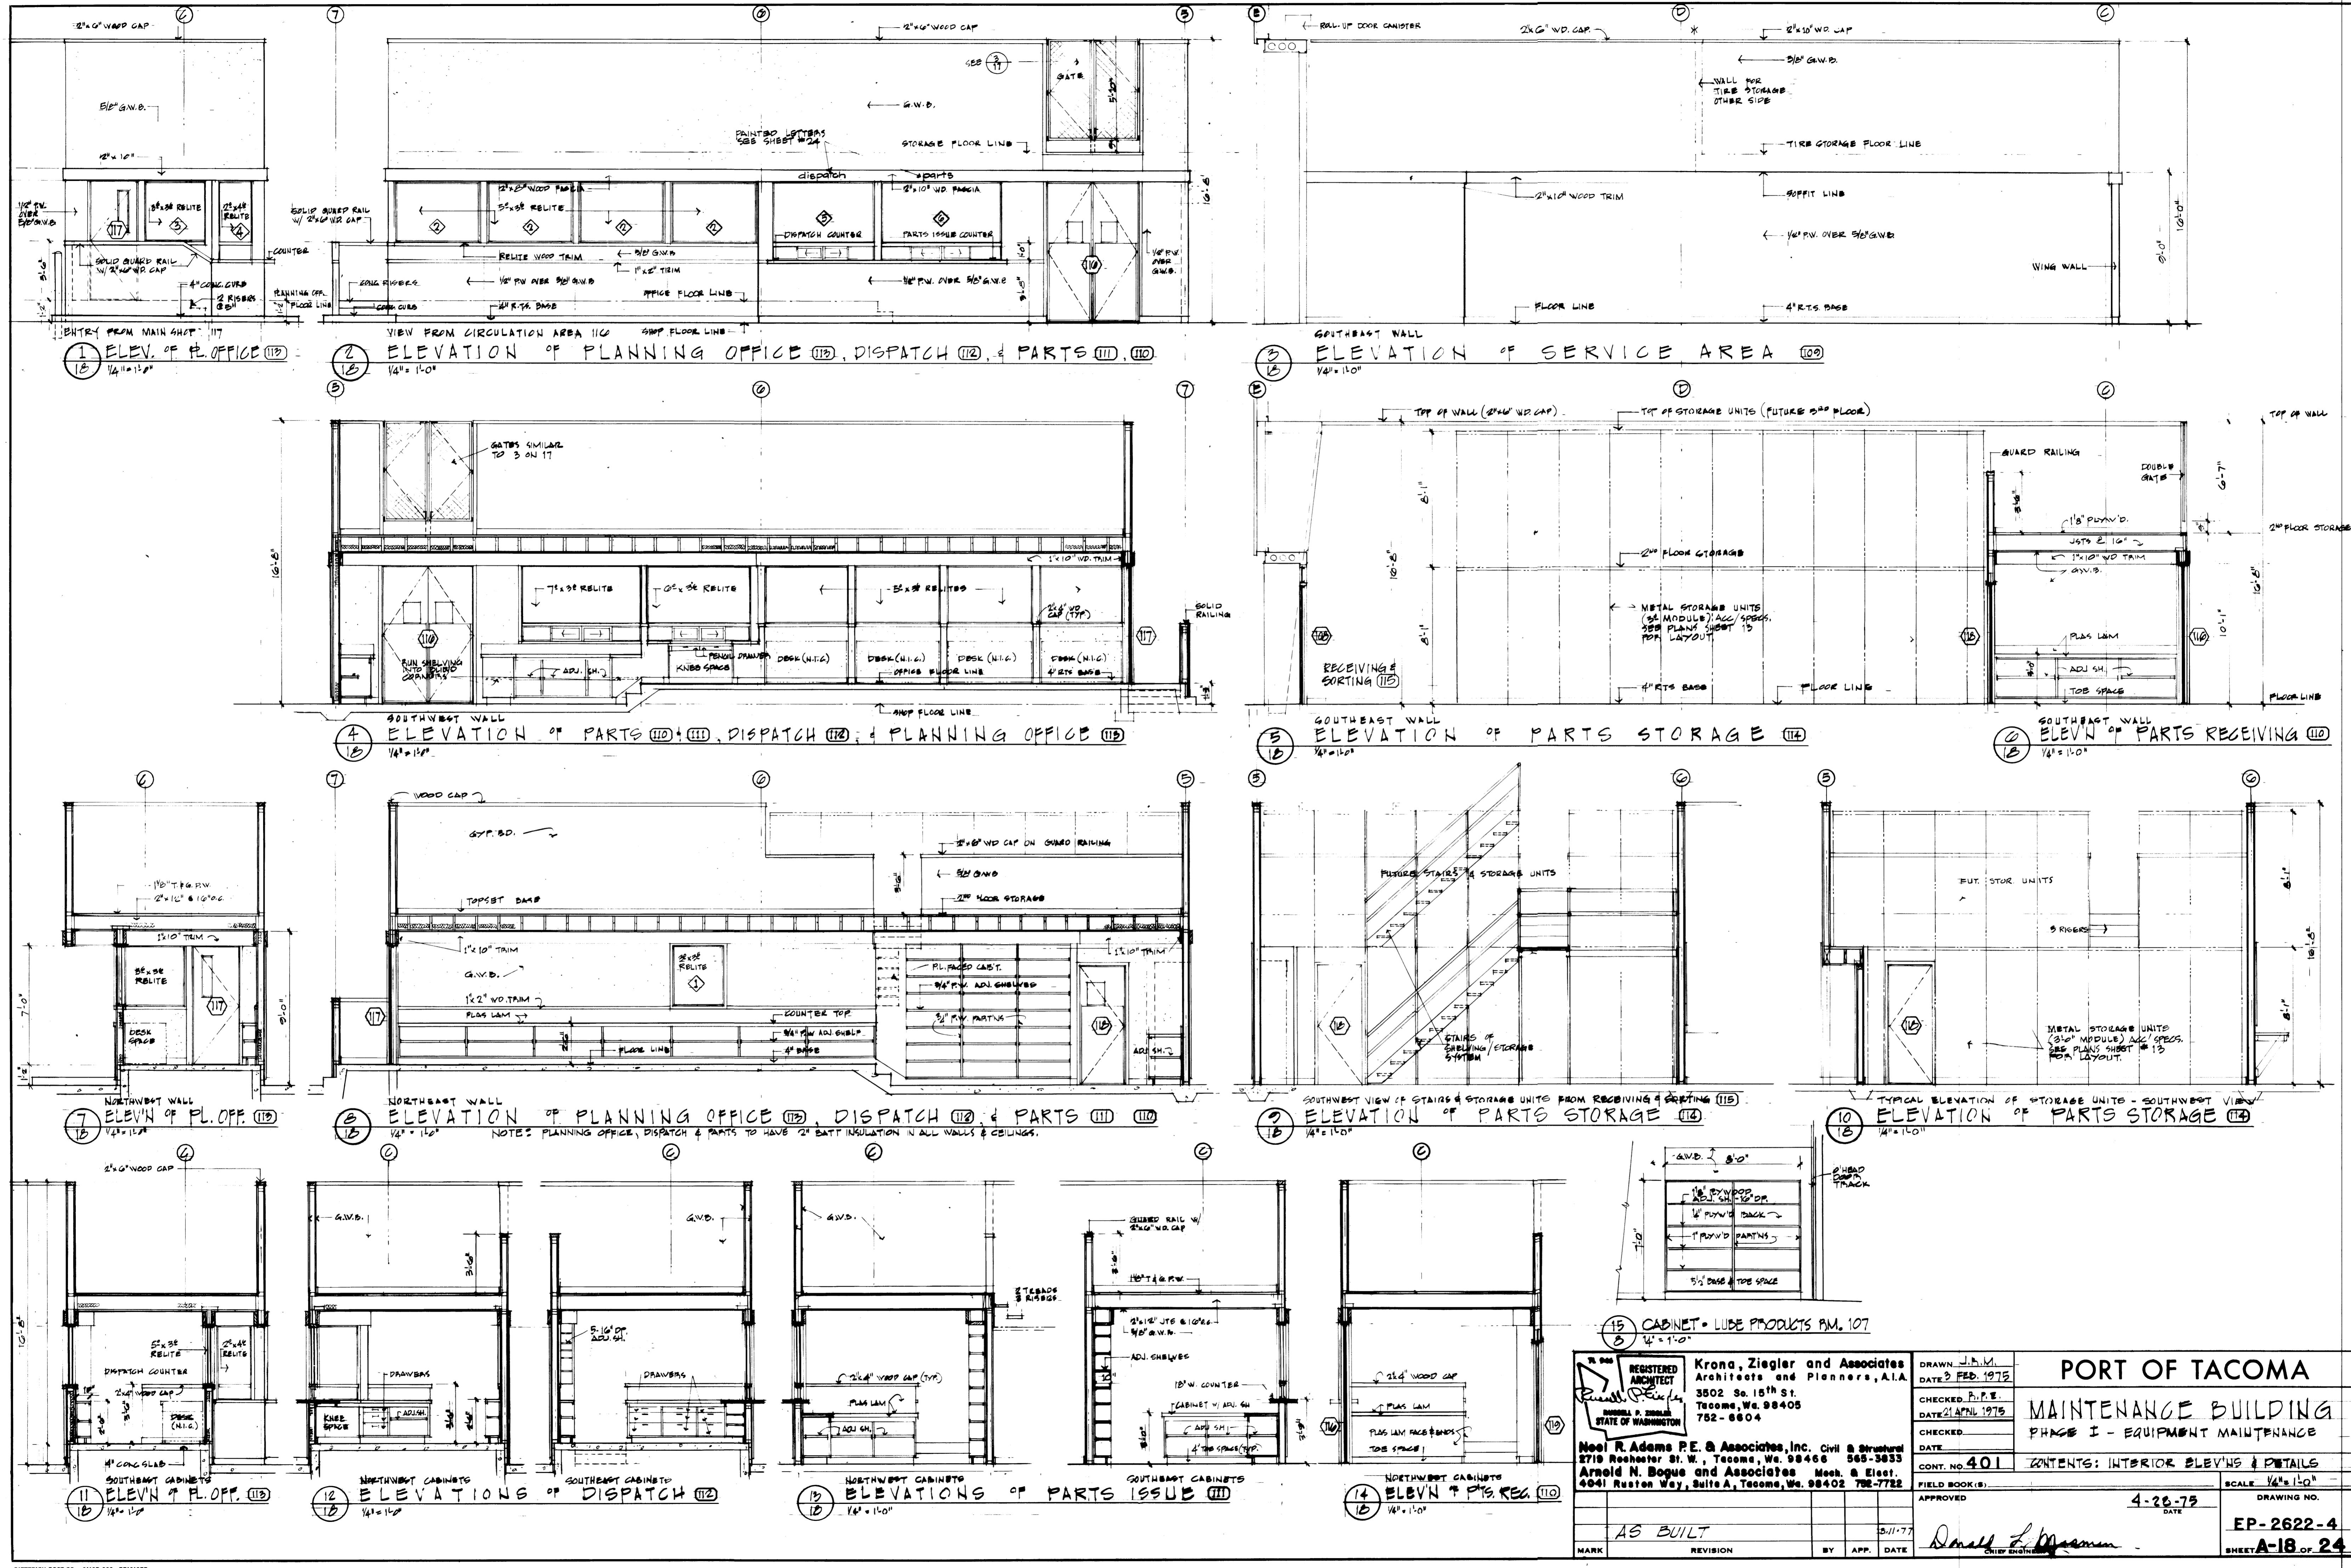

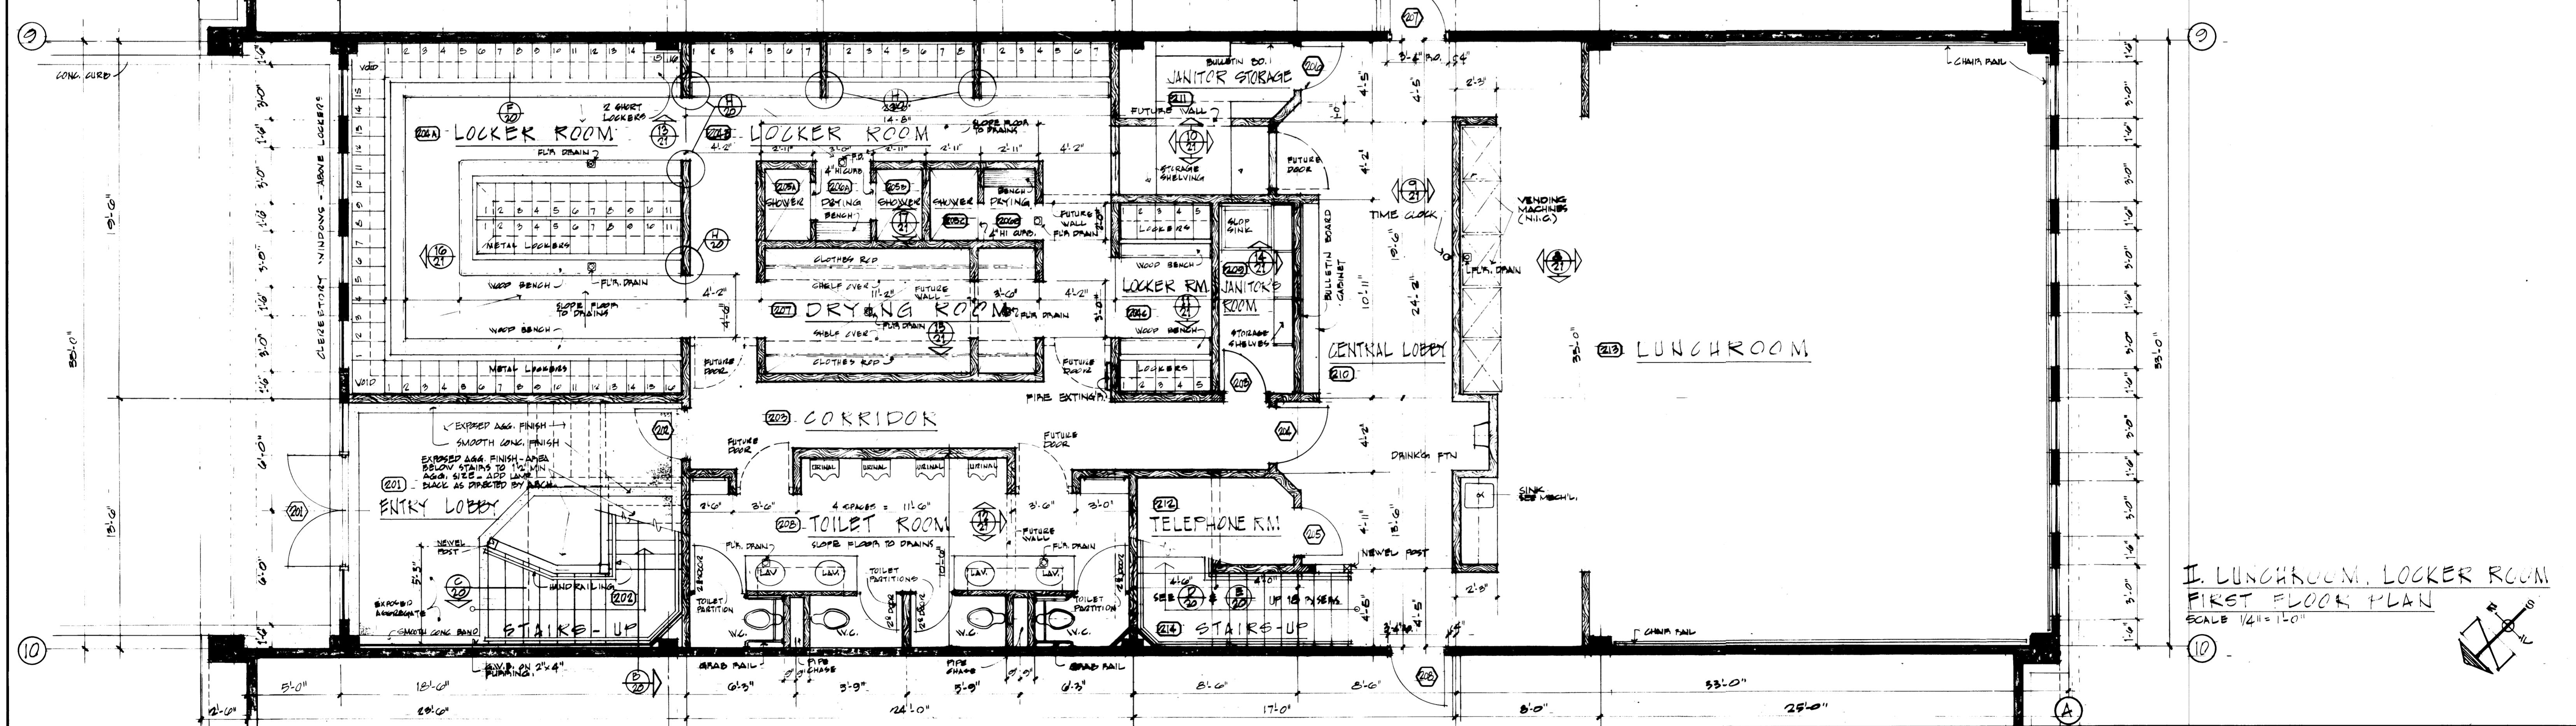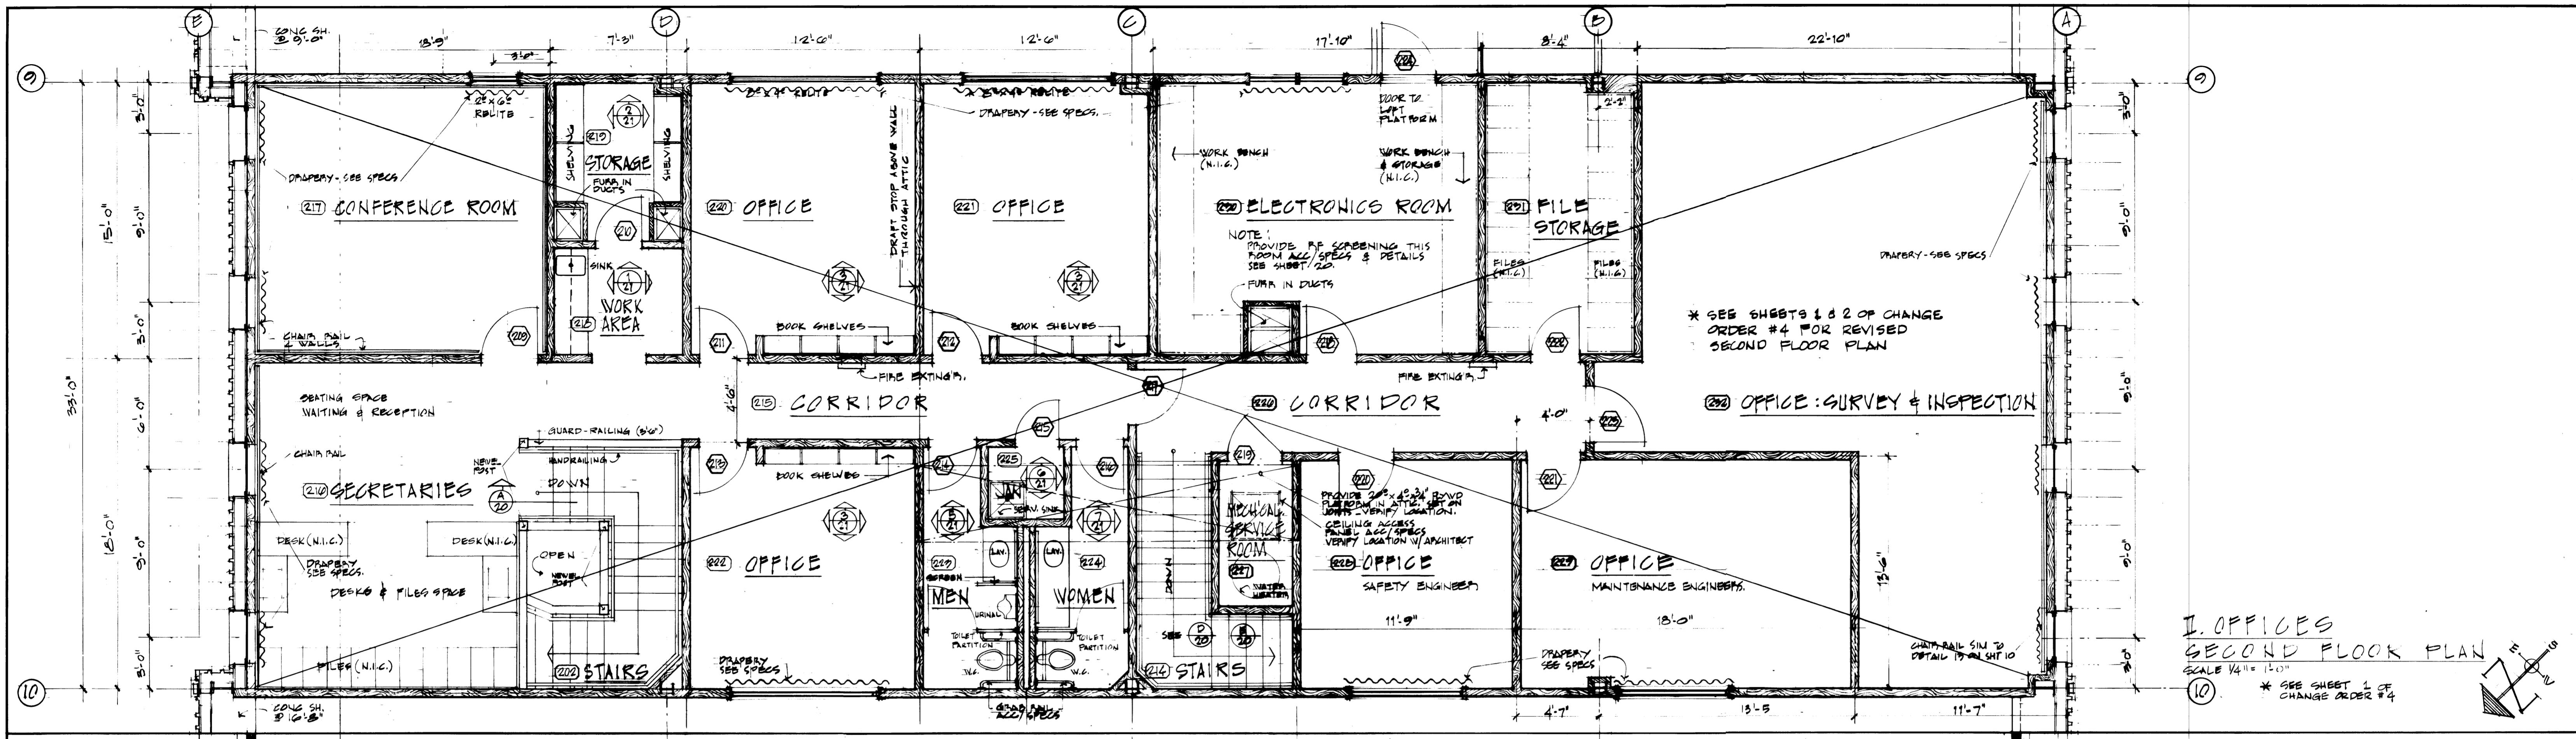


 <p>71 946</p> <p>REGISTERED ARCHITECT</p> <p><i>Russell P. Ziegler</i></p> <p>RUSSELL P. ZIEGLER STATE OF WASHINGTON</p>	<p>Krona, Ziegler and Associates Architects and Planners, A.I.A.</p> <p>3502 So. 15th St. Tacoma, Wa. 98405 752-6604</p>			
<p>Noel R. Adams P.E. & Associates, Inc. Civil & Structural 2719 Rochester St. W., Tacoma, Wa. 98466 565-3833</p> <p>Arnold N. Bogue and Associates Mech. & Elect. 4041 Ruston Way, Suite A, Tacoma, Wa. 98402 752-7722</p>				
<p>AS BUILT</p>				
<p>MARK</p>	<p>REVISION</p>	<p>BY</p>	<p>APP.</p>	<p>DATE</p>
<p>3/11/77</p>				


J.P.M. FEB 1975	PORT OF TACOMA
ED. B.P.E. APRIL 1975	MAINTENANCE BUILDING PHASE II - OFFICES, LOCKER RM, LUNCH RM.
ED	
NO. 401	CONTENTS: FLOOR PLANS
BOOK(S)	SCALE 1/4" - 1'-0"
VED	4-28-75 DATE
DRAWING NO. EP-2622-4	
SHEET A-19 OF 24.	
John L. Morrison CHIEF ENGINEER	

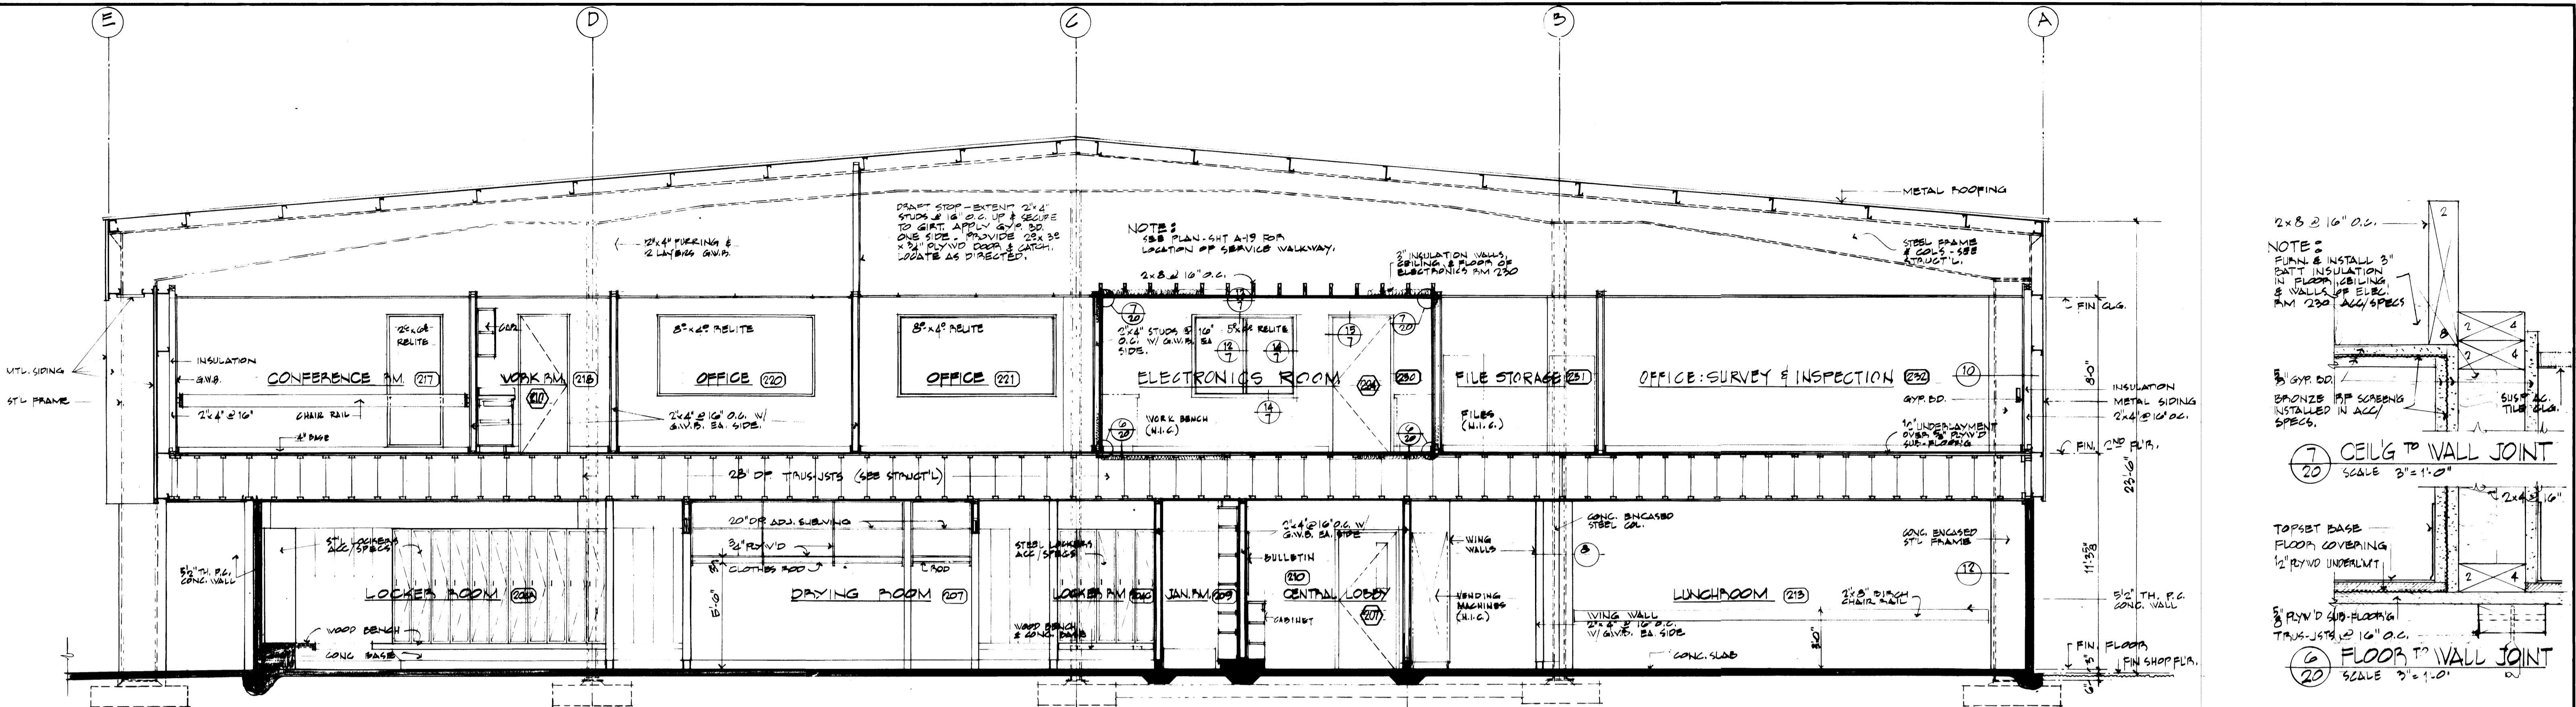

BUILDING SECTION "G-G"
SCALE 1/4" = 1'-0"

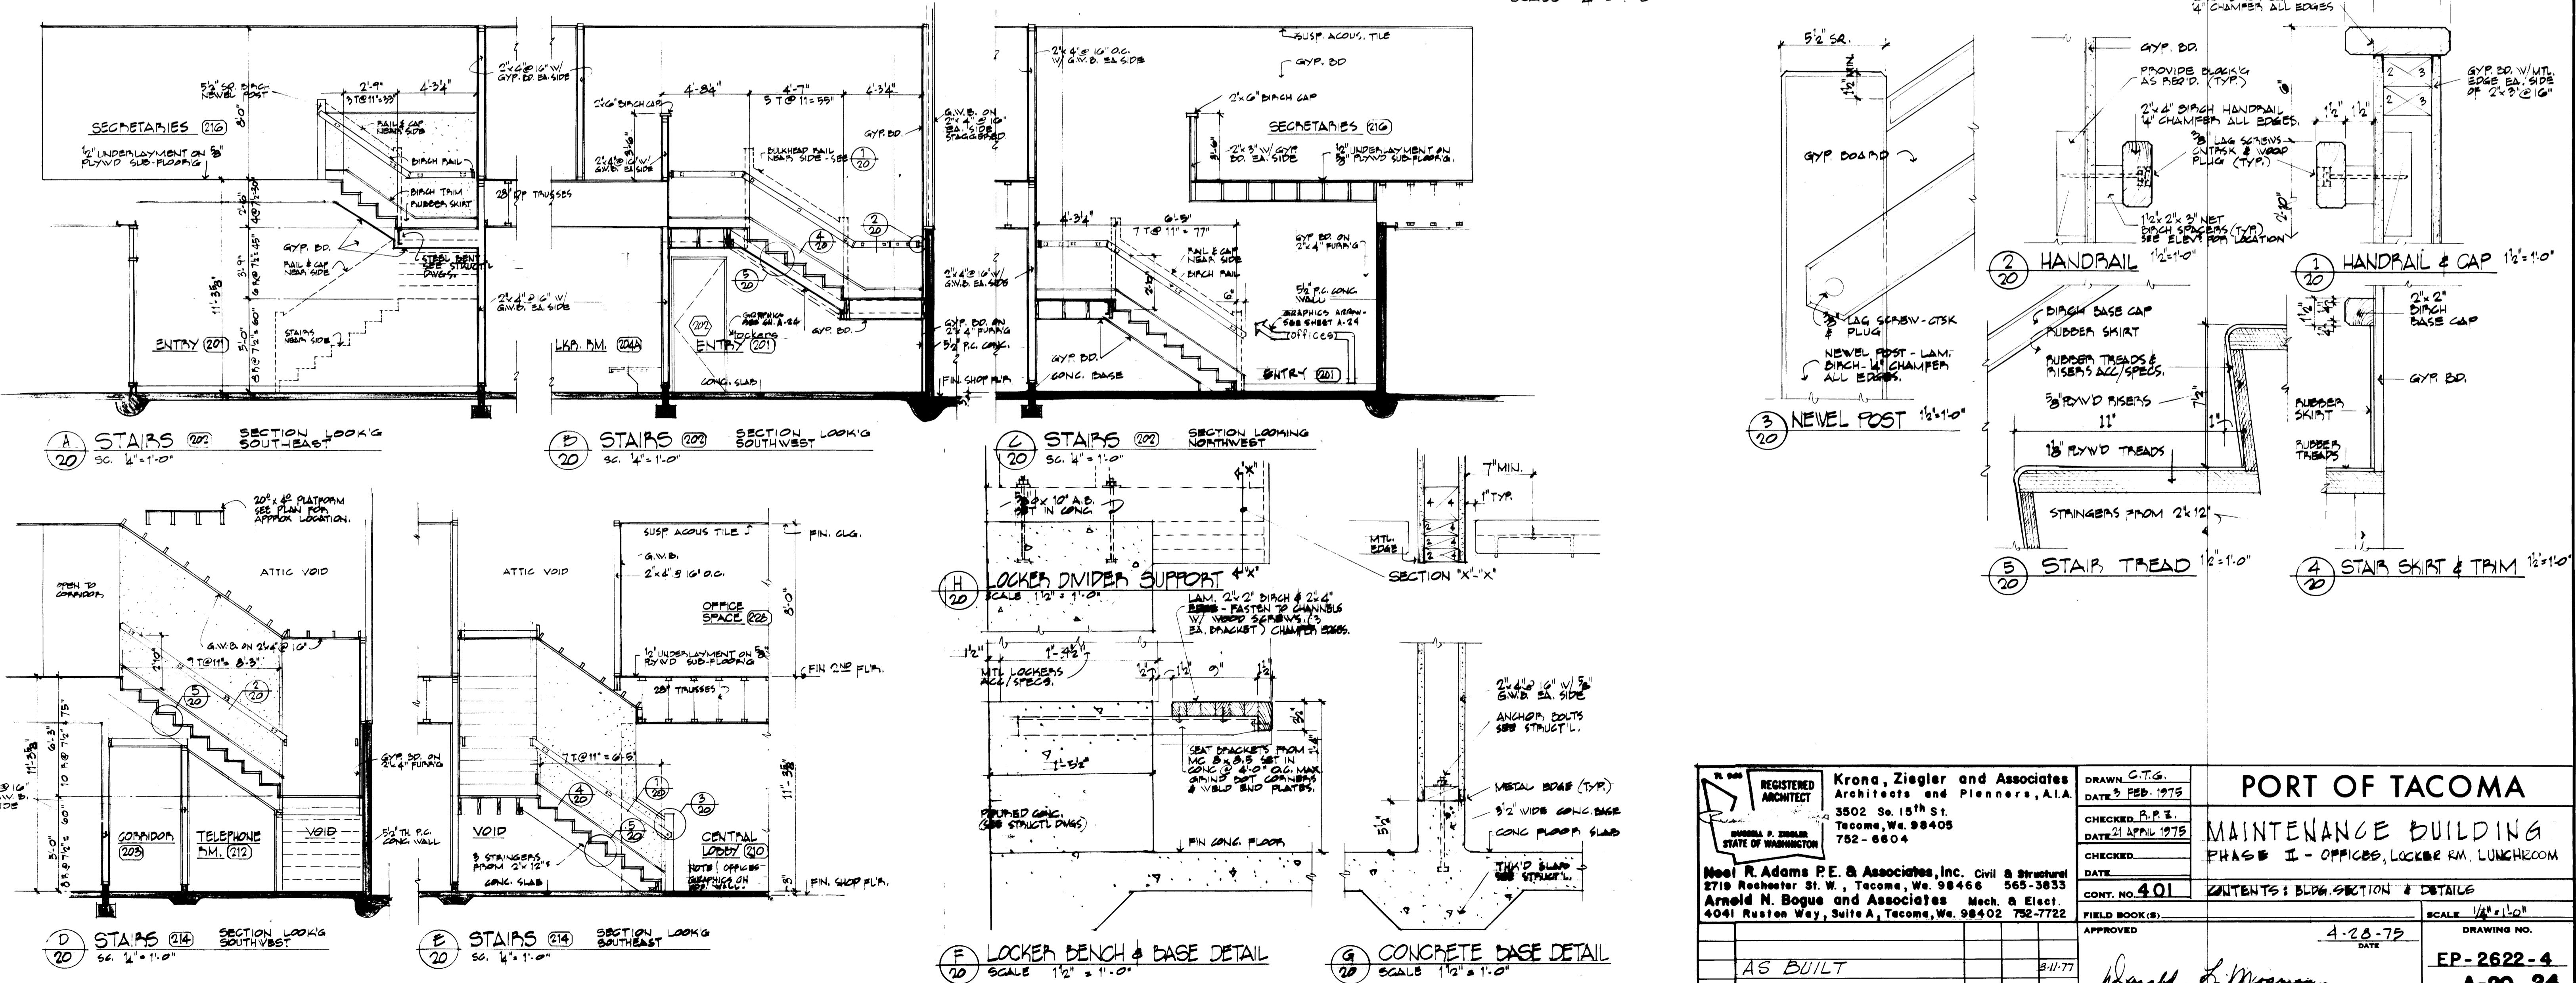


REGISTERED ARCHITECT	Krona, Ziegler and Associates Architects and Planners, A.I.A. 3502 So. 15th St. Tacoma, Wa. 98405 752-6604	DRAWN G.T.G. DATE 3 FEB. 1975
ARMAND P. ZIEGLER STATE OF WASHINGTON	checked P.P.I. DATE 21 APRIL 1975	checked
Neal R. Adams P.E. & Associates, Inc. Civil & Structural 2719 Rochester St. W., Tacoma, Wa. 98466 565-3833	checked	checked
Arnold N. Bogue and Associates Inc. Mech. & Elect. 4041 Ruston Way, Suite A, Tacoma, Wa. 98402 752-7222	CONT. NO. 401	CONT. NO. 401
PORT OF TACOMA MAINTENANCE BUILDING PHASE II - OFFICES, LOCKER RM. LUNCHROOM		
CONTENTS: BLDG. SECTION & DETAILS		
APPROVED 4-28-75 DATE DRAWING NO. EP-2622-4 SHEET A-20 OF 24		

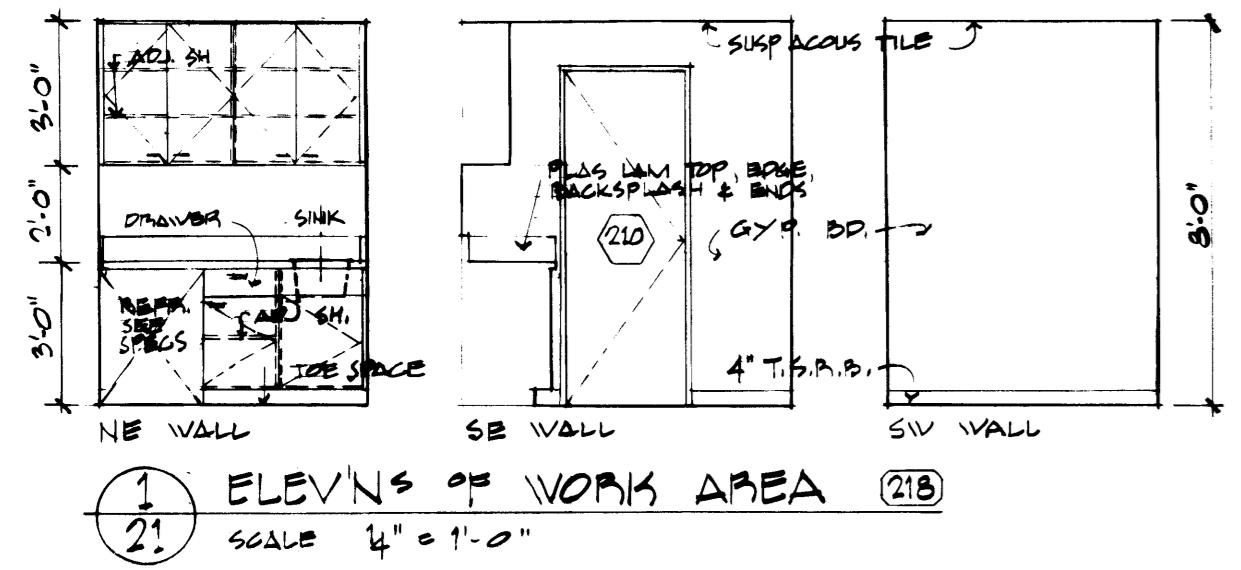


1 ELEVNS OF WORK AREA (218)

21 SCALE 1/4" = 1'-0"

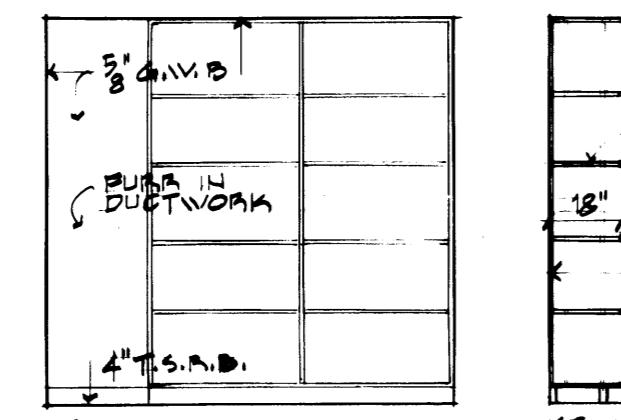


2 ELEVNS OF STORAGE (219)

21 SCALE 1/4" = 1'-0"

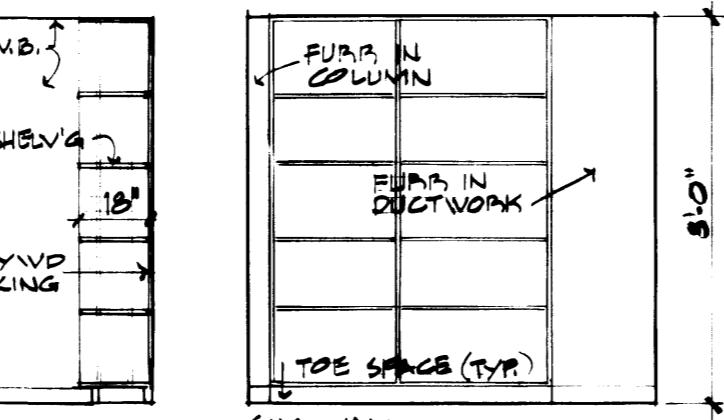


3 ELEVNS OF OFFICE (220) (OFFICE (221) IDENTICAL & OFFICE (223) SIMILAR BUT OPPOSITE HAND)

21 SCALE 1/4" = 1'-0"

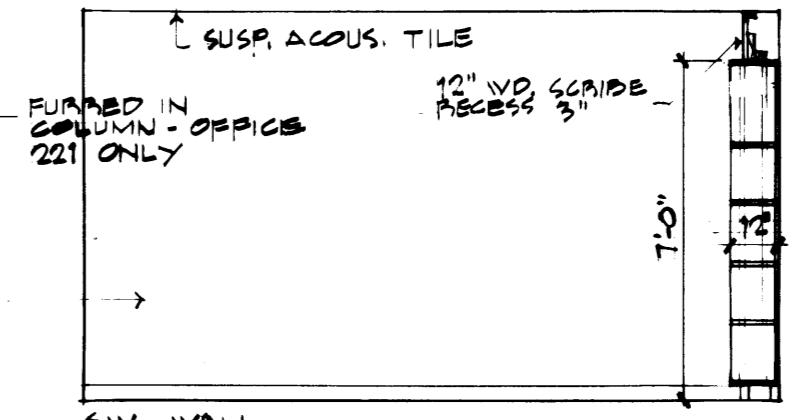


4 ELEVNS OF OFFICE (221)

21 SCALE 1/4" = 1'-0"

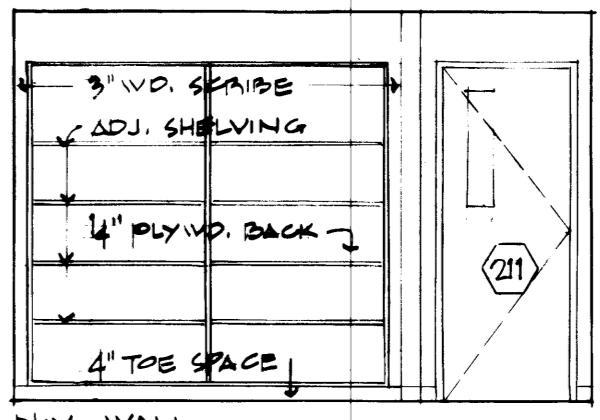


5 ELEVNS OF OFFICE (223)

21 SCALE 1/4" = 1'-0"

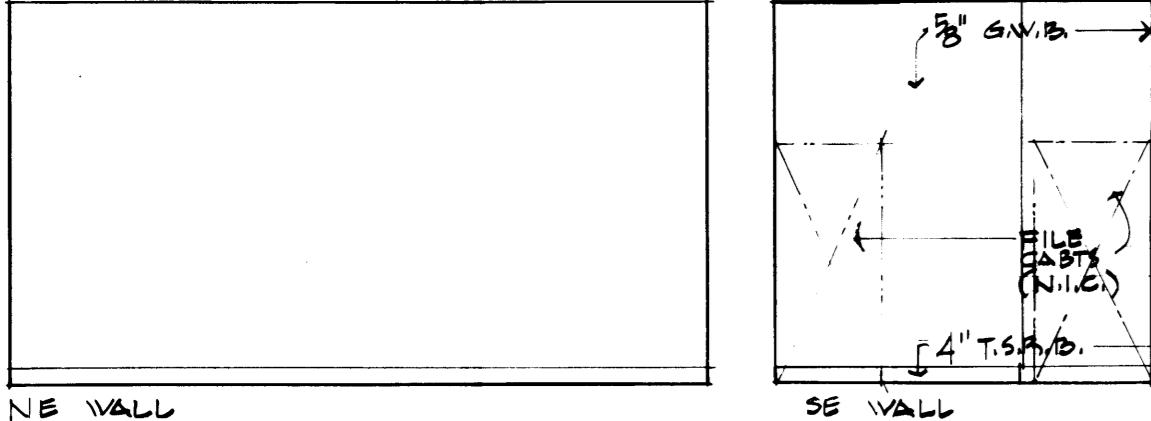






6 ELEVNS OF FILE STORAGE (224)

21 SCALE 1/4" = 1'-0"

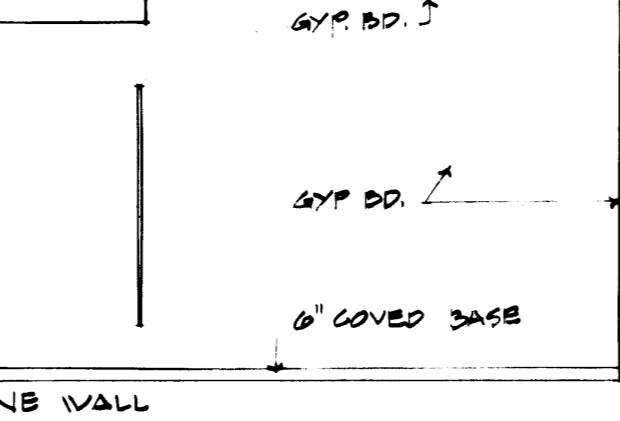


7 ELEVNS OF MEN (225)

21 SCALE 1/4" = 1'-0"

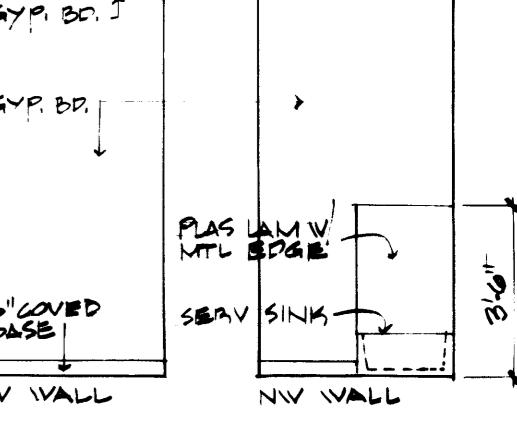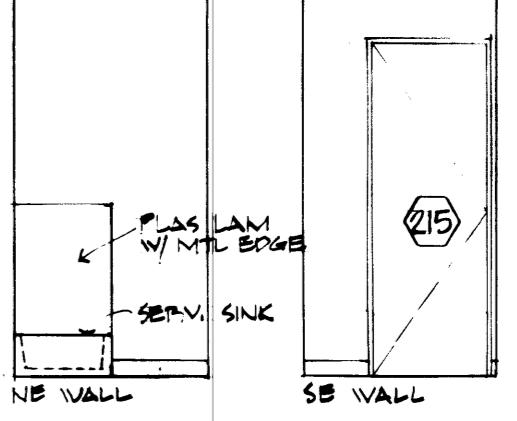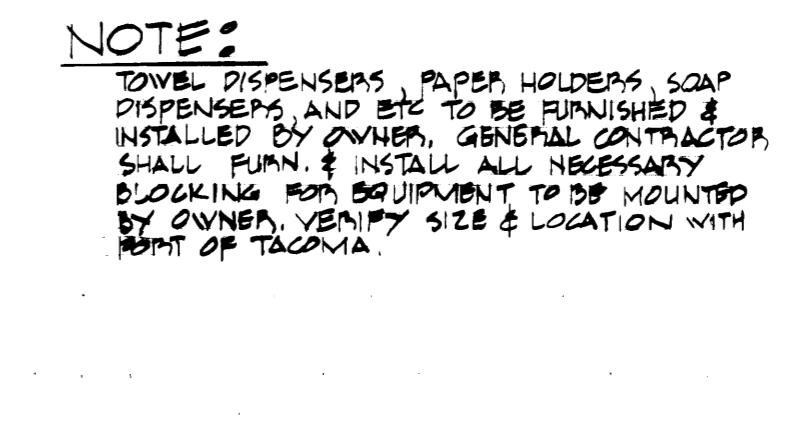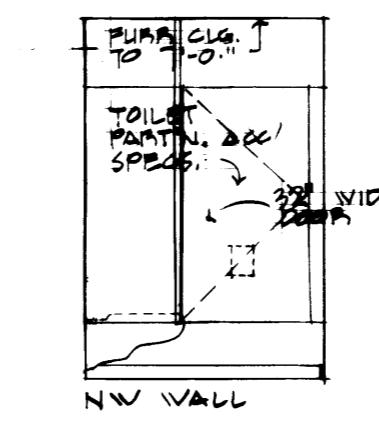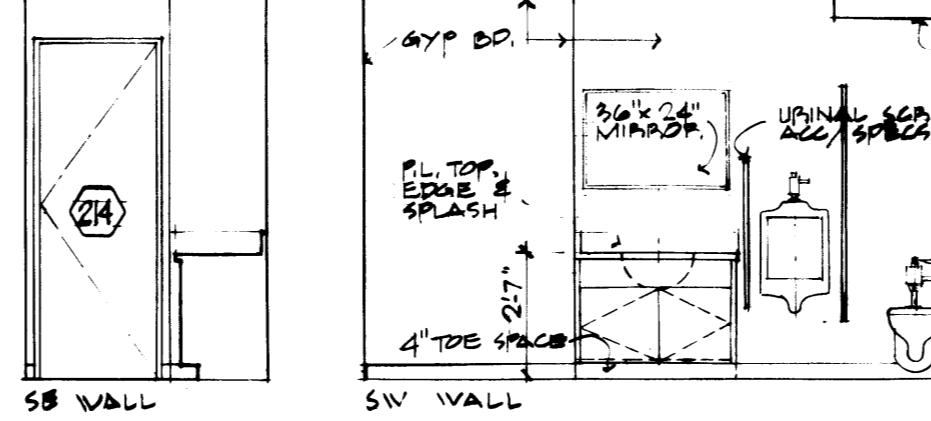


NOTE: TOILET DISPENSERS, PAPER HOLDERS, SOAP DISPENSERS, AND ETC TO BE FURNISHED & INSTALLED BY OWNER. ALL EQUIPMENT SHALL FURNISH & INSTALL ALL NECESSARY BLOCKING FOR EQUIPMENT TO BE MOUNTED BY OWNER. VERIFY SIZE & LOCATION WITH PORT OF TACOMA.

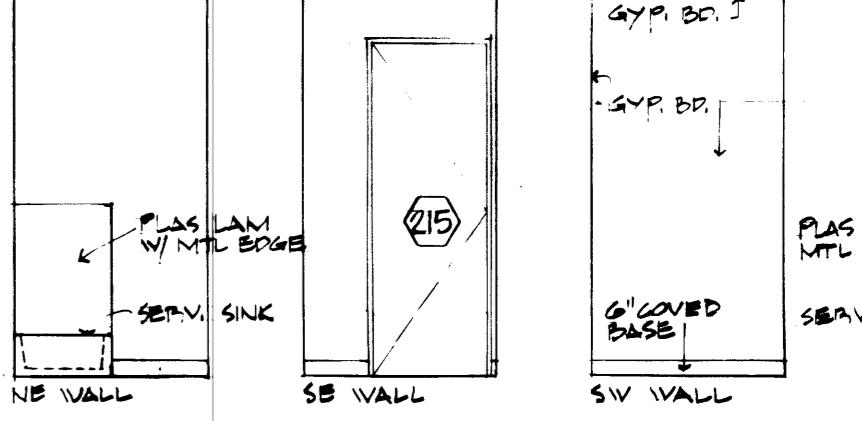



8 ELEVNS OF JANITOR (226)

21 SCALE 1/4" = 1'-0"

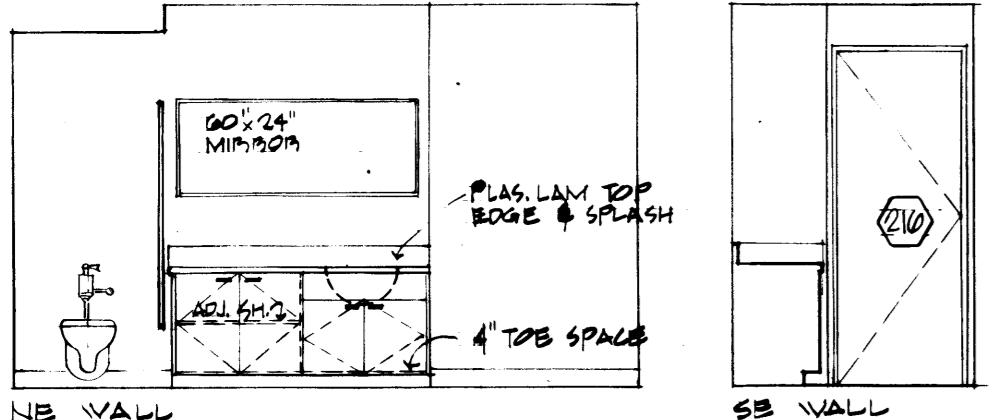




9 ELEVNS OF WOMEN (227)

21 SCALE 1/4" = 1'-0"

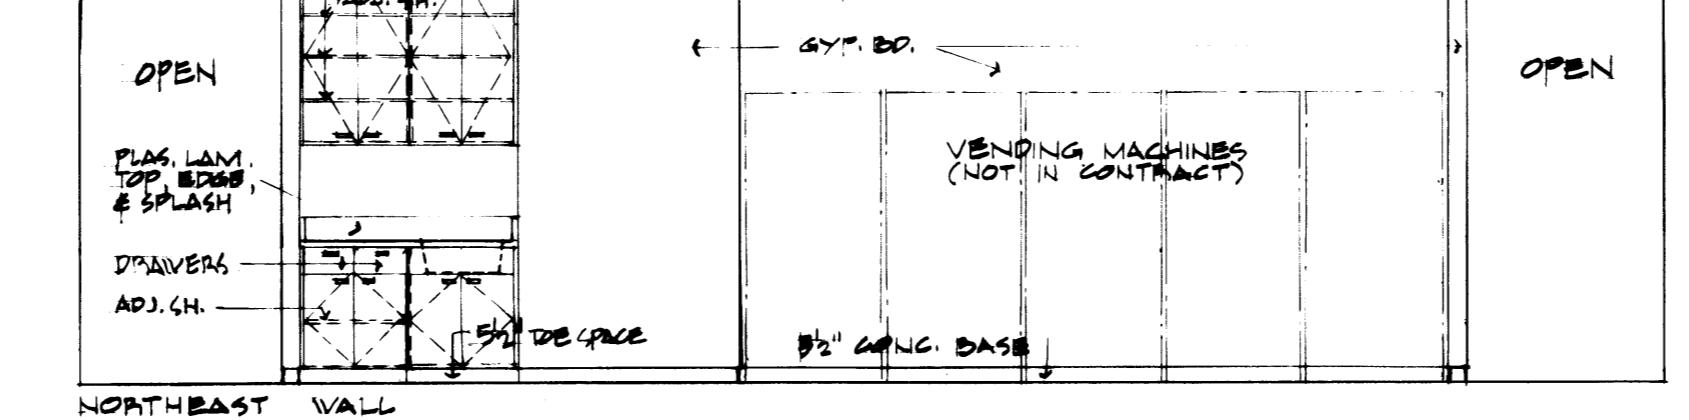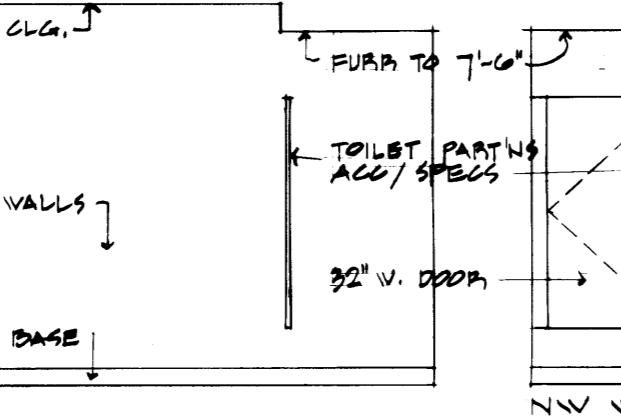








10 ELEVATIONS OF LUNCHROOM (228)

21 SCALE 1/4" = 1'-0"

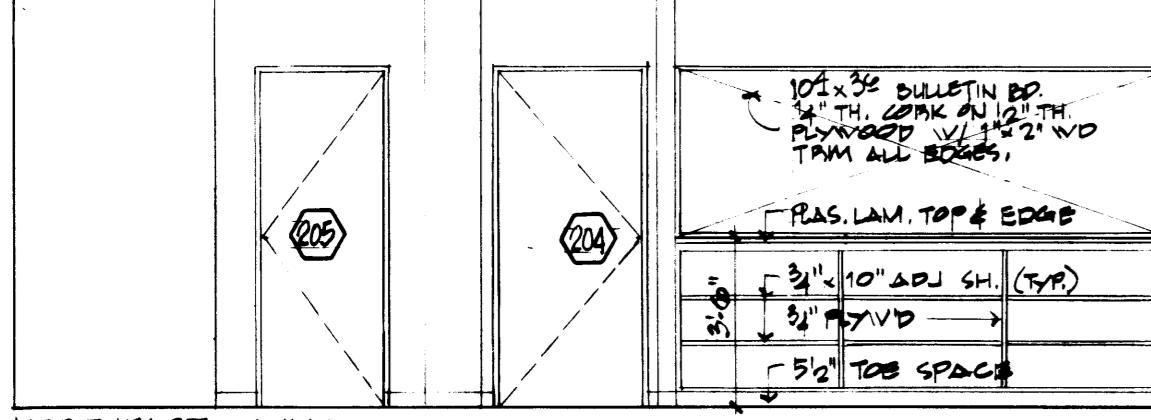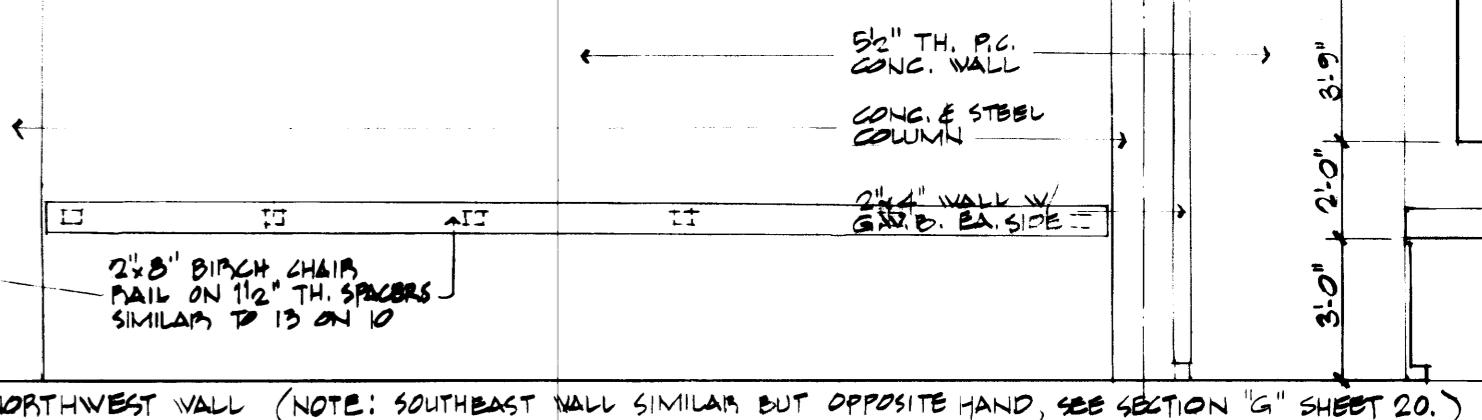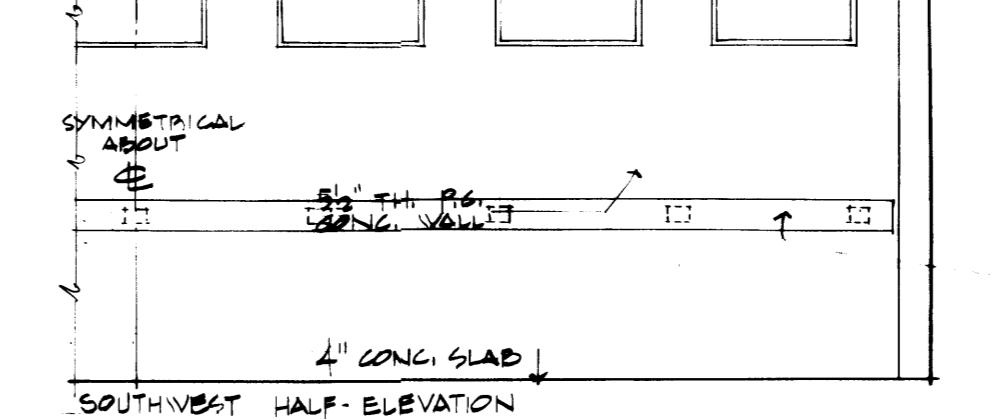







11 ELEVATIONS OF CENTRAL LOBBY (229)

21 SCALE 1/4" = 1'-0"

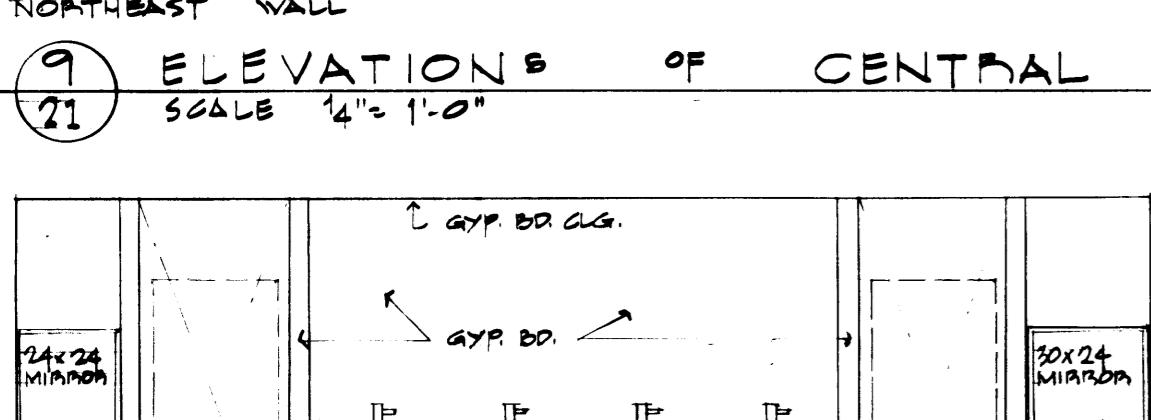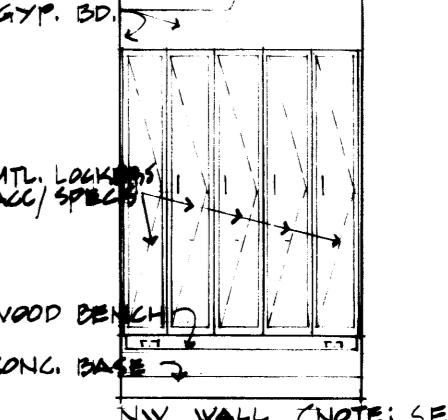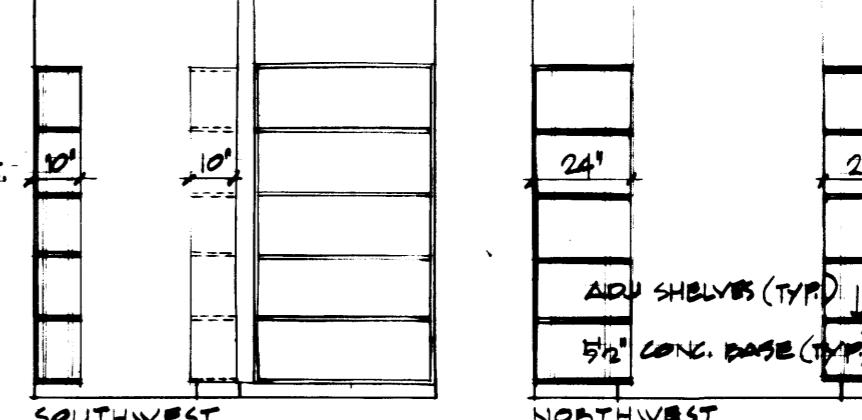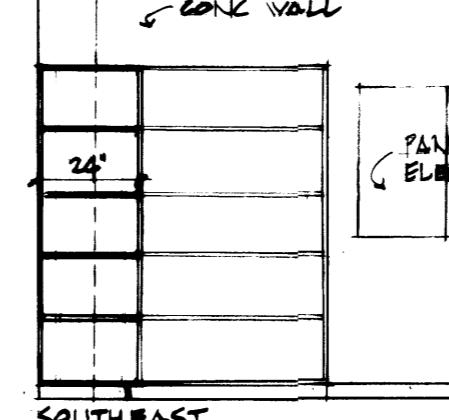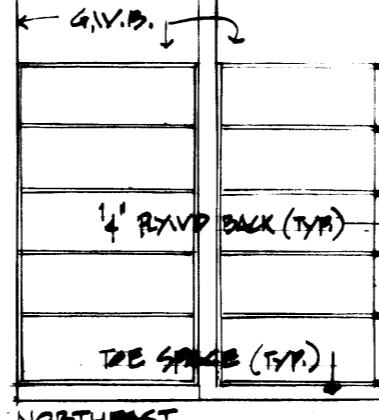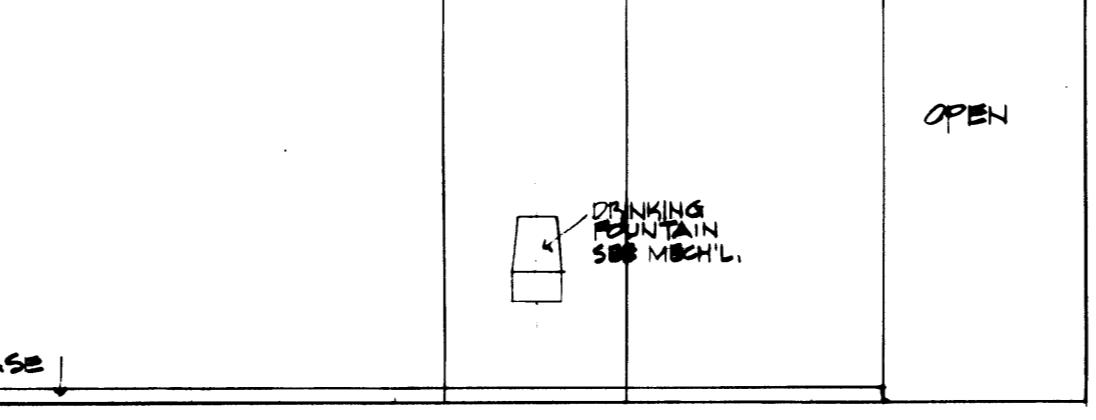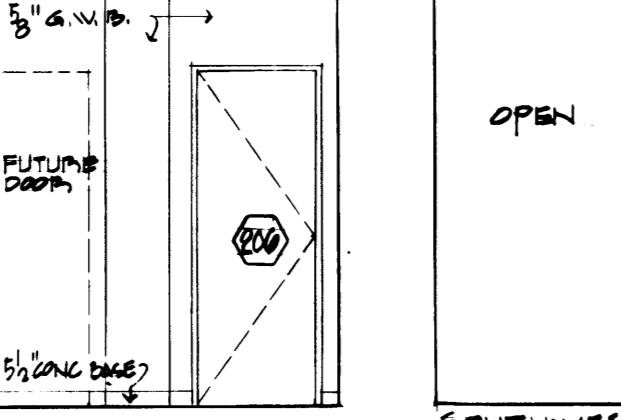





12 ELEVATIONS OF TOILET ROOM (230)

21 SCALE 1/4" = 1'-0"

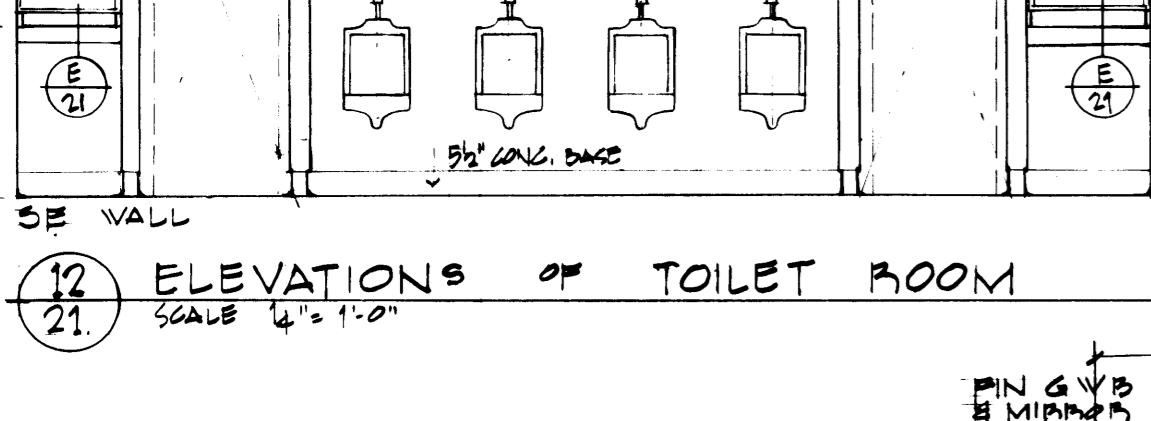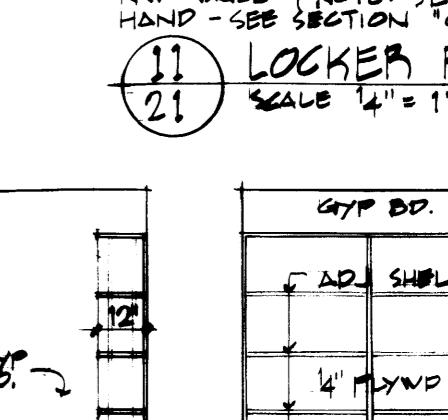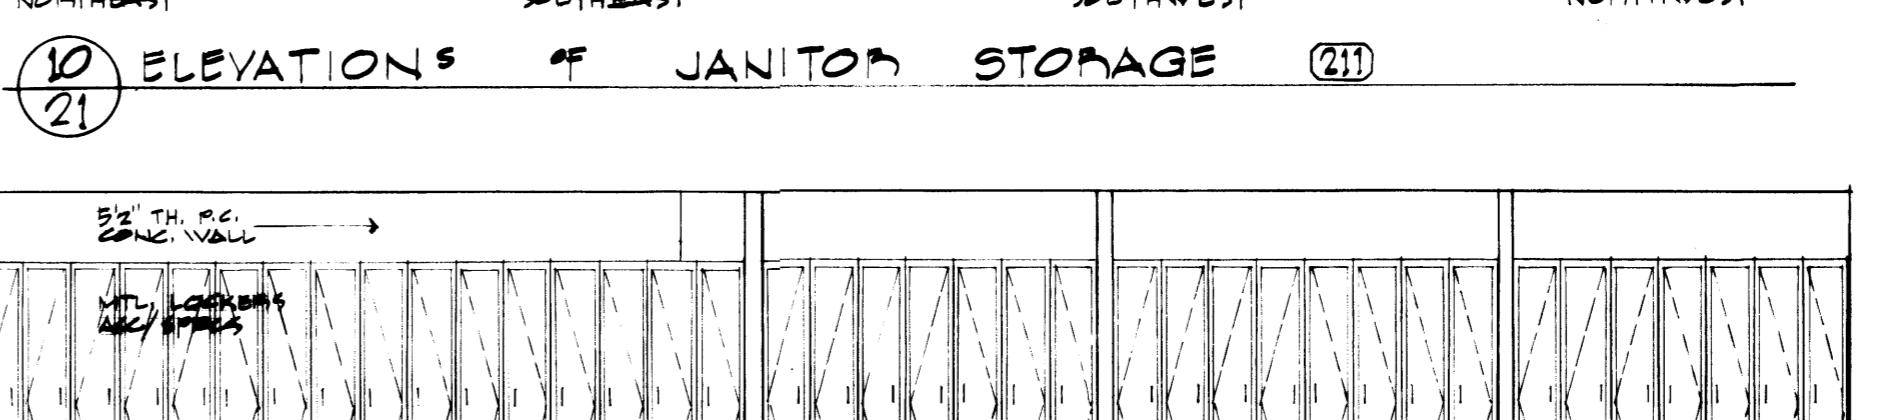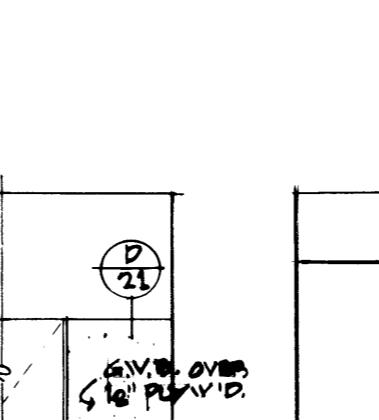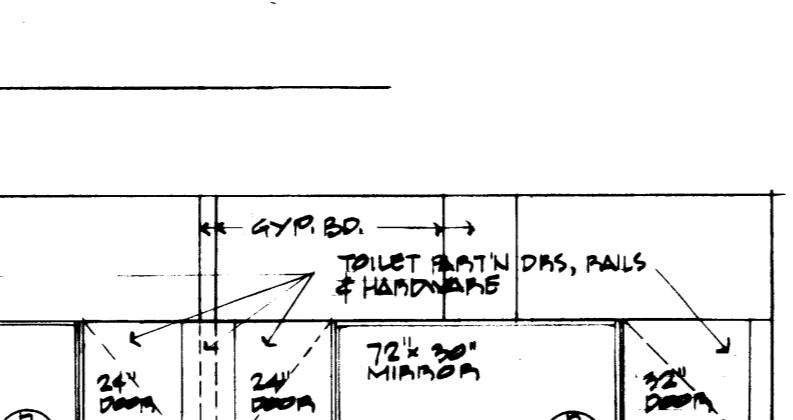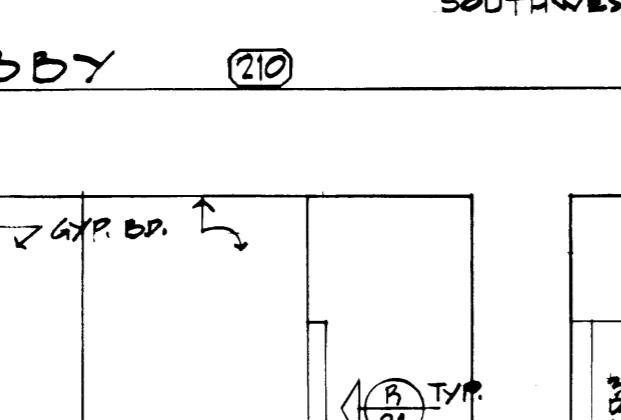






13 ELEVATIONS OF JAN. RM. (231)

21 SCALE 1/4" = 1'-0"

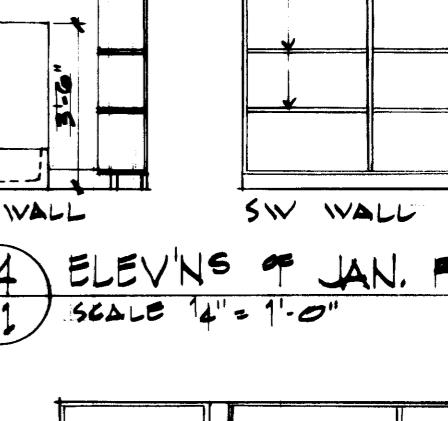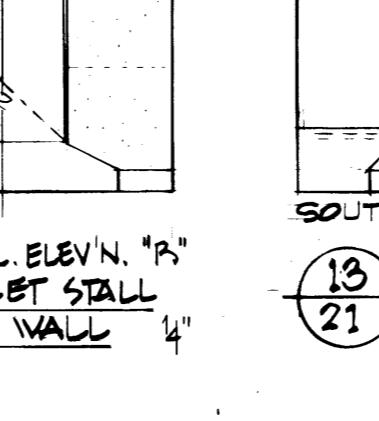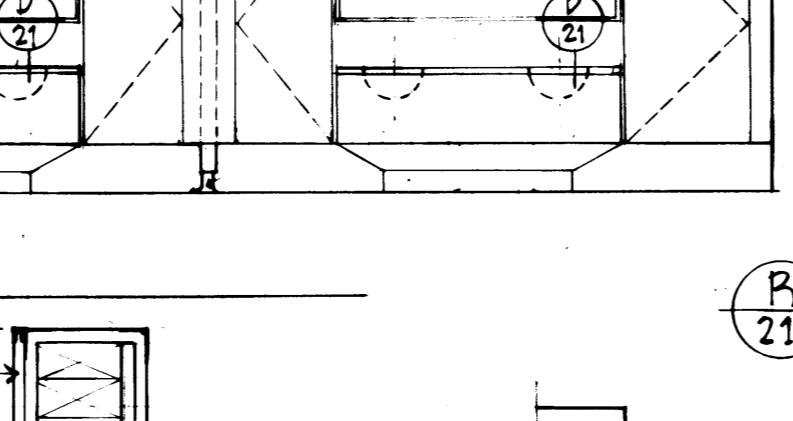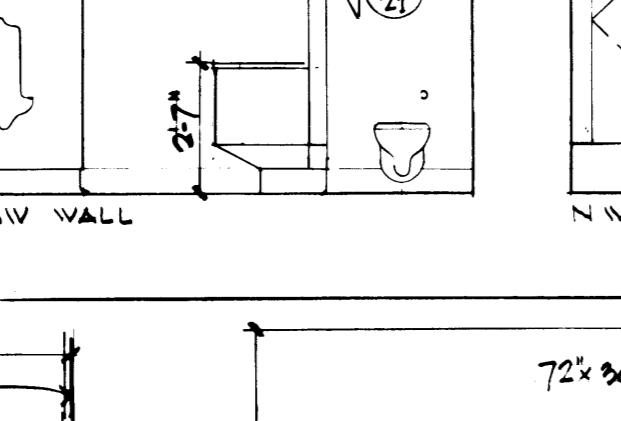






14 ELEVNS OF JAN. RM. (232)

21 SCALE 1/4" = 1'-0"

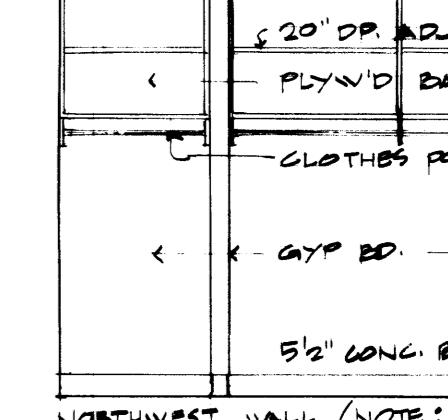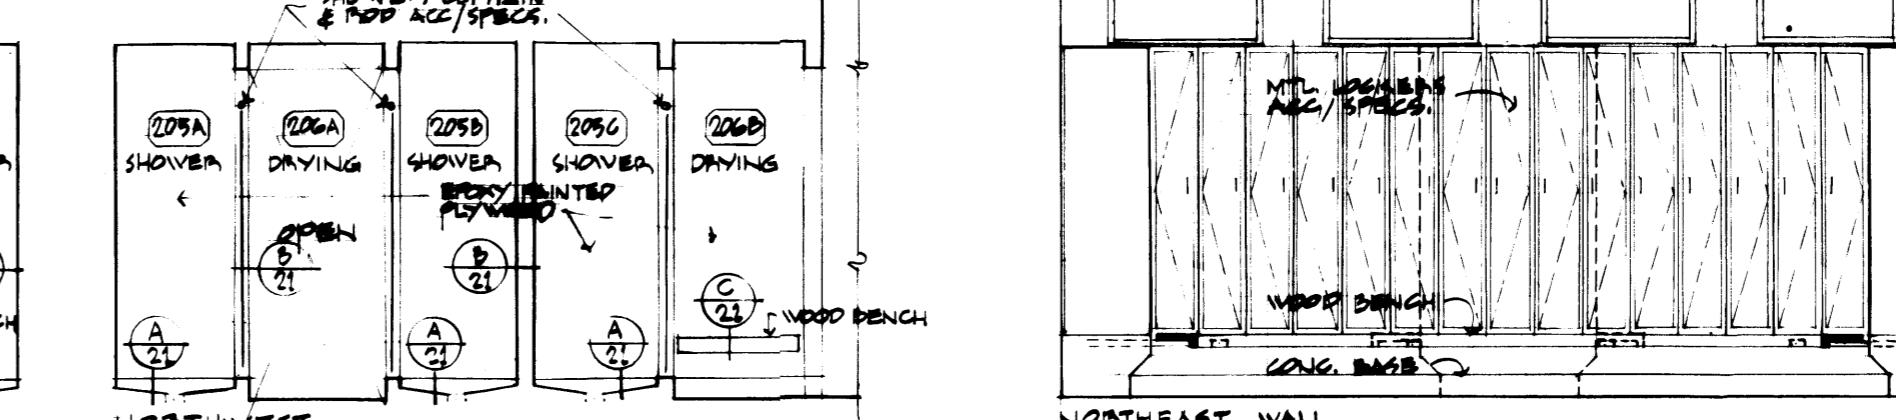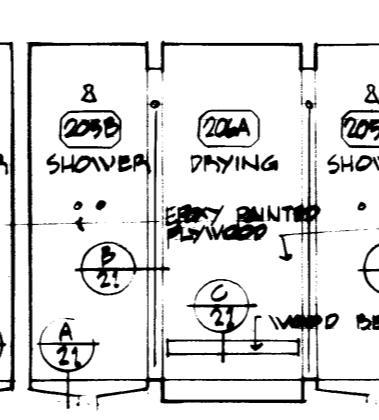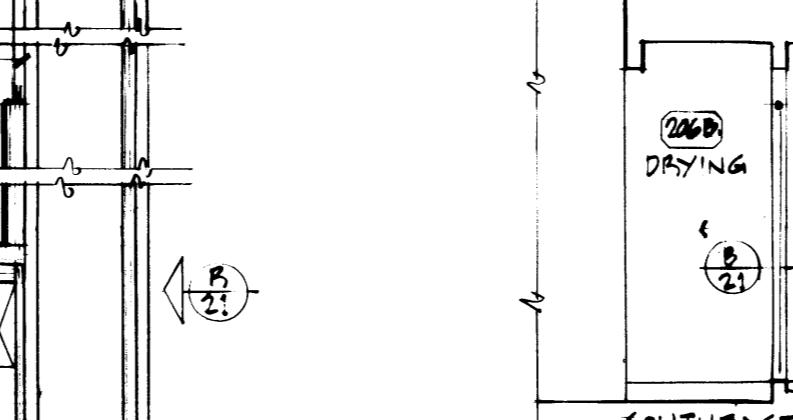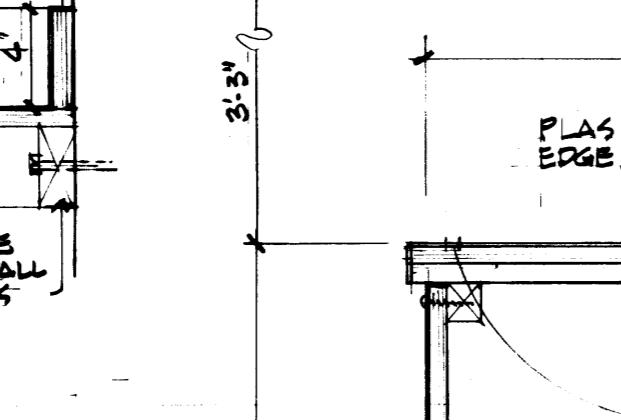

15 ELEVNS OF JAN. RM. (233)

21 SCALE 1/4" = 1'-0"

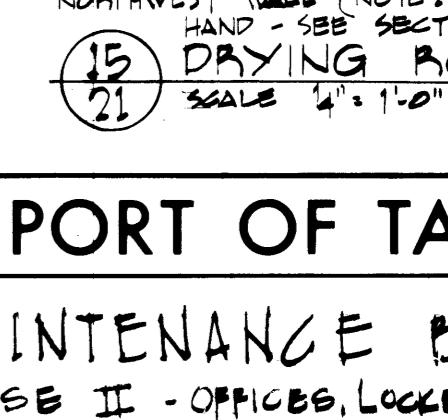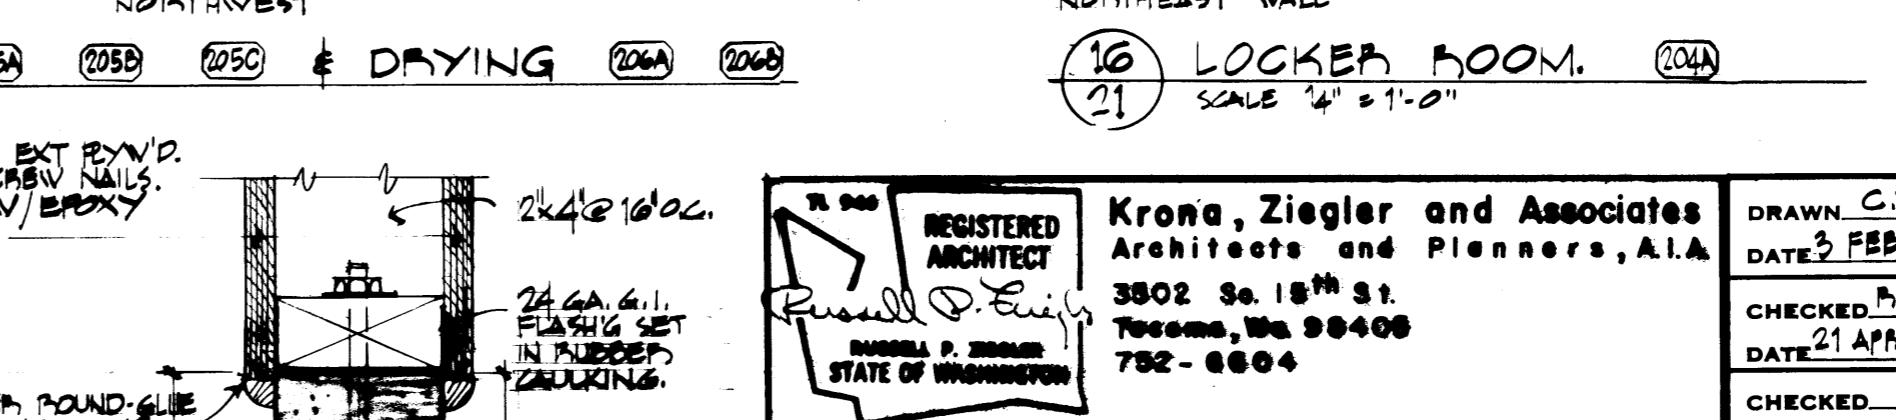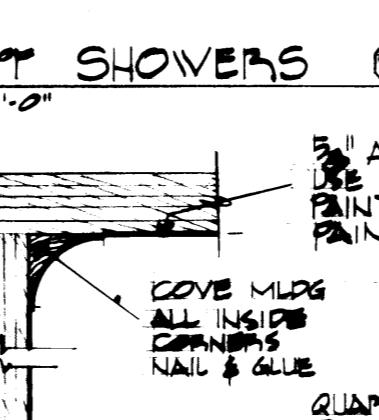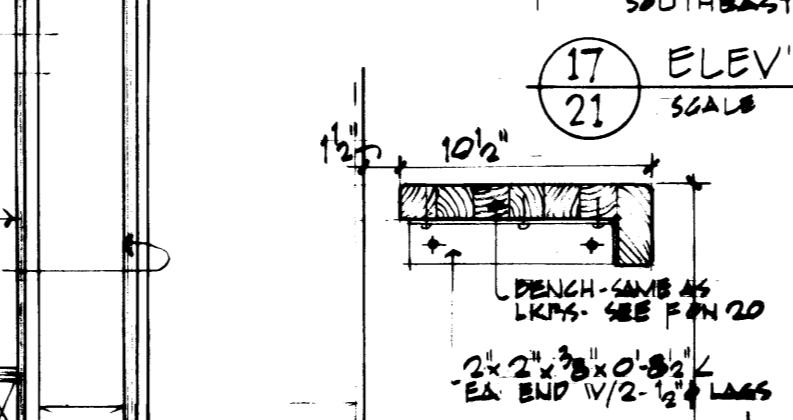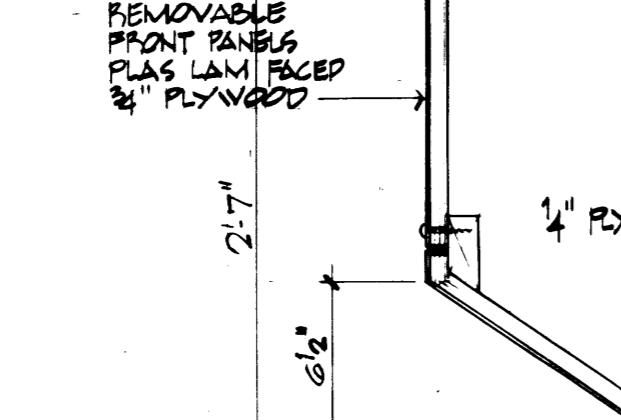

D SECTION THRU LAV. CABINET

21 SCALE 1/2" = 1'-0"

D

DRYING BENCH

21 SC. 1/2" = 1'-0"

C

COPPER JOINTS FOR SHOWER & DRYING BMS.

21 HALF SIZE

B


SHOWER-DRYING BASE

21 SC. 3" = 1'-0"


A

REGISTERED ARCHITECT	Arnold P. Lewis	DATE 3 FEB 1975
ASSOCIATE	RANDALL P. JONES	DATE 21 APRIL 1975
STRUCTURAL ENGINEER	NEIL R. ADAMS, P.E.	DATE
MECHANICAL ENGINEER	ARNOLD M. BURKE, P.E.	DATE
ELECTRICAL ENGINEER	4041 Rainier Way, Suite A, Tacoma, Wa. 98402	CONT. NO. 401
FIELD BOOK(S)	4-28-75	APPROVED
MARK	REVISION	3/11/77
BY	APP.	DATE
CHIEF ENGINEER	DANIEL L. MOORE	4-28-75

PORT OF TACOMA
MAINTENANCE BUILDING
PHASE II - OFFICES, LOCKER RM, LUNCHROOM
Krona, Ziegler and Associates, Architects and Planners, A.I.A.
3802 Se. 18th St., Tacoma, Wa. 98406 565-3833
STATE OF WASHINGTON 752-6804
Neil R. Adams, P.E. & Associates, Inc. Civil & Structural
2719 Rochester St. W., Tacoma, Wa. 98466 565-3833
Arnold M. Burke and Associates, Mech. & Elect.
4041 Rainier Way, Suite A, Tacoma, Wa. 98402 752-7722
CONT. NO. 401
FIELD BOOK(S)
APPROVED
4-28-75
DATE
DRAWING NO.
EP-2622-4
A-21 OF 24
SHEET NO. 21 OF 24

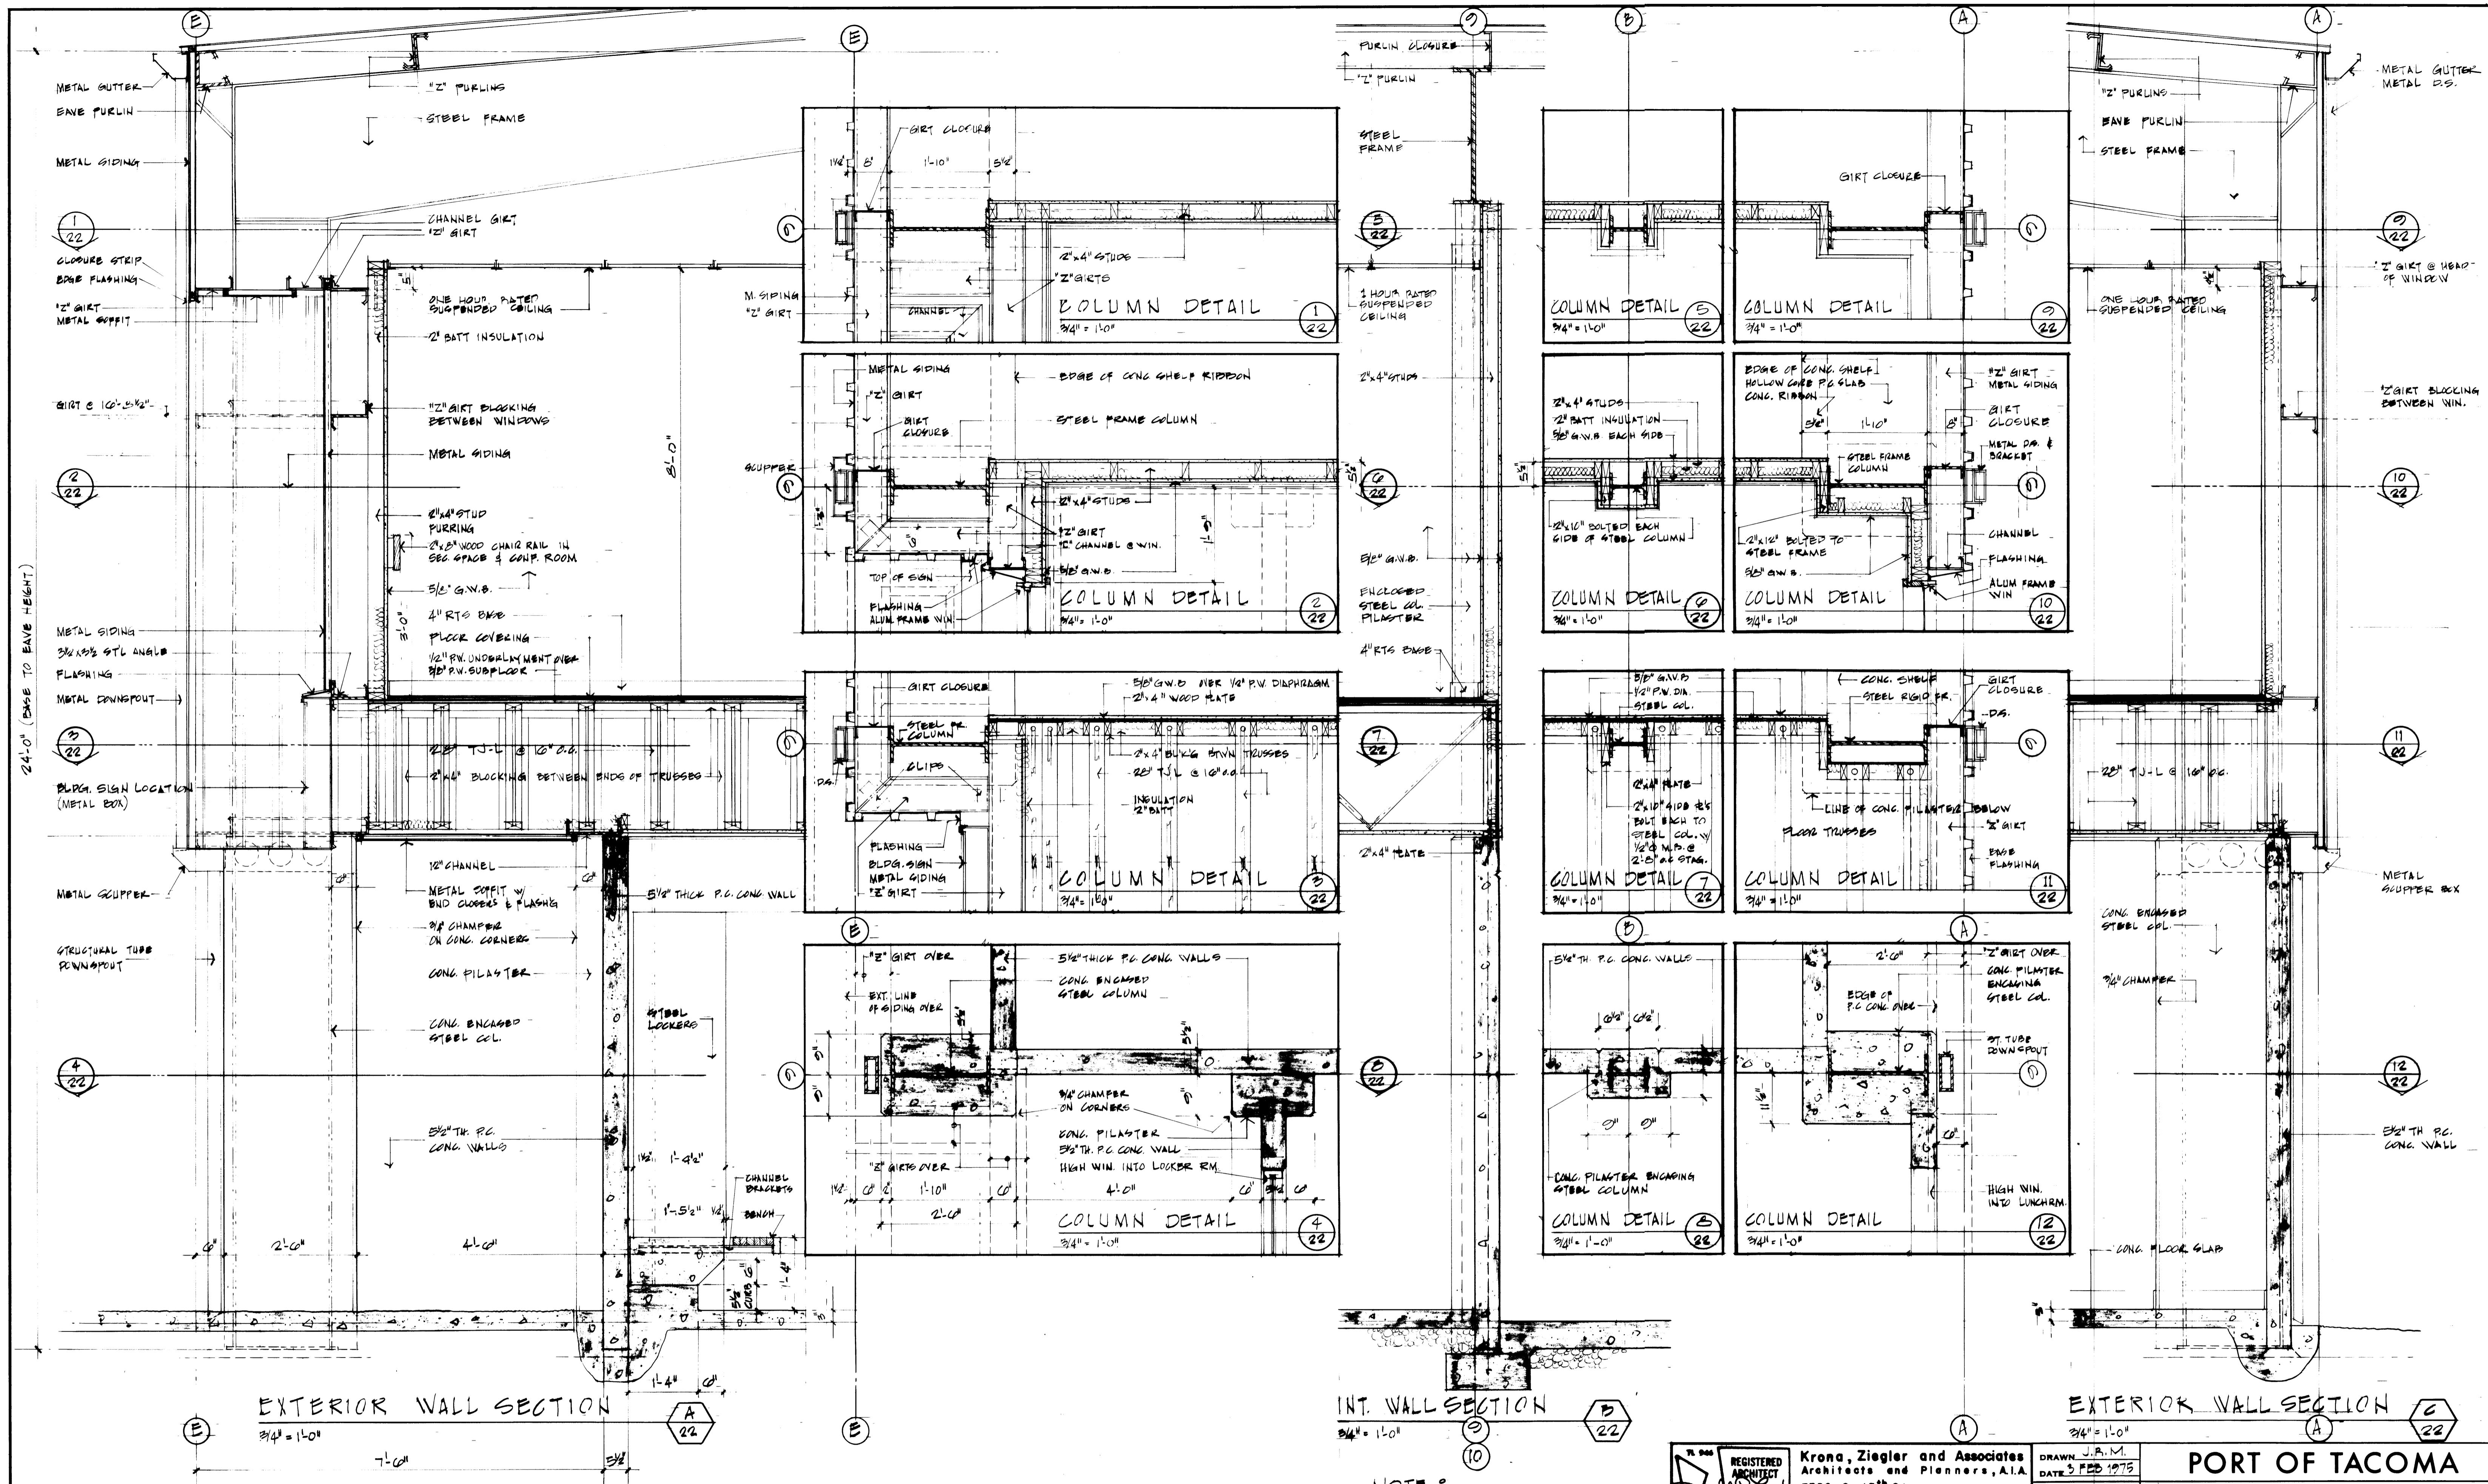

 <p>REGISTERED ARCHITECT <i>Russell P. Ziegler</i> RUSSELL P. ZIEGLER STATE OF WASHINGTON</p>	<p>Krona, Ziegler and Associates Architects and Planners, A.I.A. 3502 So. 15th St. Tacoma, Wa. 98405 752-6604</p>																					
	<p>Noel R. Adams P.E. & Associates, Inc. Civil & Structural 2719 Rochester St. W., Tacoma, Wa. 98466 565-3833</p> <p>Arnold N. Bogue and Associates Mech. & Elect. 4041 Ruston Way, Suite A, Tacoma, Wa. 98402 752-7722</p>																					
MARK	REVISION	BY APP. DATE																				
<p>AS BUILT</p>		3-11-77																				
<p>44-100</p>																						
<table border="1"> <tr> <td>DRAWN</td> <td>J.R.M.</td> </tr> <tr> <td>DATE</td> <td>3 FEB 1975</td> </tr> <tr> <td>CHECKED</td> <td>R.P.Z.</td> </tr> <tr> <td>DATE</td> <td>21 APRIL 1975</td> </tr> <tr> <td>CHECKED</td> <td></td> </tr> <tr> <td>DATE</td> <td></td> </tr> <tr> <td>CONT. NO.</td> <td>401</td> </tr> <tr> <td colspan="2">FIELD BOOK(S)</td> </tr> <tr> <td>APPROVED</td> <td>4-28-75 <i>Russell P. Ziegler</i></td> </tr> <tr> <td colspan="2">CREF ENGS</td> </tr> </table>			DRAWN	J.R.M.	DATE	3 FEB 1975	CHECKED	R.P.Z.	DATE	21 APRIL 1975	CHECKED		DATE		CONT. NO.	401	FIELD BOOK(S)		APPROVED	4-28-75 <i>Russell P. Ziegler</i>	CREF ENGS	
DRAWN	J.R.M.																					
DATE	3 FEB 1975																					
CHECKED	R.P.Z.																					
DATE	21 APRIL 1975																					
CHECKED																						
DATE																						
CONT. NO.	401																					
FIELD BOOK(S)																						
APPROVED	4-28-75 <i>Russell P. Ziegler</i>																					
CREF ENGS																						
<p>PORT OF TACOMA MAINTENANCE BUILDING PHASE II OFFICES, LOCKER RM, LUNCHROOM CONTENTS: WALL SECTIONS, DETAILS</p>																						
<p>SCALE $3/4" = 1'-0"$</p>																						
<p>DRAWING NO. EP-2622-4</p>																						
<p>SHEET NO. A-22 OF 24</p>																						

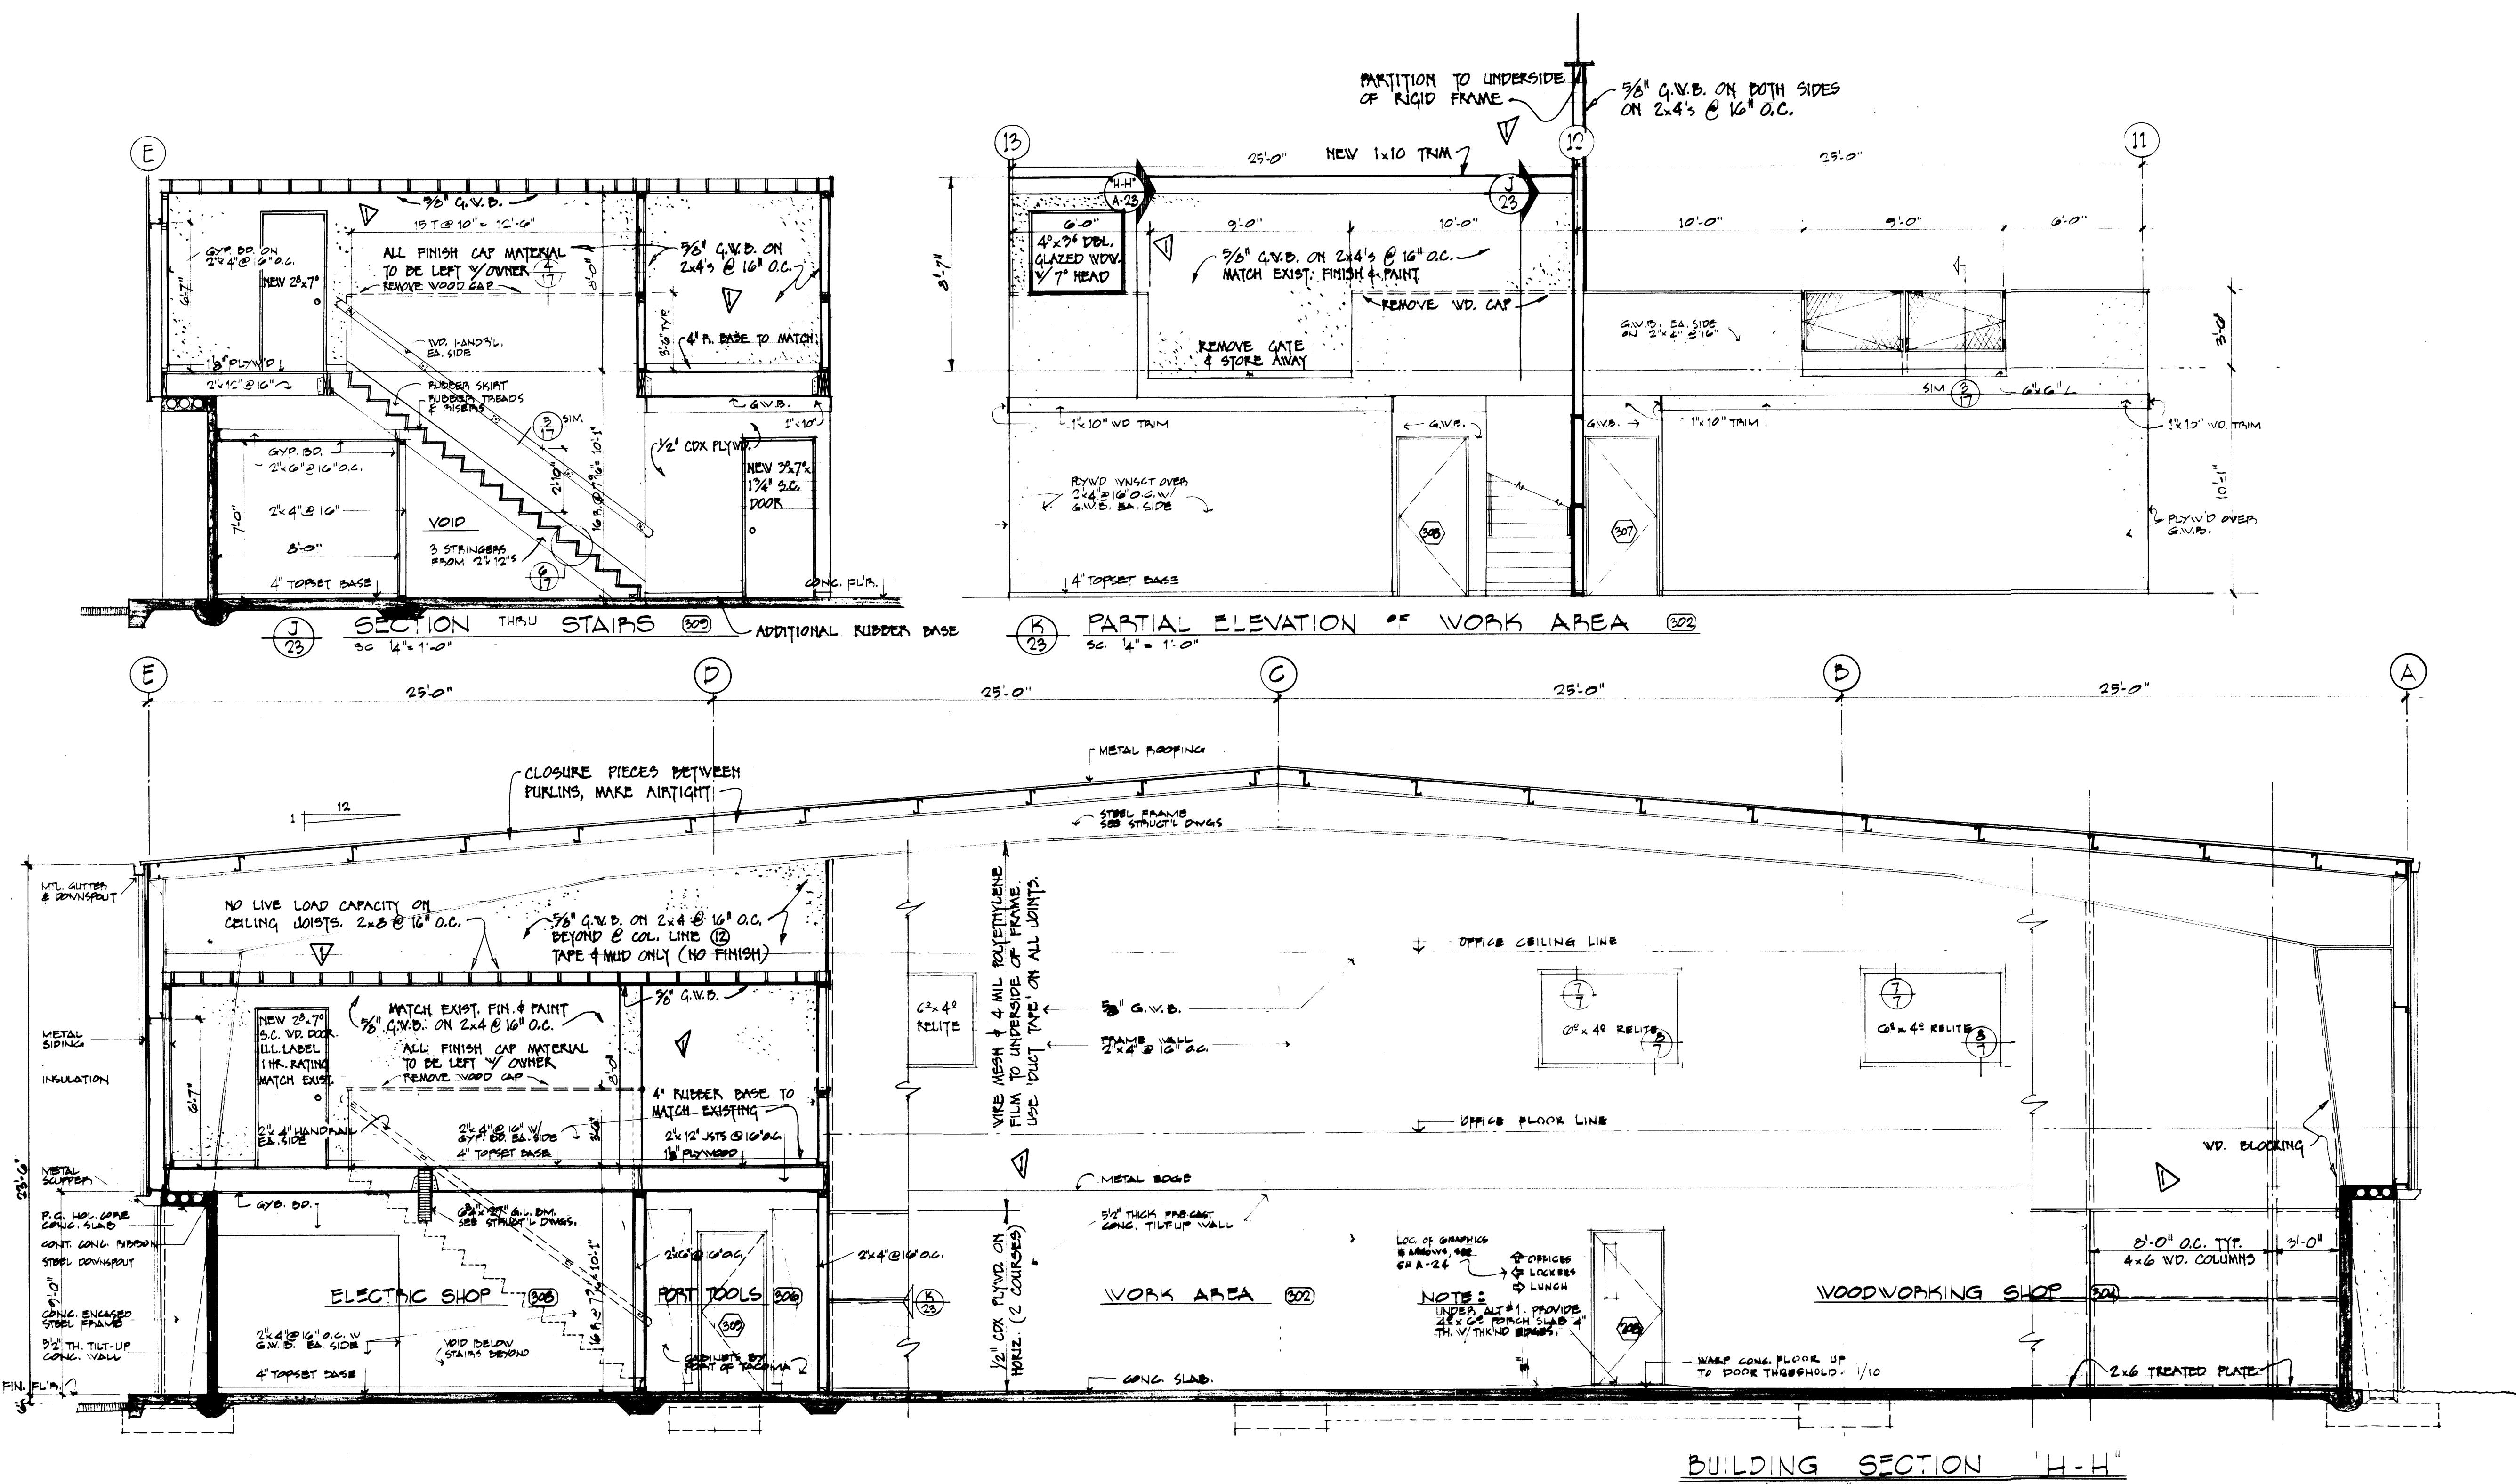

PL 940	REGISTERED ARCHITECT Arnold P. Ziegler STATE OF WASHINGTON	Krona, Ziegler and Associates Architects and Planners, A.I.A. 3502 So. 15th St. Tacoma, Wa. 98405 752-6604	DRAWN C.T.G. DATE 3 FEB 1975
		CHECKED B.P.Z. DATE 21 APRIL 1975	CHECKED DATE
		CONT. NO. 401	MAINTENANCE BUILDING PHASE III - FACILITIES MAINT.
		APPROVED	4-28-75 DATE
		AS BUILT	3/1/77
		✓ T.O.E. MODIFICATIONS	REV. 245. 6-4-76
		MARK	REVISION
		BY APP	DATE

4-28-75
DATE

EP-2622-4
A23 OF 24

