




1 PLAN - FENDER
SCALE: 3/4"=1'-0"

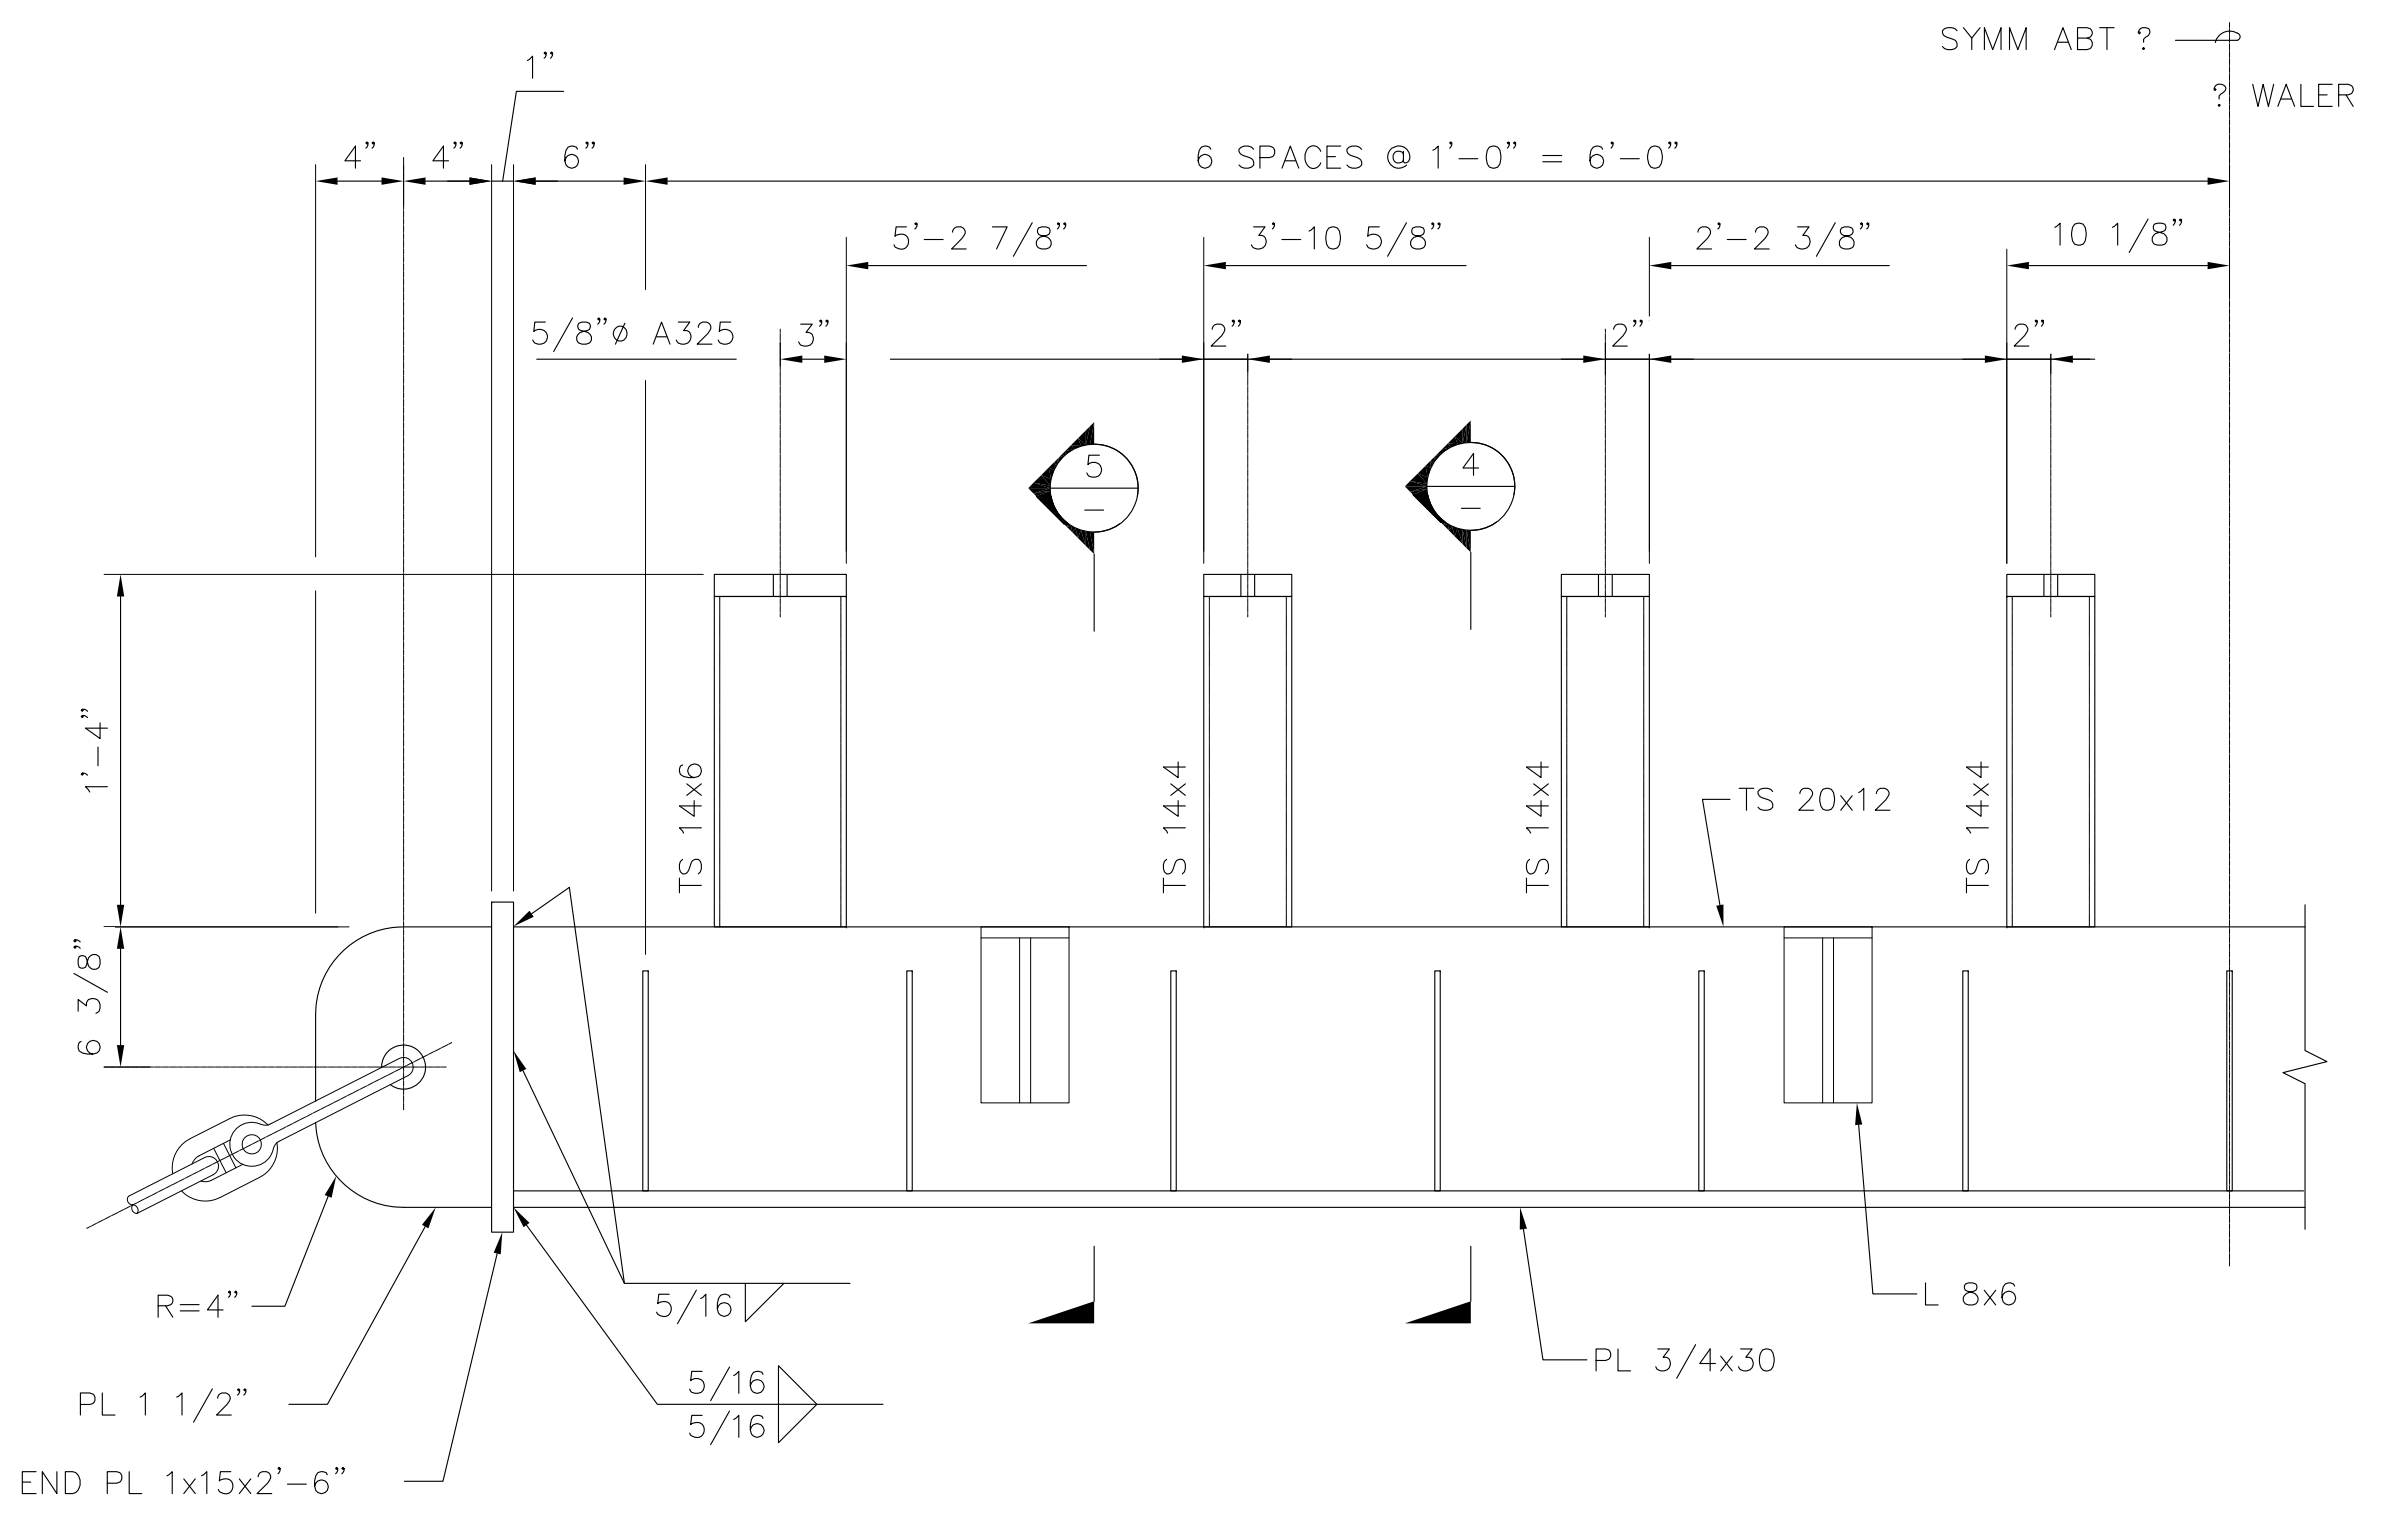


3 PLAN - WALER
SCALE: 1 1/2"=1'-0"

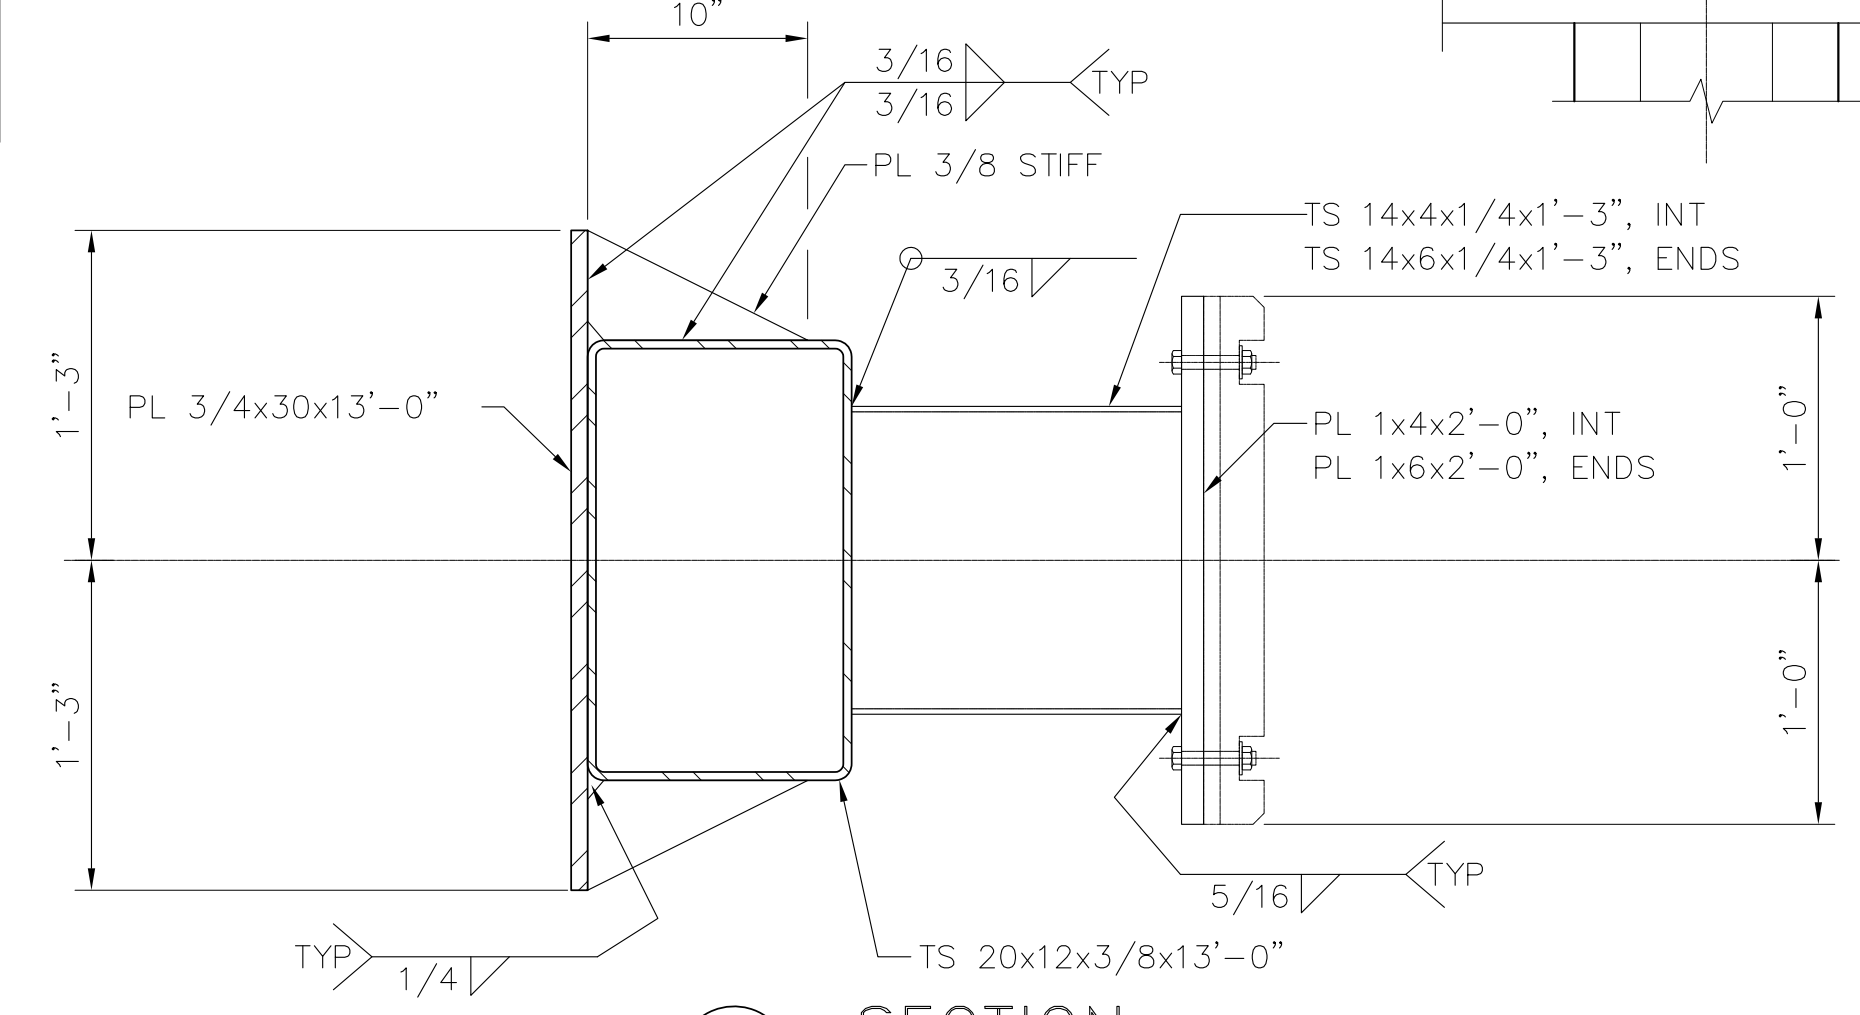

4 SECTION
SCALE: 1 1/2"=1'-0"

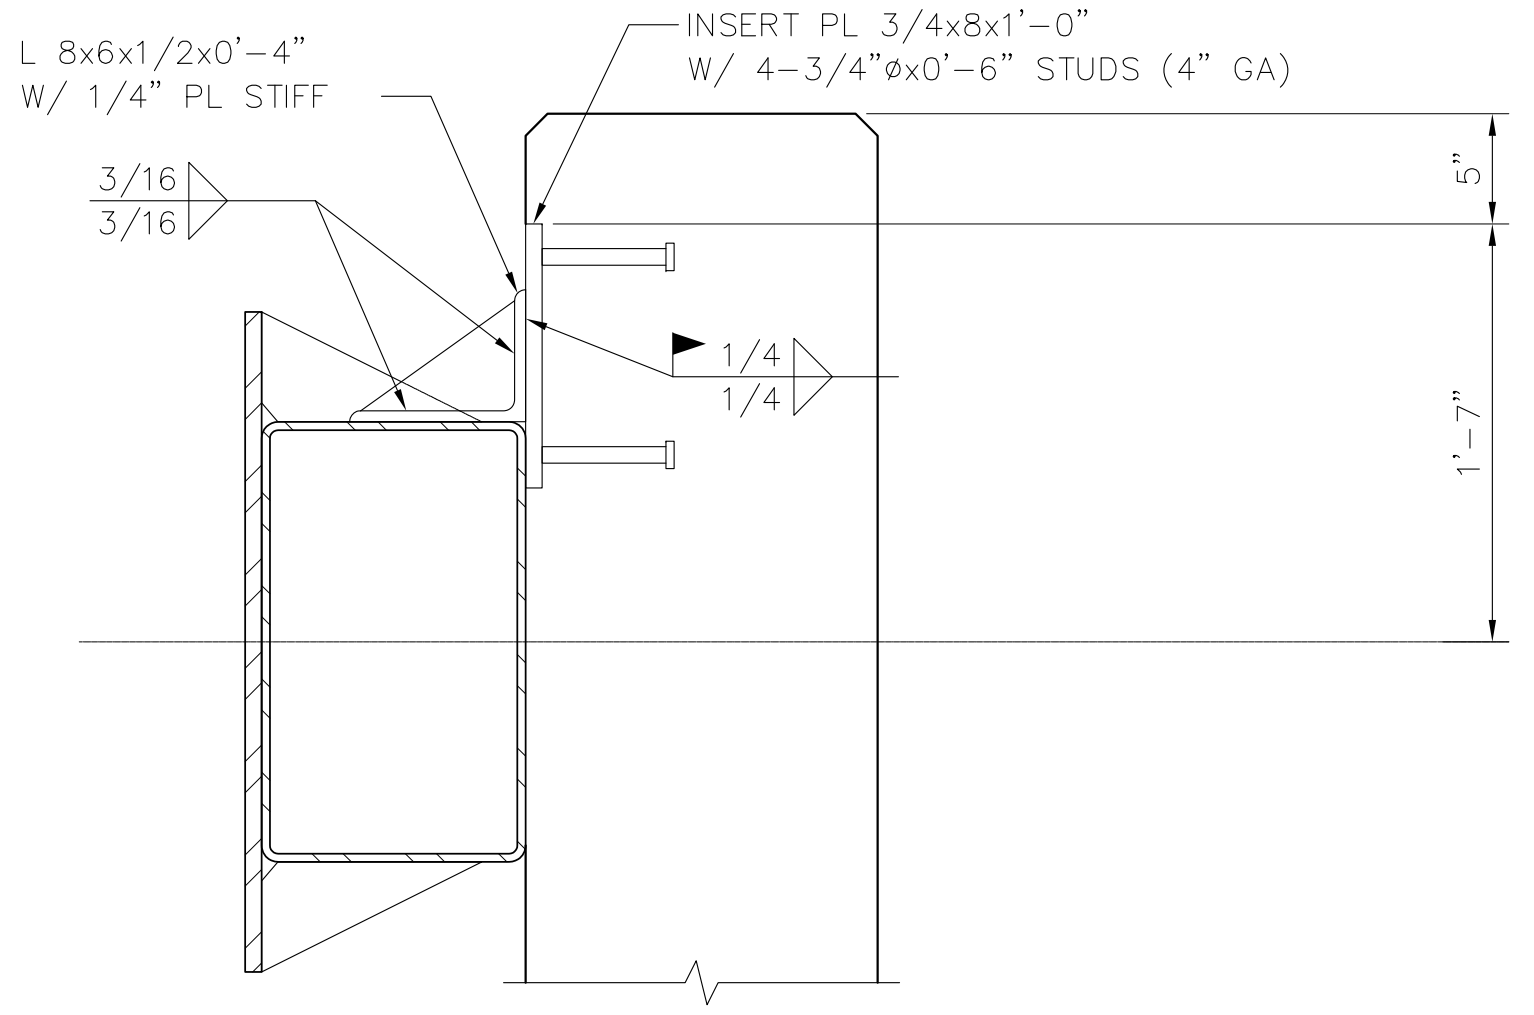

5 SECTION
SCALE: 1 1/2"=1'-0"

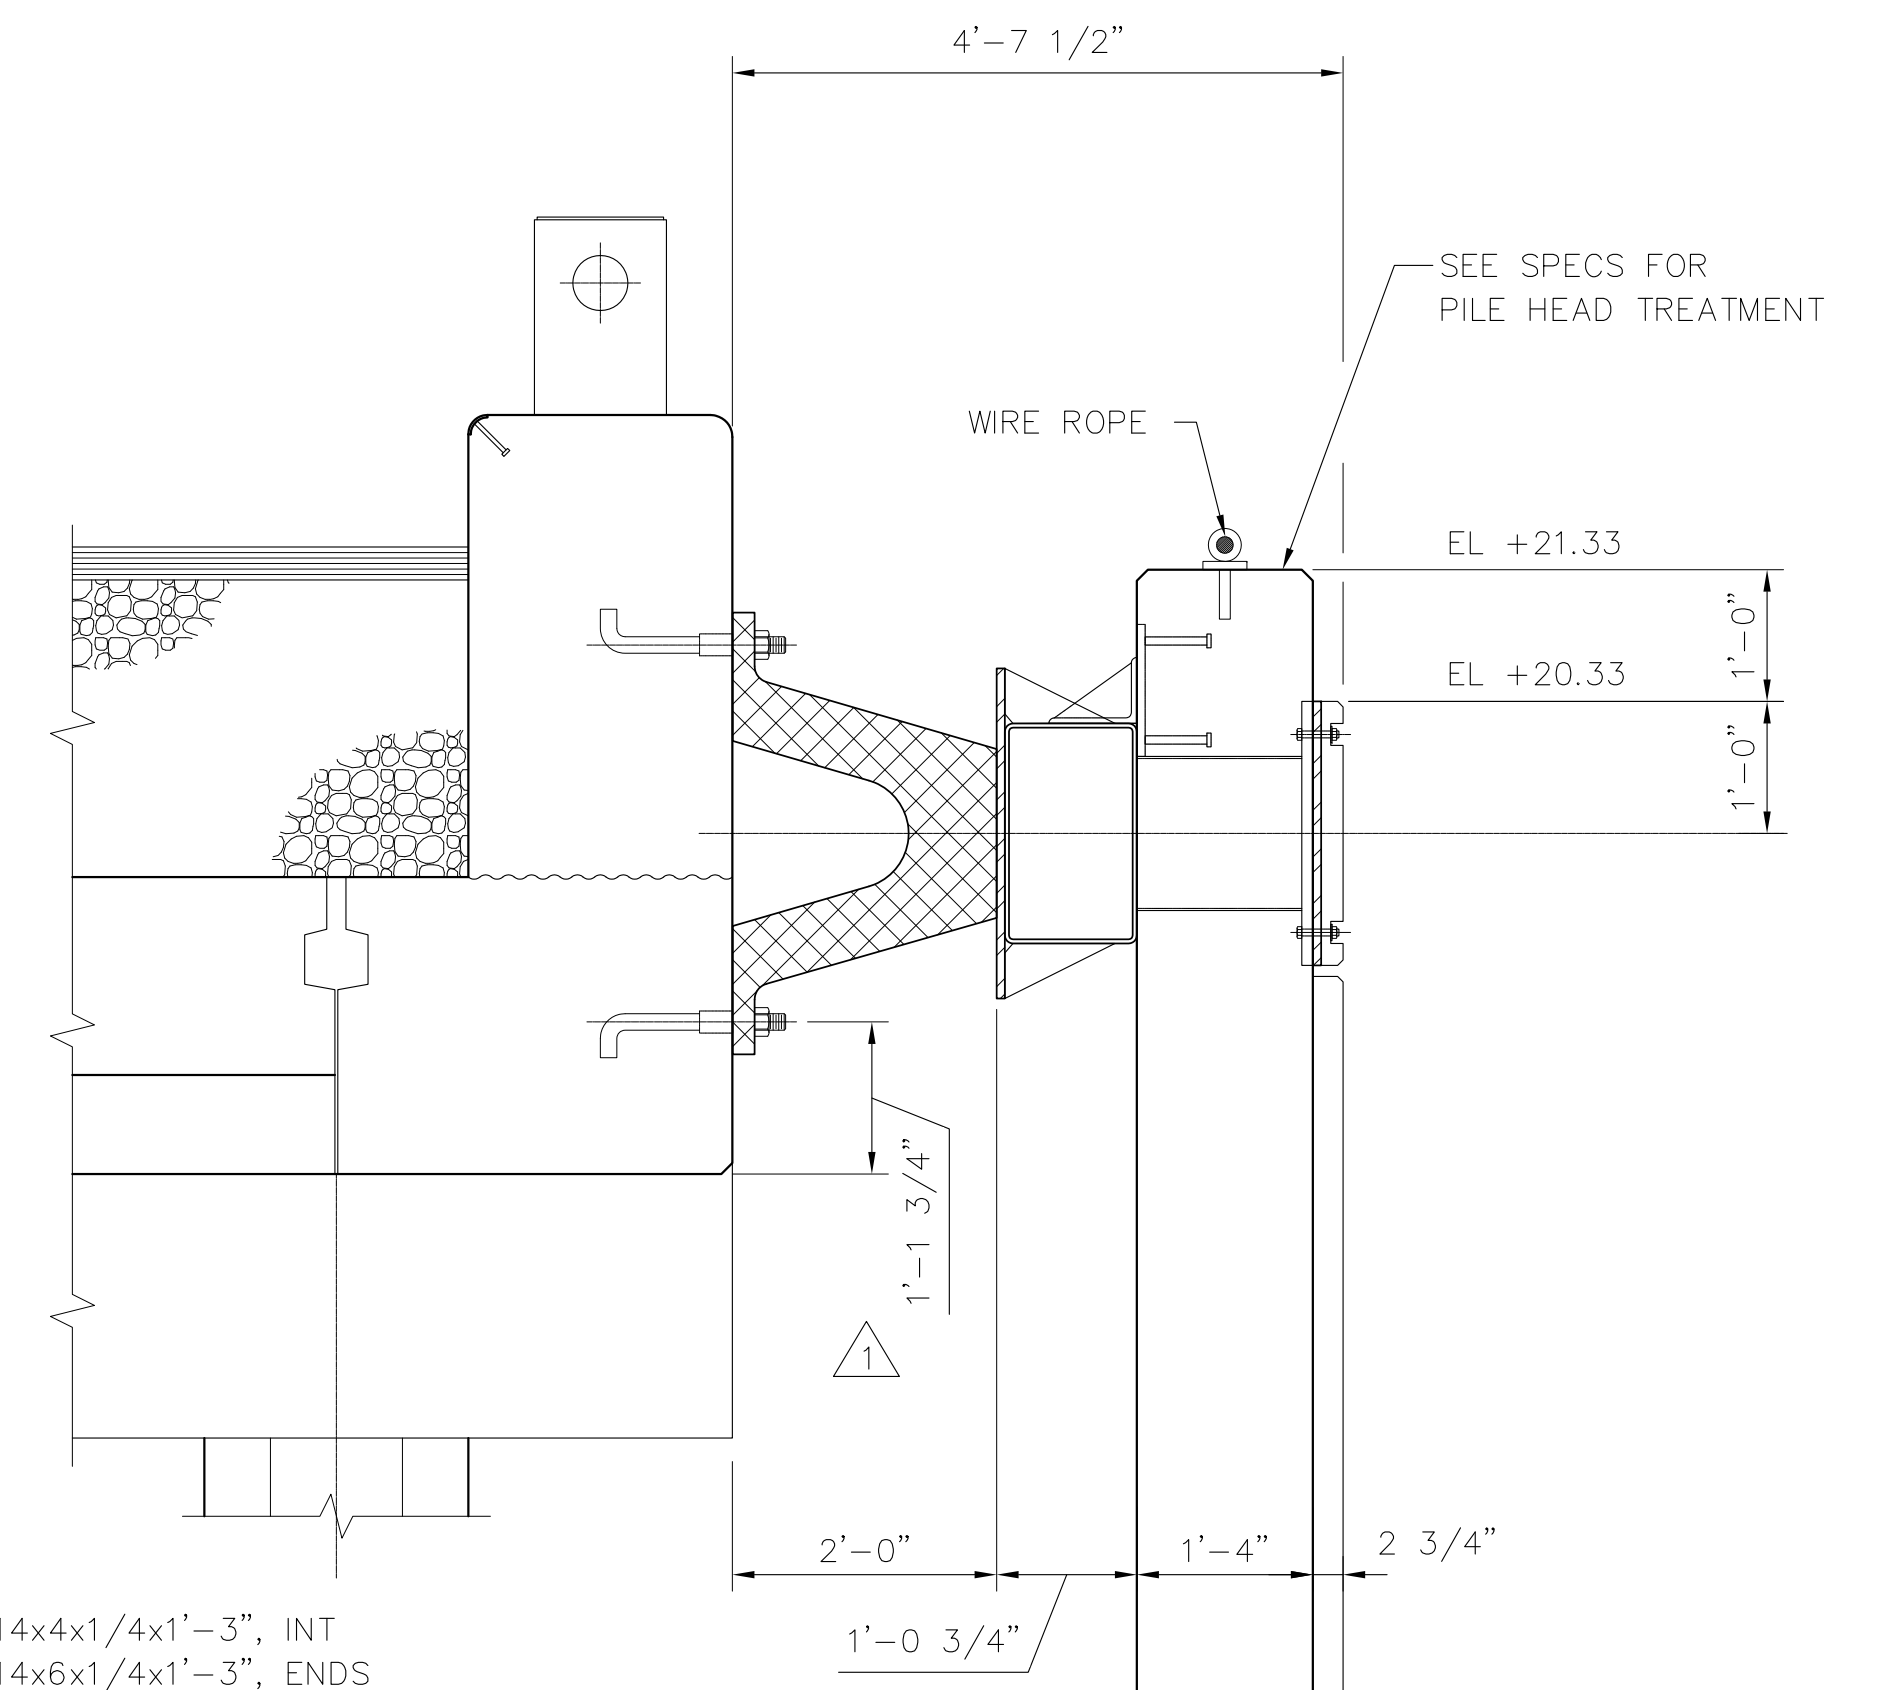

2 SECTION
SCALE: 3/4"=1'-0"

AS-BUILT

AUTOCAD FILE NO. 5012S33 S-33



PORT OF TACOMA
P.O. BOX 1837 TACOMA, WASHINGTON 98401
(206) 383-5841

BERGER/ABAM
ENGINEERS INC.
33301 9TH AVENUE SOUTH
FEDERAL WAY, WASHINGTON 98003-6395
(206)431-2300 FAX:(206)431-2250

APPROVED
DATE
CURTIS L. RATCLIFFE P.E.
CHIEF ENGINEER


BTH 9/91
DRAWN BY DATE
DESIGNED BY DATE

BCM 9/91
CHECKED BY DATE
JAS 9/91
PROJ ENGR DATE


MARK	REVISION	BY	APP.	DATE
AS-BUILT		RDD	JAS	1/4/93

HYUNDAI MERCHANT MARINE TERMINAL WHARF
PORT OF TACOMA
FENDER SYSTEM DETAILS - SHEET 1


DRAWING NO. EP-5012-26
CONTRACT NO. 978038
SHEET NO. 44 OF 58

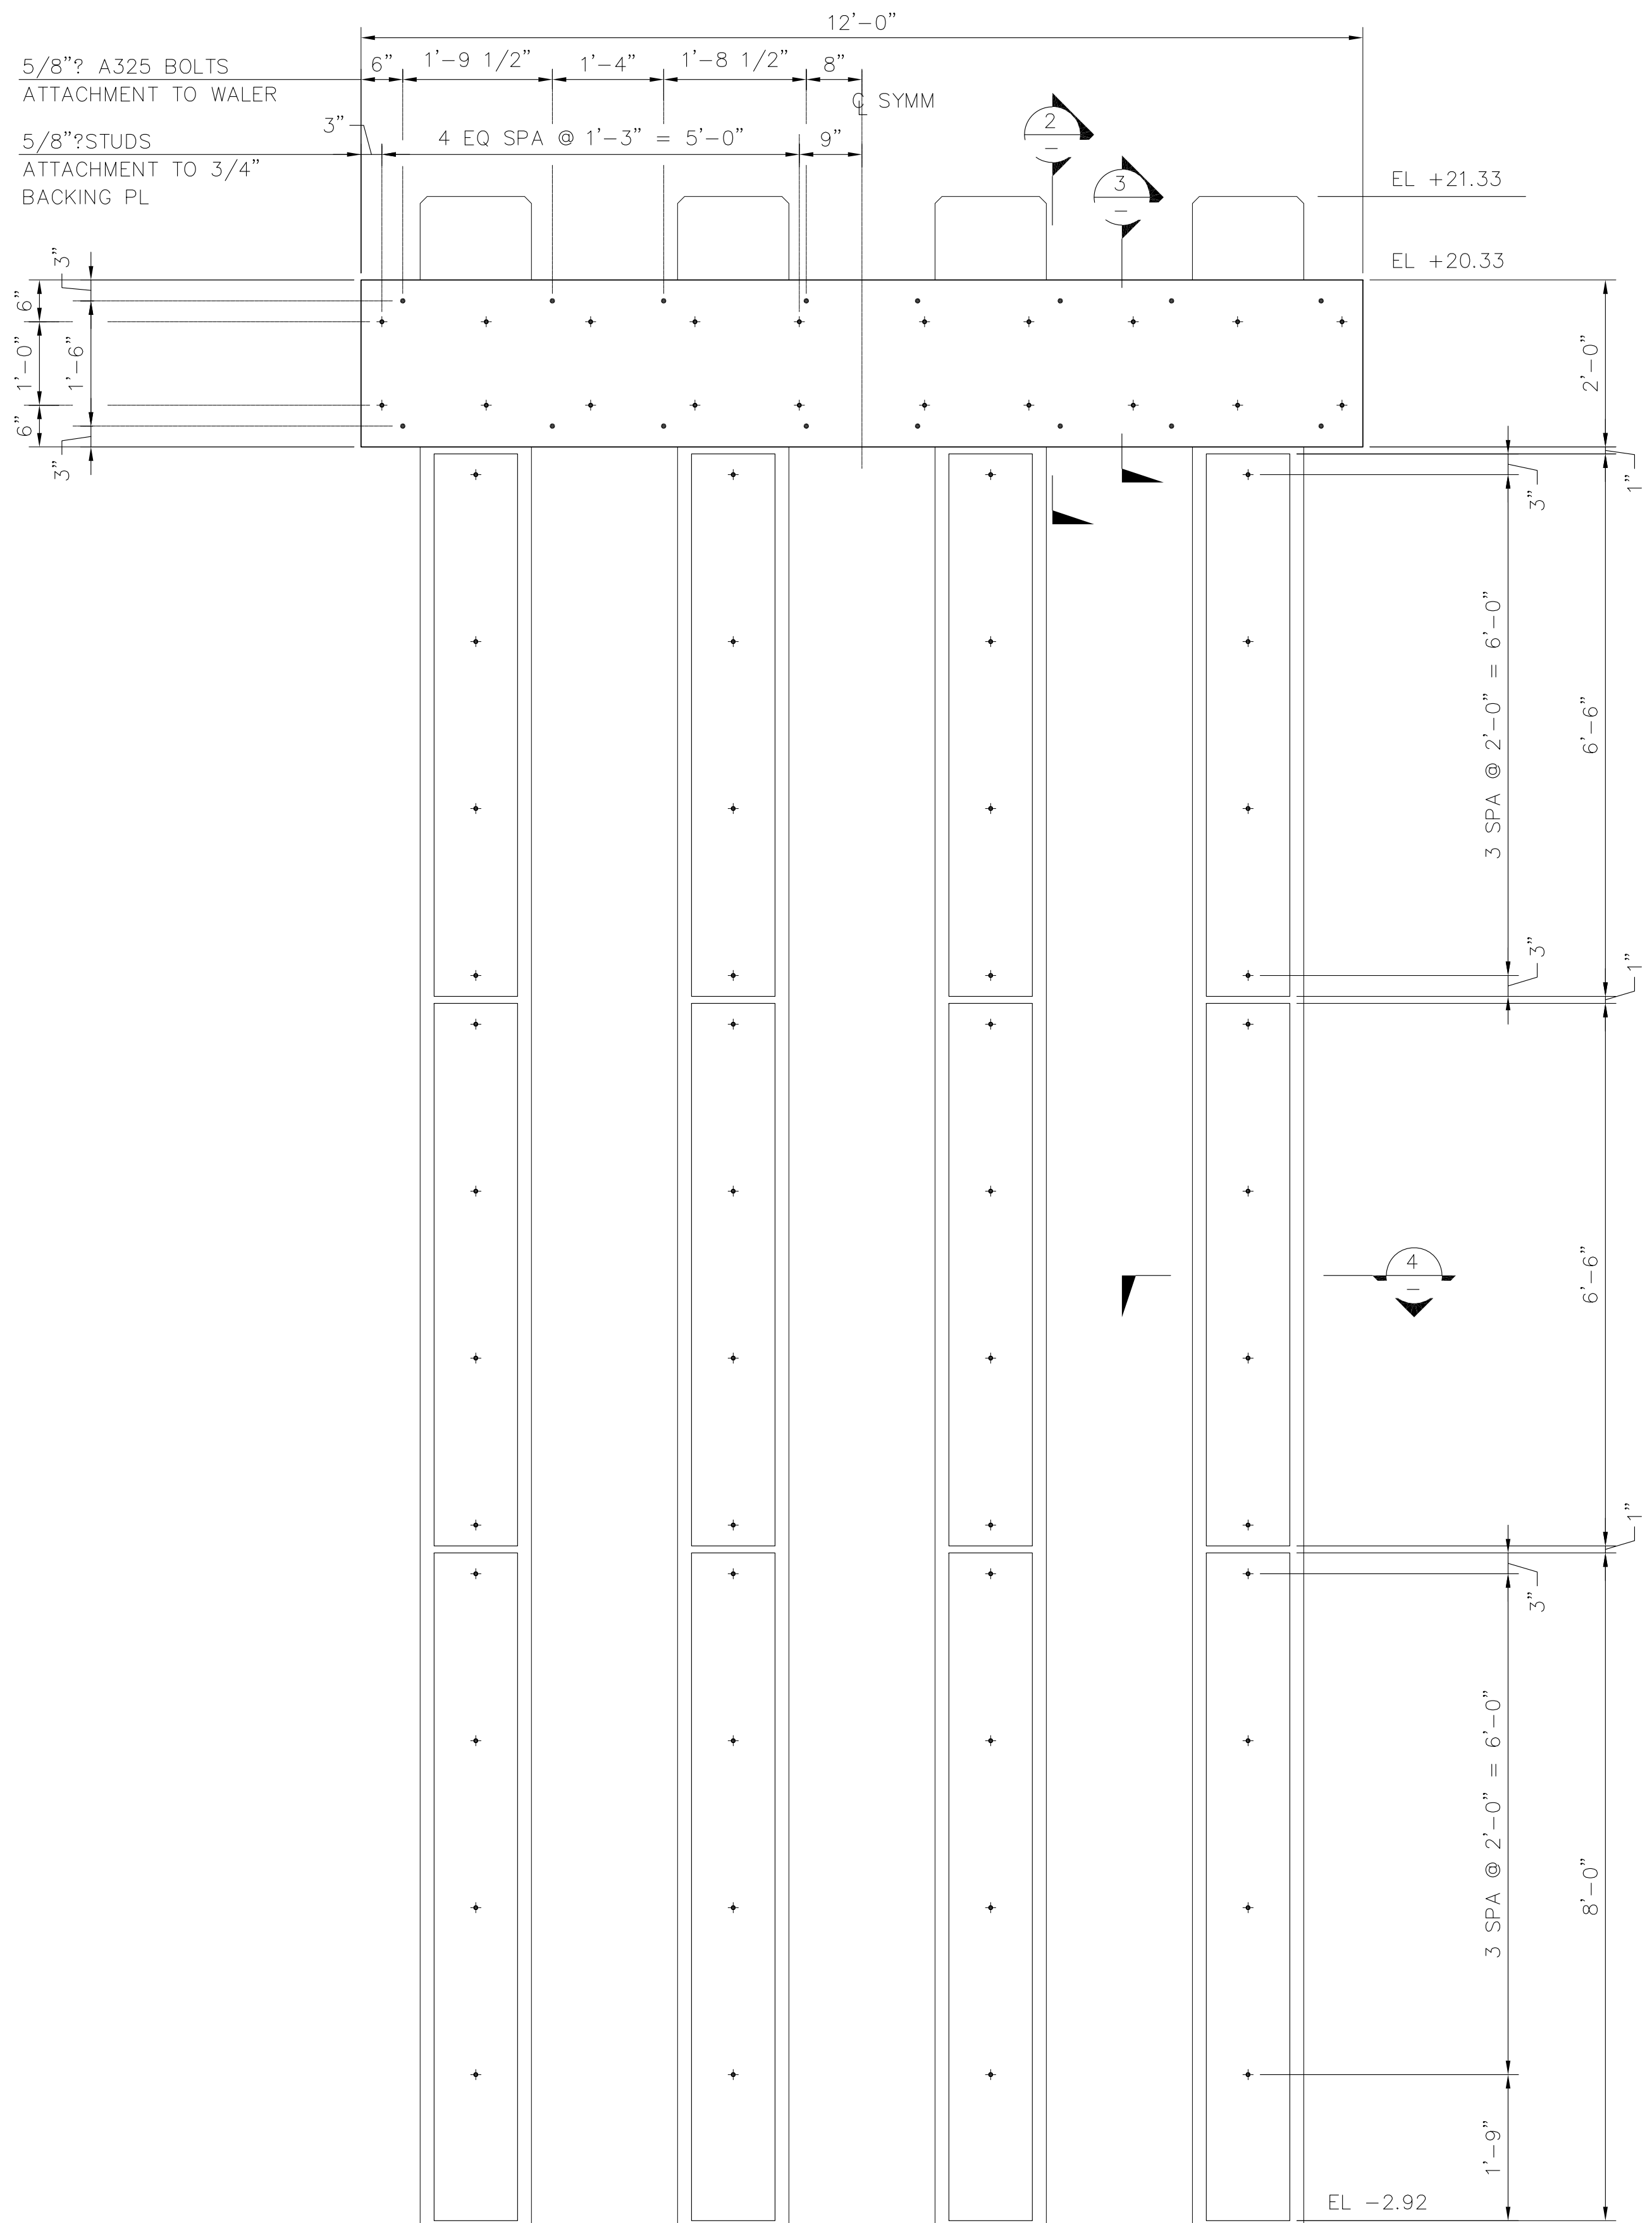


1 ELEVATION - UHMW FACING ON FENDER PANEL & PILES
 S-34 SCALE: 3/4"=1'-0"

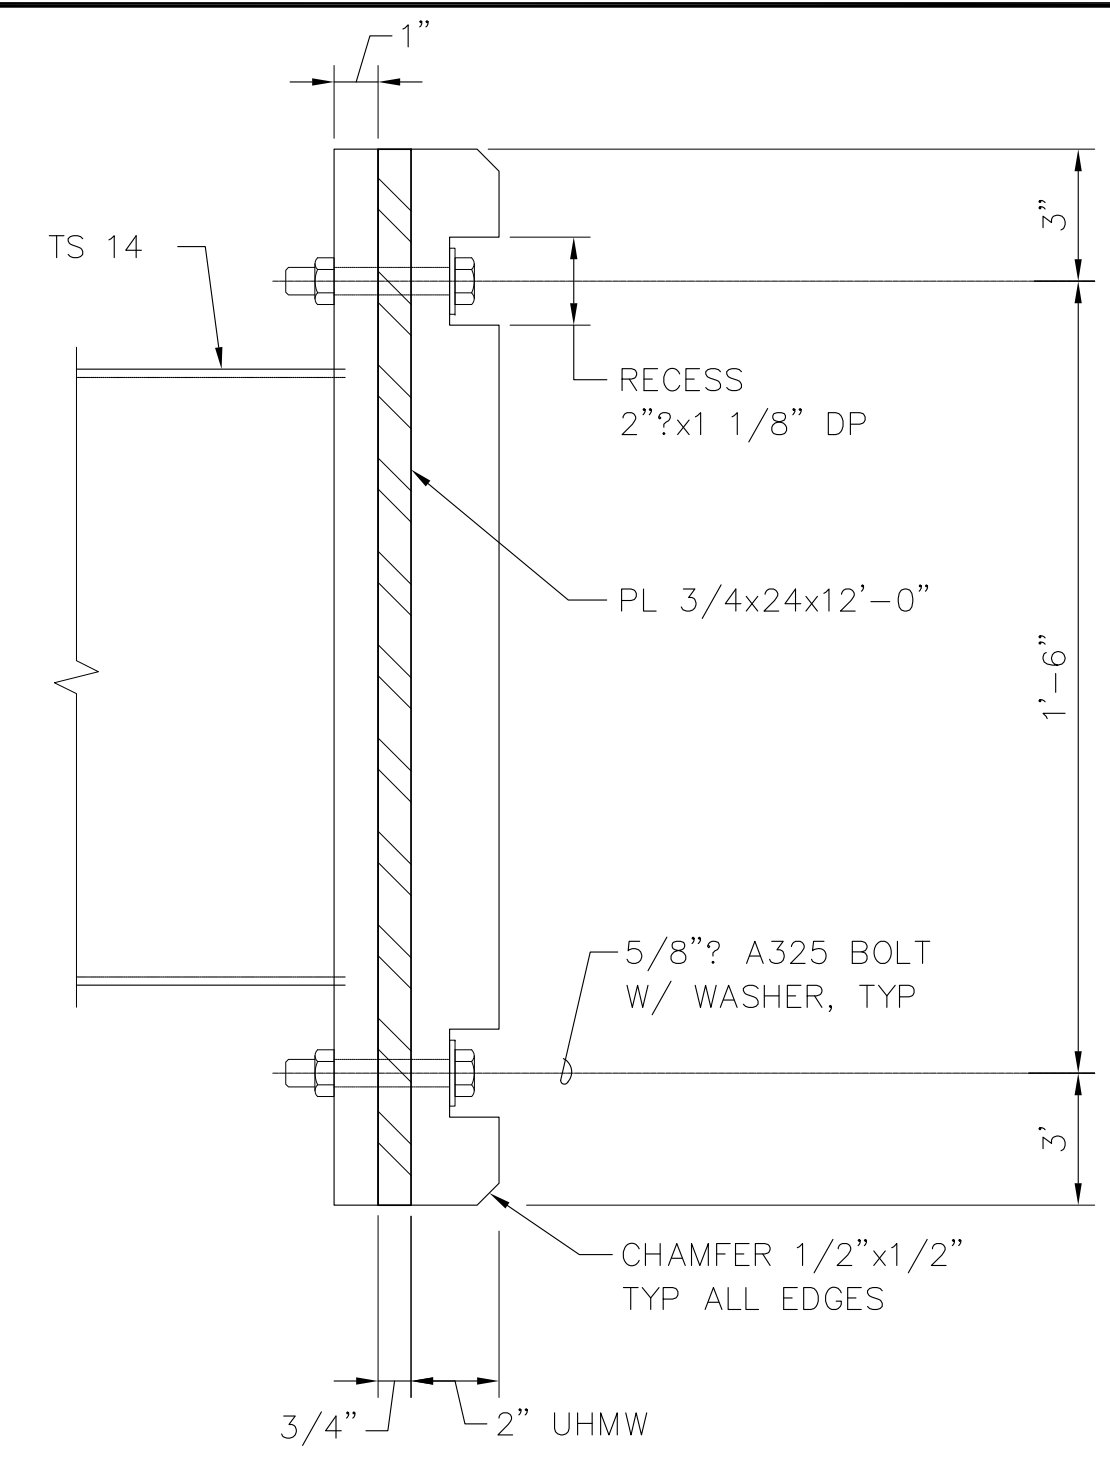


2 SECTION - FENDER PANEL @ TOP
 S-34 SCALE: 3"=1'-0"

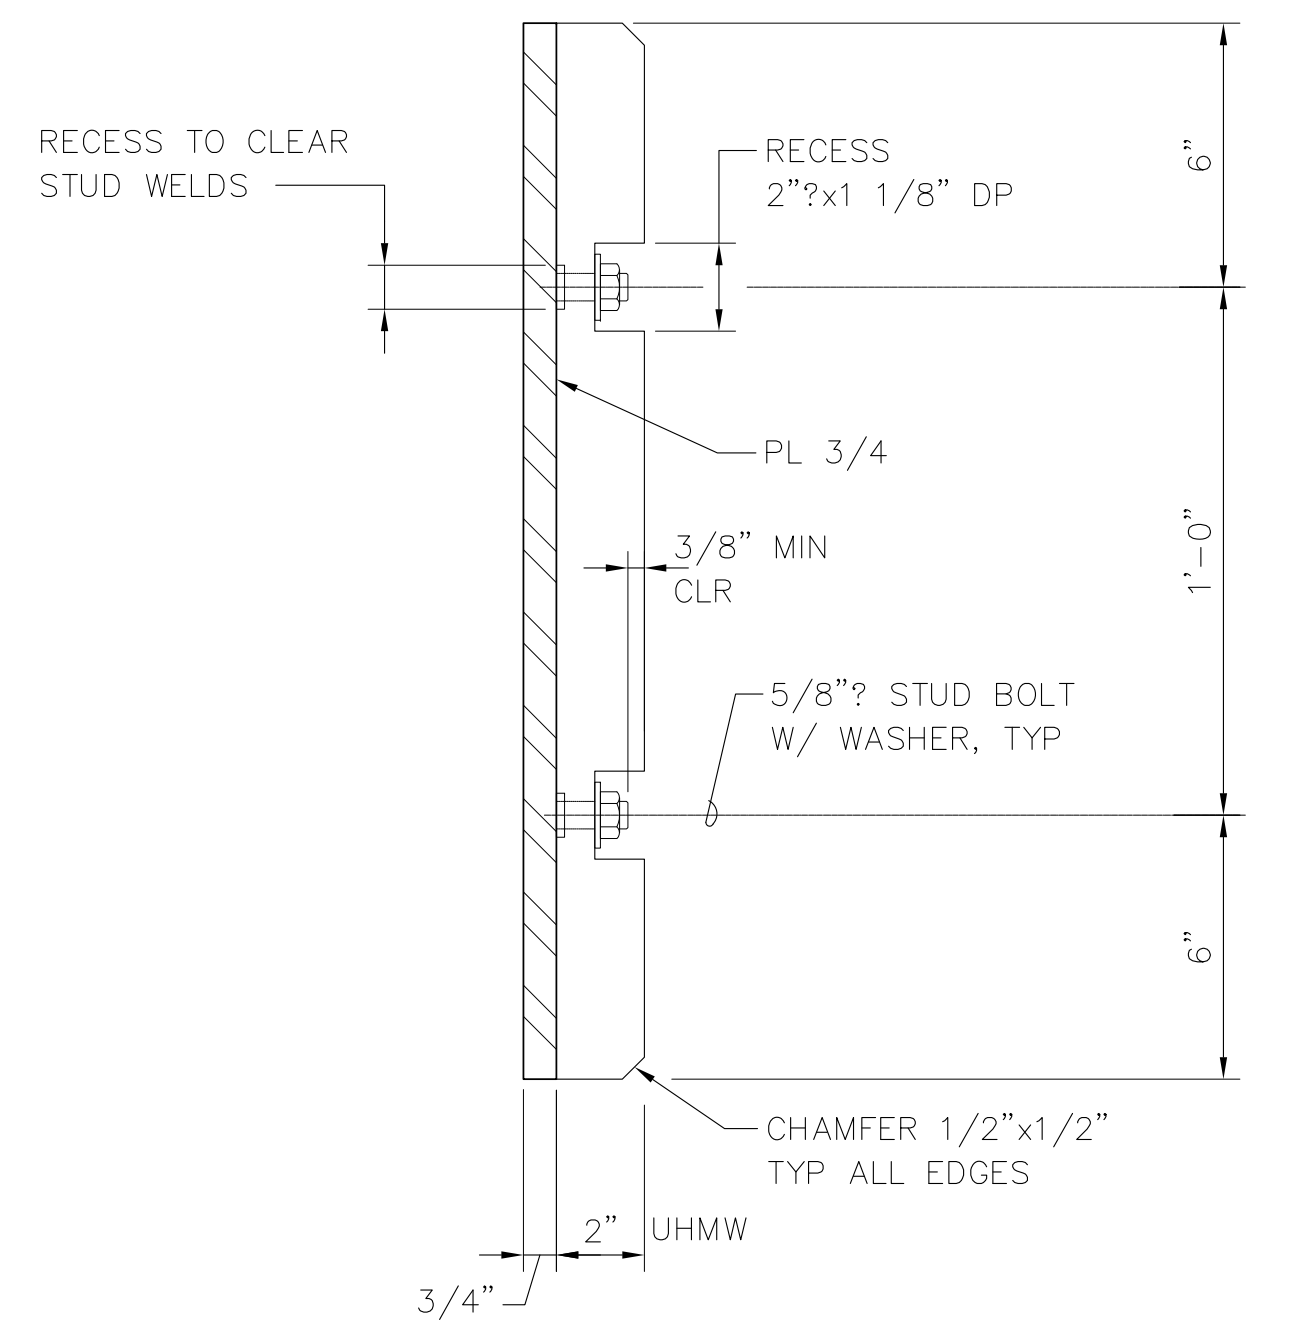

3 SECTION - FENDER PANEL @ TOP
 S-34 SCALE: 3"=1'-0"

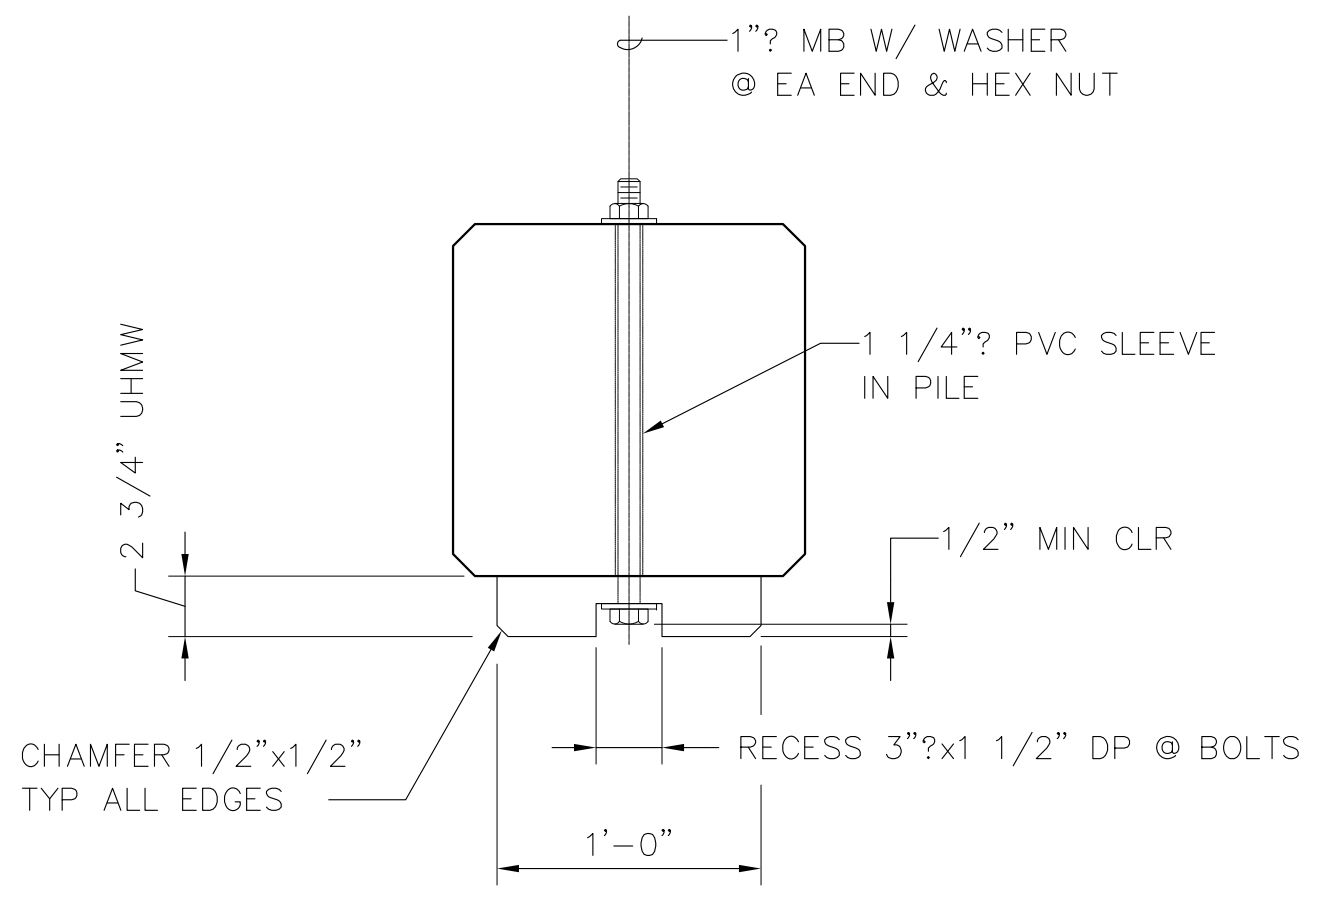

4 SECTION - UHMW ATTACHMENT TO FENDER PILE
 S-34 SCALE: 1 1/2"=1'-0"

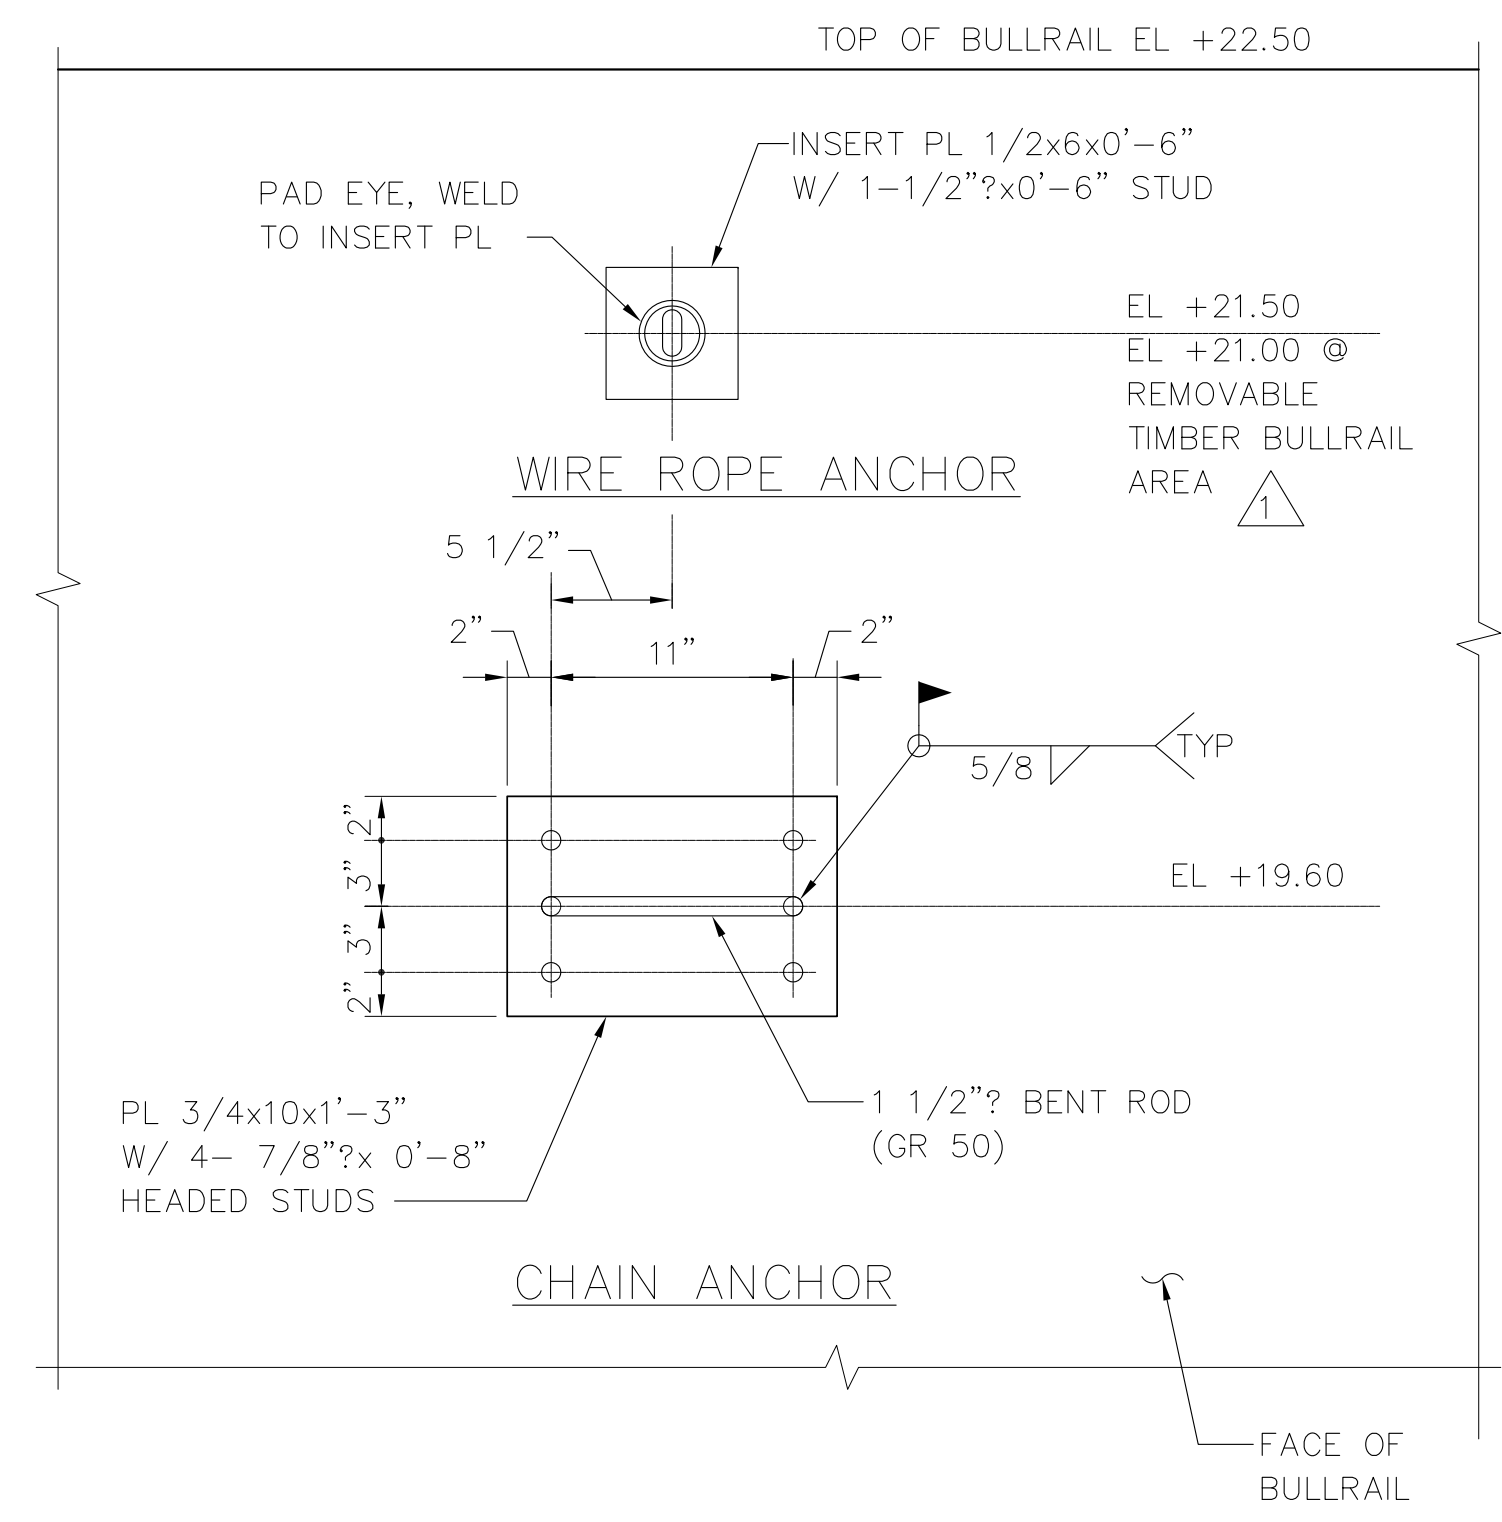

5 ELEVATION - CHAIN AND WIRE ROPE ANCHOR
 S-34 SCALE: 1 1/2"=1'-0"

AS-BUILT

AUTOCAD FILE NO. 5012S34 S-34



PORT OF TACOMA
 P.O. BOX 1837 TACOMA, WASHINGTON 98401
 (206) 383-5841

BERGER/ABAM ENGINEERS INC.
 33301 9TH AVENUE SOUTH
 FEDERAL WAY, WASHINGTON 98003-6395
 (206)431-2300 FAX: (206)431-2250

APPROVED
 DATE
 CURTIS L. RATCLIFFE P.E.
 CHIEF ENGINEER

ETH 9/91
 DRAWN BY DATE
 DESIGNED BY DATE


BCM 9/91
 CHECKED BY DATE
 JAS 9/91
 PROJ ENGR DATE

MARK	REVISION	BY	APP.	DATE
AS-BUILT		RDD	JAS	1/4/99


HYUNDAI MERCHANT MARINE TERMINAL WHARF
 PORT OF TACOMA
 FENDER SYSTEM DETAILS - SHEET 2

DRAWING NO. EP-5012-26
 CONTRACT NO. 978038
 SHEET NO. 45 OF 58


Last Saved on Tue Jun 10 2008 at 11:31AM by Lorechin File Name: G:\2008\FAWA-08-121\CADD\497091\5012S34.dwg Scale: 1

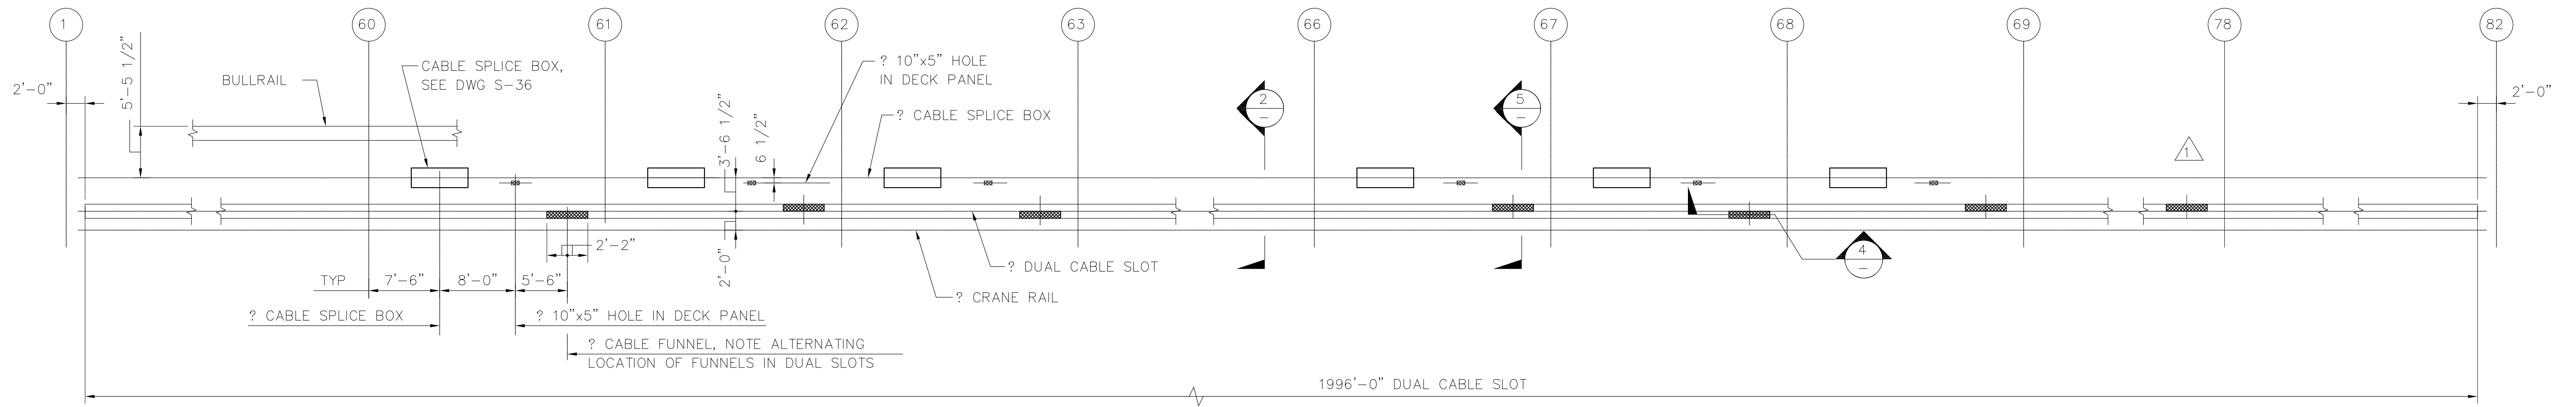


1
S-35 PLAN - CABLE SLOT AND CABLE SPLICE BOXES
SCALE: 1/8"=1'-0"

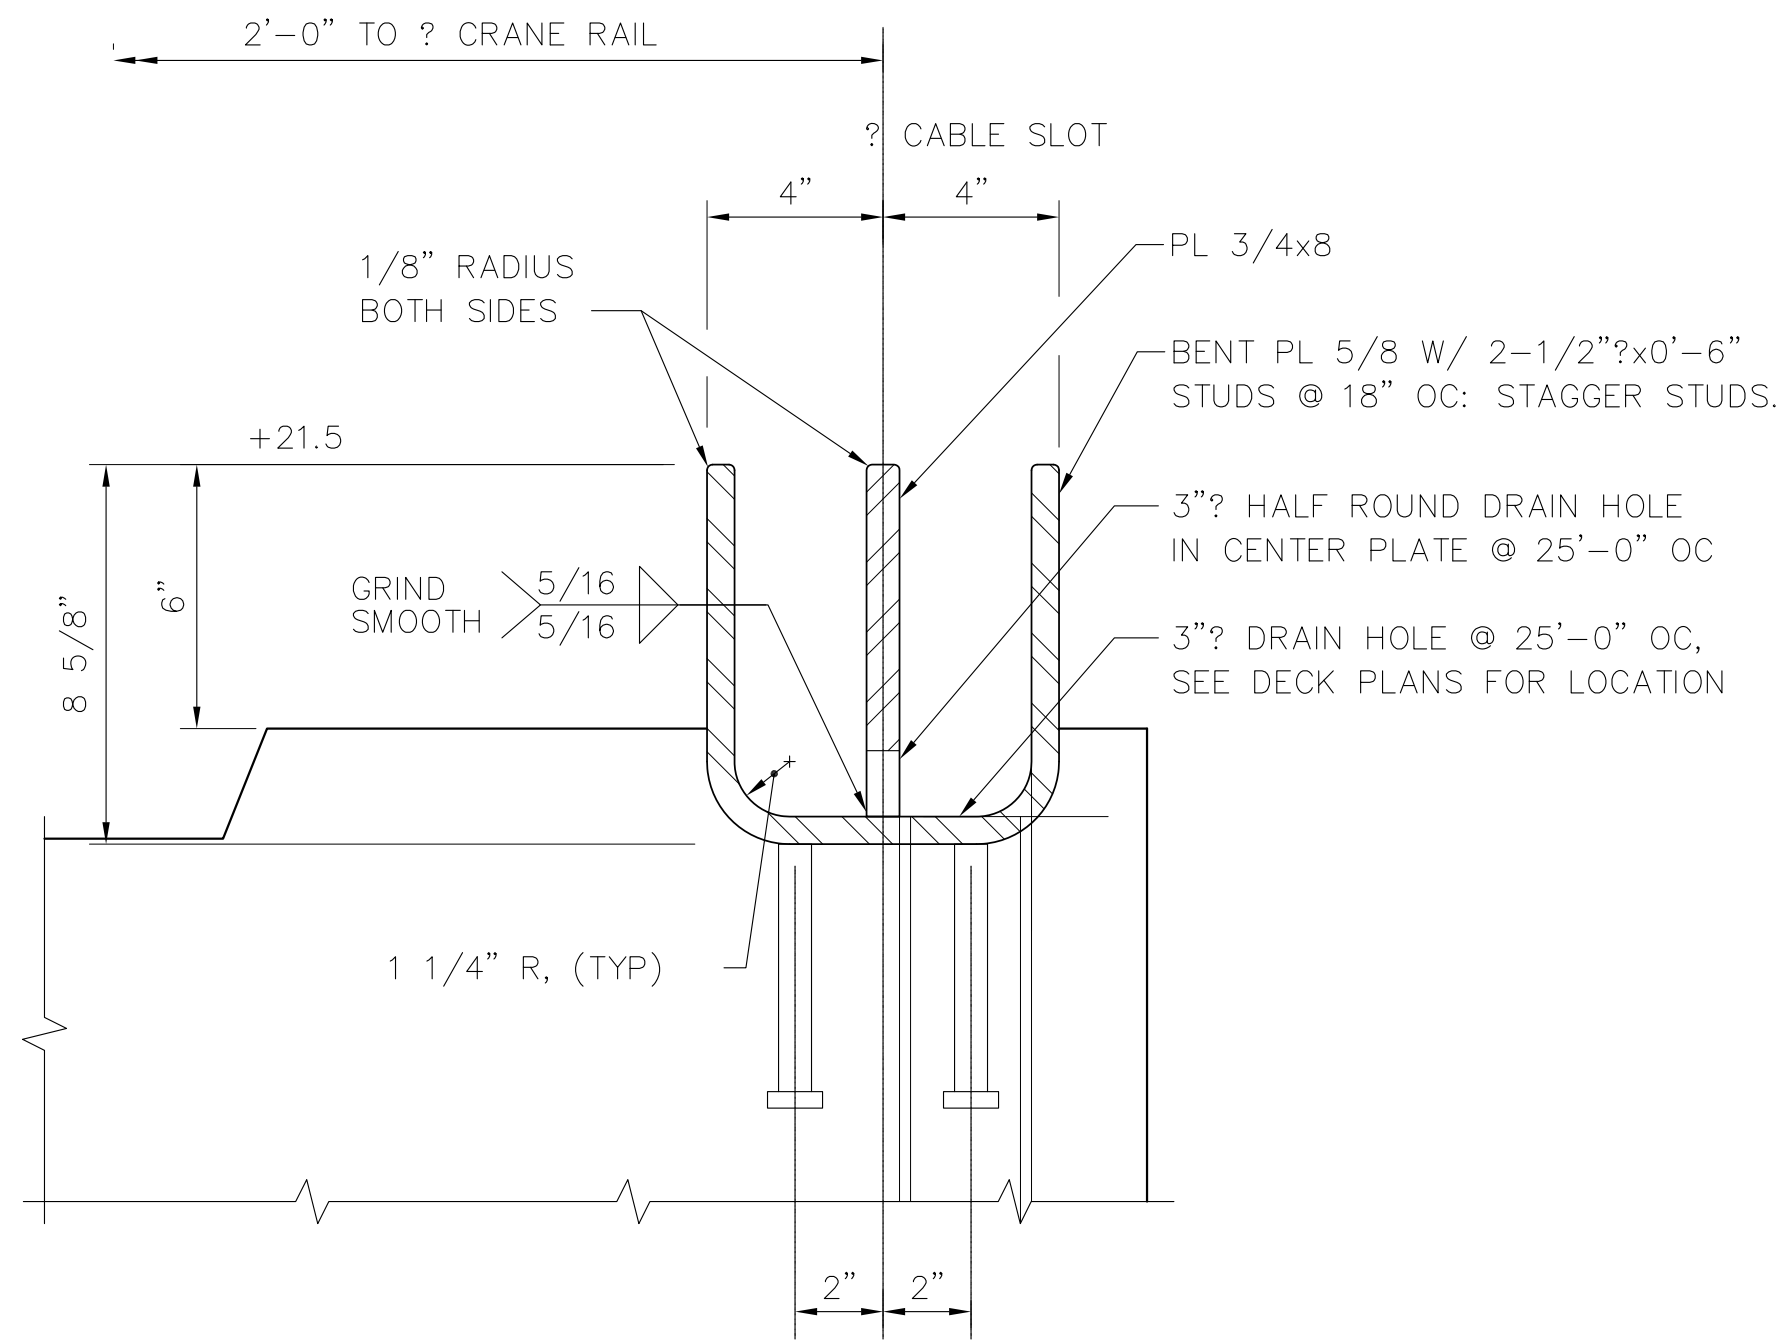


2
S-35 SECTION - DUAL CABLE SLOT
SCALE: 3"=1'-0"

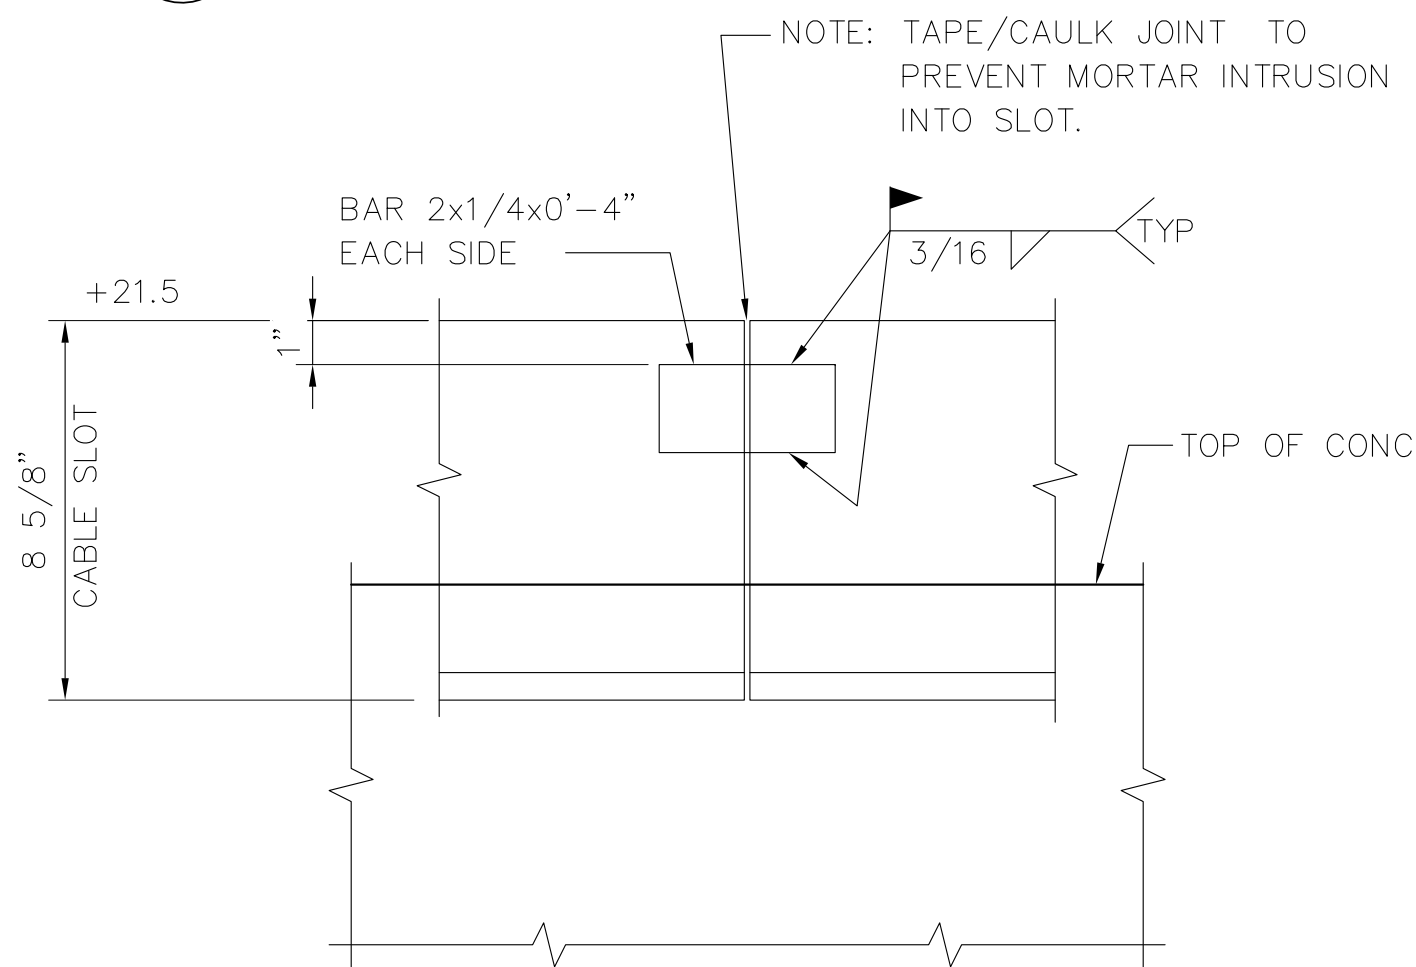

3
S-35 ELEVATION - CABLE SLOT @ SPLICE
SCALE: 3"=1'-0"

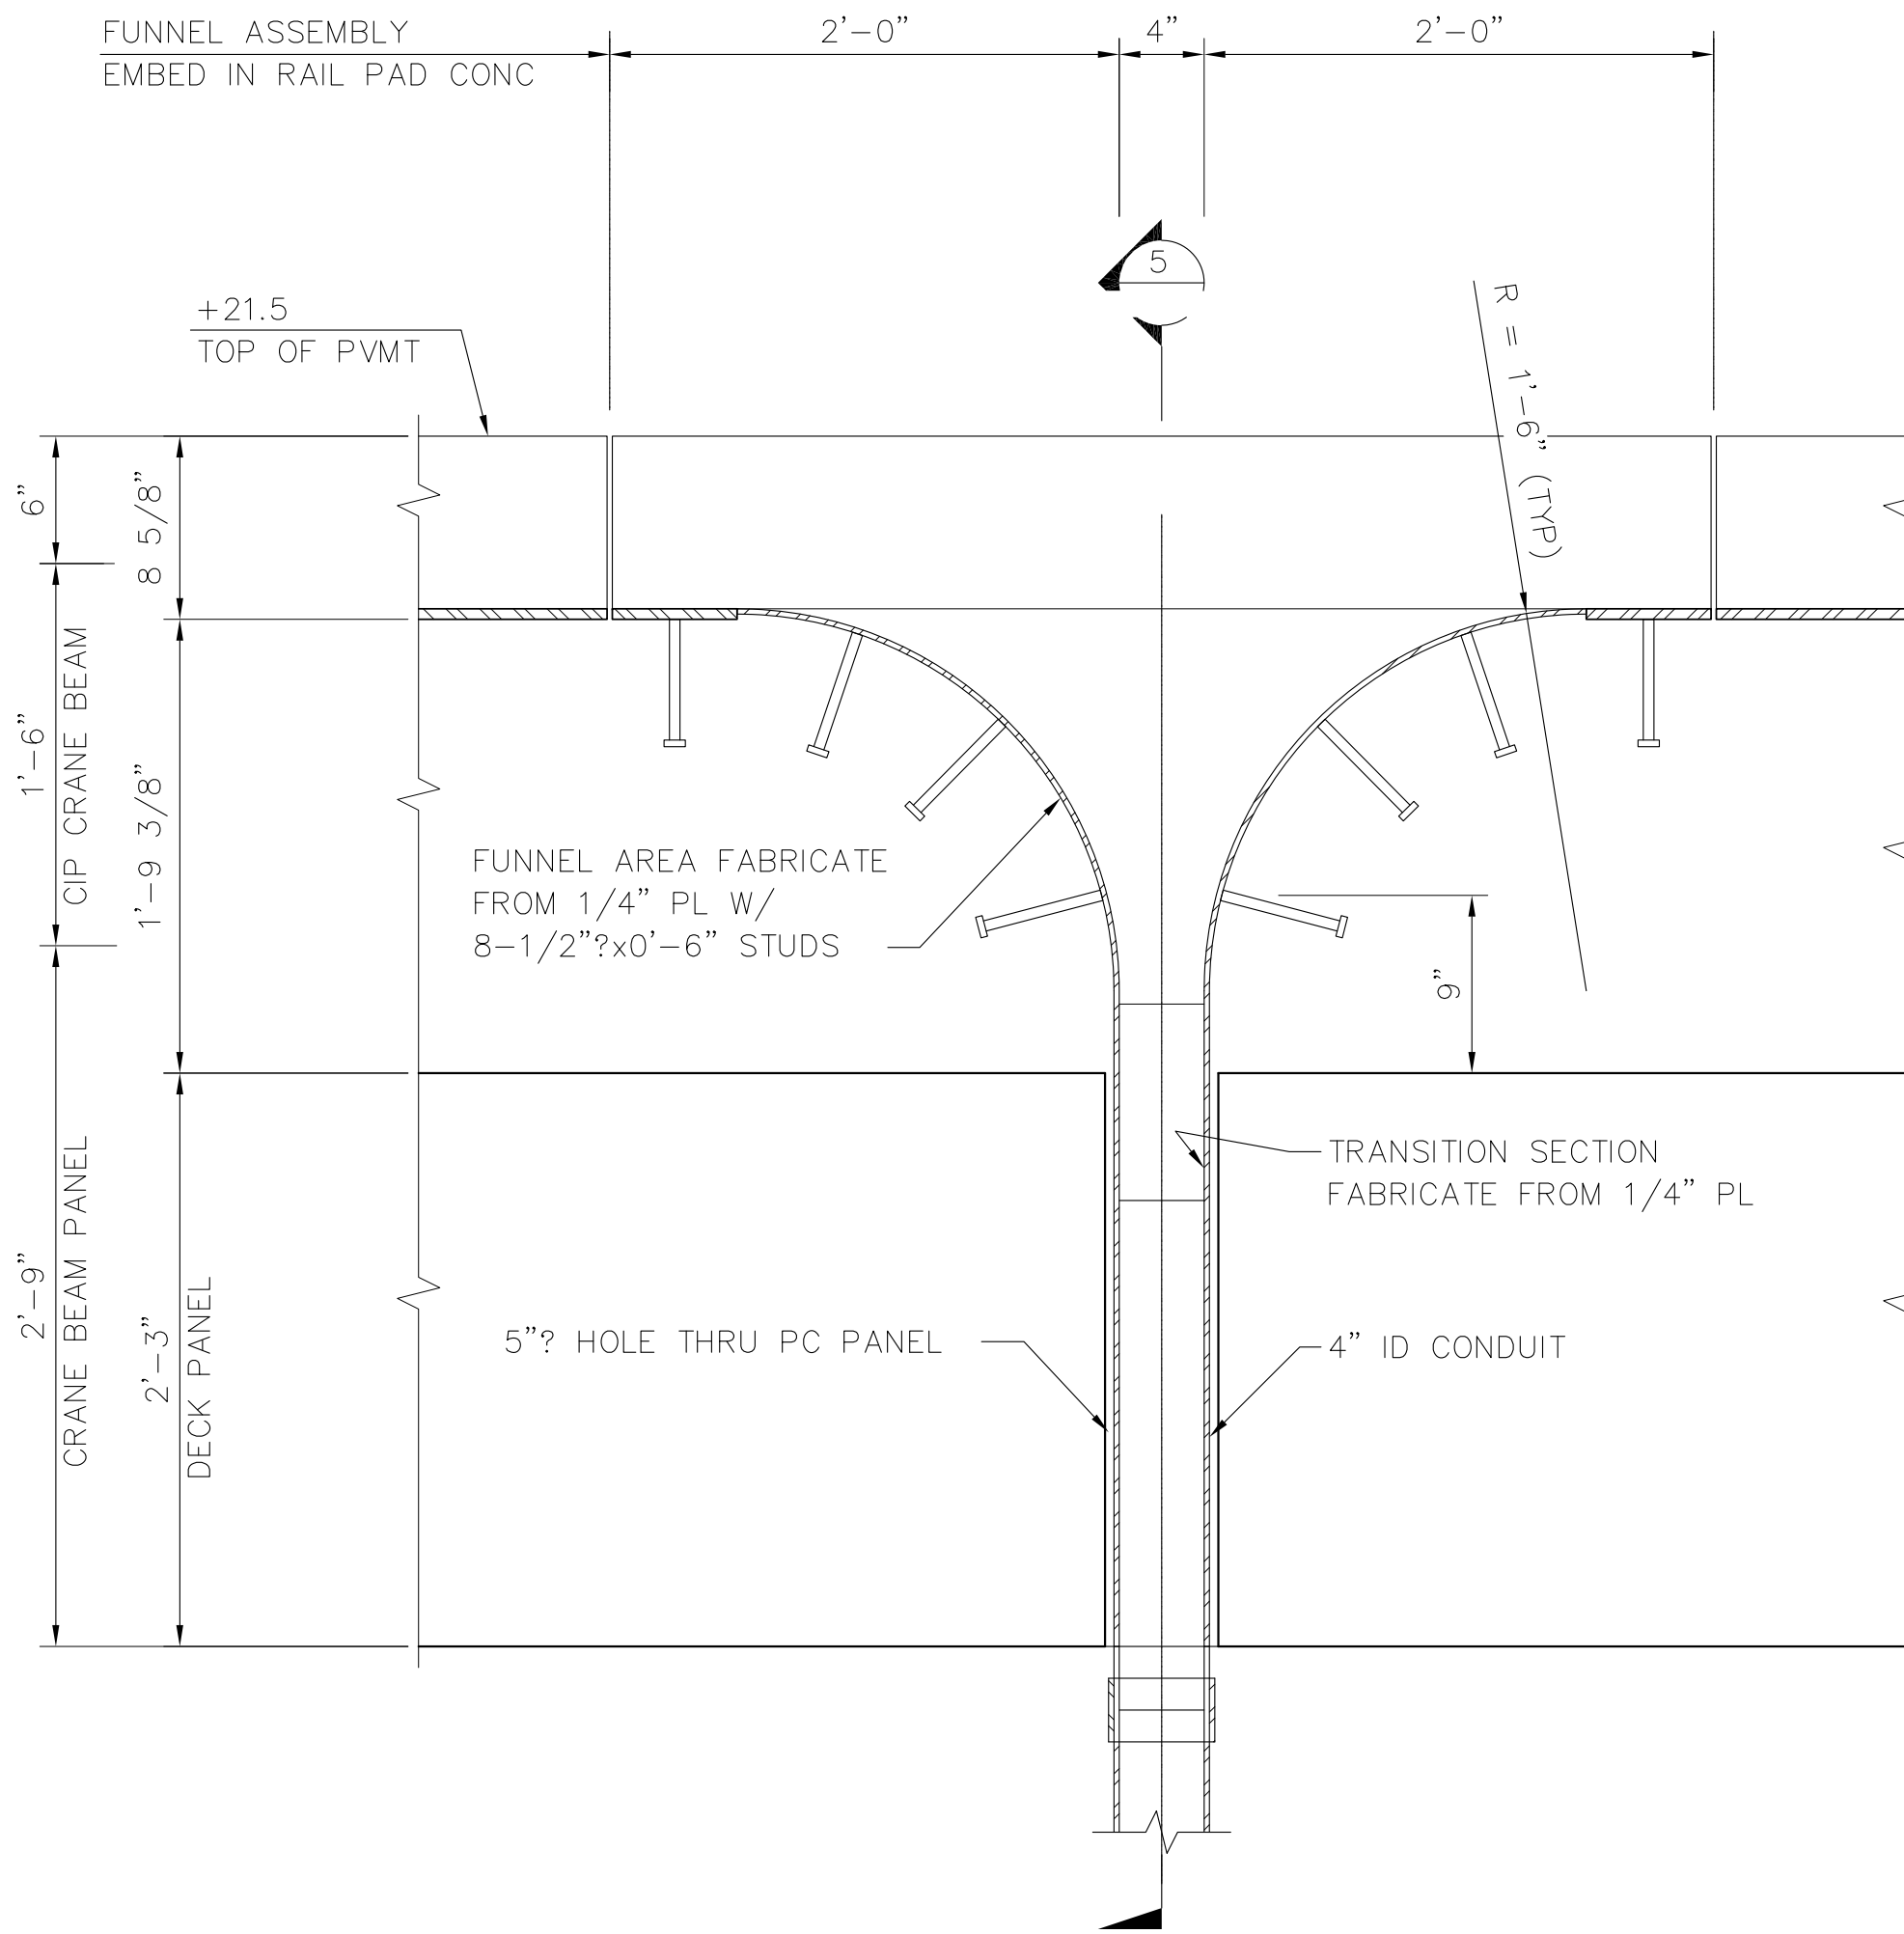

4
S-35 SECTION - CABLE FUNNEL
SCALE: 1 1/2"=1'-0"

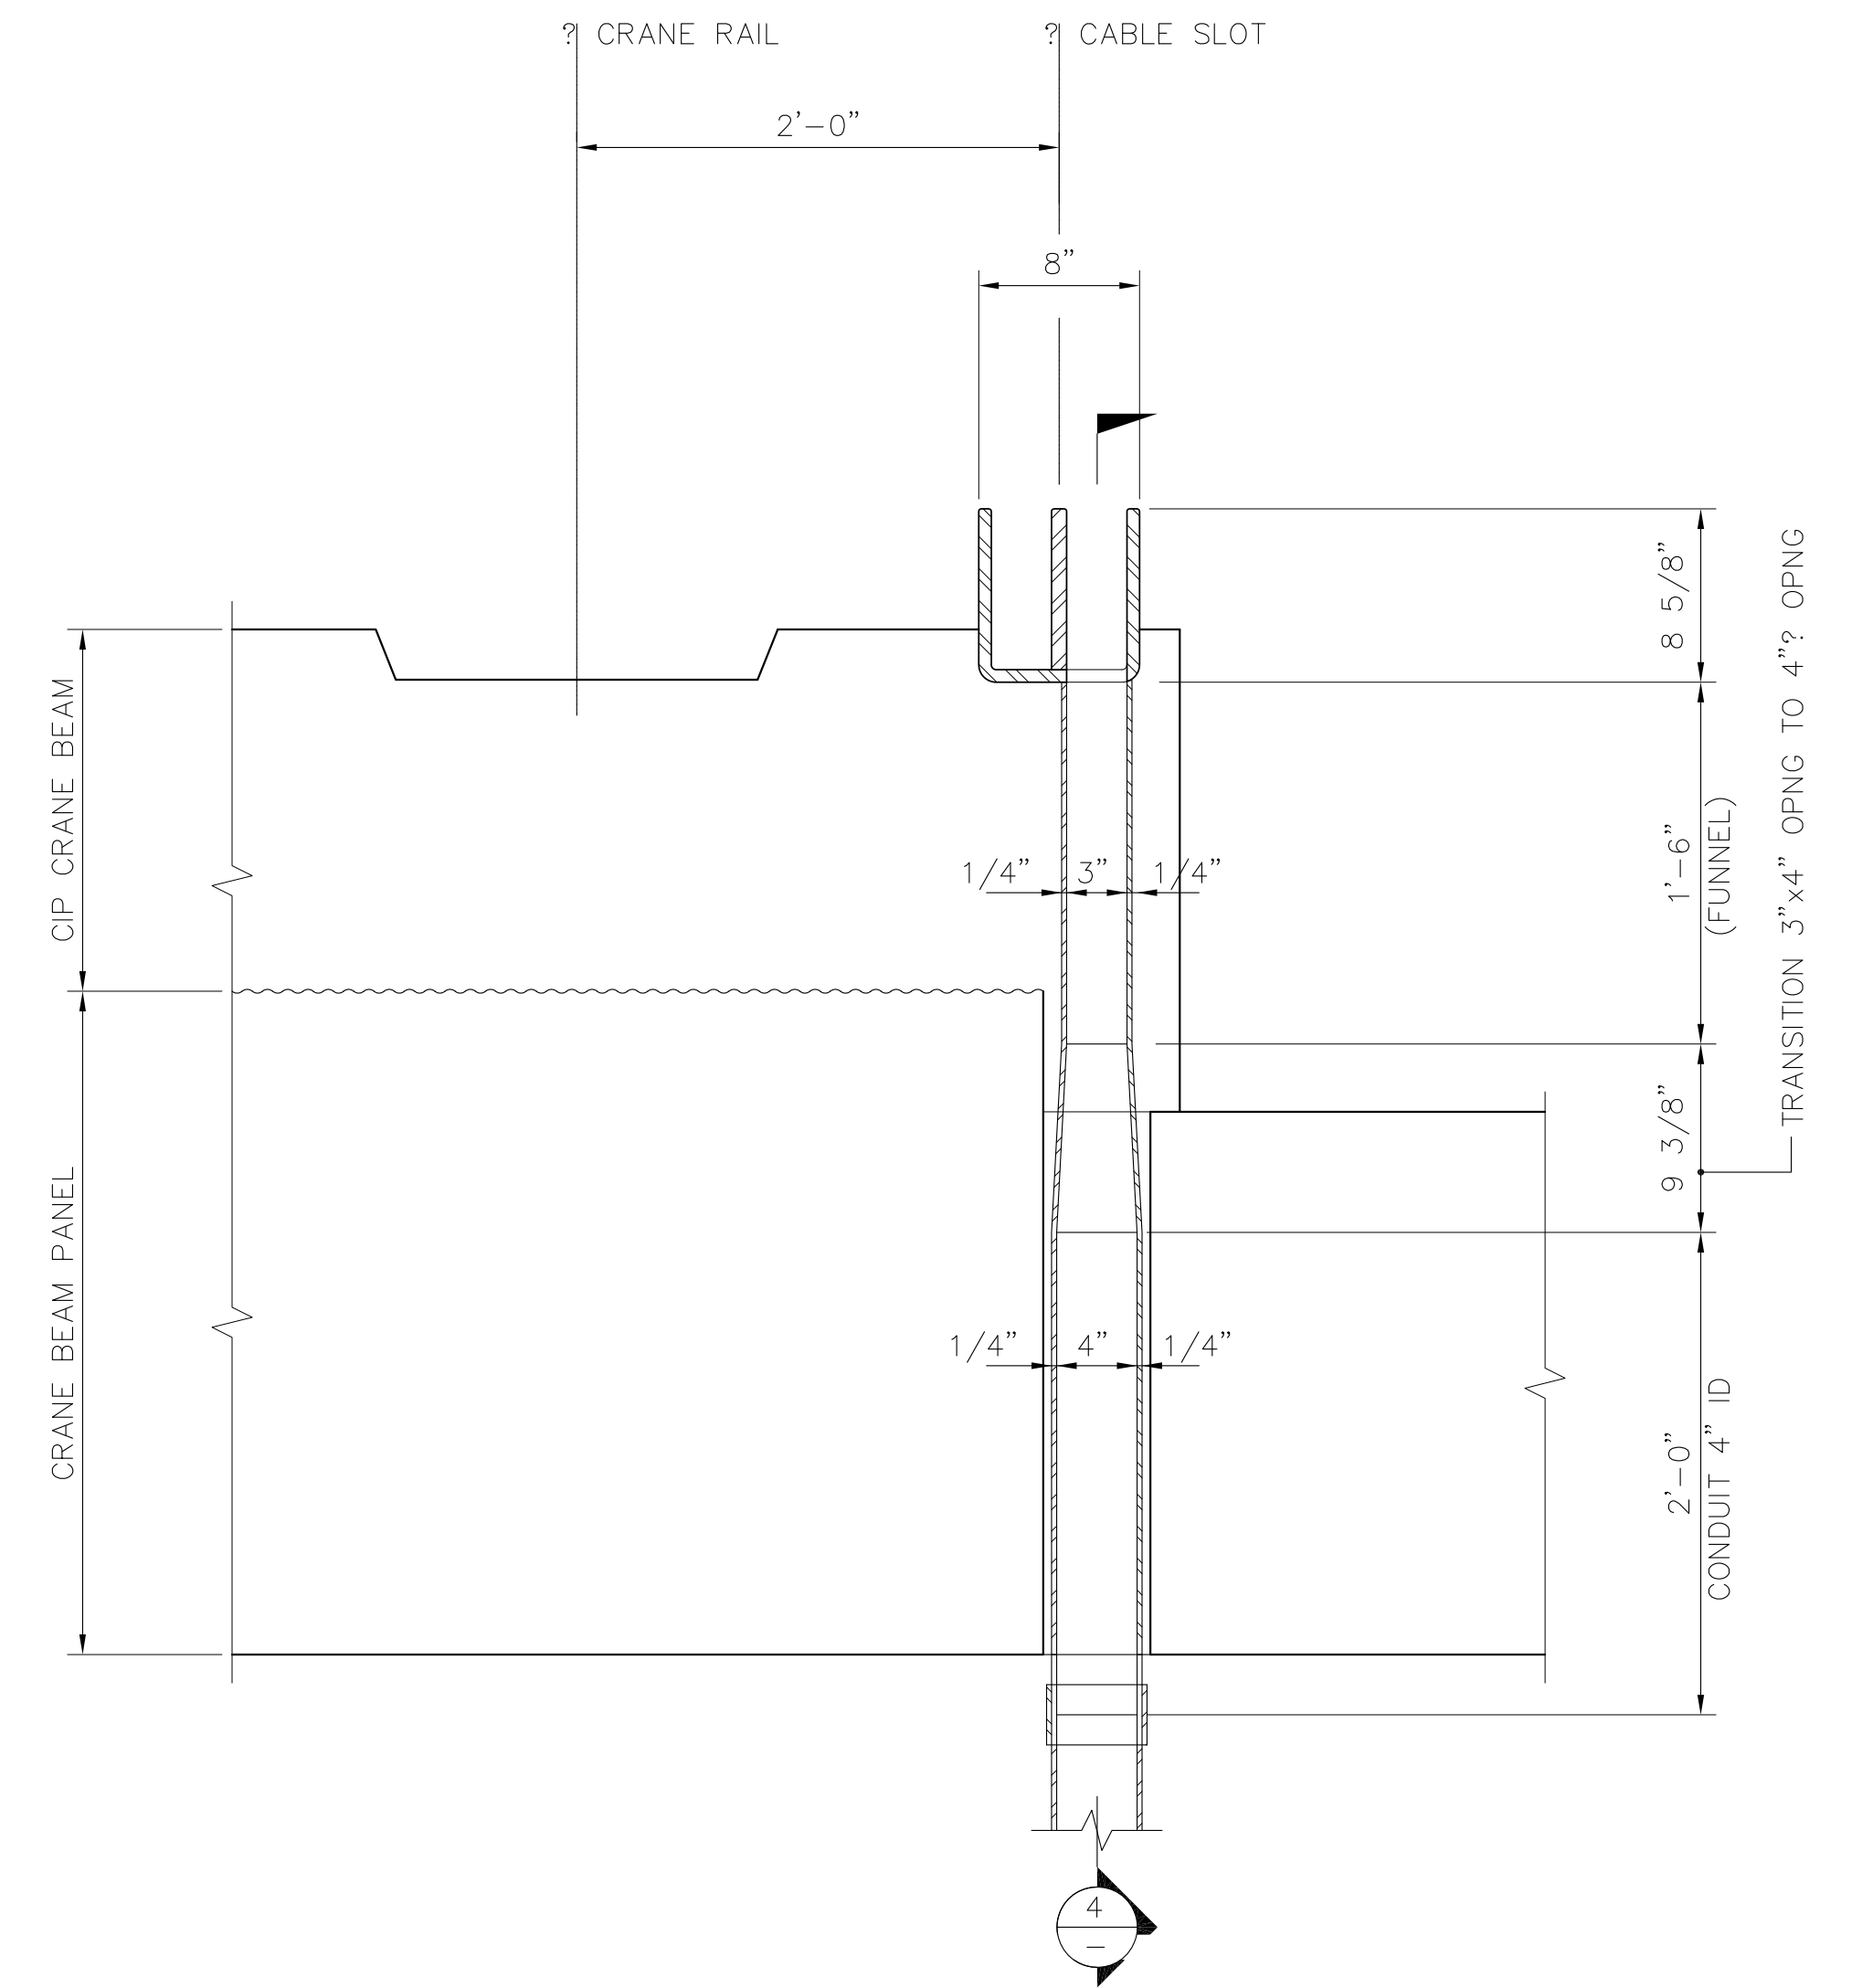

5
S-35 SECTION - CABLE FUNNEL
SCALE: 1 1/2"=1'-0"

AS-BUILT

AUTOCAD FILE NO.
5012S35

S-35



PORT OF TACOMA
P.O. BOX 1837 TACOMA, WASHINGTON 98401
(206) 383-5841

BERGER/ABAM
ENGINEERS INC.
33301 9TH AVENUE SOUTH
FEDERAL WAY, WASHINGTON 98003-6395
(206)431-2300 FAX: (206)431-2250

APPROVED

CURTIS L. RATCLIFFE P.E.
CHIEF ENGINEER

ETH
DRAWN BY DATE

DESIGNED BY DATE

BCM
CHECKED BY DATE

PROJ ENGR DATE


JAS
DATE

DATE


MARK	REVISION	BY	APP.	DATE

HYUNDAI MERCHANT MARINE TERMINAL
WHARF
PORT OF TACOMA
CABLE SLOT DETAILS


DRAWING NO. EP-5012-26
CONTRACT NO. 978038
SHEET NO. 46 OF 58

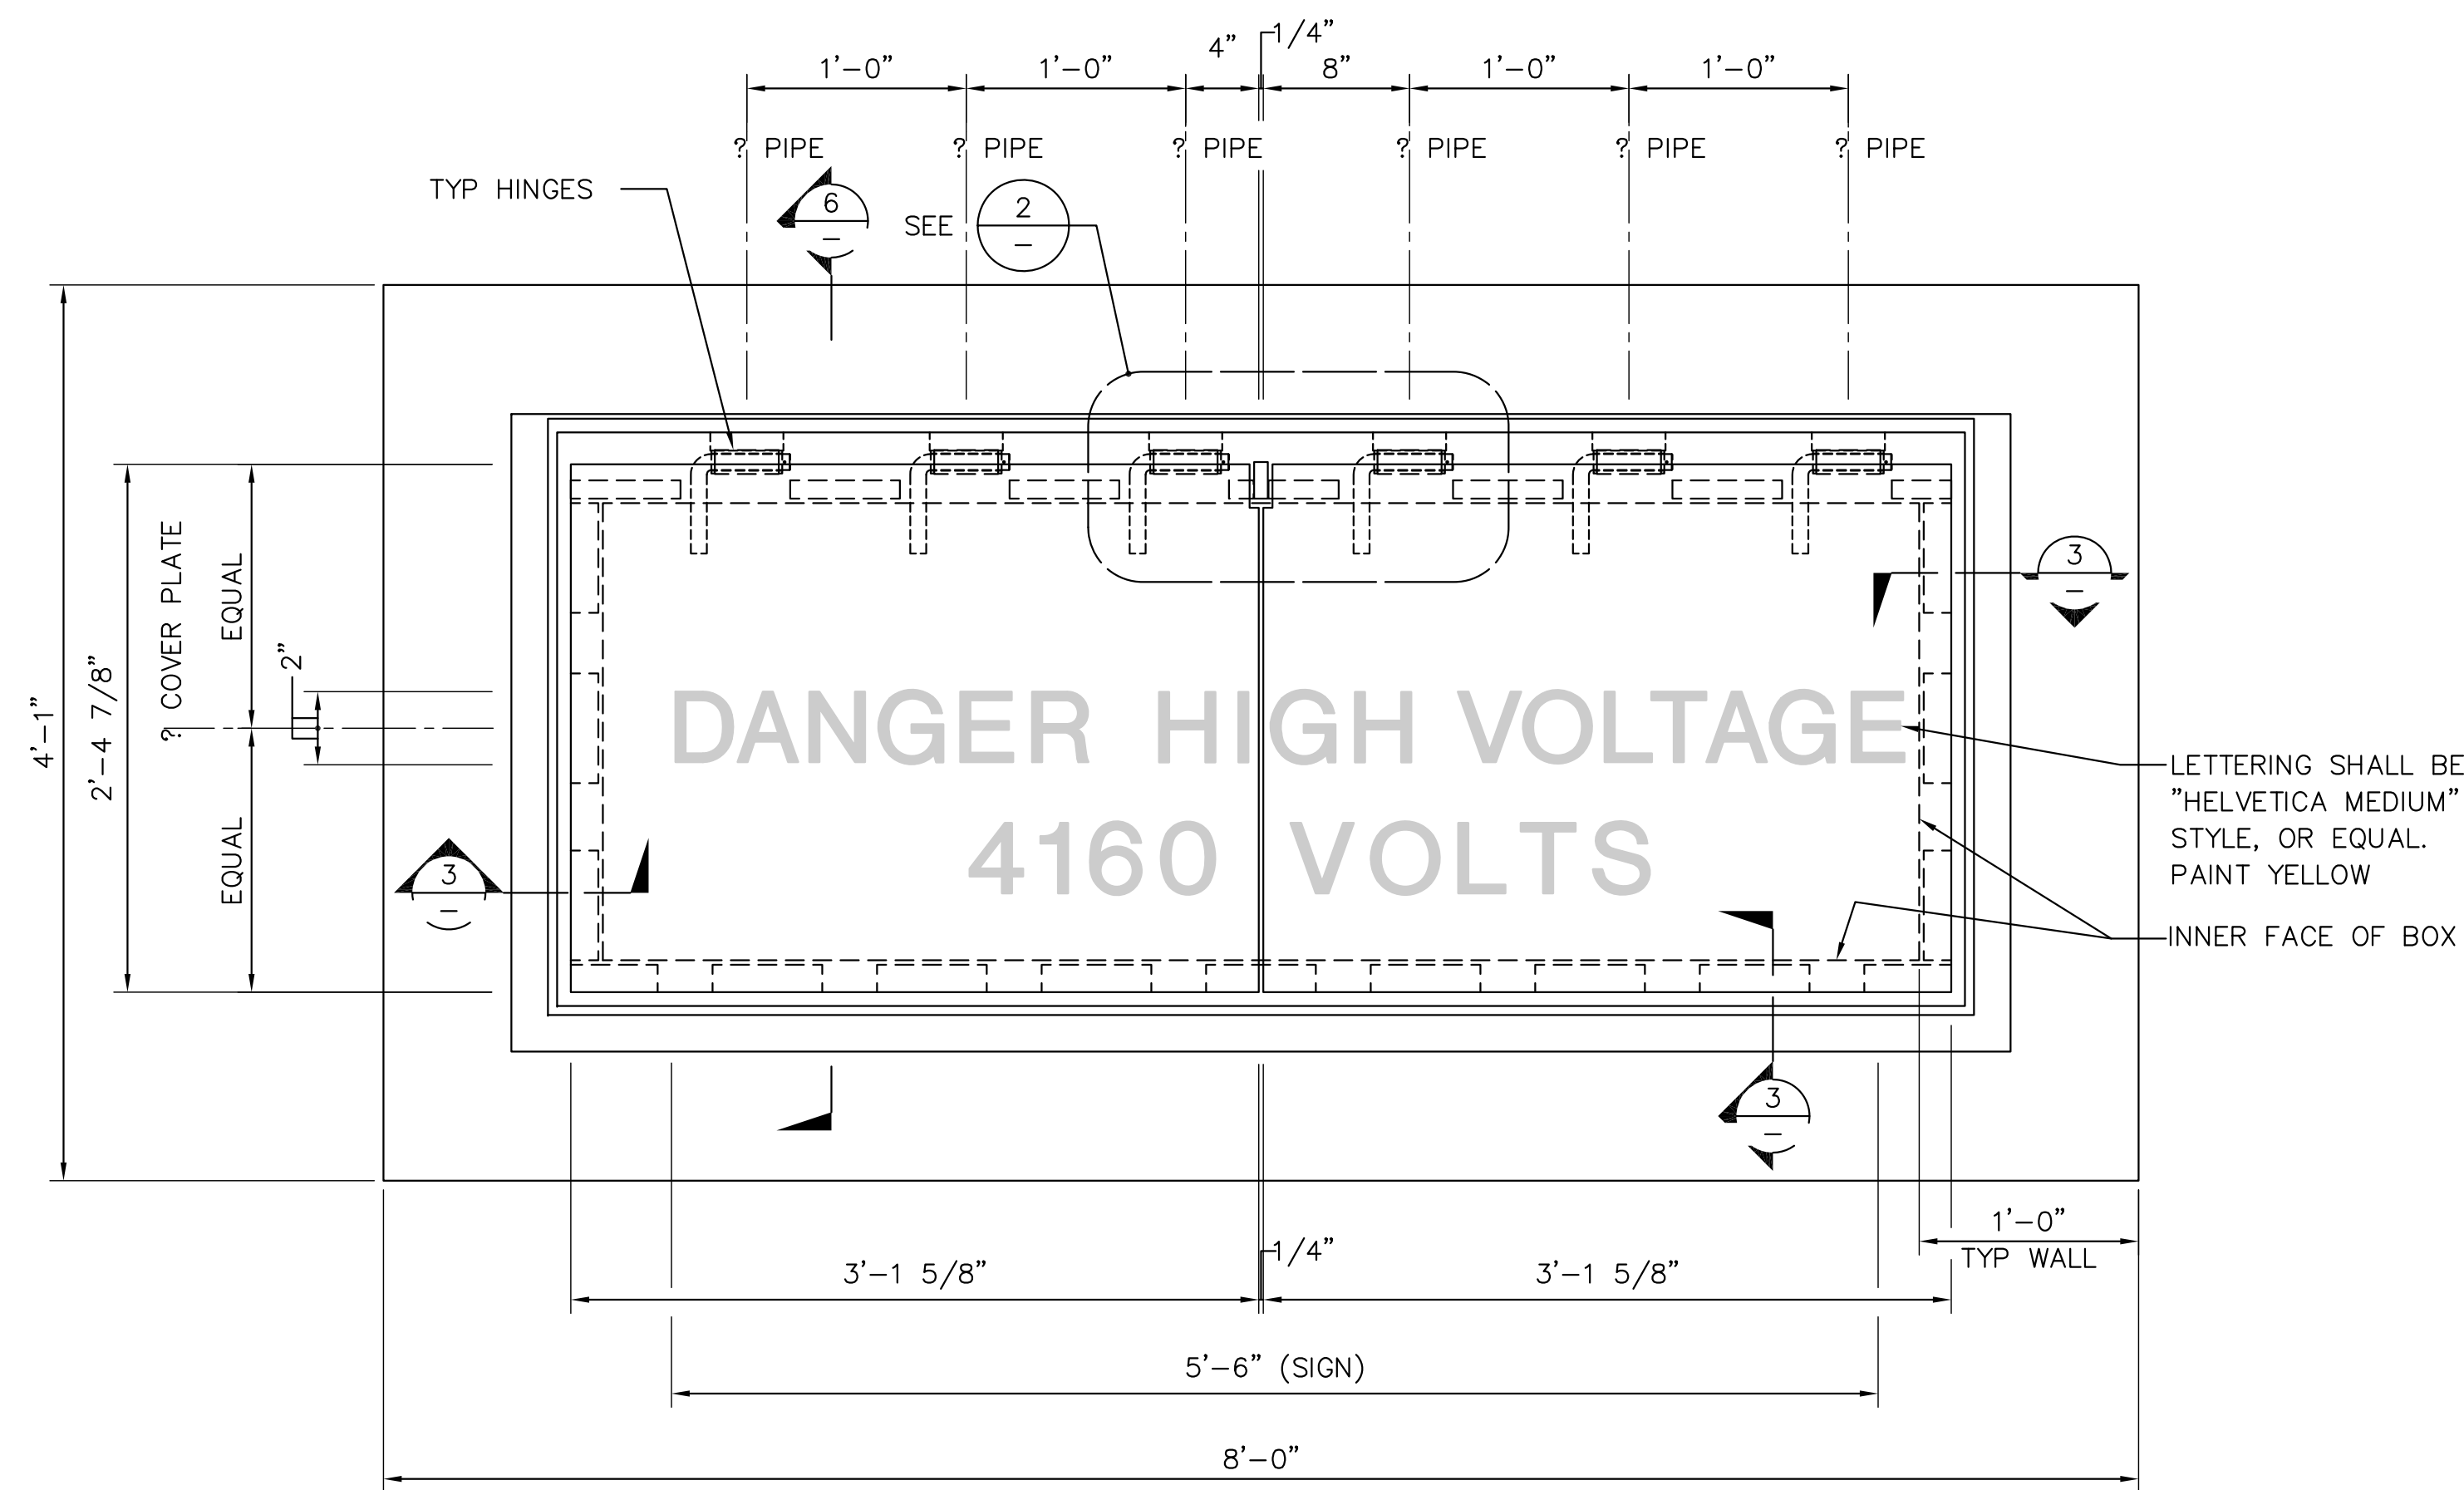

1 PLAN - CABLE SPLICE BOX COVER
SCALE: 1 1/2"=1'-0"

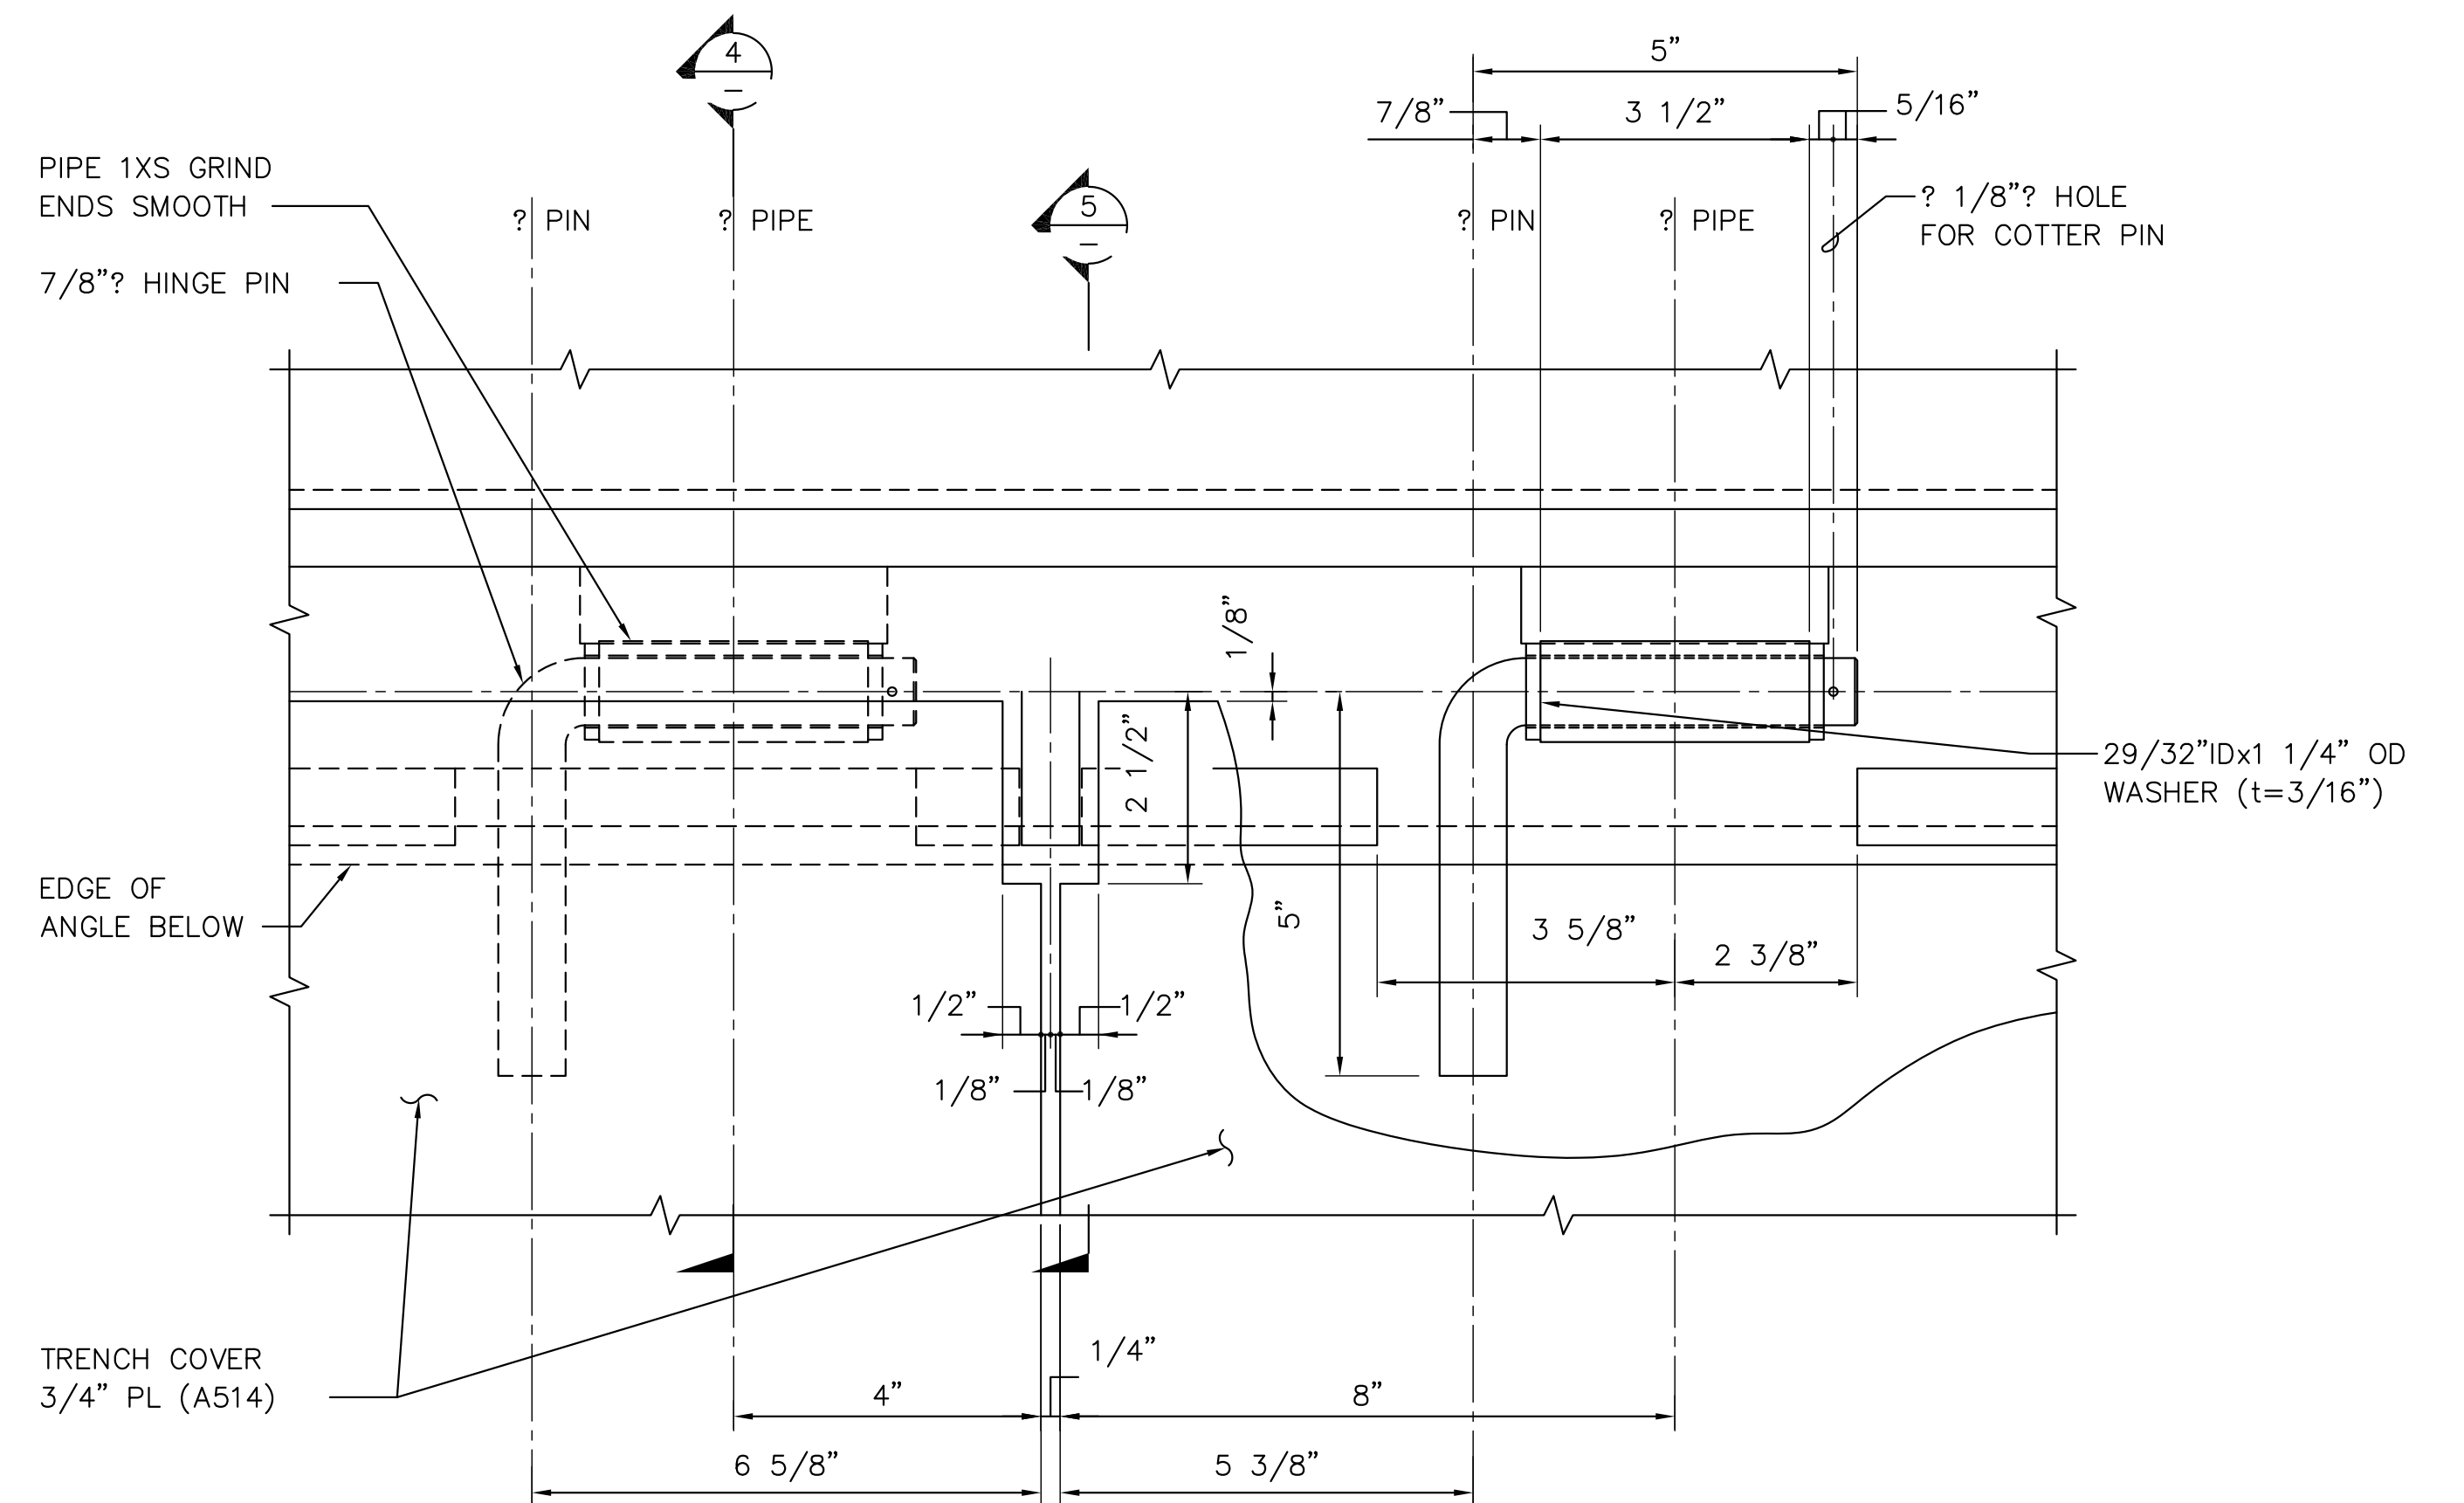


2 DETAIL
SCALE: 6"=1'-0"

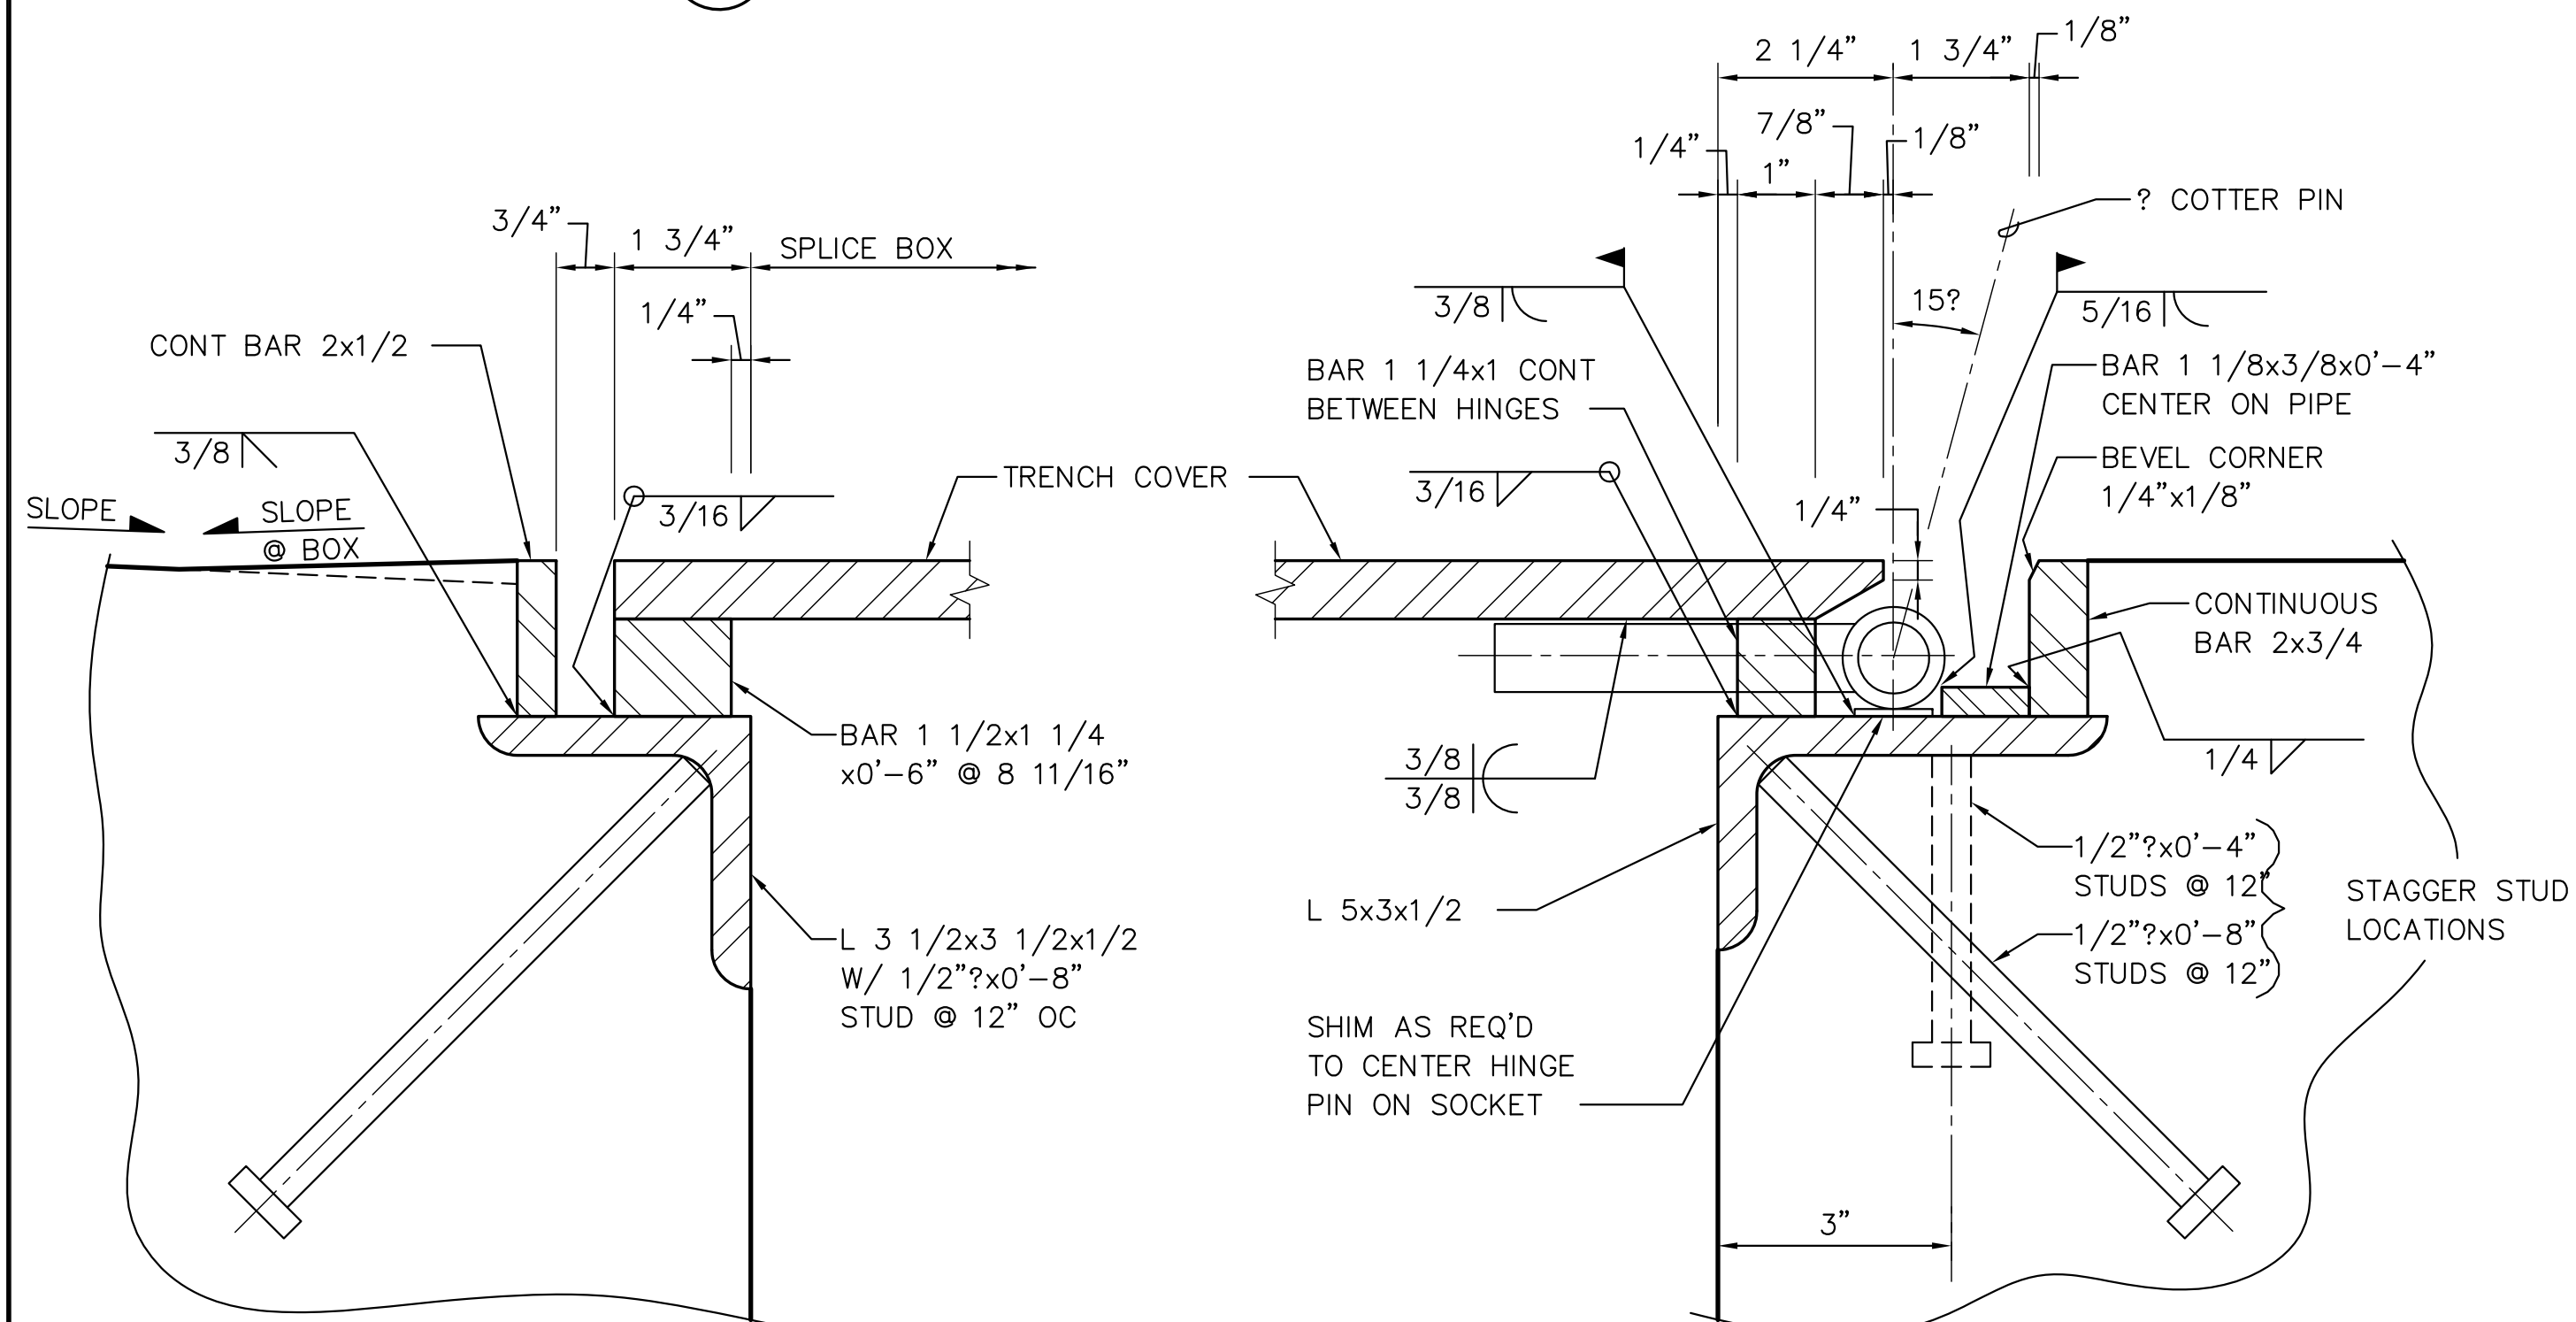


3 SECTION
SCALE: 3"=1'-0"

4 SECTION
SCALE: 3"=1'-0"

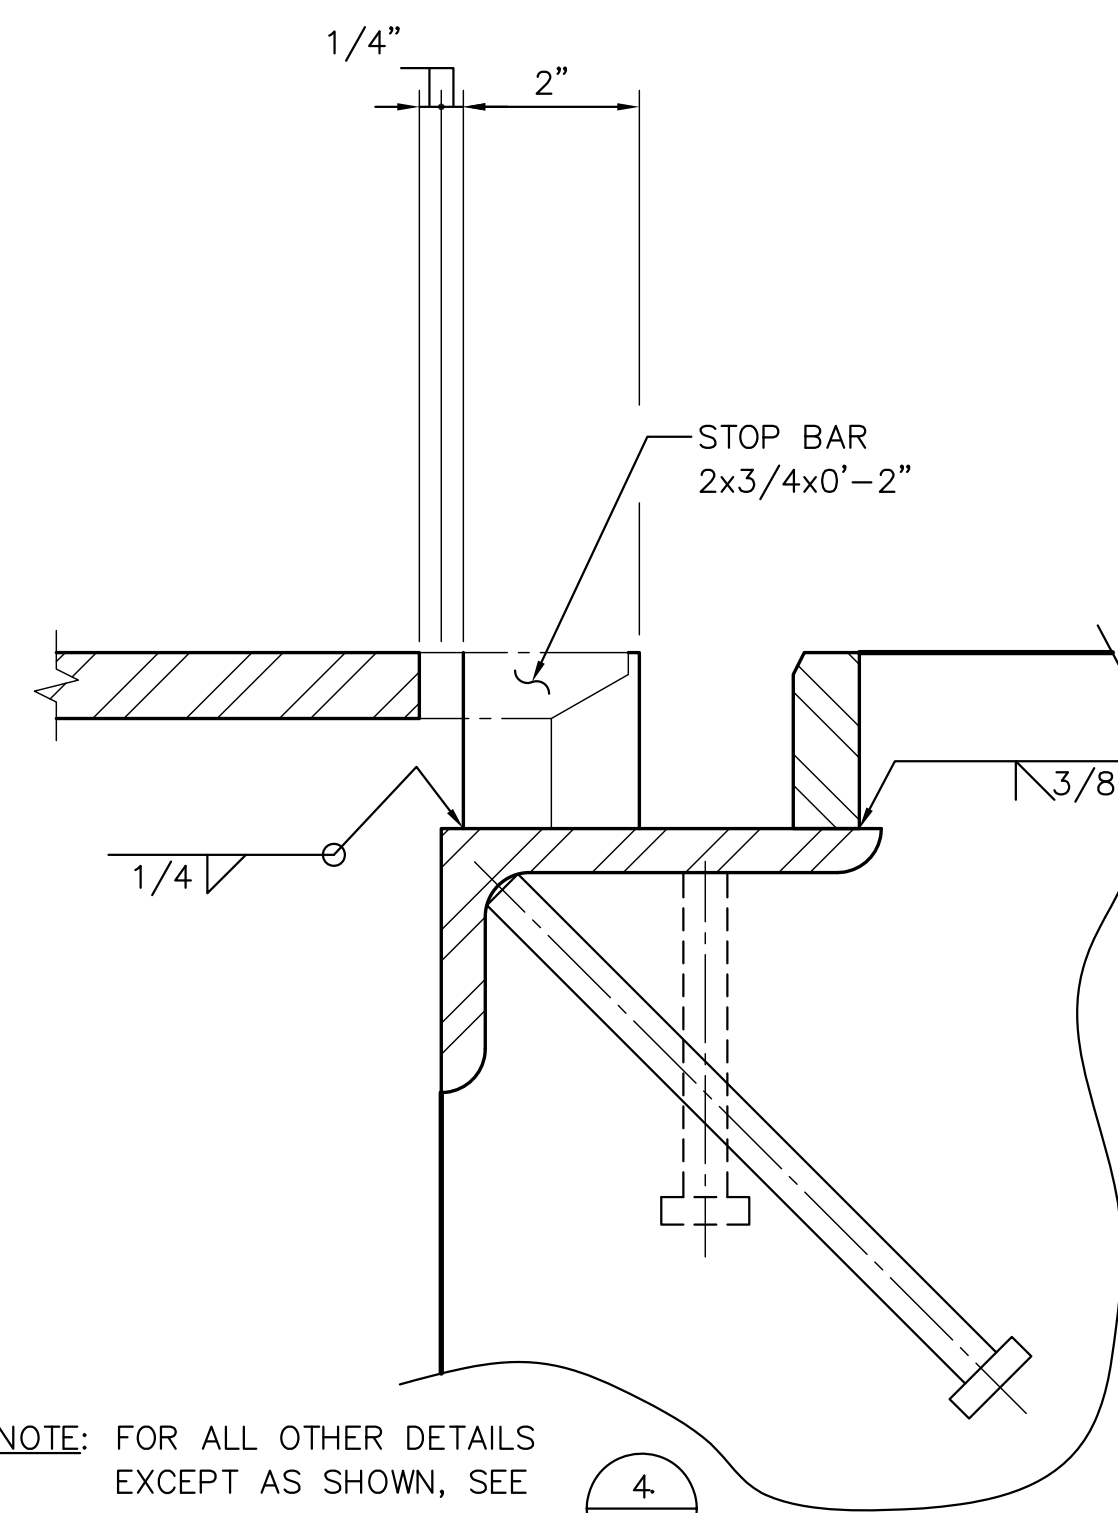

NOTE: FOR ALL OTHER DETAILS EXCEPT AS SHOWN, SEE

5 SECTION
SCALE: 3"=1'-0"

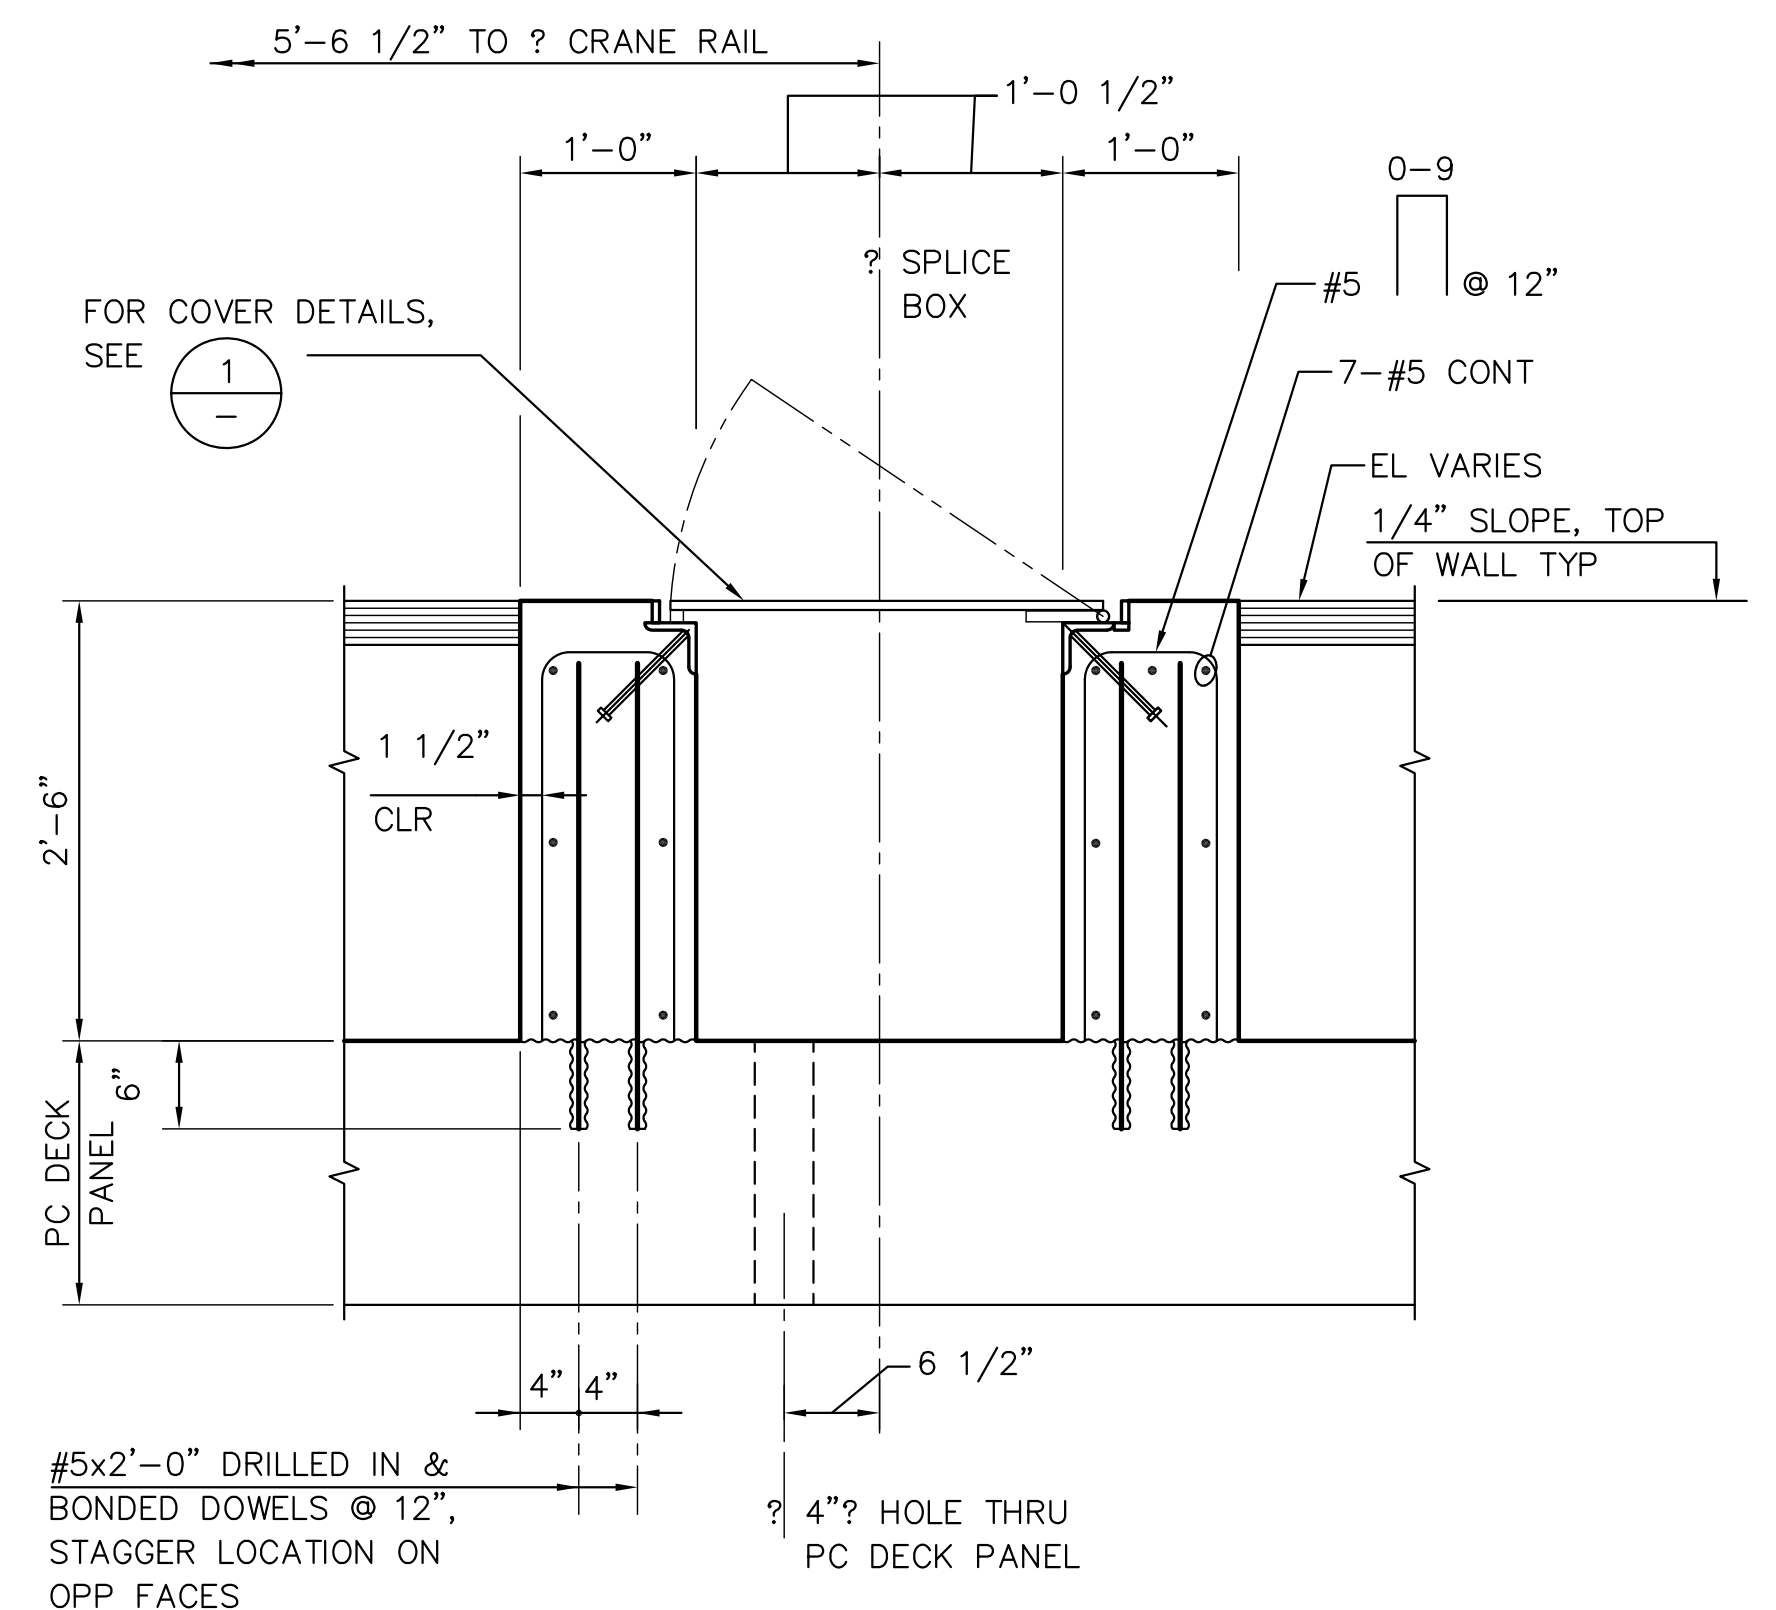

6 SECTION - CABLE SPLICE BOX AS-BUILT
SCALE: 1"=1'-0"



PORT OF TACOMA
P.O. BOX 1837 TACOMA, WASHINGTON 98401
(206) 383-5841

BERGER/ABAM
ENGINEERS INC.
33301 9TH AVENUE SOUTH
FEDERAL WAY, WASHINGTON 98003-6395
(206) 431-2300 FAX: (206) 431-2250

APPROVED
DATE
CURTIS L. RATCLIFFE P.E.
CHIEF ENGINEER

BTH 9/91
DRAWN BY DATE
DESIGNED BY DATE


BCM 9/91
CHECKED BY DATE
PROJ ENGR DATE

JAS 9/91
DATE


MARK	REVISION	BY	APP.	DATE
AS-BUILT		RDD	JAS	1/4/99

**HYUNDAI MERCHANT MARINE TERMINAL
WHARF
PORT OF TACOMA
SPLICE BOX DETAILS**


AUTOCAD FILE NO. **5012S36** **S-36**
DRAWING NO. **EP-5012-26**
CONTRACT NO. **978038**
SHEET NO. **47** OF **58**

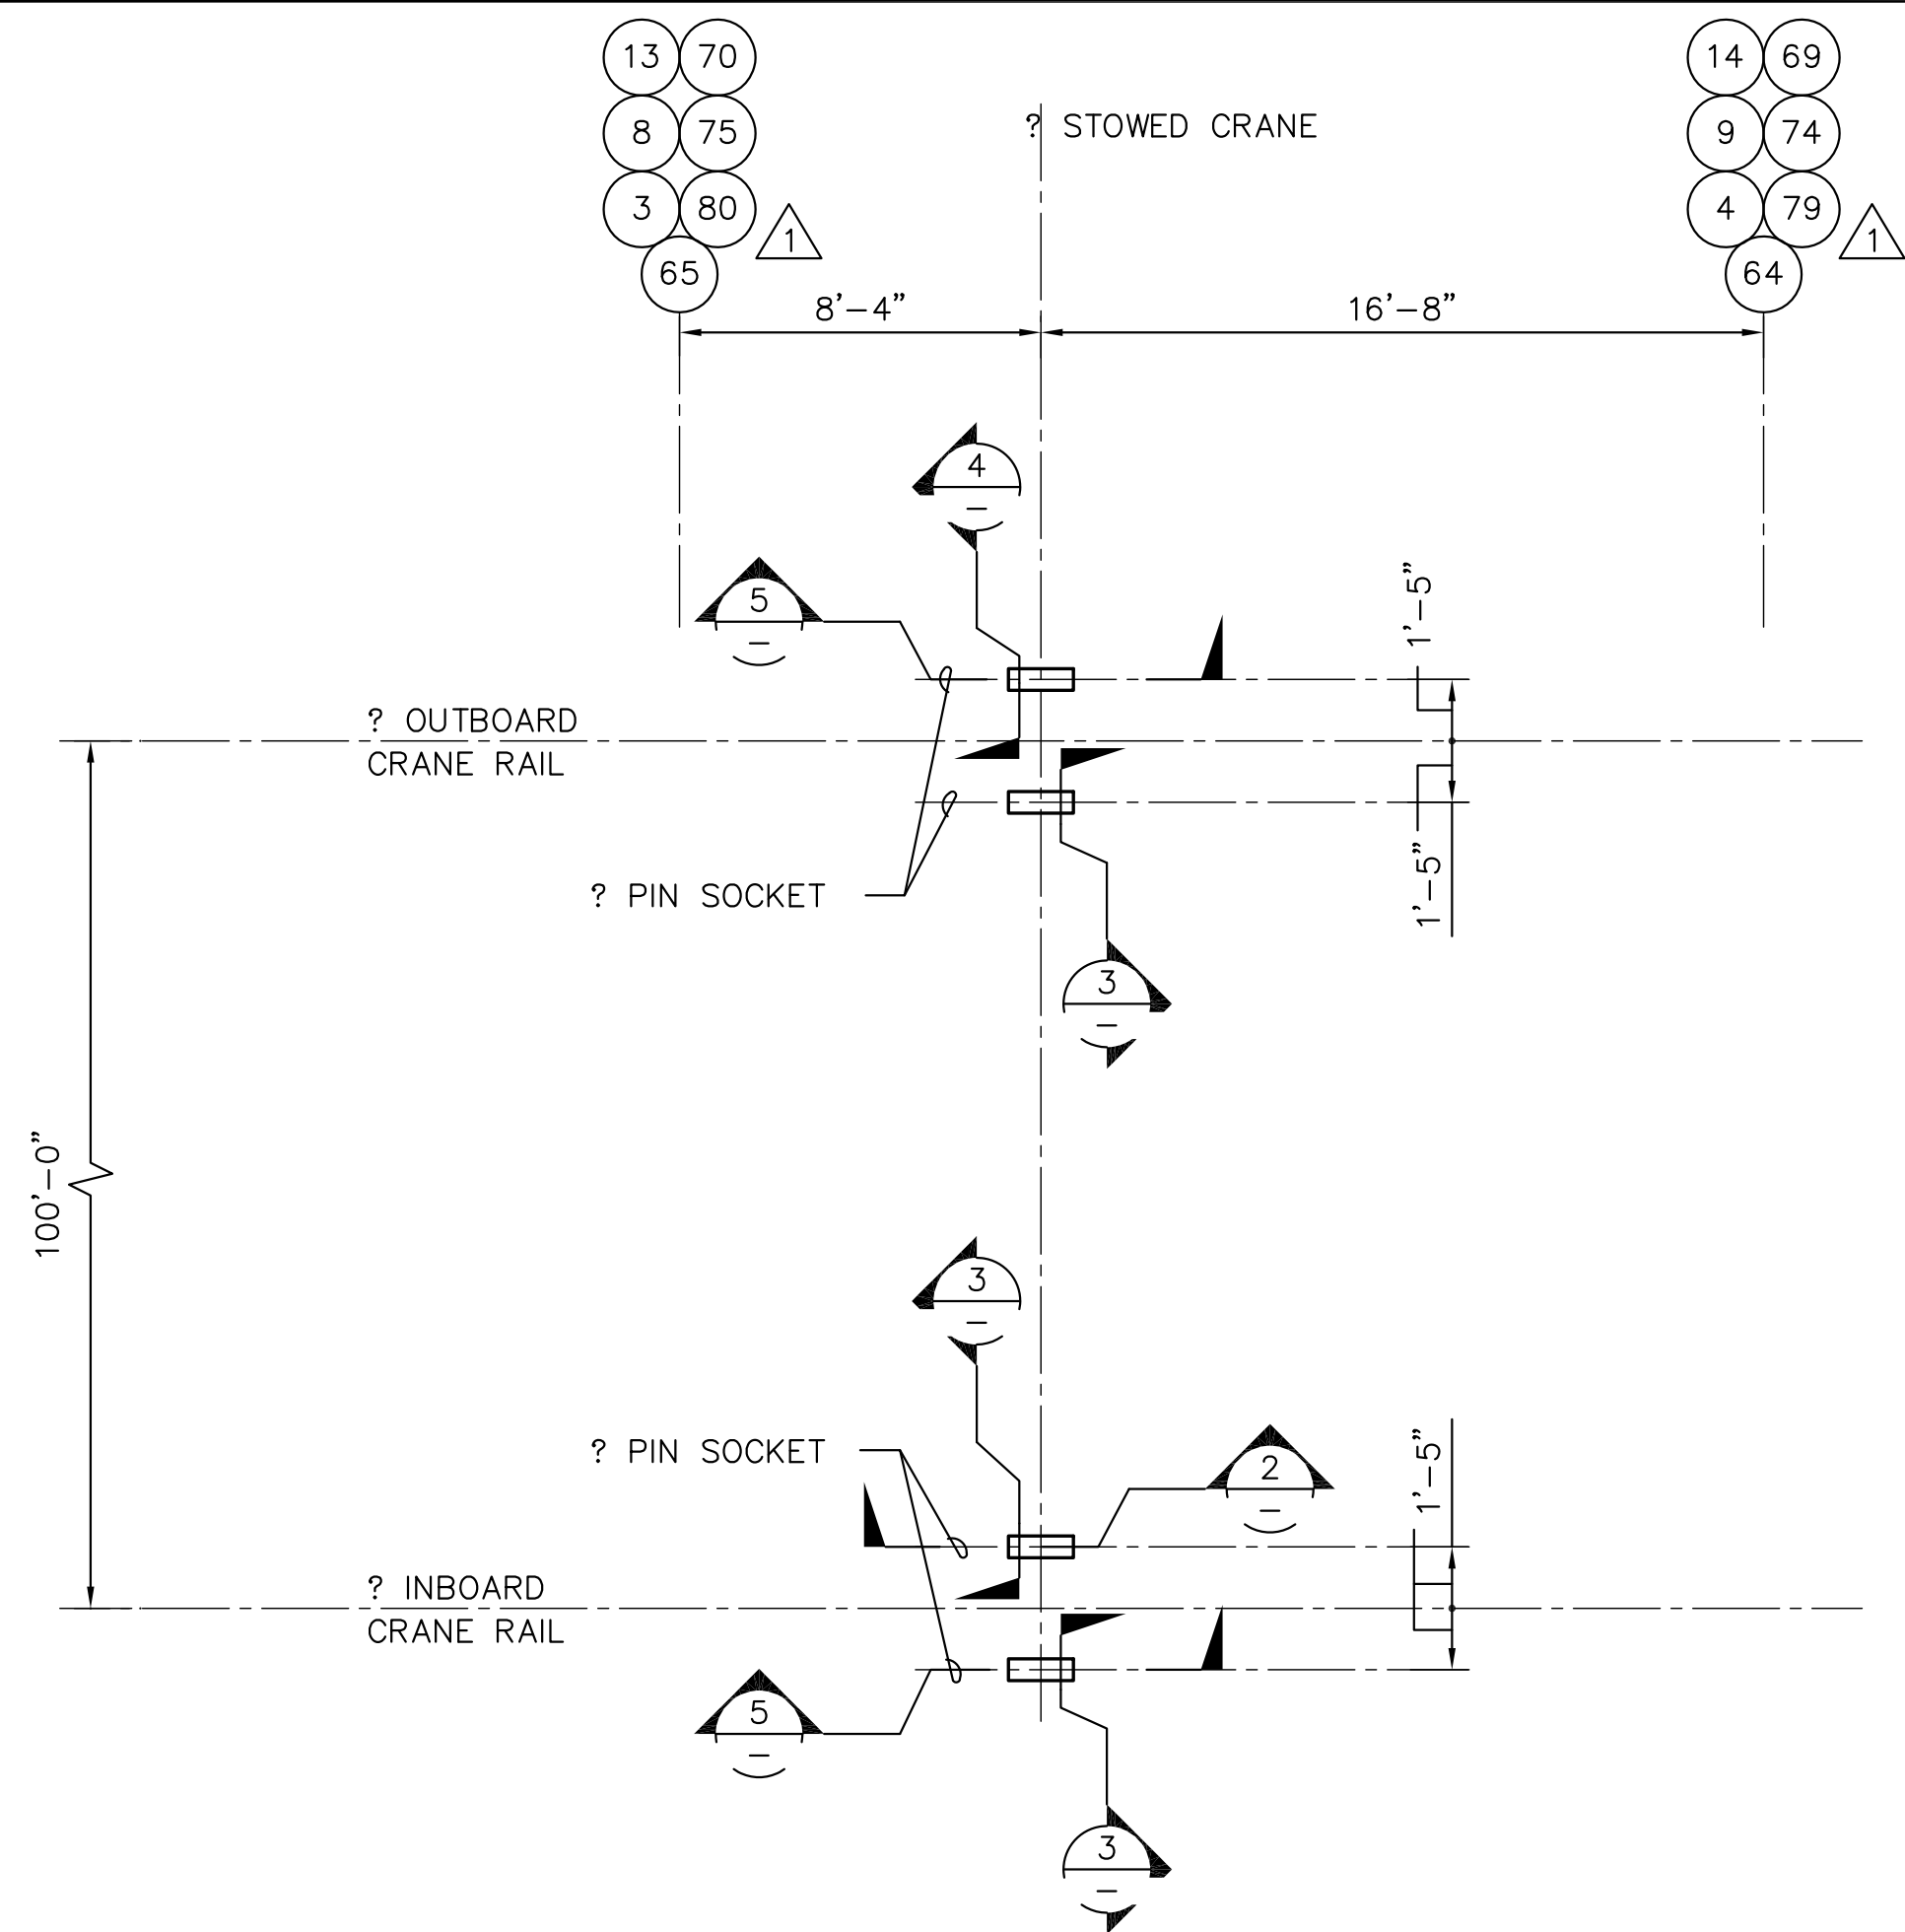


1 PLAN - PIN SOCKET @ STOWED CRANE LOCATIONS
SCALE: 1/4"=1'-0"

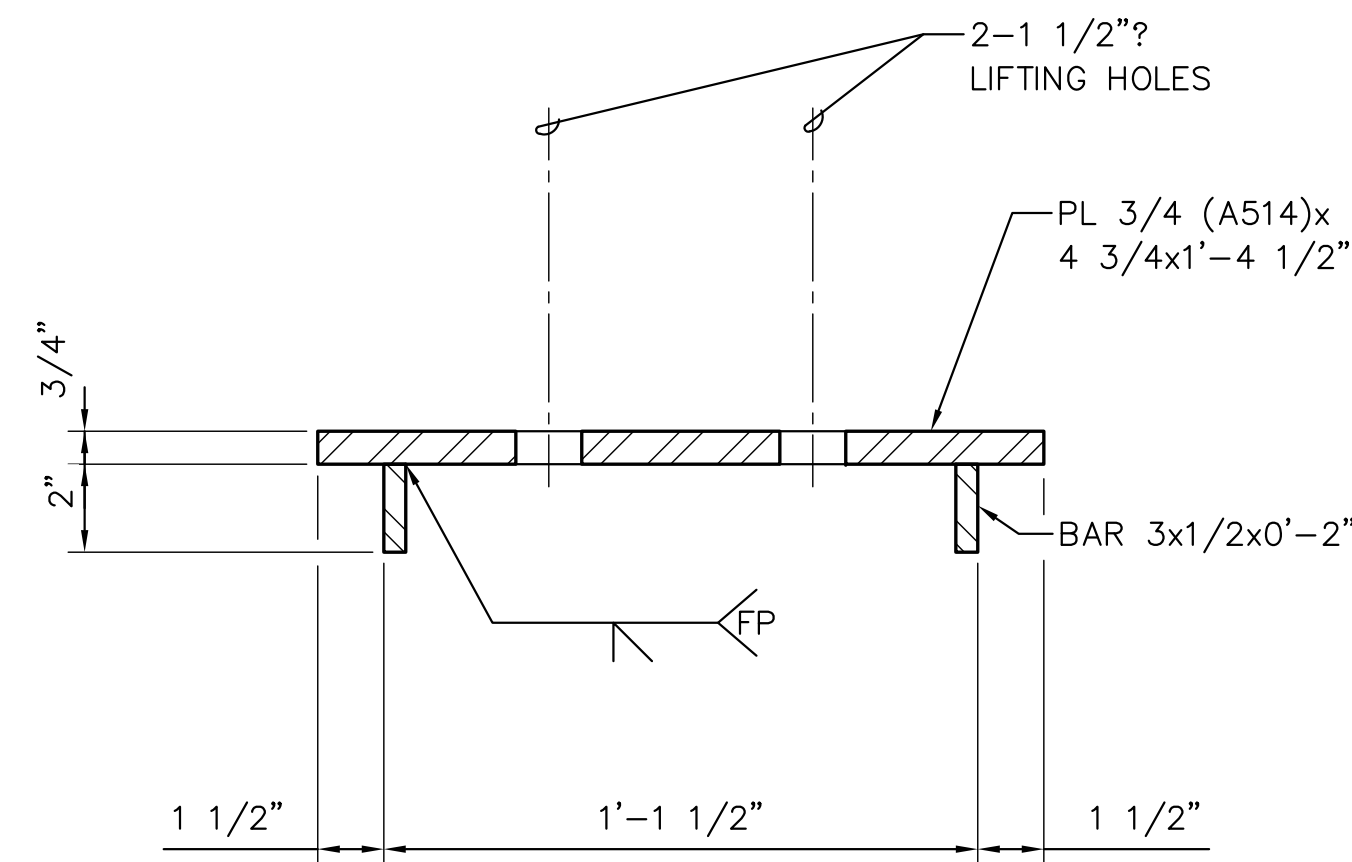


2 DETAIL - PIN SOCKET COVER
SCALE: 3"=1'-0"

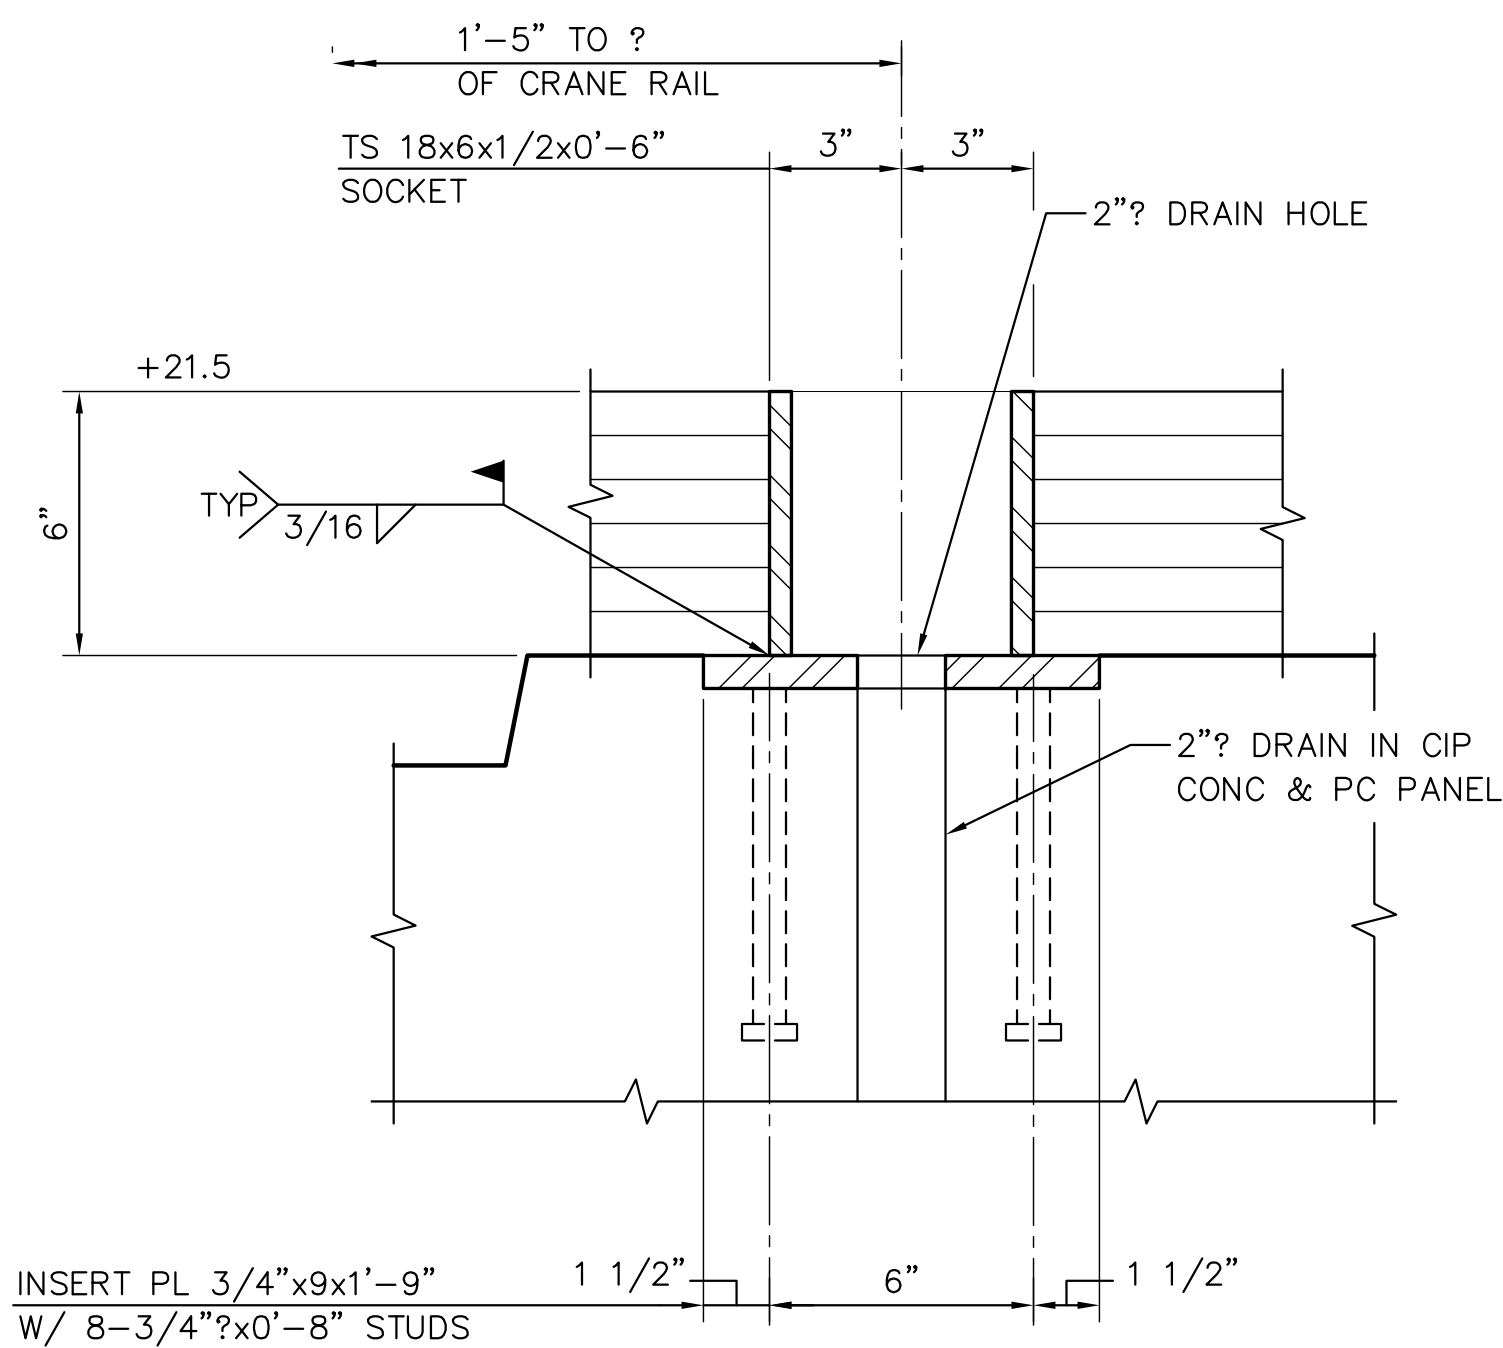

3 SECTION - PIN SOCKETS: INBOARD CRANE RAIL & LANDSIDE OF OUTBOARD CRANE RAIL
SCALE: 3"=1'-0"

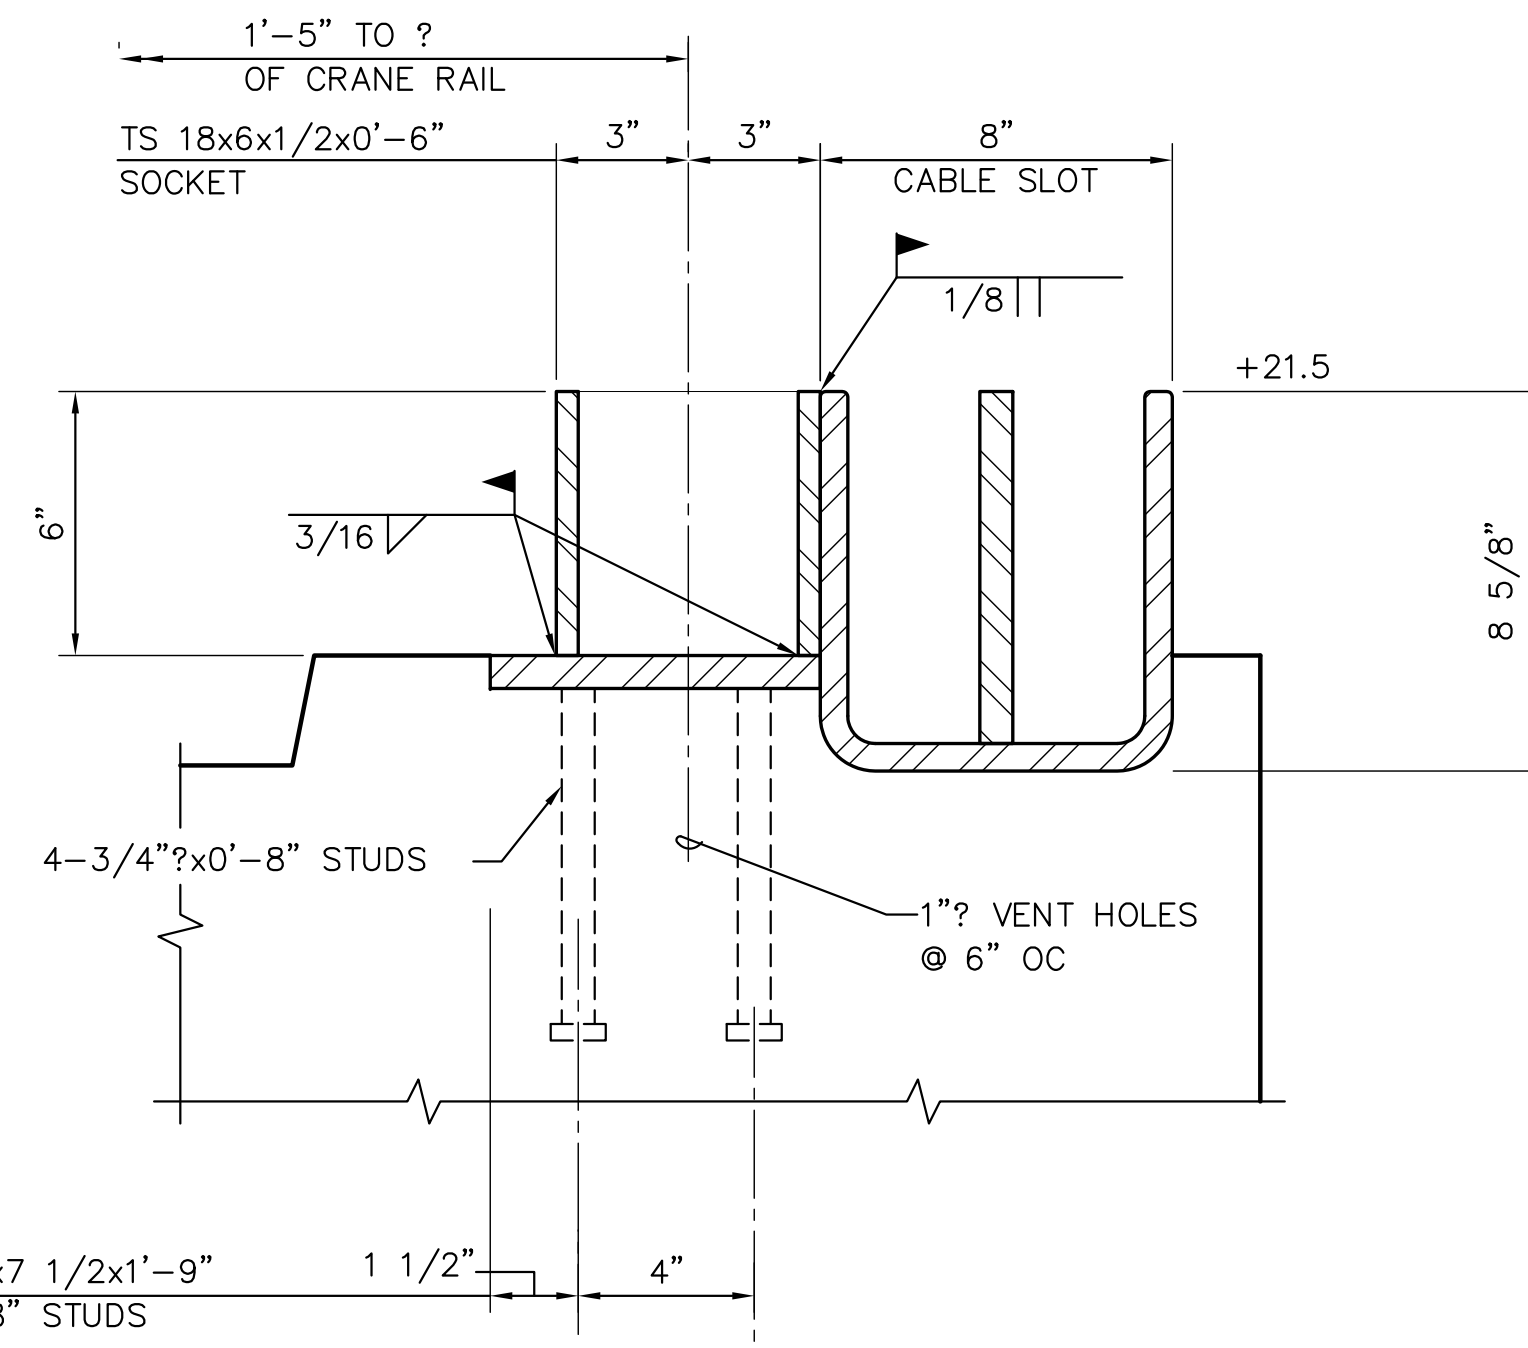

4 SECTION - PIN SOCKETS: WATERSIDE OF OUTBOARD CRANE RAIL
SCALE: 3"=1'-0"

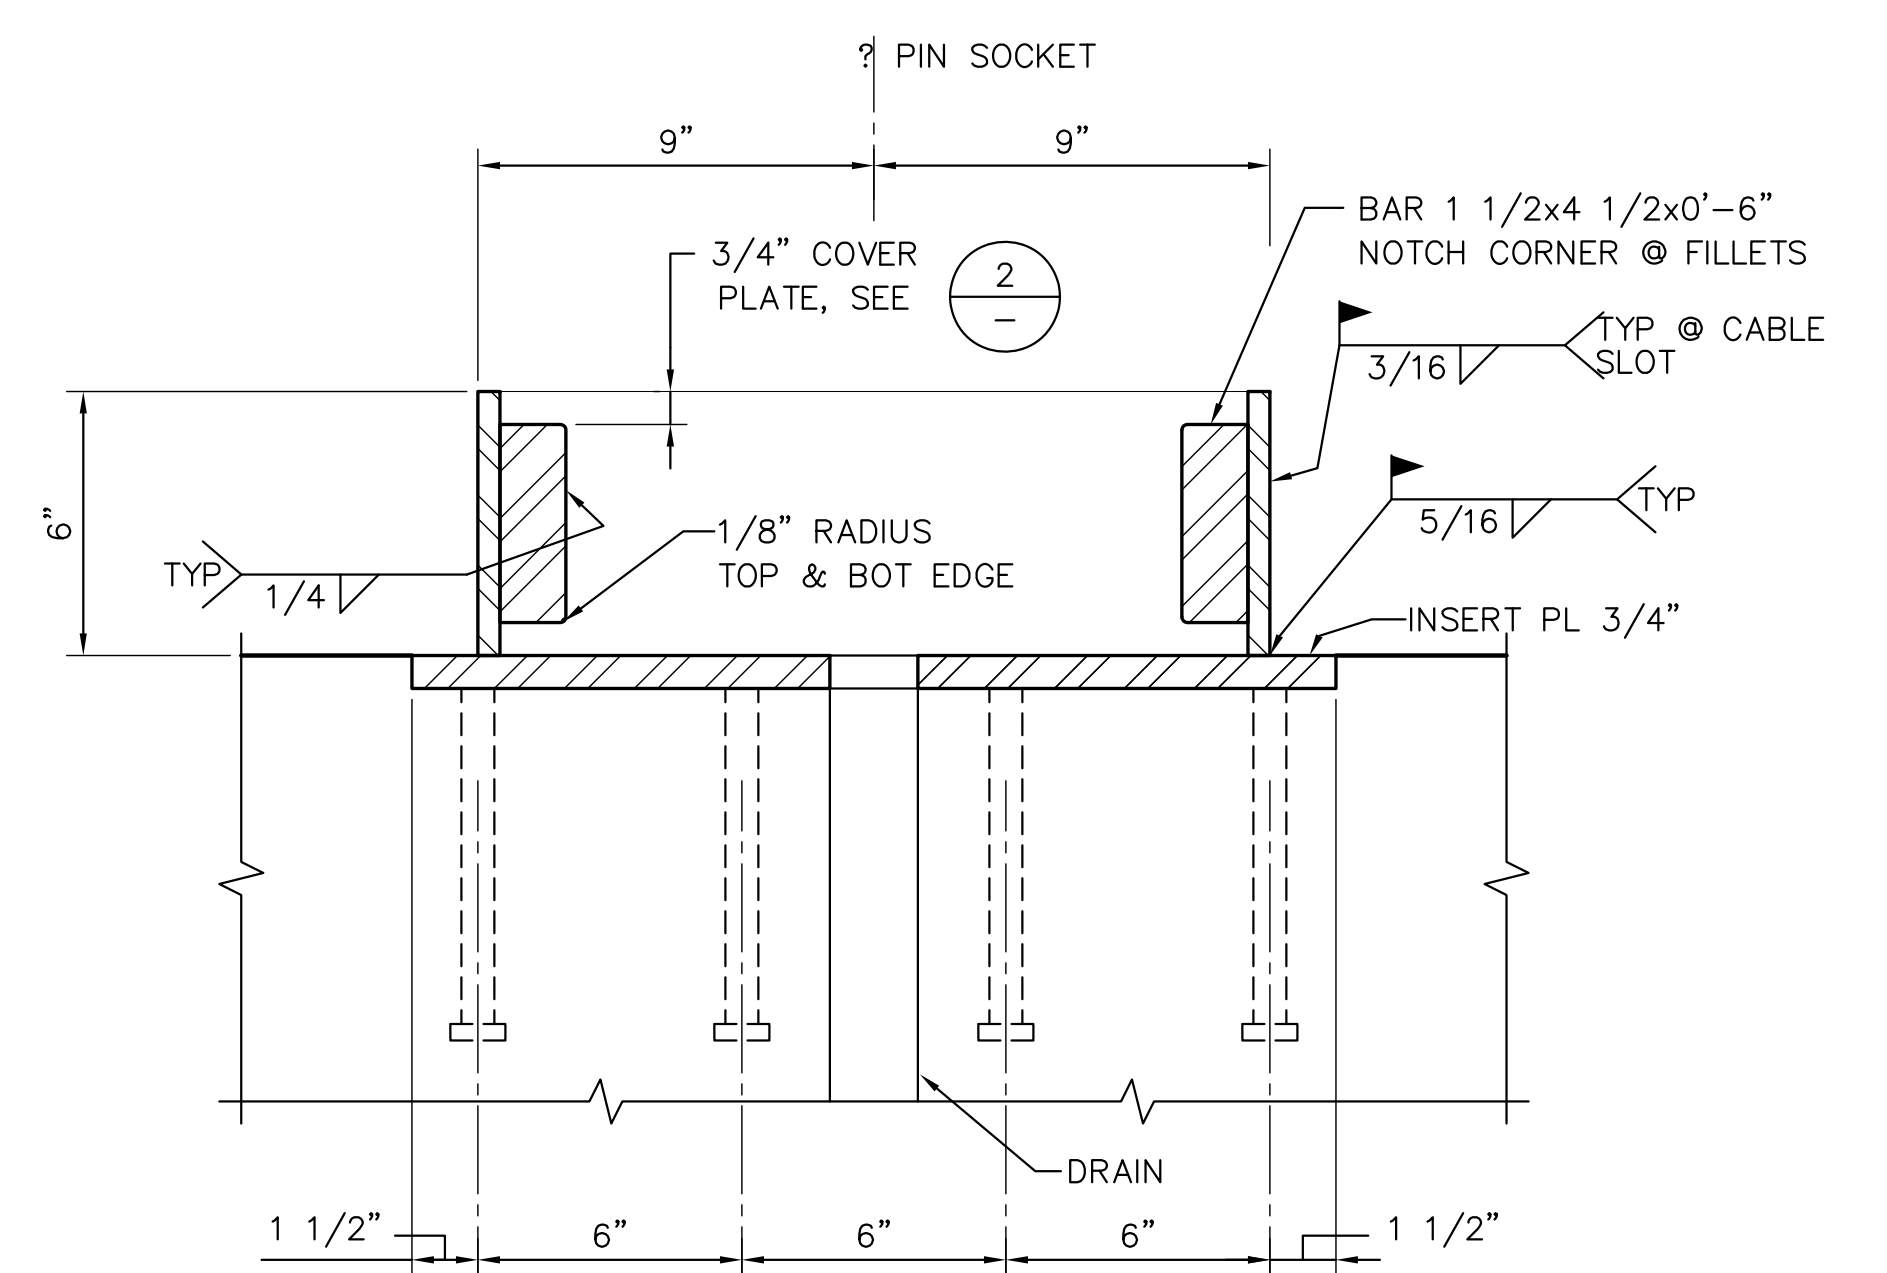

5 SECTION - TYPICAL PIN SOCKET
SCALE: 3"=1'-0"



PORT OF TACOMA
P.O. BOX 1837 TACOMA, WASHINGTON 98401
(206) 383-5841

BERGER/ABAM
ENGINEERS INC.
33301 9TH AVENUE SOUTH
FEDERAL WAY, WASHINGTON 98003-6395
(206) 431-2300 FAX: (206) 431-2250

APPROVED
DATE
CURTIS L. RATCLIFFE P.E.
CHIEF ENGINEER

BTH 9/91
DRAWN BY DATE
DESIGNED BY DATE

BCM 9/91
CHECKED BY DATE
JAS 9/91
PROJ ENGR DATE

MARK	REVISION	BY	APP.	DATE
AS-BUILT		RDD	JAS	1/4/99


HYUNDAI MERCHANT MARINE TERMINAL WHARF
PORT OF TACOMA
CRANE PIN SOCKET DETAILS

AS-BUILT

AUTOCAD FILE NO.
5012S37

S-37


DRAWING NO. **EP-5012-26**
CONTRACT NO. **978038**
SHEET NO. **48** OF **58**

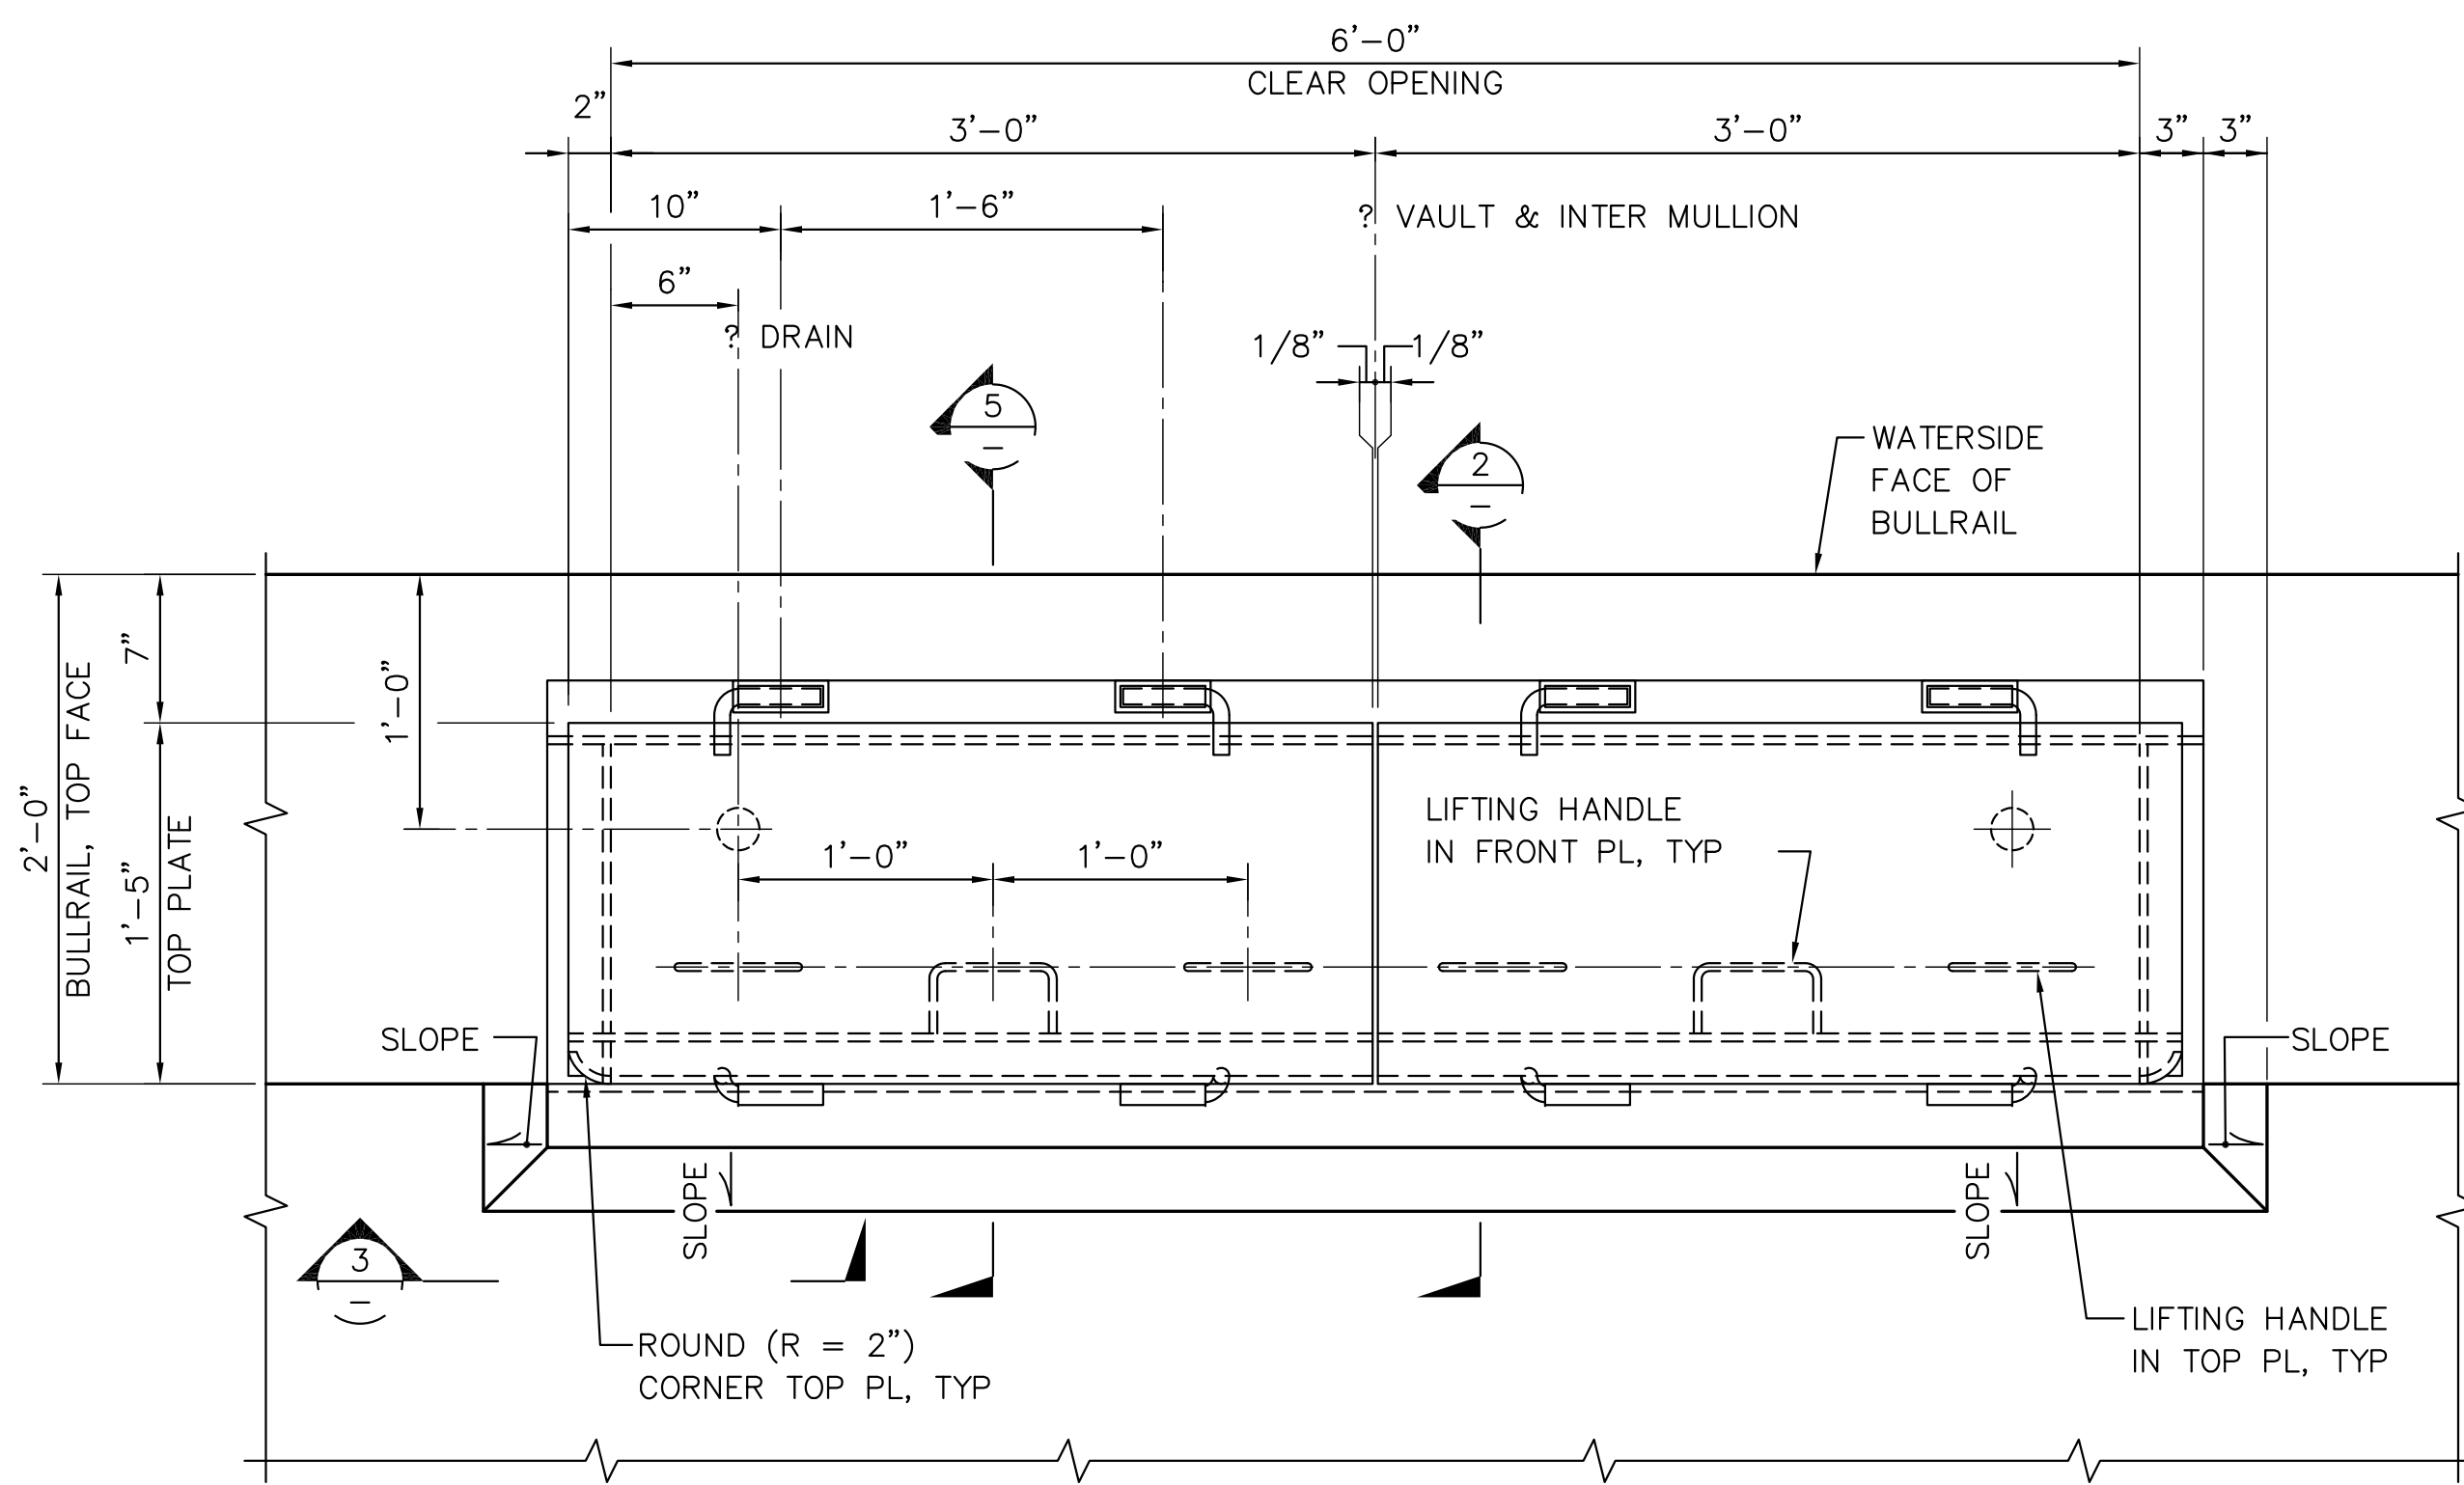



1 PLAN - UTILITY VAULT
SCALE: 1 1/2"=1'-0"

NOTE: PAINT DESIGNATOR SIGNS - "WATER" & "ELECTRICAL" ON TOP OF RESPECTIVE VAULTS. DETAIL AS SHOWN ON


2 DETAIL - INTERMEDIATE MULLION
SCALE: 1 1/2"=1'-0"

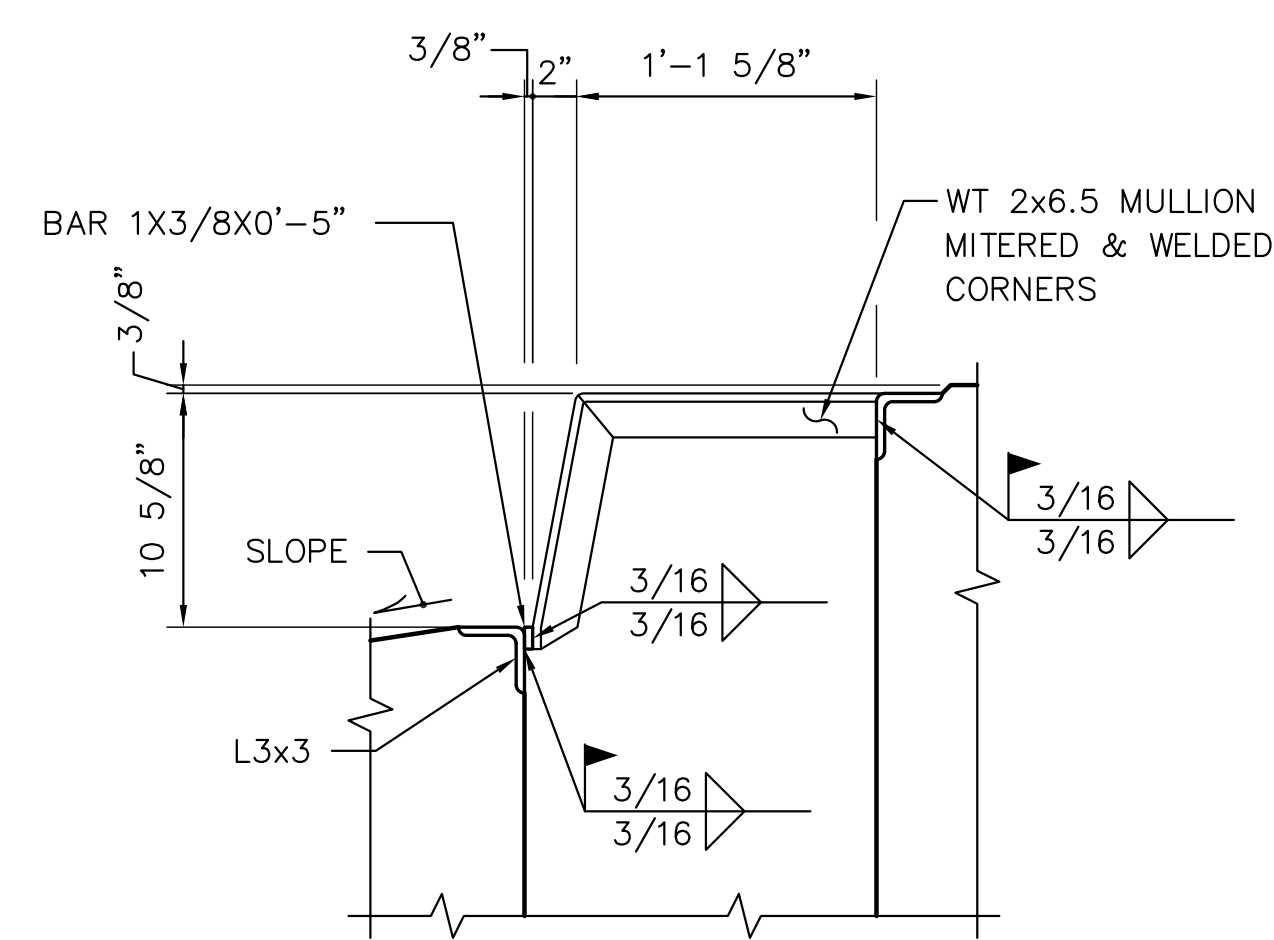

3 ELEVATION - FRONT PLATE
SCALE: 3"=1'-0"

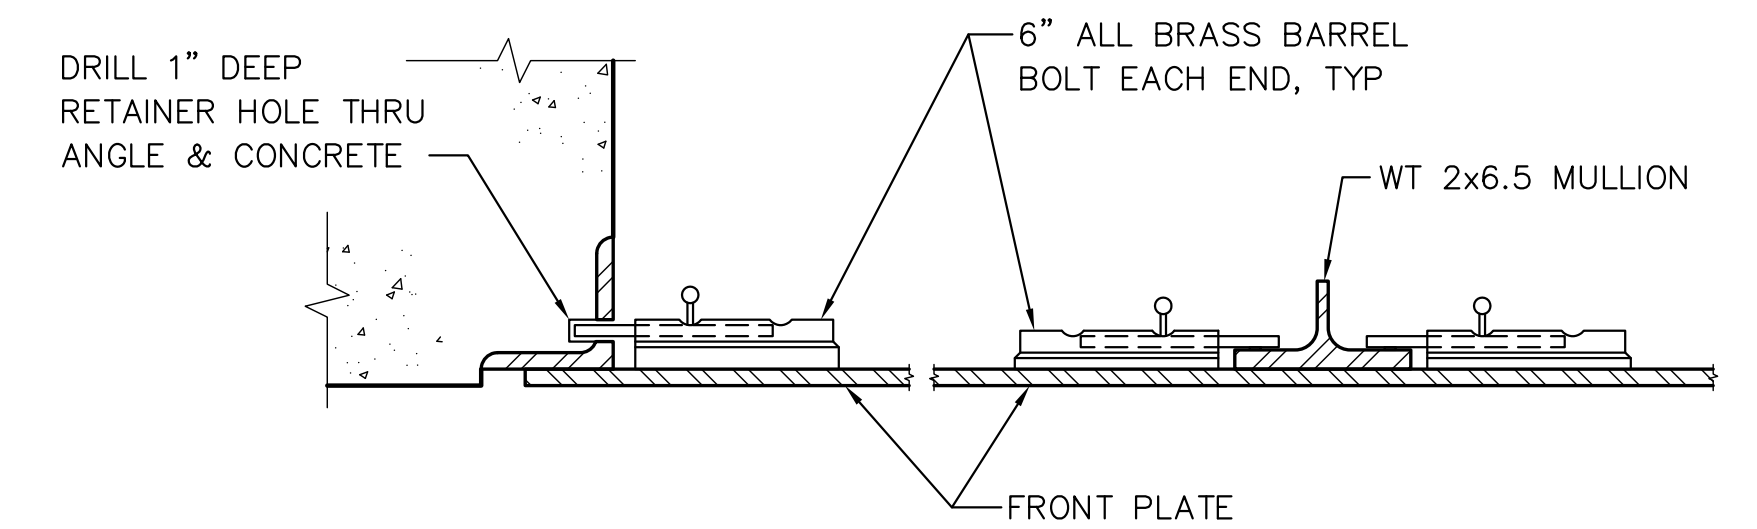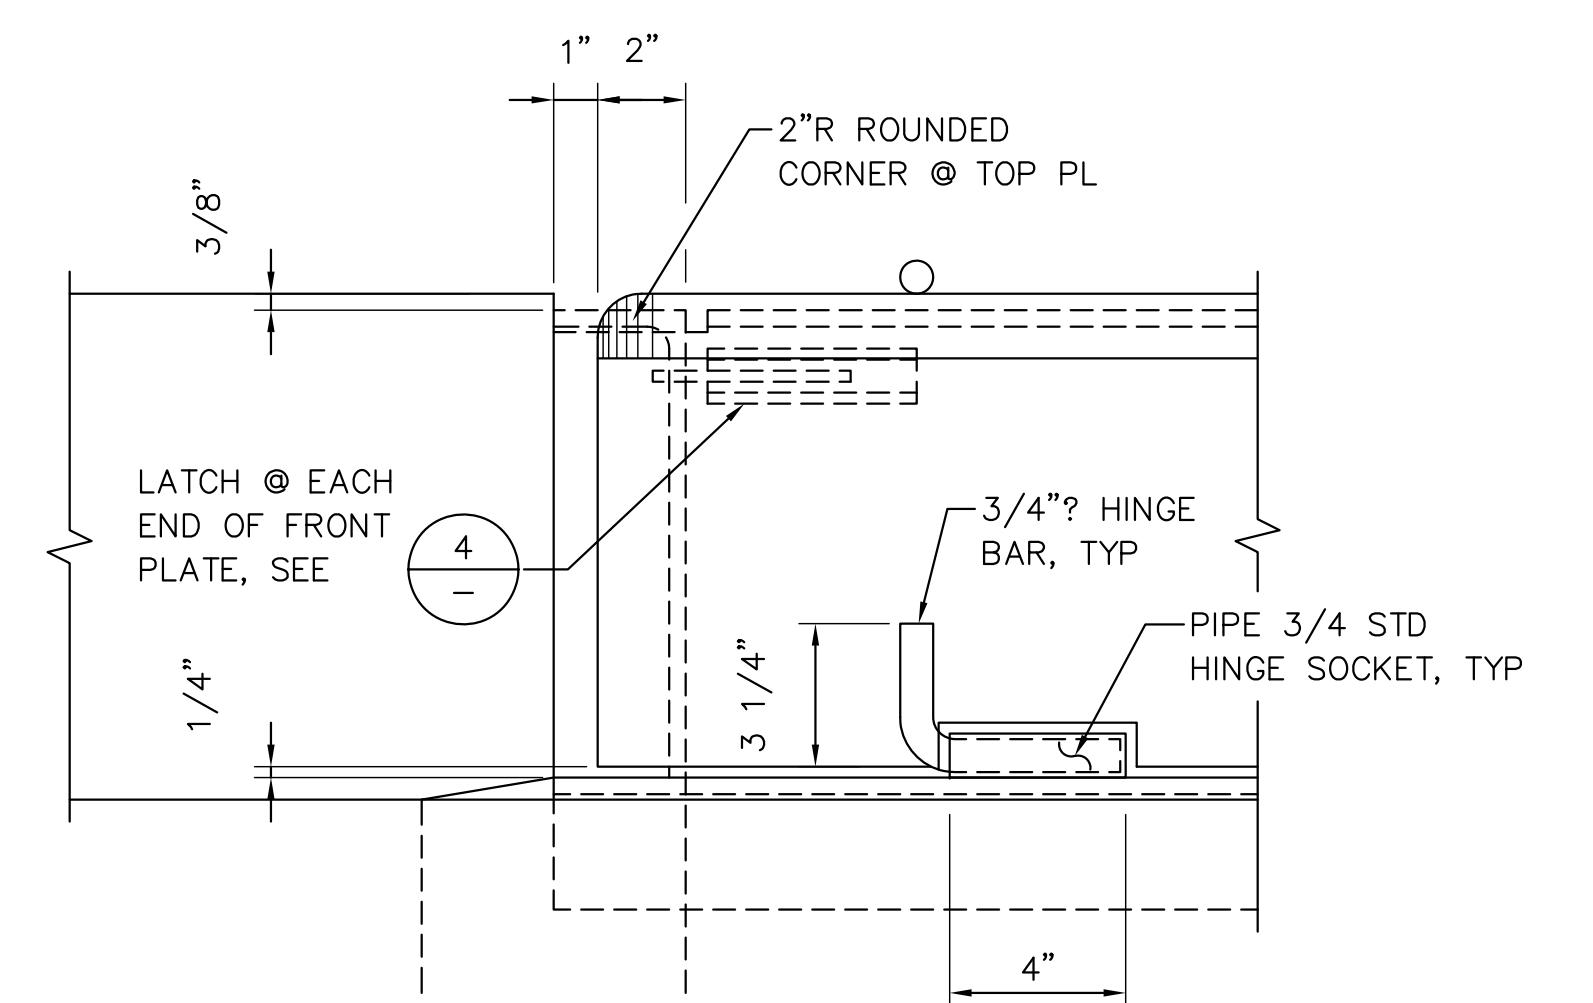

4 PLAN - LATCH DETAIL
SCALE: 3"=1'-0"

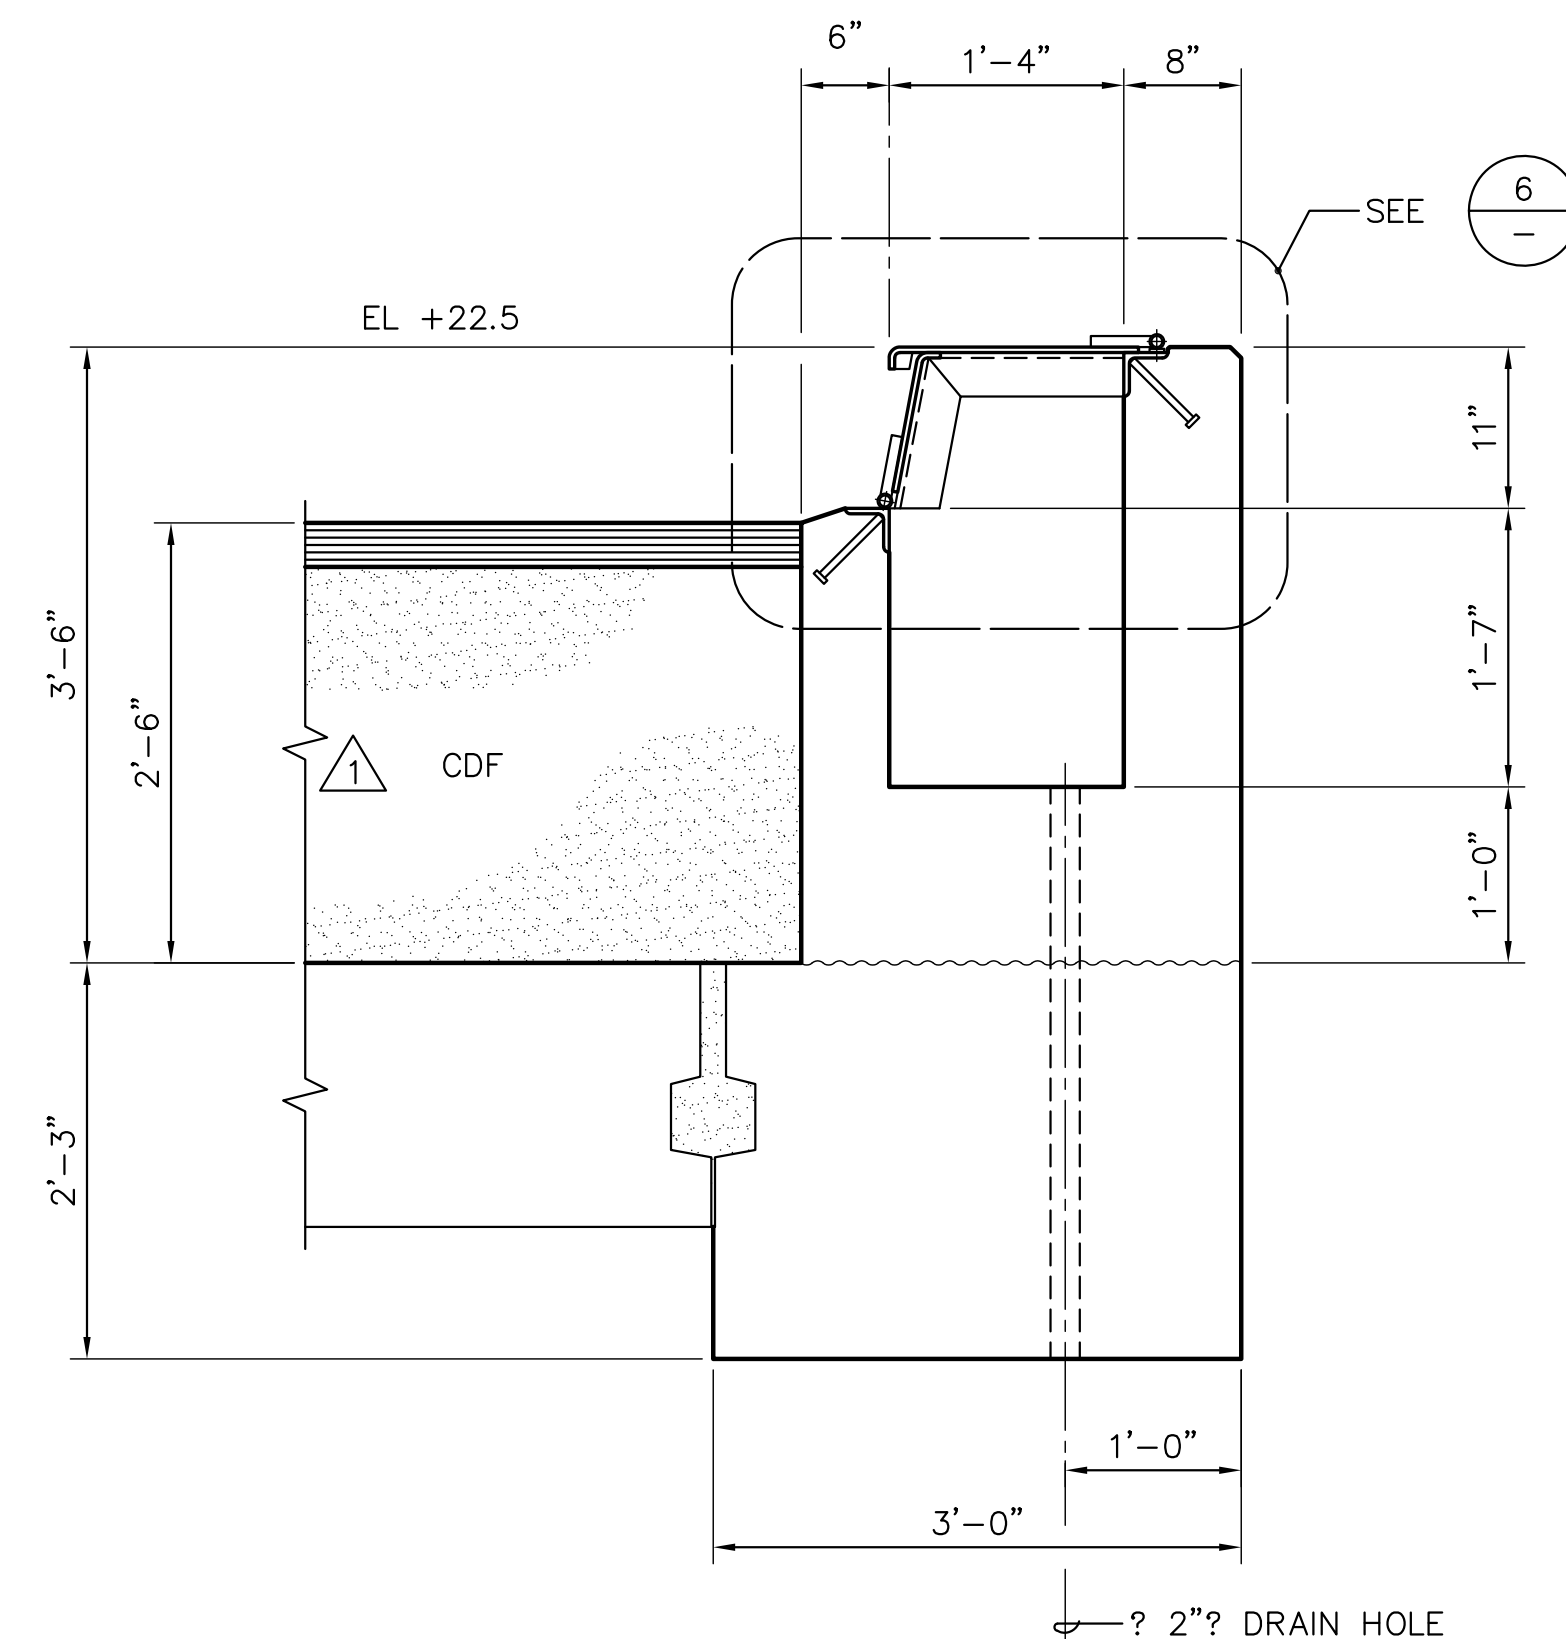

5 SECTION - UTILITY VAULT
SCALE: 1"=1'-0"

6 DETAIL - VAULT COVER
SCALE: 3"=1'-0"

AS-BUILT

AUTOCAD FILE NO. 5012S38 S-38



PORT OF TACOMA
P.O. BOX 1837 TACOMA, WASHINGTON 98401
(206) 383-5841

BERGER/ABAM ENGINEERS INC.
33301 9TH AVENUE SOUTH
FEDERAL WAY, WASHINGTON 98003-6395
(206) 431-2300 FAX: (206) 431-2250

APPROVED
DATE
CURTIS L. RATCLIFFE P.E.
CHIEF ENGINEER


BTH 9/91
DRAWN BY DATE
DESIGNED BY DATE

BCM 9/91
CHECKED BY DATE
JAS 9/91
PROJ ENGR DATE


MARK	REVISION	BY	APP.	DATE
AS-BUILT		RDD	JAS	1/4/99

HYUNDAI MERCHANT MARINE TERMINAL
WHARF
PORT OF TACOMA
UTILITY VAULT DETAILS


DRAWING NO. EP-5012-26
CONTRACT NO. 978038
SHEET NO. 49 OF 58

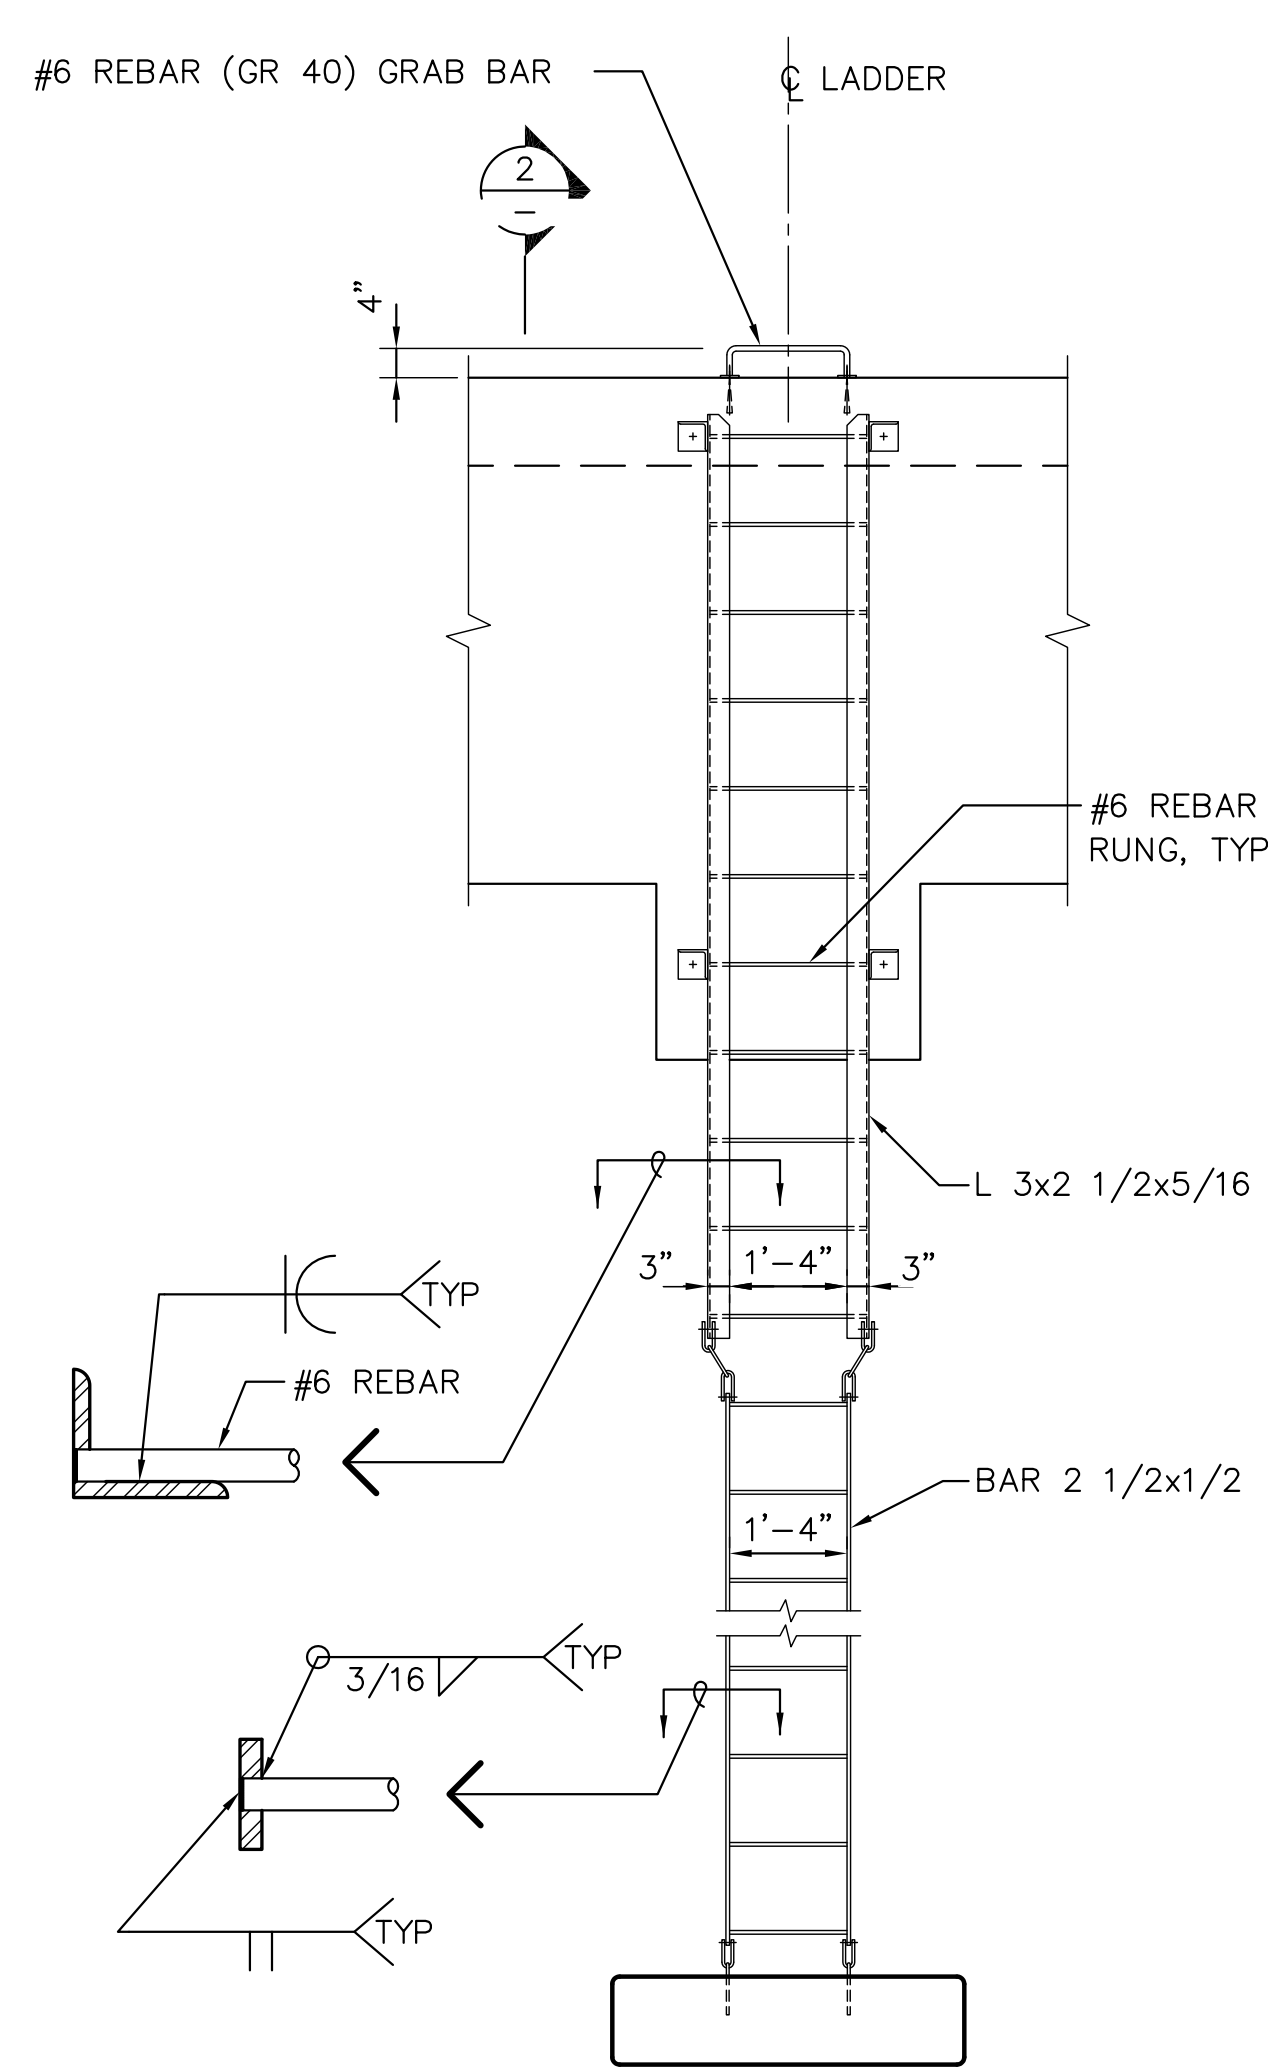

1 ELEVATION - LADDER
SCALE: 1/2"=1'-0"

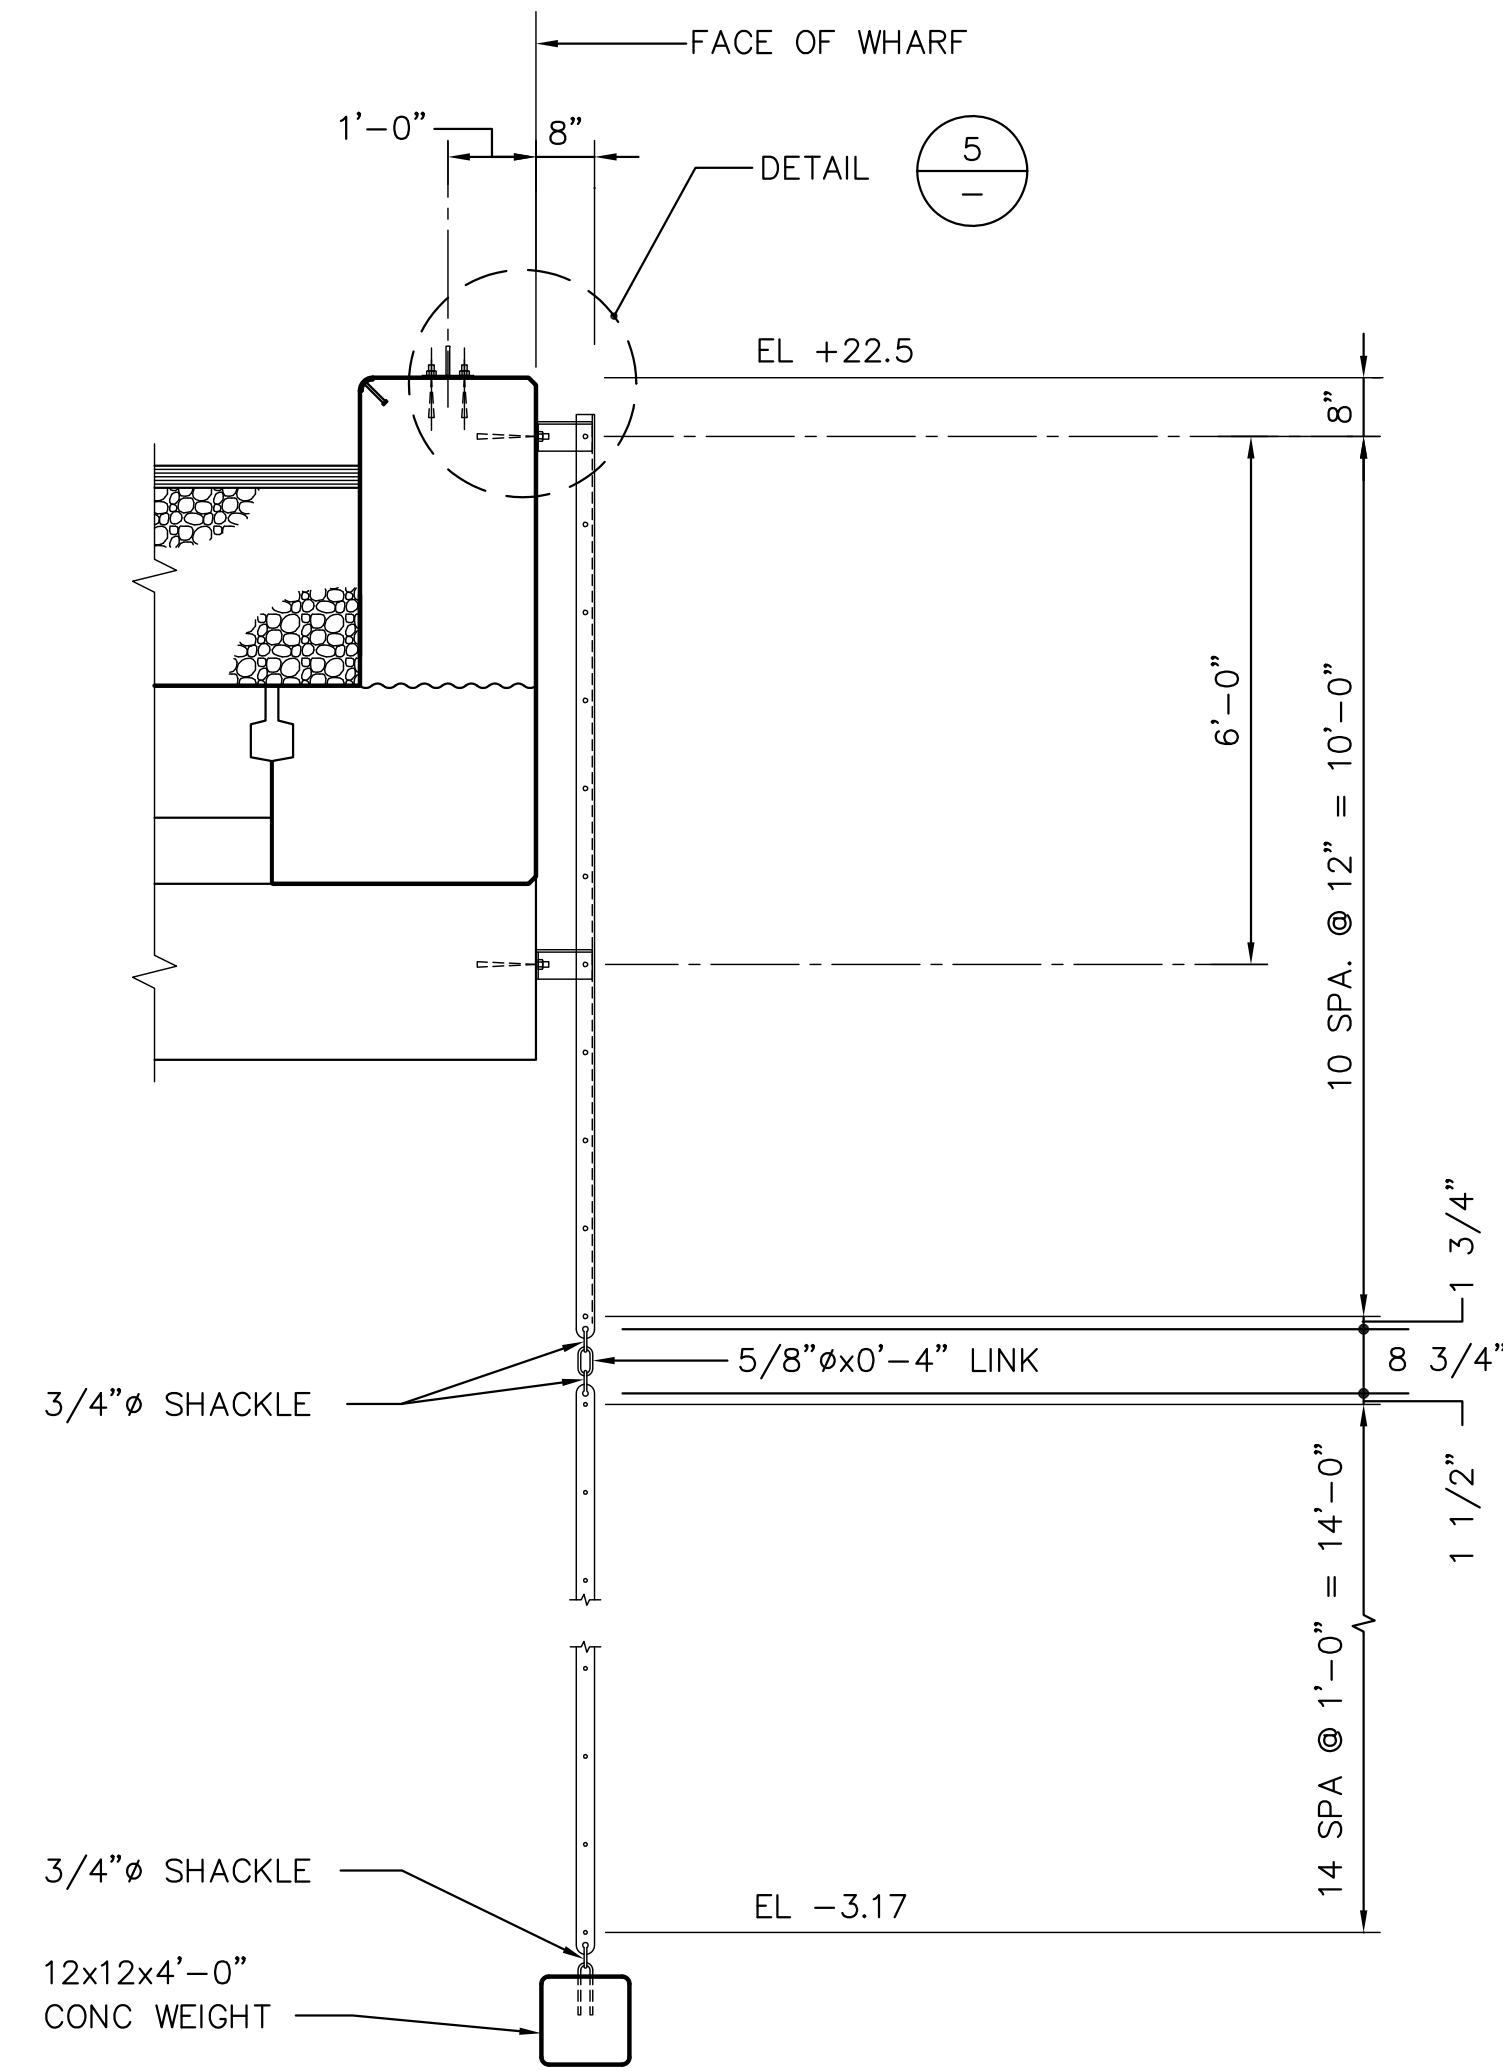


2 SECTION - LADDER
SCALE: 1/2"=1'-0"

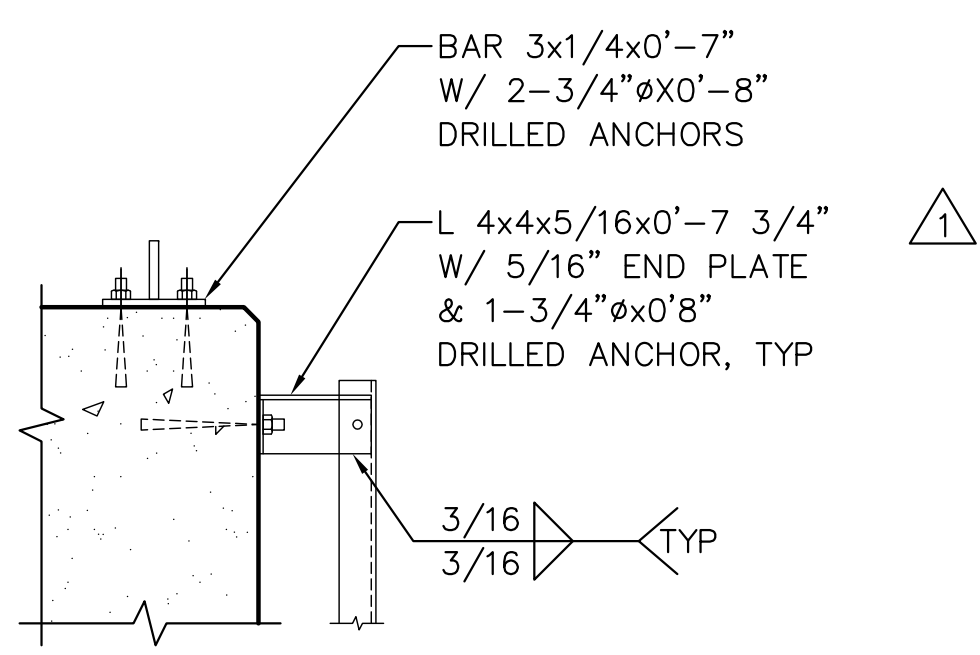


5 DETAIL
SCALE: 1"=1'-0"

NOTE: FOR ALL OTHER DETAILS EXCEPT AS SHOWN, SEE 5.


6 SECTION - LADDER @ BENTS 1 & 82
SCALE: 1/2"=1'-0"

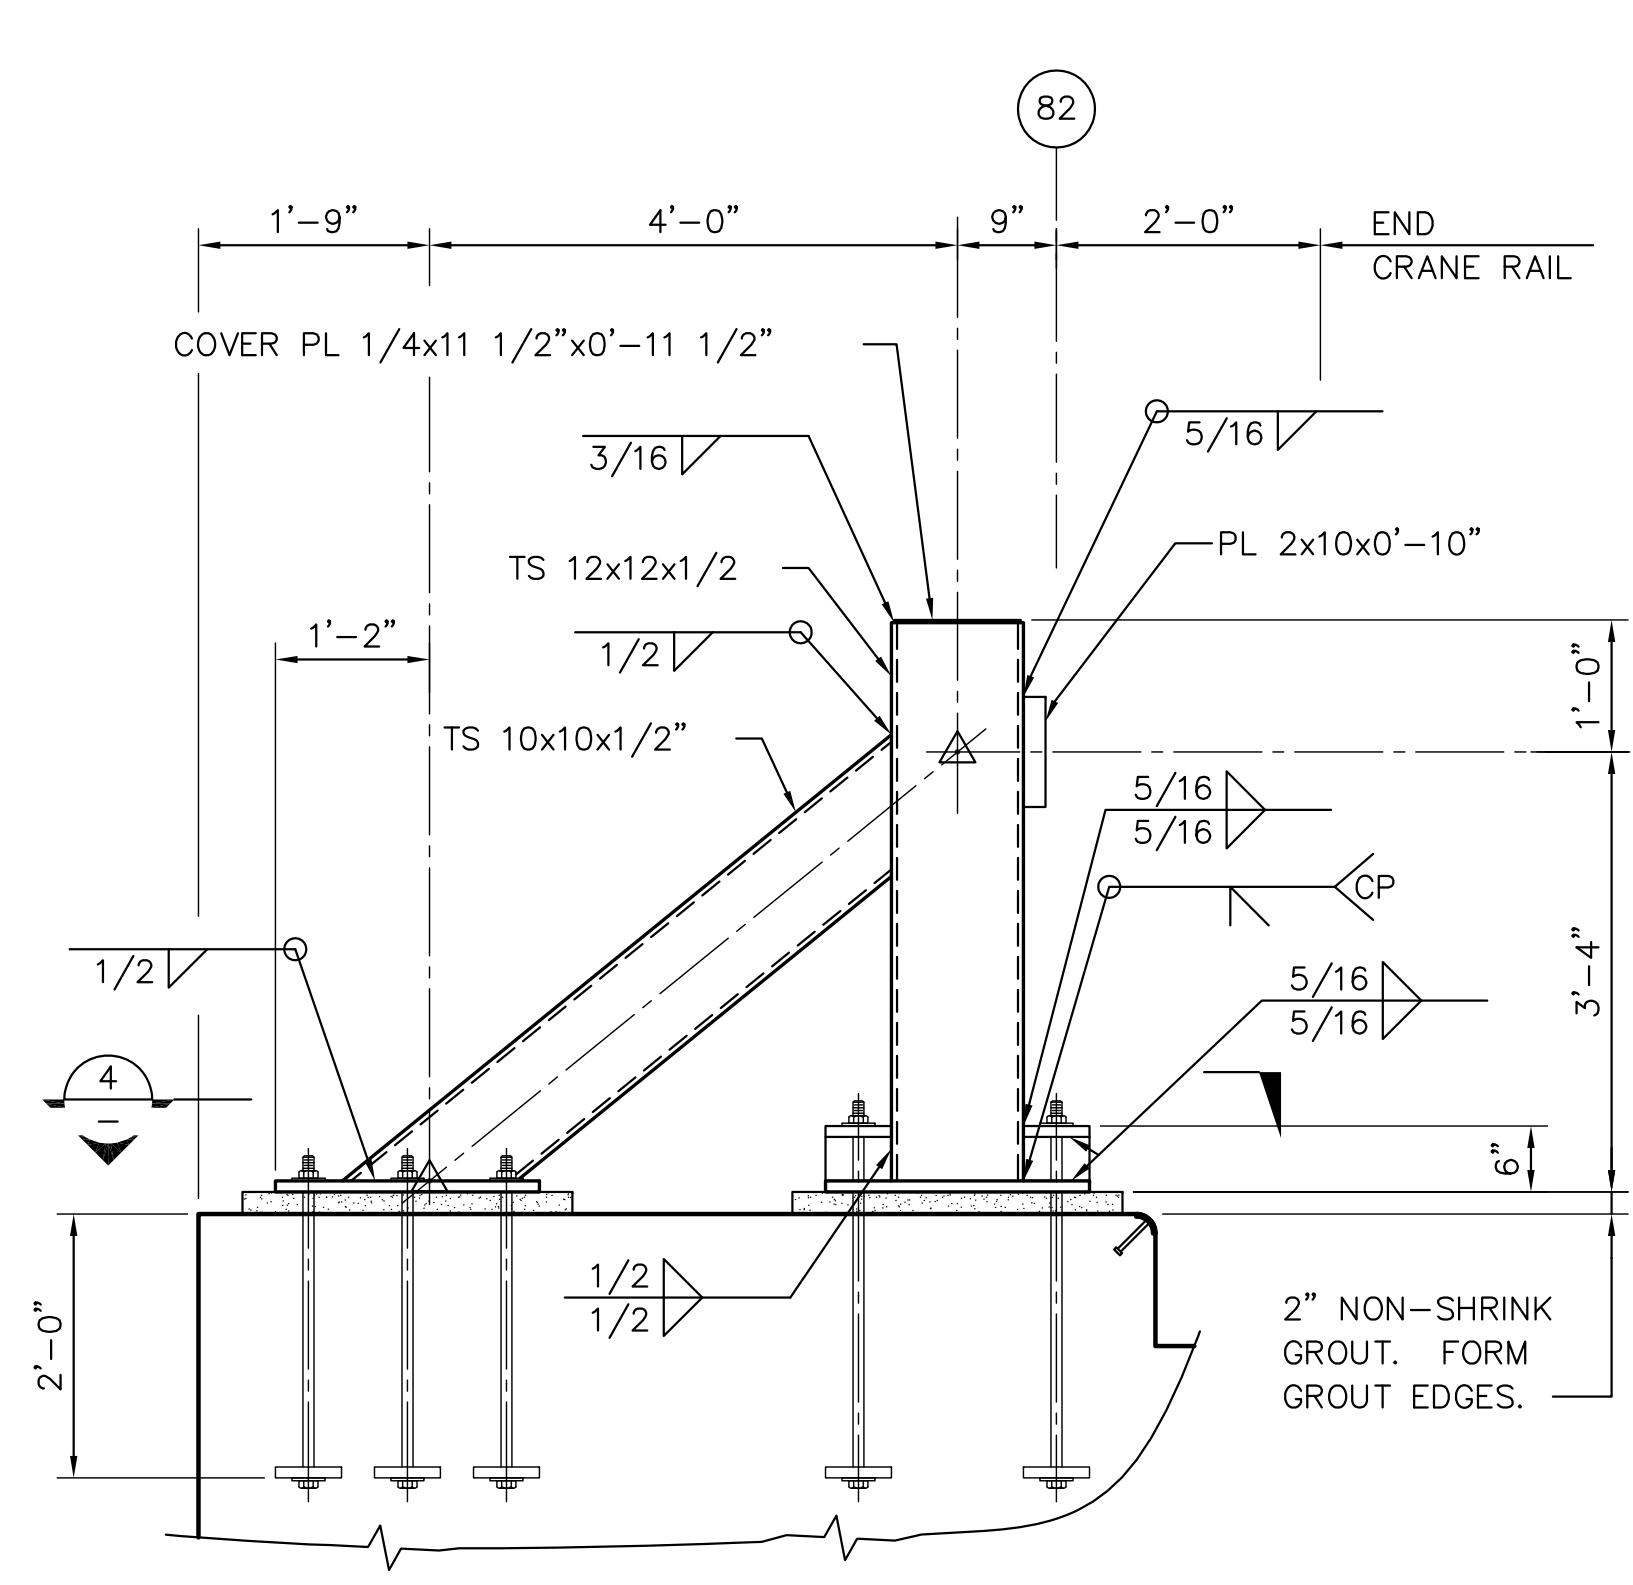



3 ELEVATION - CRANE STOP
SCALE: 3/4"=1'-0"

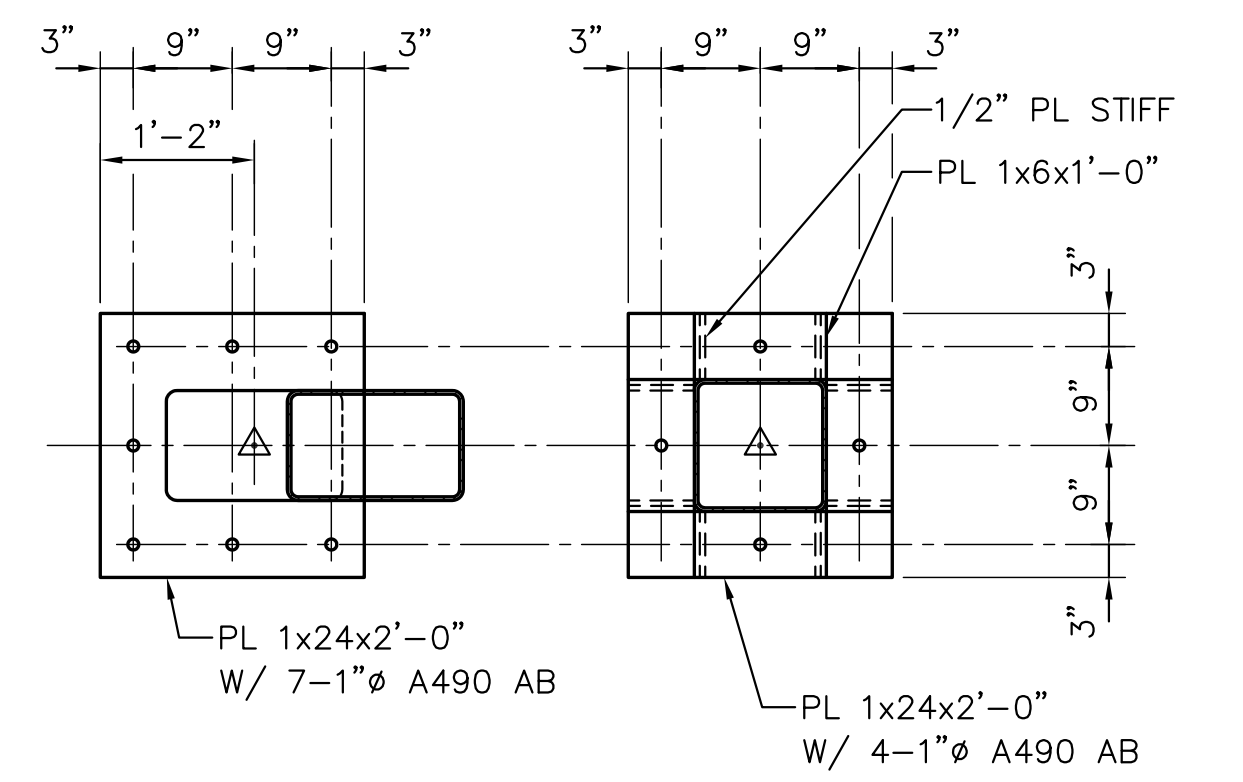

4 SECTION
SCALE: 3/4"=1'-0"

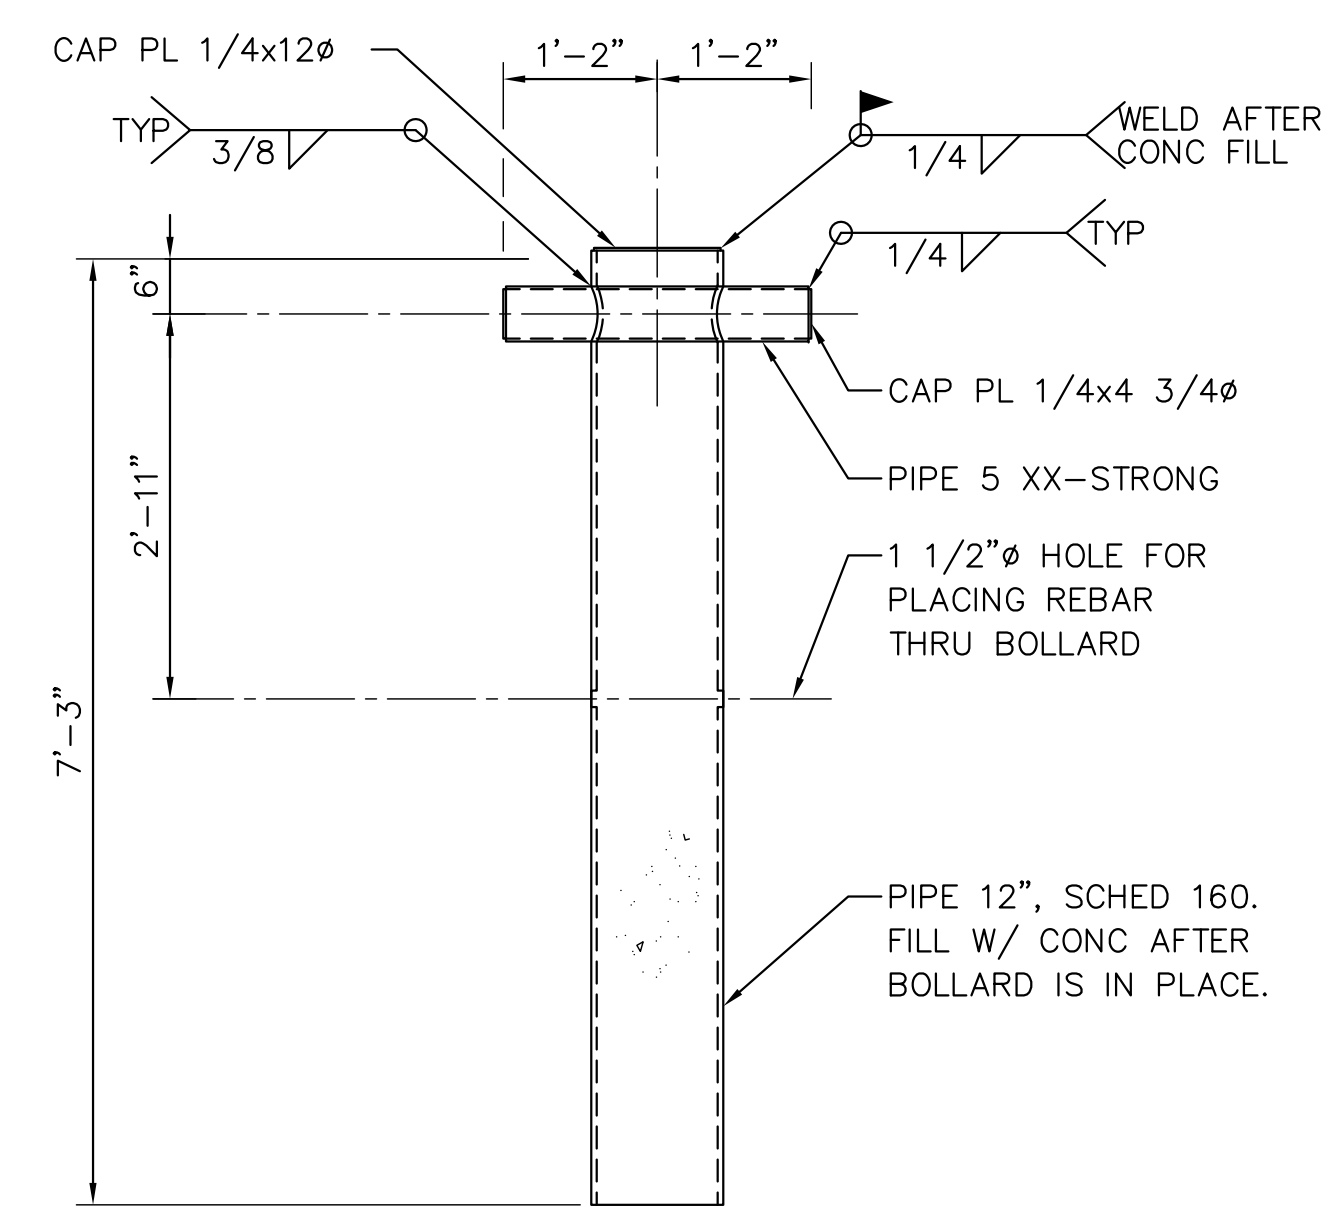

7 DETAIL - PERMANENT BOLLARD
SCALE: 3/4"=1'-0"

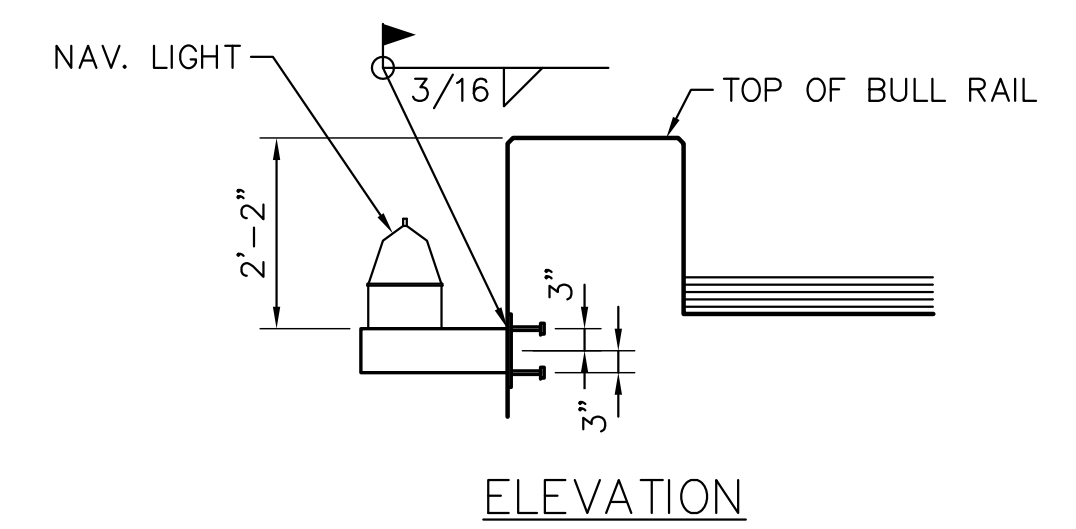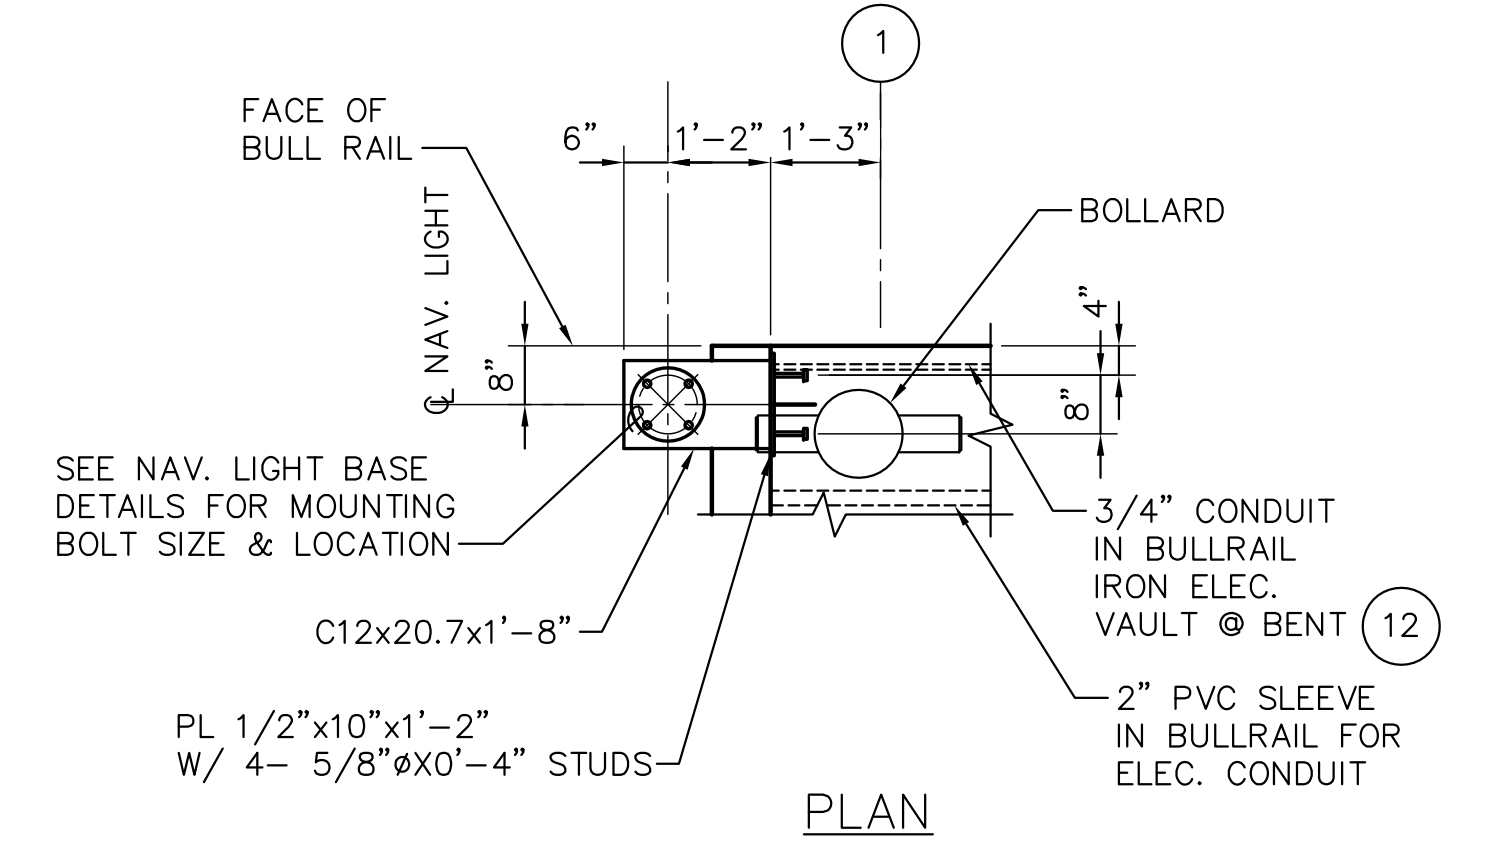

8 DETAIL - NAVIGATION LIGHT
SCALE: 3/4"=1'-0"



PORT OF TACOMA
P.O. BOX 1837 TACOMA, WASHINGTON 98401
(206) 383-5841

BERGER/ABAM
ENGINEERS INC.
33301 9TH AVENUE SOUTH
FEDERAL WAY, WASHINGTON 98003-6395
(206) 431-2300 FAX: (206) 431-2250


APPROVED
DATE
CURTIS L. RATCLIFFE P.E.
CHIEF ENGINEER

BTH 9/91
DRAWN BY DATE
DESIGNED BY DATE
BCM 9/91
CHECKED BY DATE
JAS 9/91
PROJ ENGR DATE

MARK	REVISION	BY	APP.	DATE
AS-BUILT				


HYUNDAI MERCHANT MARINE TERMINAL WHARF
PORT OF TACOMA
MISCELLANEOUS STEEL DETAILS

AS-BUILT
AUTOCAD FILE NO. 5012S39
DRAWING NO. EP-5012-26
CONTRACT NO. 978038
SHEET NO. 50 OF 58

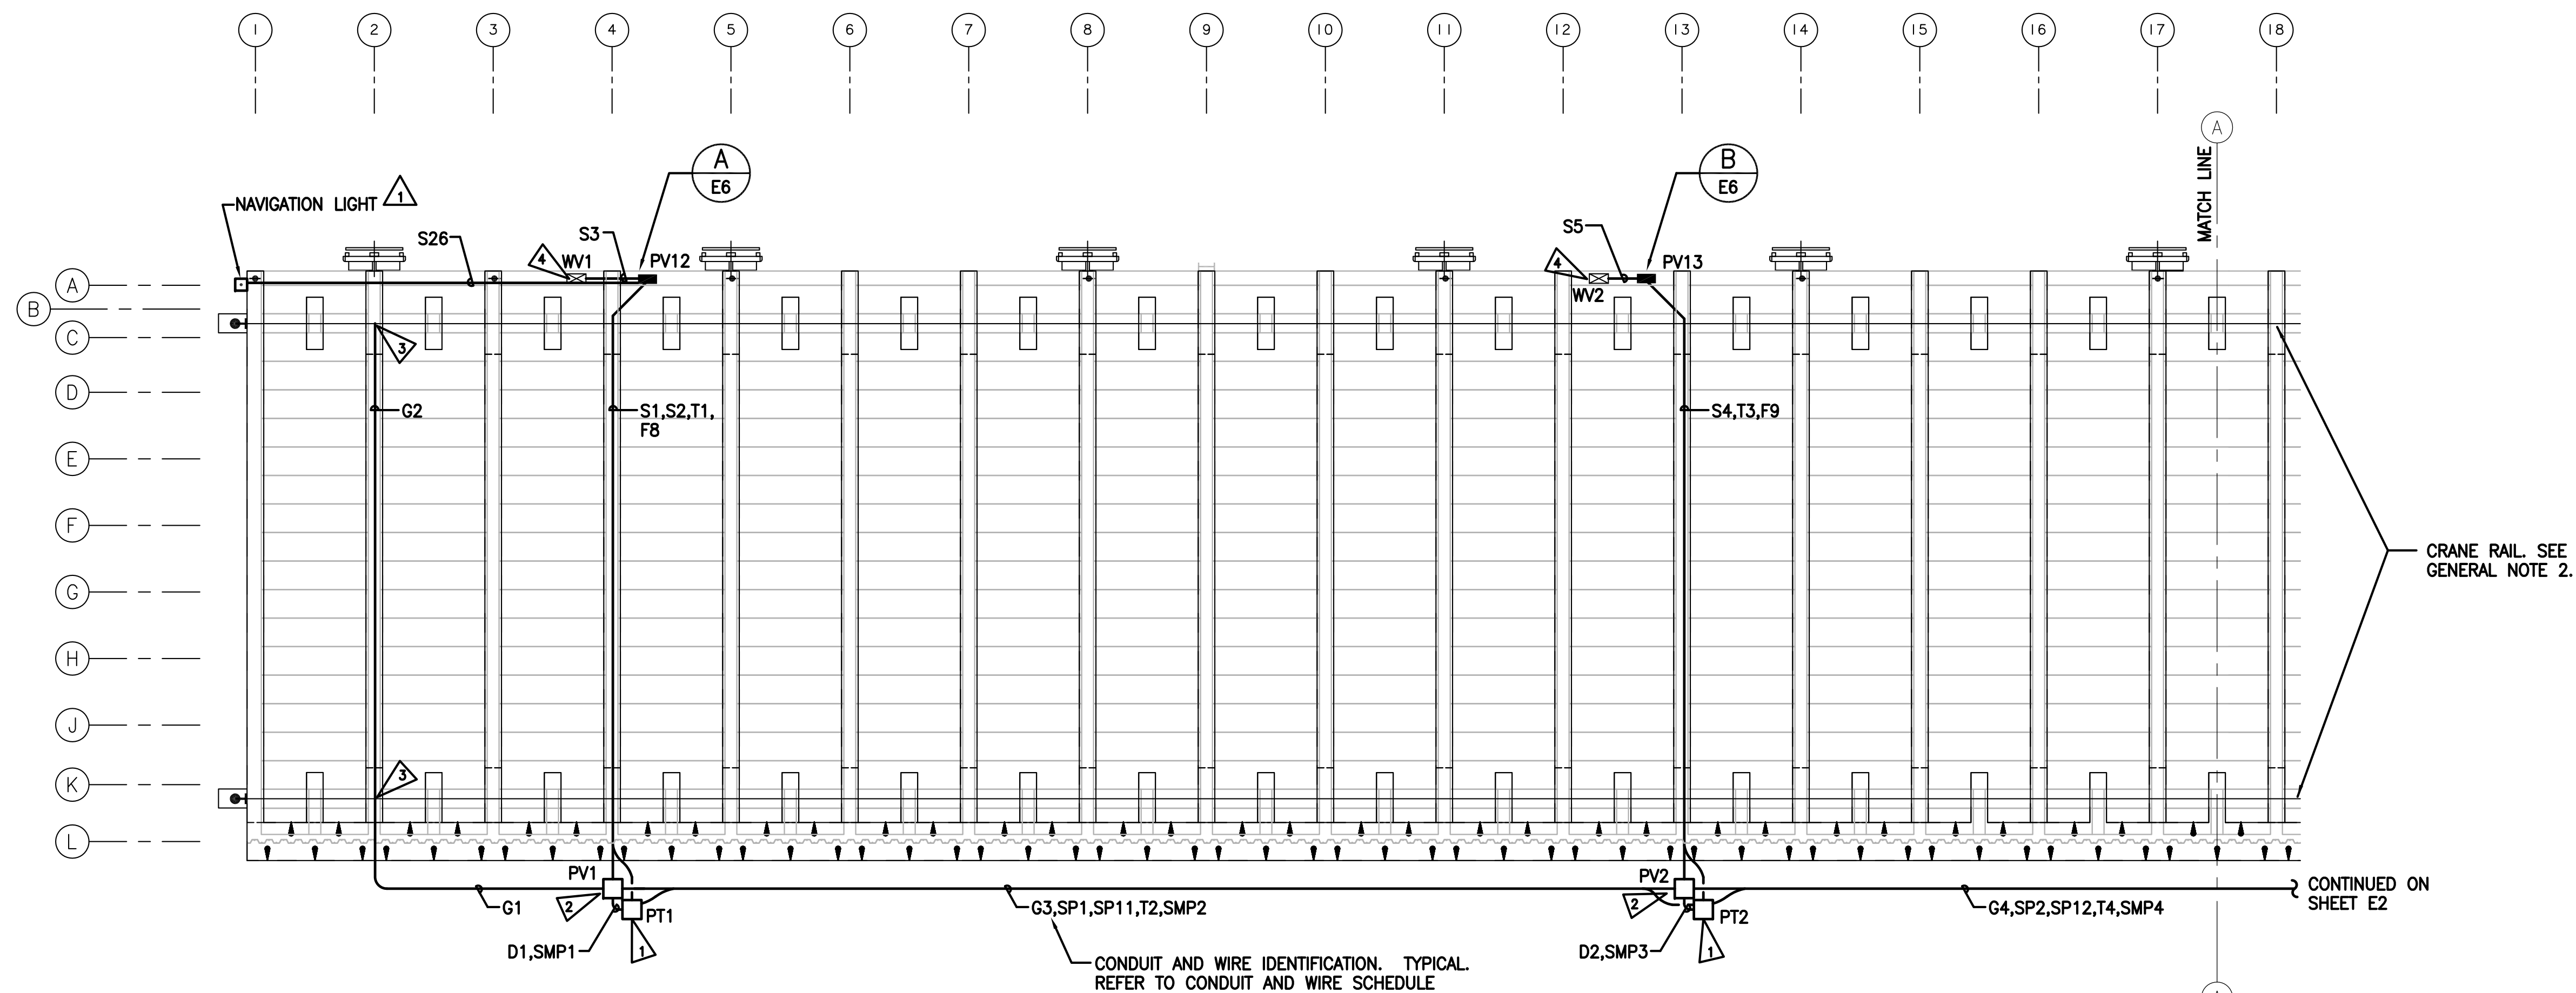

PARTIAL WHARF ELECTRICAL PLAN

SCALE: 1"=20'-0"

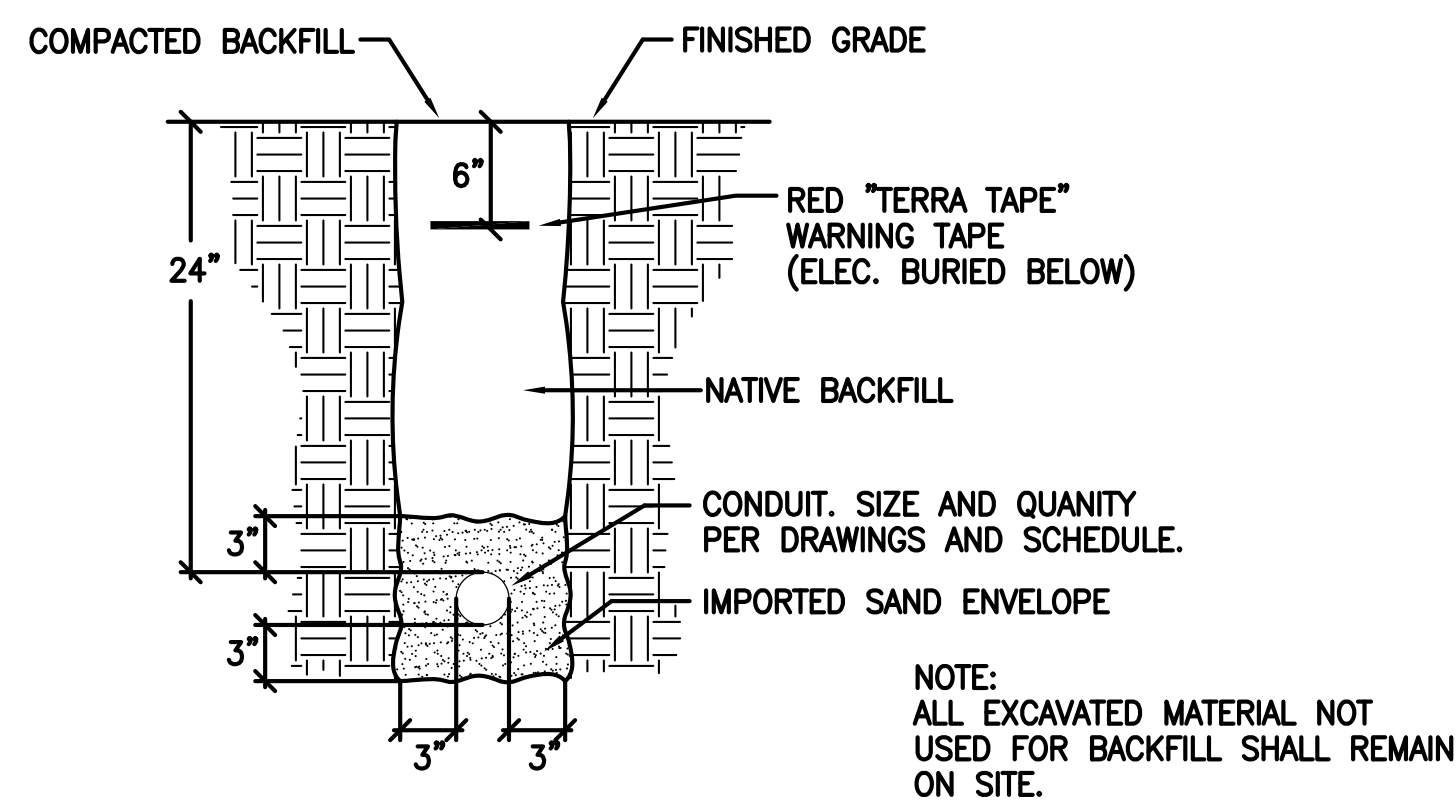

TYPICAL CONDUIT TRENCHING
NO SCALE

ELECTRICAL NOTES:

- 1 TELEPHONE VAULTS PT1 THRU PT11 SHALL BE SIMILAR TO PIPE INC., #4484 TCA. VAULT, COVER AND LID SHALL BE DESIGNED FOR 100 KIP WHEEL LOAD (100 PSI TIRE PRESSURE). PROVIDE VAULTS WITH GALVANIZED "C" CHANNEL FOR MOUNTING ON ALL SIDES, GALVANIZED PULLING IRONS, BONDING RIBBON, AND ENTRY LADDER. THE CENTER LINE OF THE VAULT SHALL BE 11'-0" FROM GRID LINE L. PROVIDE 12" PEA GRAVEL BED UNDER AND AROUND ALL VAULTS.
- 2 POWER VAULTS PV1 THRU PV11 SHALL BE SIMILAR TO PIPE 44600. VAULT COVER AND LID SHALL BE DESIGNED FOR 100 KIP WHEEL LOAD (100 PSI TIRE PRESSURE). PROVIDE WITH 8"x3/4" DIAMETER COPPER GLAD STEEL GROUND ROD AND 4"x1/2"x12" L COPPER GROUND BUS, PROVIDE WITH 6 SCREW LUGS, SIZED FOR #10 THRU #4 CU CONDUCTORS. CENTERLINE OF POWER VAULT SHALL BE 6'-6" FROM GRID LINE L. PROVIDE 12" PEA GRAVEL BED UNDER ALL VAULTS.
- 3 PROVIDE EXOTHERMIC WELDS FOR GROUND CONNECTION AT CRANE RAILS.
- 4 PROVIDE A MINIMUM OF 60' OF RAYCHEM XL-TRACE SERIES HEAT TAPE, 240V, 8 WATTS PER LINEAR FOOT TO WRAP WATER PIPE. USE SPIRAL WRAP ON PIPE AND WRAP VALVES PER MANUFACTURERS RECOMMENDATIONS.

GENERAL NOTES:

1. PROVIDE REMOVABLE FOAM FILL IN ALL CONDUIT OPENINGS.
2. PROVIDE 1" GRS-(1)#4 CU GRD FROM CRANE RAIL TO EACH CRANE PIN SOCKET, POWER VAULT, AND THE CRANE CABLE SLOTS. PROVIDE EXOTHERMIC WELD FOR ALL CONNECTIONS OF THE GROUND WIRE. THESE ARE NOT SHOWN ON THIS DRAWING, REVIEW STRUCTURAL DRAWINGS FOR EXACT LOCATION OF EQUIPMENT.
3. ALL CONDUIT IN WHARF BALLAST AREA SHALL BE PVC COATED GRS.
4. PROVIDE FLEXIBLE CONDUIT TRANSITION BETWEEN WHARF AND SITE FOR ALL CONDUITS.
5. ALL CONDUITS IN POWER VAULTS, WHARF UTILITY VAULTS AND TELEPHONE VAULTS SHALL BE PROVIDED WITH BELL ENDS.
6. COUPLINGS AND JOINTS OF CONDUITS EMBEDDED IN CONCRETE SHALL BE TAPED OR OTHERWISE MADE WATERTIGHT TO PREVENT INTRUSION OF MORTAR OR OTHER OBSTRUCTIONS, TEST CONDUIT FOR ABSENCE OF ANY BLOCKAGE WITHIN 24 HOURS OF COMPLETING THE CONCRETE POUR.

AS-BUILT

AUTOCAD FILE NO. 5012E1	E1
DRAWING NO. EP-5012-26	
CONTRACT NO. 978038	
SHEET NO. 51 OF 58	




PORT OF TACOMA
P.O. BOX 1837 TACOMA, WASHINGTON 98401
(206) 383-5841


CROSS ENGINEERS, INC.
290 South Fifth St. (253) 383-2544
Tacoma, Washington 98402 (FAX) 272-5848
Cross@halyon.com

APPROVED	NEA 9/23/91	GLW/JAB 9/23/91	AS-BUILT	RNG	GLW	1/4/99
DATE	DRAWN BY	CHECKED BY	MARK	REVISION	BY	APP. DATE
CURTIS L. RATCLIFFE P.E.	GLW 9/23/91	GLW 9/23/91				
CHIEF ENGINEER	DESIGNED BY	PROJ ENGR				

**HYUNDAI MERCHANT MARINE TERMINAL
WHARF
PORT OF TACOMA
PARTIAL ELECTRICAL PLAN**

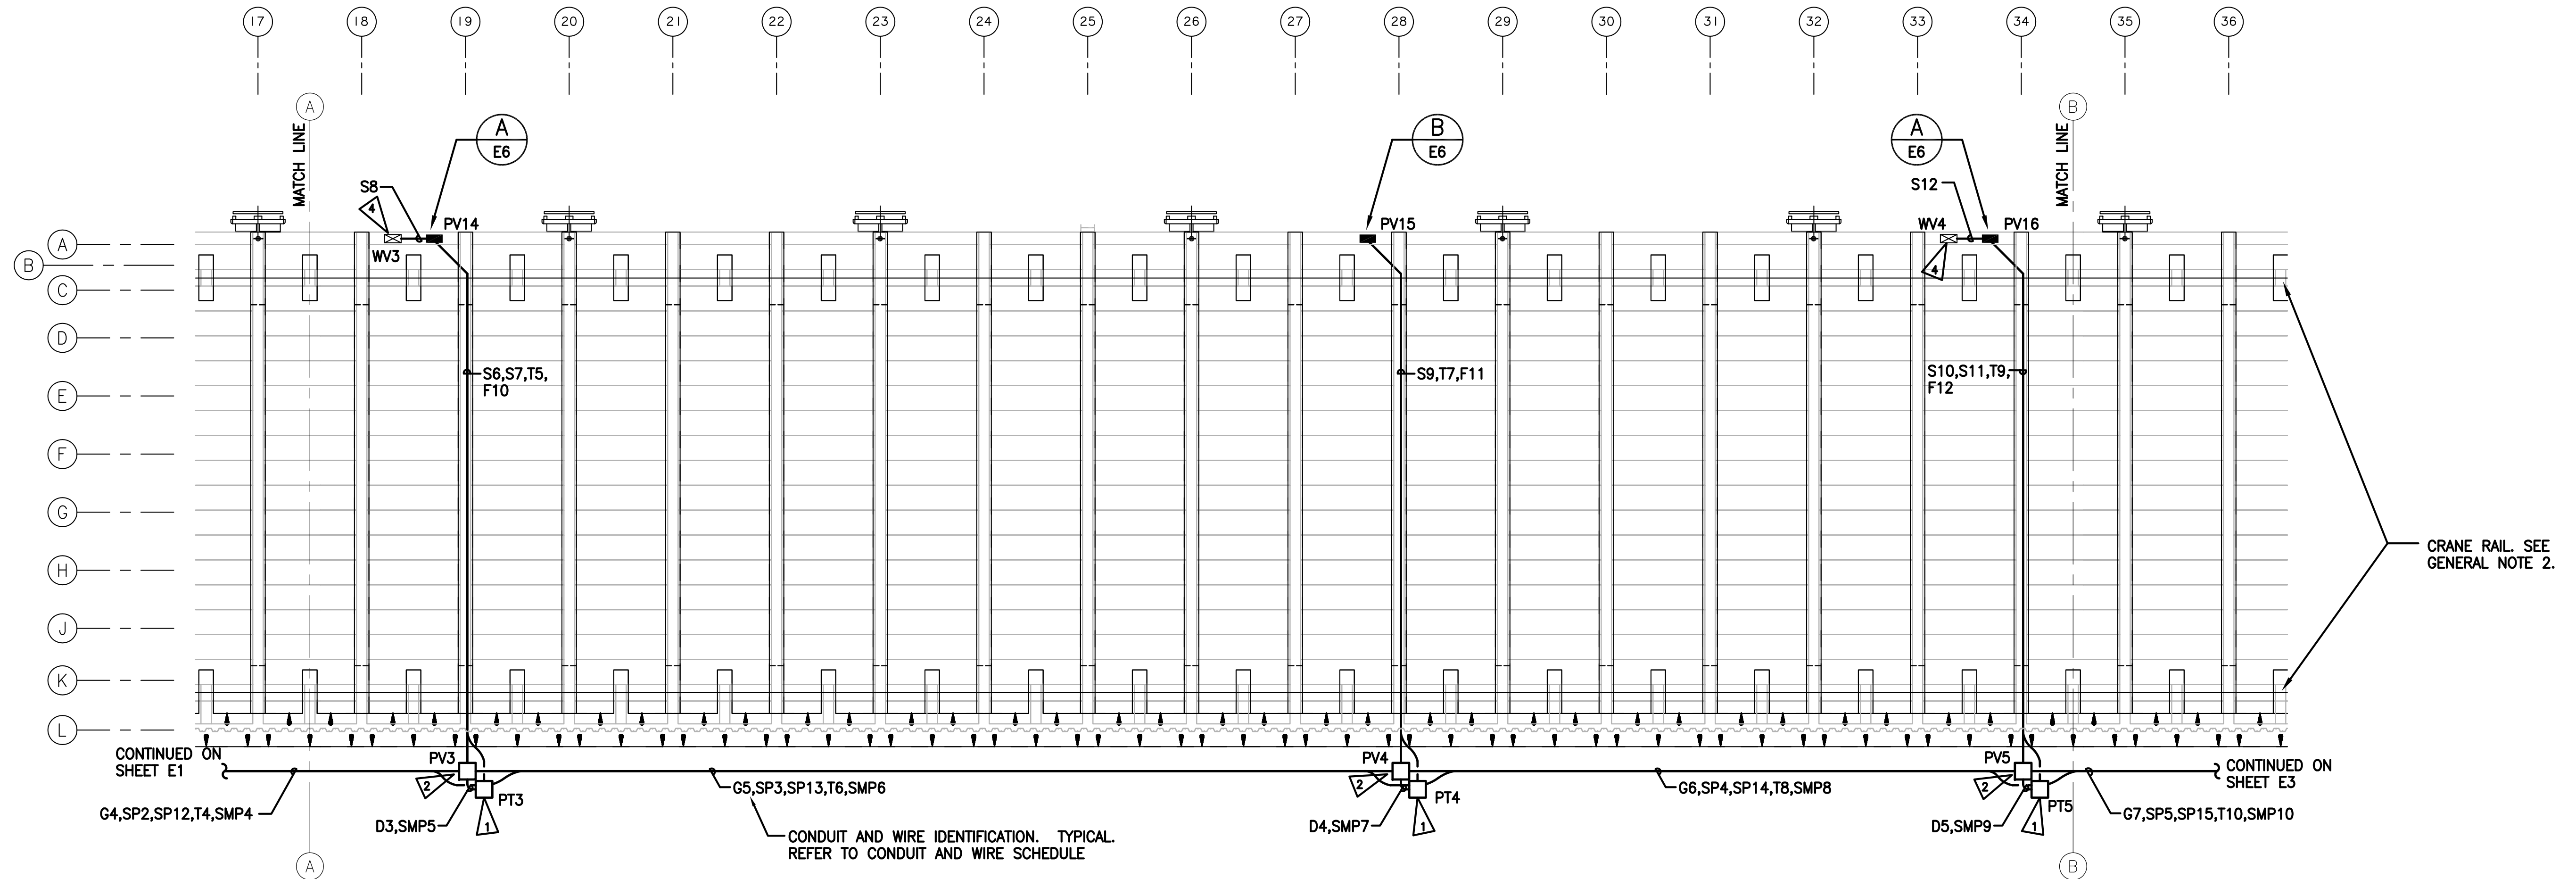

PARTIAL WHARF ELECTRICAL PLAN
SCALE: 1"=20'-0"

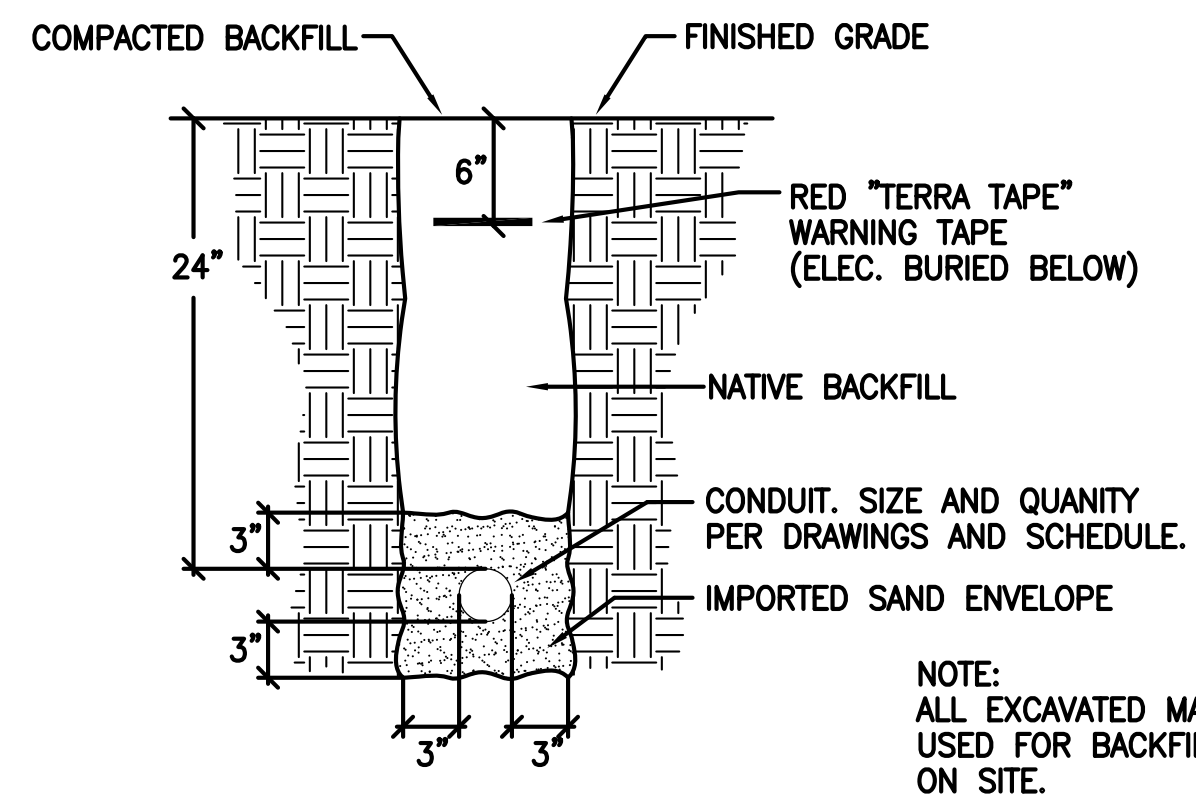

TYPICAL CONDUIT TRENCHING
NO SCALE

ELECTRICAL NOTES:

- 1 TELEPHONE VAULTS PT1 THRU PT11 SHALL BE SIMILAR TO PIPE INC., #4484 TCA. VAULT, COVER AND LID SHALL BE DESIGNED FOR 100 KIP WHEEL LOAD (100 PSI TIRE PRESSURE). PROVIDE VAULTS WITH GALVANIZED "C" CHANNEL FOR MOUNTING ON ALL SIDES, GALVANIZED PULLING IRONS, BONDING RIBBON, AND ENTRY LADDER. THE CENTER LINE OF THE VAULT SHALL BE 11'-0" FROM GRID LINE L. PROVIDE 12" PEA GRAVEL BED UNDER AND AROUND ALL VAULTS.
- 2 POWER VAULTS PV1 THRU PV11 SHALL BE SIMILAR TO PIPE 44600. VAULT COVER AND LID SHALL BE DESIGNED FOR 100 KIP WHEEL LOAD (100 PSI TIRE PRESSURE). PROVIDE WITH 8"x3/4" DIAMETER COPPER CLAD STEEL GROUND ROD AND 4"x1/2"x12" L COPPER GROUND BUS, PROVIDE WITH 6 SCREW LUGS, SIZED FOR #10 THRU #4 CU CONDUCTORS. CENTERLINE OF POWER VAULT SHALL BE 6'-6" FROM GRID LINE L. PROVIDE 12" PEA GRAVEL BED UNDER ALL VAULTS.
- 3 NOT USED
- 4 PROVIDE A MINIMUM OF 60' OF RAYCHEM XL-TRACE SERIES HEAT TAPE, 240V, 8 WATTS PER LINEAR FOOT TO WRAP WATER PIPE. USE SPIRAL WRAP ON PIPE AND WRAP VALVES PER MANUFACTURERS RECOMMENDATIONS.

GENERAL NOTES:

1. PROVIDE REMOVABLE FOAM FILL IN ALL CONDUIT OPENINGS.
2. PROVIDE 1" GRS-(1)#4 CU GRD FROM CRANE RAIL TO EACH CRANE PIN SOCKET, POWER VAULT, AND THE CRANE CABLE SLOTS. PROVIDE EXOTHERMIC WELD FOR ALL CONNECTIONS OF THE GROUND WIRE. THESE ARE NOT SHOWN ON THIS DRAWING, REVIEW STRUCTURAL DRAWINGS FOR EXACT LOCATION OF EQUIPMENT.
3. ALL CONDUIT IN WHARF BALLAST AREA SHALL BE PVC COATED GRS.
4. PROVIDE FLEXIBLE CONDUIT TRANSITION BETWEEN WHARF AND SITE FOR ALL CONDUITS.
5. ALL CONDUITS IN POWER VAULTS, WHARF UTILITY VAULTS AND TELEPHONE VAULTS SHALL BE PROVIDED WITH BELL ENDS.
6. COUPLINGS AND JOINTS OF CONDUITS EMBEDDED IN CONCRETE SHALL BE TAPED OR OTHERWISE MADE WATERTIGHT TO PREVENT INTRUSION OF MORTAR OR OTHER OBSTRUCTIONS, TEST CONDUIT FOR ABSENCE OF ANY BLOCKAGE WITHIN 24 HOURS OF COMPLETING THE CONCRETE POUR.

AS-BUILT

AUTOCAD FILE NO. 5012E2	E2
DRAWING NO. EP-5012-26	
CONTRACT NO. 978038	
SHEET NO. 52 OF 58	




PORT OF TACOMA
P.O. BOX 1837 TACOMA, WASHINGTON 98401
(206) 383-5841


CROSS ENGINEERS, INC.
290 South Fifth St. (253) 383-2544
Tacoma, Washington 98402 (FAX) 272-5848
Cross@tacoyon.com

APPROVED	NEA 9/23/91	GLW/JAB 9/23/91	AS-BUILT	RNG	GLW	1/4/99
DATE	DRAWN BY	CHECKED BY	MARK	REVISION	BY	APP. DATE
CURTIS L. RATCLIFFE P.E.	GLW 9/23/91	GLW 9/23/91				
CHIEF ENGINEER	DESIGNED BY	PROJ ENGR				

**HYUNDAI MERCHANT MARINE TERMINAL
WHARF
PORT OF TACOMA
PARTIAL ELECTRICAL PLAN**

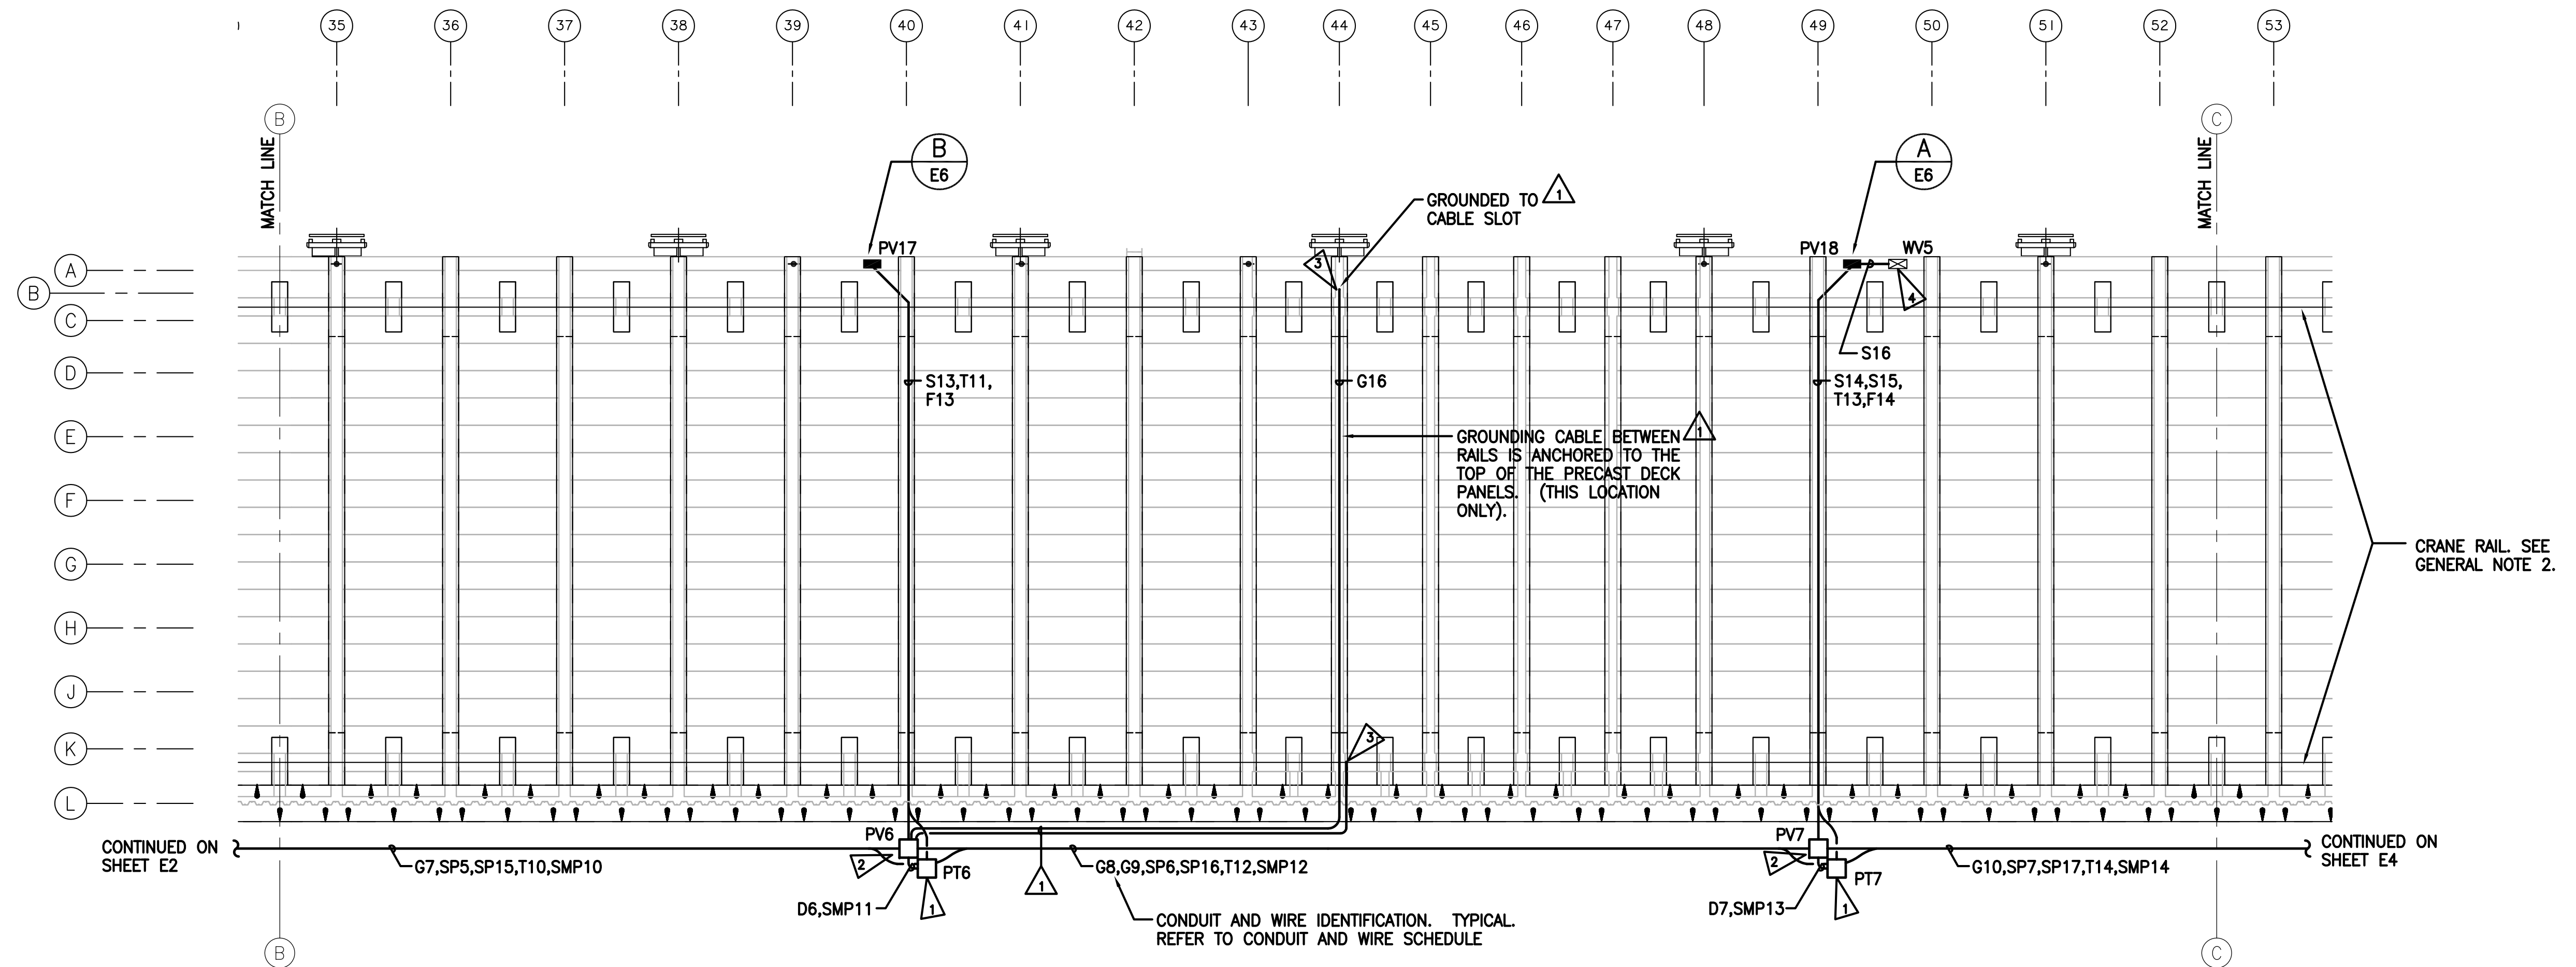

PARTIAL WHARF ELECTRICAL PLAN
SCALE: 1"=20'-0" N

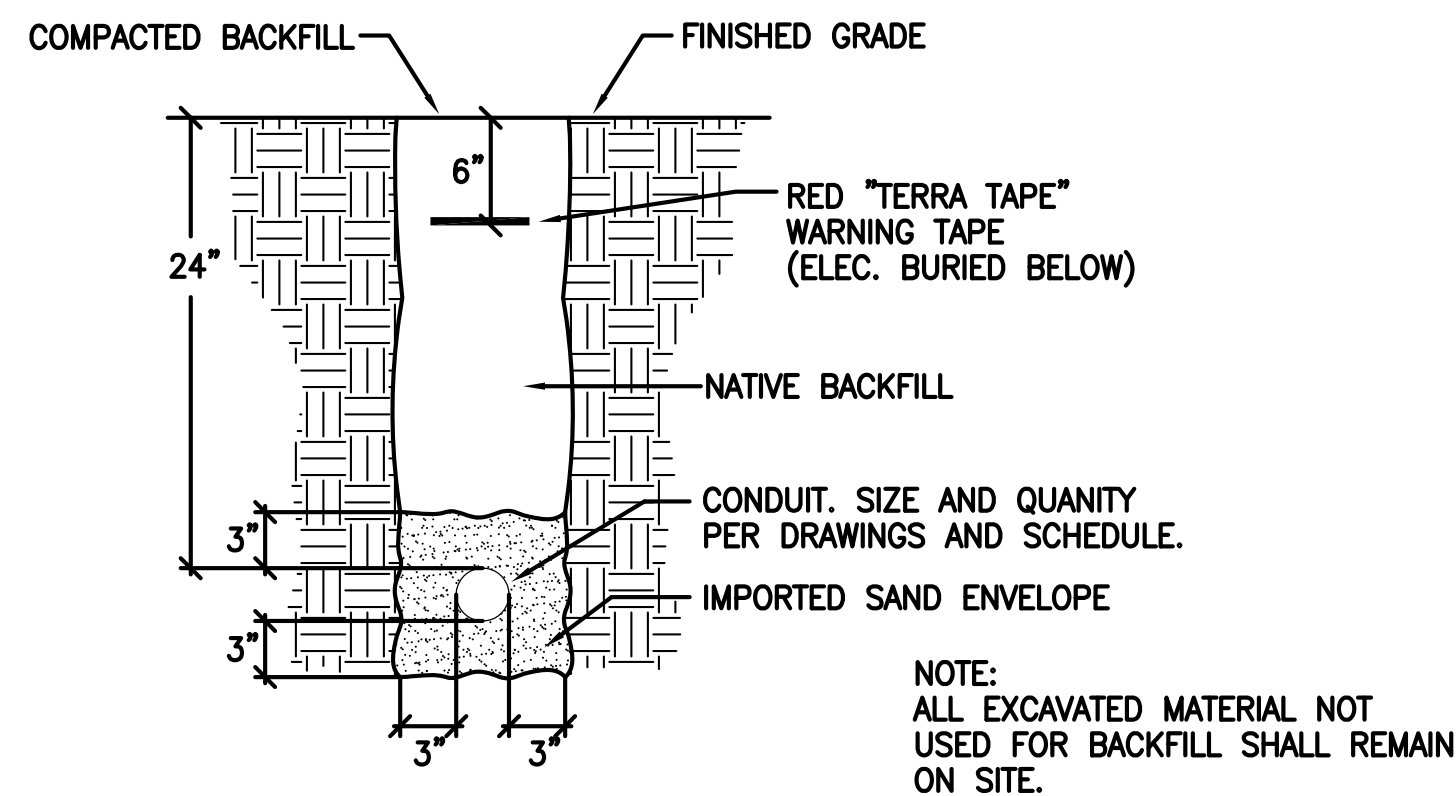

TYPICAL CONDUIT TRENCHING
NO SCALE

ELECTRICAL NOTES:

- 1 TELEPHONE VAULTS PT1 THRU PT11 SHALL BE SIMILAR TO PIPE INC., #4484 TCA. VAULT, COVER AND LID SHALL BE DESIGNED FOR 100 KIP WHEEL LOAD (100 PSI TIRE PRESSURE). PROVIDE VAULTS WITH GALVANIZED "C" CHANNEL FOR MOUNTING ON ALL SIDES, GALVANIZED PULLING IRONS, BONDING RIBBON, AND ENTRY LADDER. THE CENTER LINE OF THE VAULT SHALL BE 11'-0" FROM GRID LINE L. PROVIDE 12" PEA GRAVEL BED UNDER AND AROUND ALL VAULTS.
- 2 POWER VAULTS PV1 THRU PV11 SHALL BE SIMILAR TO PIPE 44600. VAULT COVER AND LID SHALL BE DESIGNED FOR 100 KIP WHEEL LOAD (100 PSI TIRE PRESSURE). PROVIDE WITH 8"x3/4" DIAMETER COPPER CLAD STEEL GROUND ROD AND 4"x1/2"x12" L COPPER GROUND BUS, PROVIDE WITH 6 SCREW LUGS, SIZED FOR #10 THRU #4 CU CONDUCTORS. CENTERLINE OF POWER VAULT SHALL BE 6'-6" FROM GRID LINE L. PROVIDE 12" PEA GRAVEL BED UNDER ALL VAULTS.
- 3 PROVIDE EXOTHERMIC WELDS FOR GROUND CONNECTION AT CRANE RAILS.
- 4 PROVIDE A MINIMUM OF 60' OF RAYCHEM XL-TRACE SERIES HEAT TAPE, 240V, 8 WATTS PER LINEAR FOOT TO WRAP WATER PIPE. USE SPIRAL WRAP ON PIPE AND WRAP VALVES PER MANUFACTURERS RECOMMENDATIONS.

GENERAL NOTES:

1. PROVIDE REMOVABLE FOAM FILL IN ALL CONDUIT OPENINGS.
2. PROVIDE 1" GRS-(1)#4 CU GRD FROM CRANE RAIL TO EACH CRANE PIN SOCKET, POWER VAULT, AND THE CRANE CABLE SLOTS. PROVIDE EXOTHERMIC WELD FOR ALL CONNECTIONS OF THE GROUND WIRE. THESE ARE NOT SHOWN ON THIS DRAWING, REVIEW STRUCTURAL DRAWINGS FOR EXACT LOCATION OF EQUIPMENT.
3. ALL CONDUIT IN WHARF BALLAST AREA SHALL BE PVC COATED GRS.
4. PROVIDE FLEXIBLE CONDUIT TRANSITION BETWEEN WHARF AND SITE FOR ALL CONDUITS.
5. ALL CONDUITS IN POWER VAULTS, WHARF UTILITY VAULTS AND TELEPHONE VAULTS SHALL BE PROVIDED WITH BELL ENDS.
6. COUPLINGS AND JOINTS OF CONDUITS EMBEDDED IN CONCRETE SHALL BE TAPED OR OTHERWISE MADE WATERTIGHT TO PREVENT INTRUSION OF MORTAR OR OTHER OBSTRUCTIONS, TEST CONDUIT FOR ABSENCE OF ANY BLOCKAGE WITHIN 24 HOURS OF COMPLETING THE CONCRETE POUR.

AS-BUILT

AUTOCAD FILE NO. **5012E3** **E3**




PORT OF TACOMA
P.O. BOX 1837 TACOMA, WASHINGTON 98401
(206) 383-5841

CROSS ENGINEERS, INC.
280 South Fifth St. (253) 383-2544
Tacoma, Washington 98402 (FAX) 272-5848
Cross@tacoyon.com


APPROVED	NEA 9/23/91	GLW/JAB 9/23/91	AS-BUILT	RNG	GLW	1/4/99
DATE	DRAWN BY	CHECKED BY	MARK	REVISION	BY	APP. DATE
CURTIS L. RATCLIFFE P.E.	GLW 9/23/91	GLW 9/23/91				
CHIEF ENGINEER	DESIGNED BY	PROJ ENGR				

**HYUNDAI MERCHANT MARINE TERMINAL
WHARF
PORT OF TACOMA
PARTIAL ELECTRICAL PLAN**

DRAWING NO. **EP-5012-26**
CONTRACT NO. **978038**
SHEET NO. **53** OF **58**

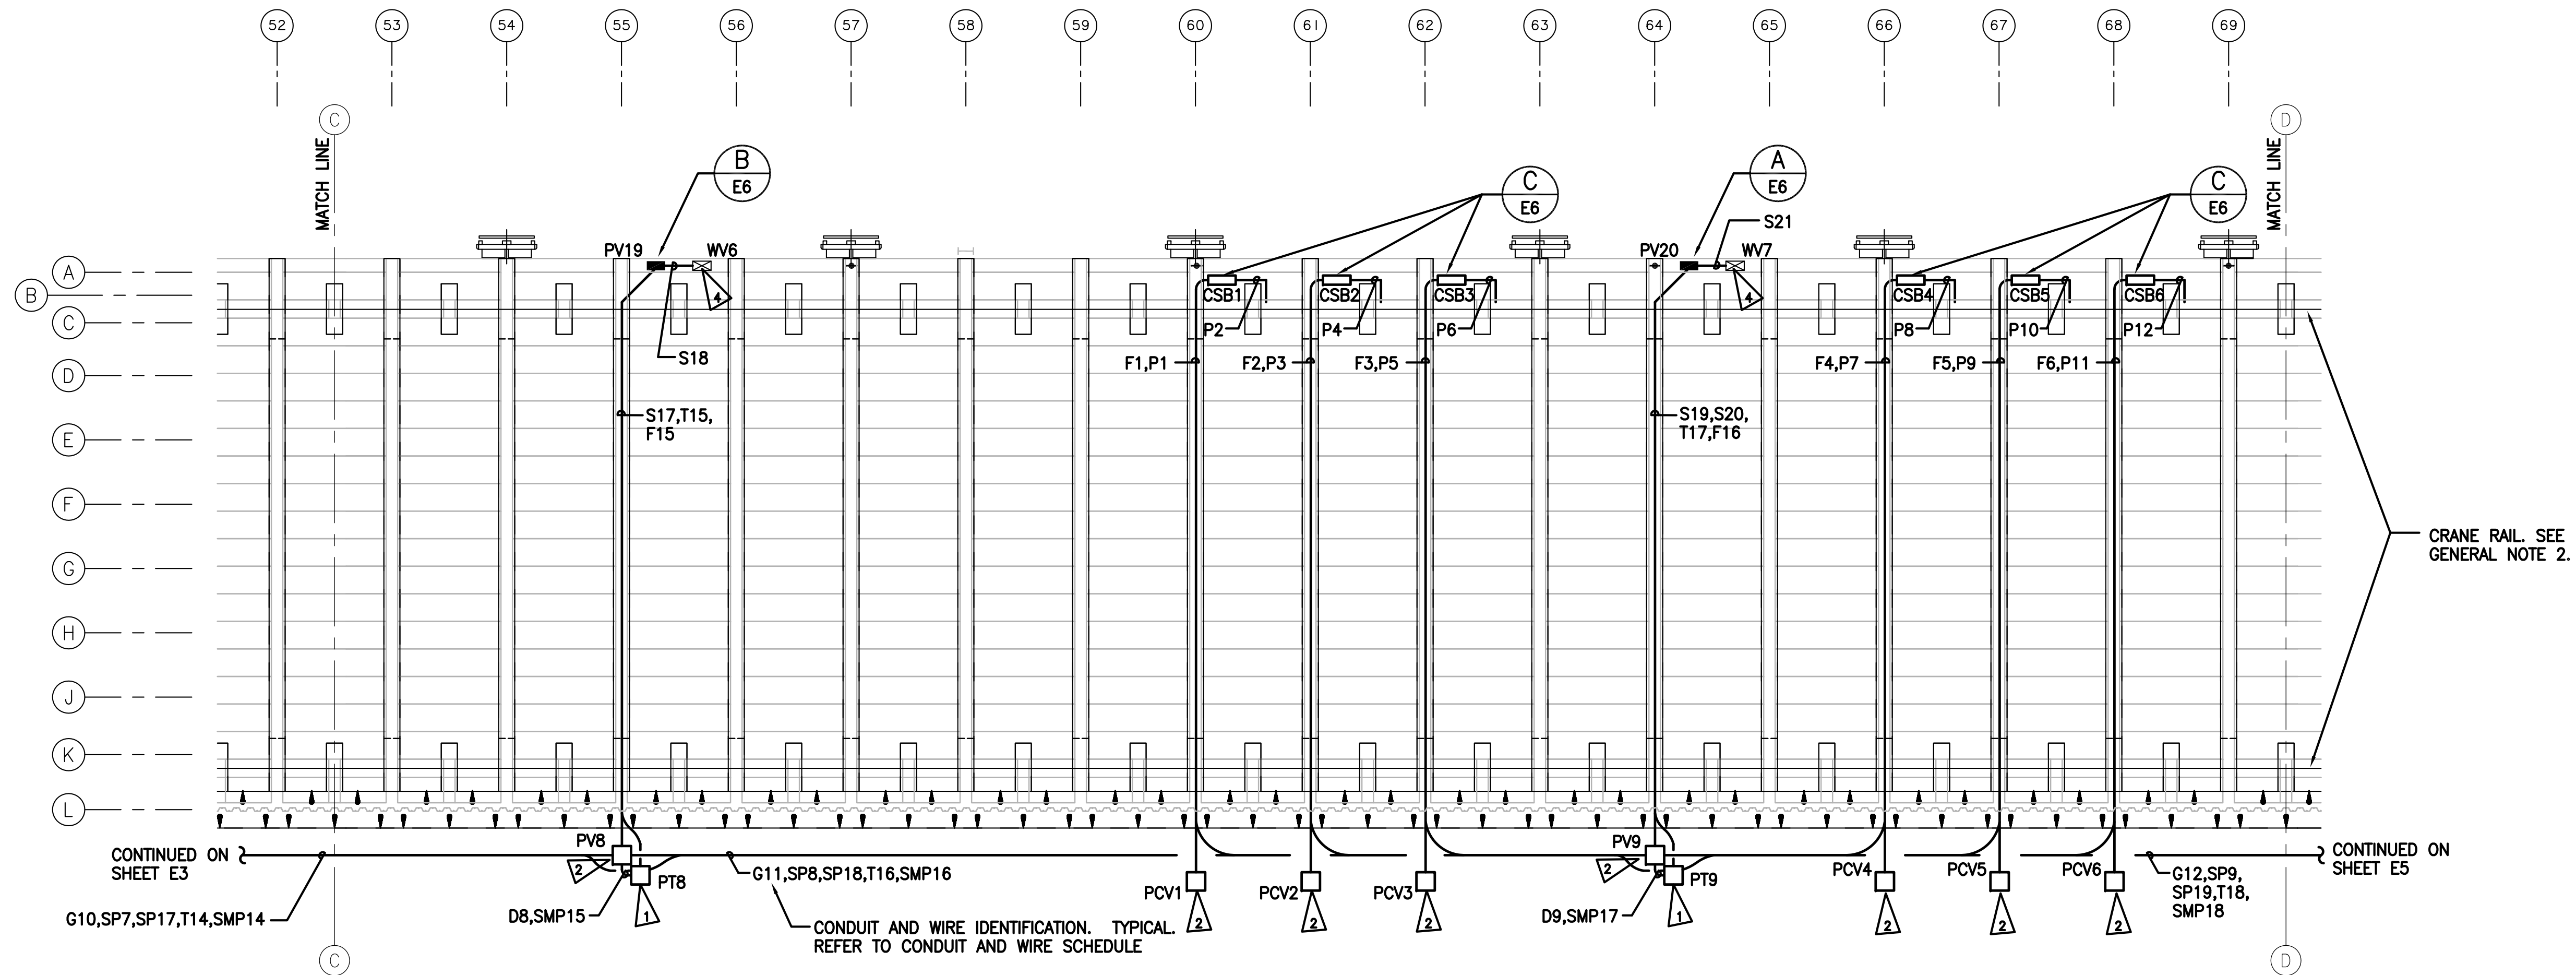

PARTIAL WHARF ELECTRICAL PLAN
 SCALE: 1"=20'-0" N

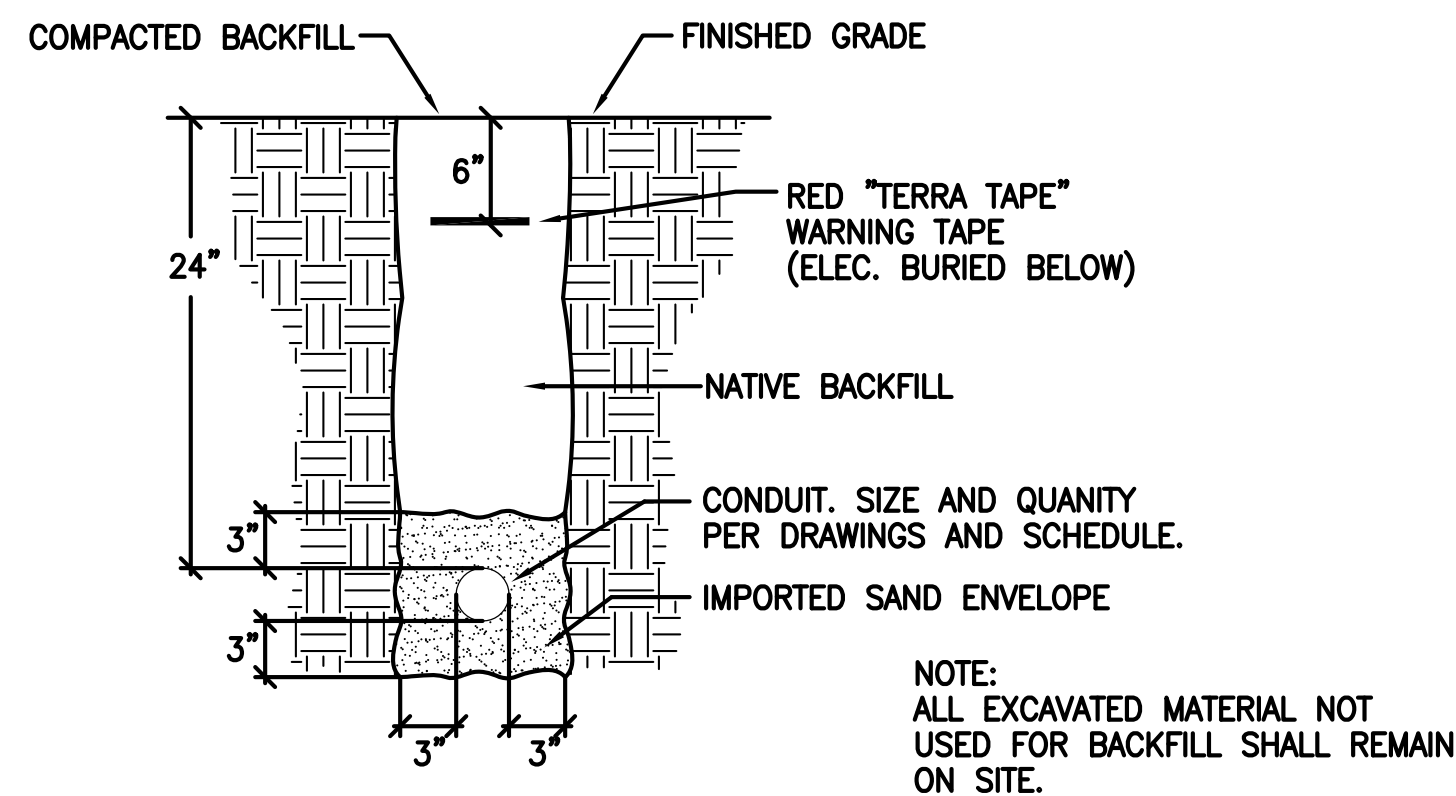

TYPICAL CONDUIT TRENCHING
 NO SCALE

ELECTRICAL NOTES:

- 1 TELEPHONE VAULTS PT1 THRU PT11 SHALL BE SIMILAR TO PIPE INC., #4484 TCA. VAULT, COVER AND LID SHALL BE DESIGNED FOR 100 KIP WHEEL LOAD (100 PSI TIRE PRESSURE). PROVIDE VAULTS WITH GALVANIZED "C" CHANNEL FOR MOUNTING ON ALL SIDES, GALVANIZED PULLING IRONS, BONDING RIBBON, AND ENTRY LADDER. THE CENTER LINE OF THE VAULT SHALL BE 11'-0" FROM GRID LINE L. PROVIDE 12" PEA GRAVEL BED UNDER AND AROUND ALL VAULTS.
- 2 POWER VAULTS PV1 THRU PV11 SHALL BE SIMILAR TO PIPE 44600. VAULT COVER AND LID SHALL BE DESIGNED FOR 100 KIP WHEEL LOAD (100 PSI TIRE PRESSURE). PROVIDE WITH 8"x3/4" DIAMETER COPPER CLAD STEEL GROUND ROD AND 4"x1/2"Wx12"L COPPER GROUND BUS, PROVIDE WITH 6 SCREW LUGS, SIZED FOR #10 THRU #4 CU CONDUCTORS. CENTERLINE OF POWER VAULT SHALL BE 6'-6" FROM GRID LINE L. PROVIDE 12" PEA GRAVEL BED UNDER ALL VAULTS.
- 3 NOT USED.
- 4 PROVIDE A MINIMUM OF 60' OF RAYCHEM XL-TRACE SERIES HEAT TAPE, 240V, 8 WATTS PER LINEAR FOOT TO WRAP WATER PIPE. USE SPIRAL WRAP ON PIPE AND WRAP VALVES PER MANUFACTURERS RECOMMENDATIONS.

GENERAL NOTES:

1. PROVIDE REMOVABLE FOAM FILL IN ALL CONDUIT OPENINGS.
2. PROVIDE 1" GRS-(1)#4 CU GRD FROM CRANE RAIL TO EACH CRANE PIN SOCKET, POWER VAULT, AND THE CRANE CABLE SLOTS. PROVIDE EXOTHERMIC WELD FOR ALL CONNECTIONS OF THE GROUND WIRE. THESE ARE NOT SHOWN ON THIS DRAWING, REVIEW STRUCTURAL DRAWINGS FOR EXACT LOCATION OF EQUIPMENT.
3. ALL CONDUIT IN WHARF BALLAST AREA SHALL BE PVC COATED GRS.
4. PROVIDE FLEXIBLE CONDUIT TRANSITION BETWEEN WHARF AND SITE FOR ALL CONDUITS.
5. ALL CONDUITS IN POWER VAULTS, WHARF UTILITY VAULTS AND TELEPHONE VAULTS SHALL BE PROVIDED WITH BELL ENDS.
6. COUPLINGS AND JOINTS OF CONDUITS EMBEDDED IN CONCRETE SHALL BE TAPED OR OTHERWISE MADE WATERTIGHT TO PREVENT INTRUSION OF MORTAR OR OTHER OBSTRUCTIONS, TEST CONDUIT FOR ABSENCE OF ANY BLOCKAGE WITHIN 24 HOURS OF COMPLETING THE CONCRETE POUR.

AS-BUILT

AUTOCAD FILE NO. **5012E4** **E4**



PORT OF TACOMA
 P.O. BOX 1837 TACOMA, WASHINGTON 98401
 (206) 383-5841

CROSS ENGINEERS, INC.
 290 South Fifth St. (253) 383-2544
 Tacoma, Washington 98402 (FAX) 272-5848
 Cross@tacoyon.com


APPROVED _____ DATE _____
CURTIS L. RATCLIFFE P.E.
 CHIEF ENGINEER

NEA 9/23/91 GLW/JAB 9/23/91
 DRAWN BY DATE CHECKED BY DATE
 GLW 9/23/91 GLW 9/23/91
 DESIGNED BY DATE PROJ ENGR DATE

MARK	REVISION	BY	APP.	DATE
AS-BUILT		RNG	GLW	1/4/99

**HYUNDAI MERCHANT MARINE TERMINAL
 WHARF
 PORT OF TACOMA
 PARTIAL ELECTRICAL PLAN**

DRAWING NO. **EP-5012-26**
 CONTRACT NO. **978038**
 SHEET NO. **54** OF **58**

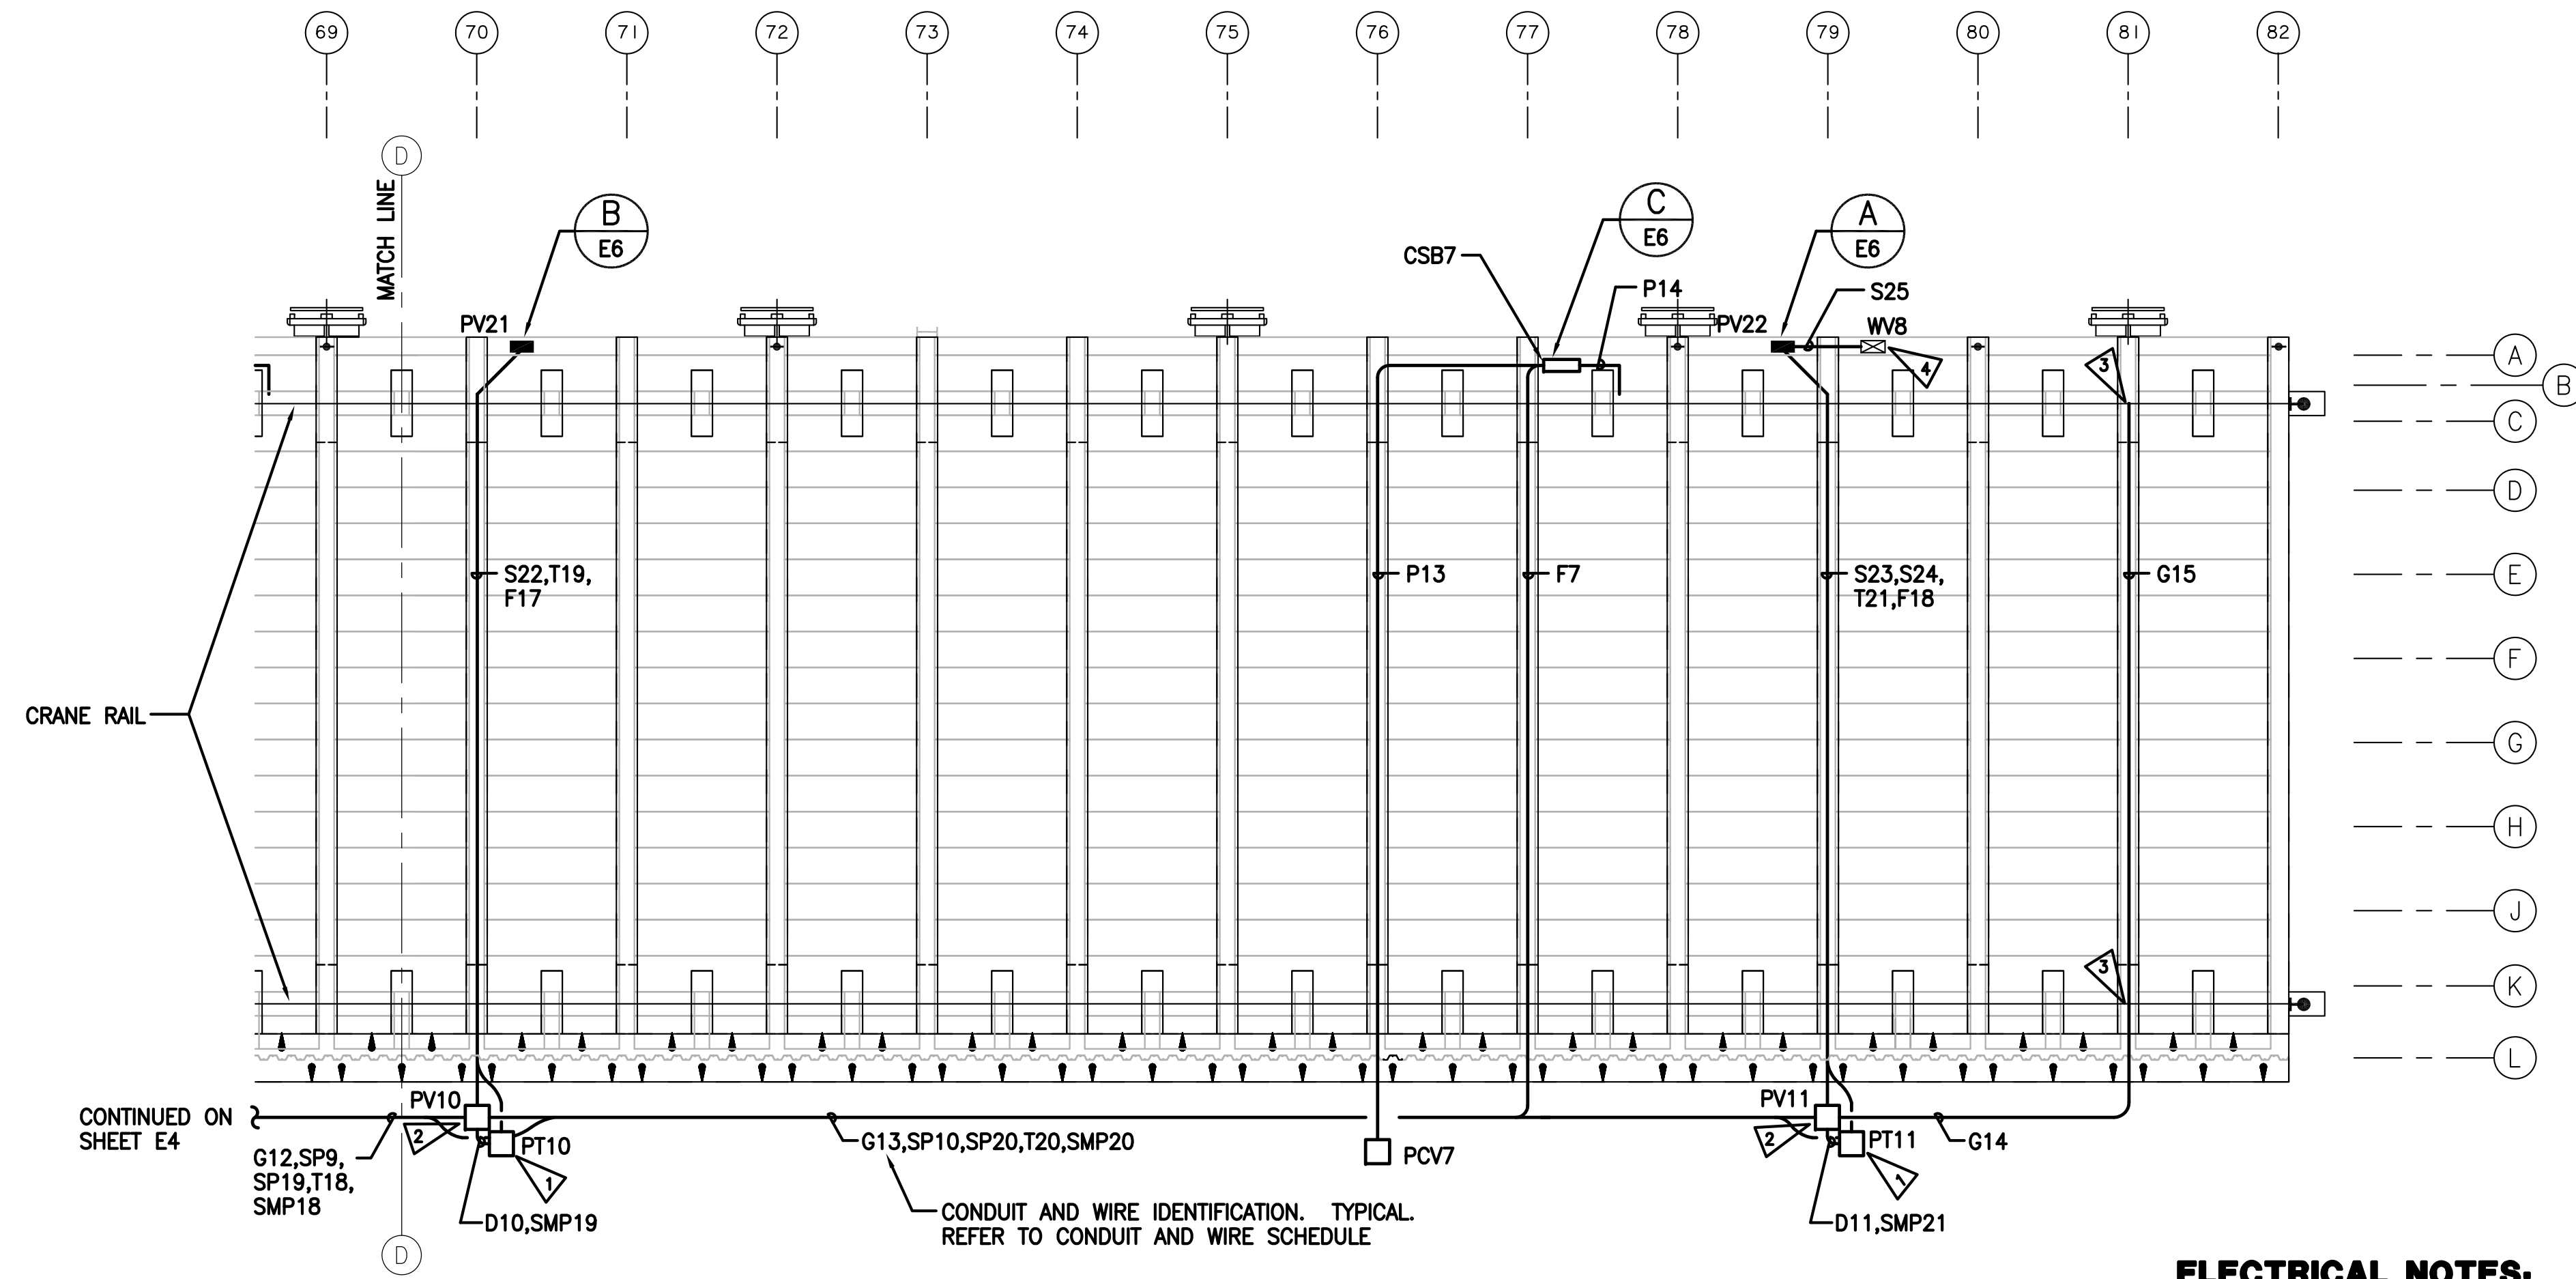


PARTIAL WHARF ELECTRICAL PLAN
SCALE: 1"=20'-0" N

ELECTRICAL NOTES:

- 1 TELEPHONE VAULTS PT1 THRU PT11 SHALL BE SIMILAR TO PIPE INC., #4484 TCA. VAULT, COVER AND LID SHALL BE DESIGNED FOR 100 KIP WHEEL LOAD (100 PSI TIRE PRESSURE). PROVIDE VAULTS WITH GALVANIZED "C" CHANNEL FOR MOUNTING ON ALL SIDES, GALVANIZED PULLING IRONS, BONDING RIBBON, AND ENTRY LADDER. THE CENTER LINE OF THE VAULT SHALL BE 11'-0" FROM GRID LINE L. PROVIDE 12" PEA GRAVEL BED UNDER AND AROUND ALL VAULTS.
- 2 POWER VAULTS PV1 THRU PV11 SHALL BE SIMILAR TO PIPE 44600. VAULT COVER AND LID SHALL BE DESIGNED FOR 100 KIP WHEEL LOAD (100 PSI TIRE PRESSURE). PROVIDE WITH 8"x3/4" DIAMETER COPPER CLAD STEEL GROUND ROD AND 4"x1/2"Wx12"L COPPER GROUND BUS, PROVIDE WITH 6 SCREW LUGS, SIZED FOR #10 THRU #4 CU CONDUCTORS. CENTERLINE OF POWER VAULT SHALL BE 6'-6" FROM GRID LINE L. PROVIDE 12" PEA GRAVEL BED UNDER ALL VAULTS.
- 3 PROVIDE EXOTHERMIC WELDS FOR GROUND CONNECTION AT CRANE RAILS.
- 4 PROVIDE A MINIMUM OF 60' OF RAYCHEM XL-TRACE SERIES HEAT TAPE, 240V, 8 WATTS PER LINEAR FOOT TO WRAP WATER PIPE. USE SPIRAL WRAP ON PIPE AND WRAP VALVES PER MANUFACTURERS RECOMMENDATIONS.

GENERAL NOTES:

1. PROVIDE REMOVABLE FOAM FILL IN ALL CONDUIT OPENINGS.
2. PROVIDE 1" GRS-(1)#4 CU GRD FROM CRANE RAIL TO EACH CRANE PIN SOCKET, POWER VAULT, AND THE CRANE CABLE SLOTS. PROVIDE EXOTHERMIC WELD FOR ALL CONNECTIONS OF THE GROUND WIRE. THESE ARE NOT SHOWN ON THIS DRAWING, REVIEW STRUCTURAL DRAWINGS FOR EXACT LOCATION OF EQUIPMENT.
3. ALL CONDUIT IN WHARF BALLAST AREA SHALL BE PVC COATED GRS.
4. PROVIDE FLEXIBLE CONDUIT TRANSITION BETWEEN WHARF AND SITE FOR ALL CONDUITS.
5. ALL CONDUITS IN POWER VAULTS, WHARF UTILITY VAULTS AND TELEPHONE VAULTS SHALL BE PROVIDED WITH BELL ENDS.
6. COUPLINGS AND JOINTS OF CONDUITS EMBEDDED IN CONCRETE SHALL BE TAPED OR OTHERWISE MADE WATERTIGHT TO PREVENT INTRUSION OF MORTAR OR OTHER OBSTRUCTIONS, TEST CONDUIT FOR ABSENCE OF ANY BLOCKAGE WITHIN 24 HOURS OF COMPLETING THE CONCRETE POUR.

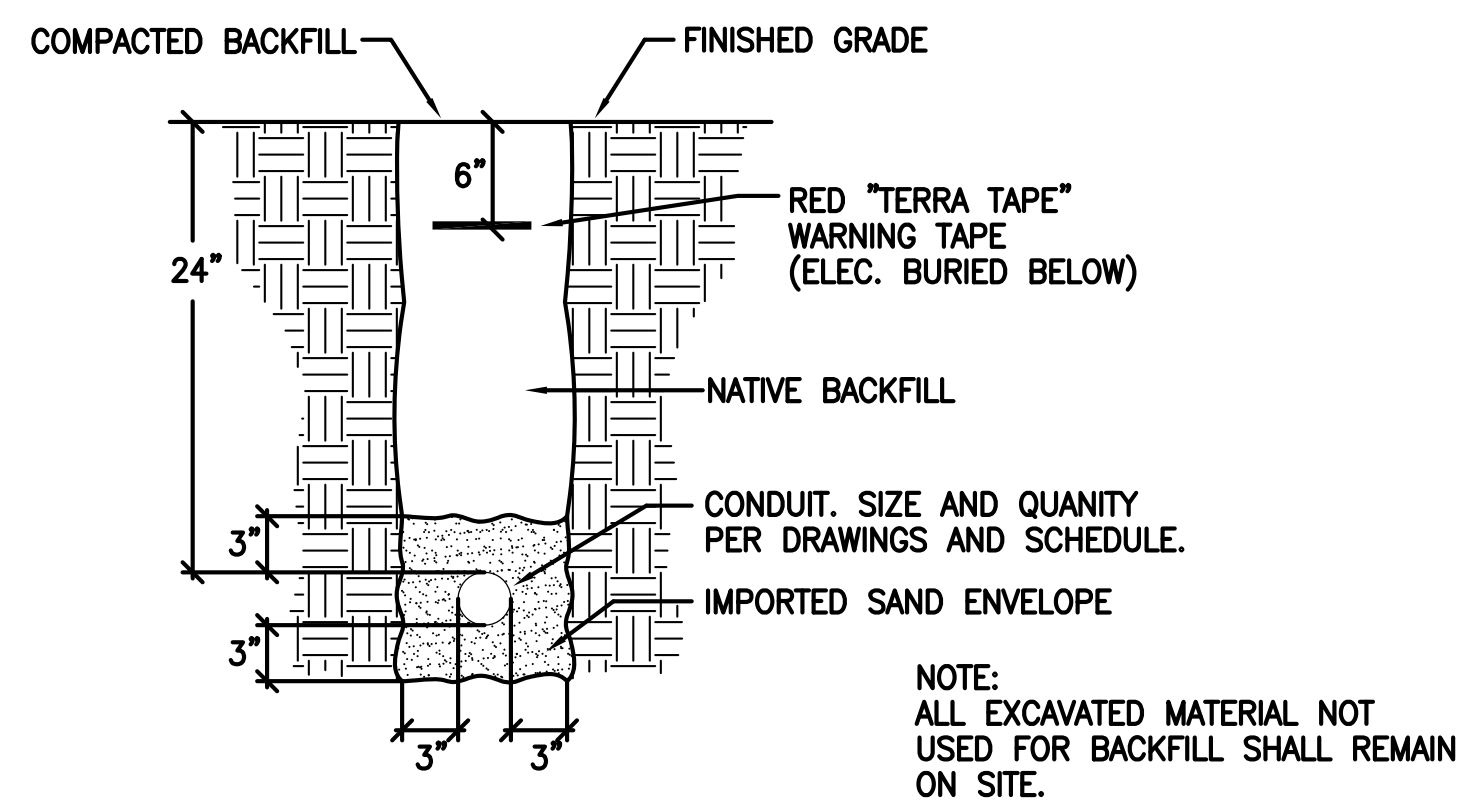

TYPICAL CONDUIT TRENCHING
NO SCALE

NOTE:
ALL EXCAVATED MATERIAL NOT USED FOR BACKFILL SHALL REMAIN ON SITE.

AS-BUILT

AUTOCAD FILE NO. 5012E5	E5
DRAWING NO. EP-5012-26	
CONTRACT NO. 978038	
SHEET NO. 55 OF 58	



PORT OF TACOMA
P.O. BOX 1837 TACOMA, WASHINGTON 98401
(206) 383-5841


CROSS ENGINEERS, INC.
280 South Fifth St. (253) 383-2544
Tacoma, Washington 98402 (FAX) 272-5848
Cross@talcyon.com

APPROVED	NEA 9/23/91	GLW/JAB 9/23/91	AS-BUILT	RNG	GLW	1/4/99
DATE	DRAWN BY	CHECKED BY	MARK	REVISION	BY	APP. DATE
CURTIS L. RATCLIFFE P.E.	GLW 9/23/91	GLW 9/23/91				
CHIEF ENGINEER	DESIGNED BY	PROJ ENGR				


**HYUNDAI MERCHANT MARINE TERMINAL
WHARF
PORT OF TACOMA
PARTIAL ELECTRICAL PLAN**

ELECTRICAL DETAIL NOTES:

- ① 3/4"x9"x24" THREE HOUR FIRE RATED EXTERIOR PLYWOOD MOUNTING PLATE FOR TELEPHONE COMPANY.
- ② 120V, 1 PHASE, 20 AMP GFI DUPLEX RECEPTACLE AND BOX.
- ③ 240V, 1 PHASE, 20 AMP RECEPTACLE WITH LOCKOUT SWITCH.
- ④ 100A, 480V, 3 PHASE, 5 WIRE RECEPTACLE AND BOX.
- ⑤ JUNCTION BOX WITH NEOPRENE GASKET, WITH UNION HUBS IN BOTTOM AND THREADED TAPPINGS INSIDE. CROUSE HINDS WCB SERIES.
- ⑥ PROVIDE MINIMUM 1-5/8"x1-5/8" GALVANIZED STEEL CHANNEL FOR MOUNTING ELECTRICAL EQUIPMENT TYPICAL.
- ⑦ TERMINATE CONDUIT AT BASE OF TELEPHONE BOARD.
- ⑧ 3" CONDUIT SLEEVE. GROUT AFTER CONDUIT INSTALLED.
- ⑨ MOTOR RATED TOGGLE SWITCH WITH PILOT LIGHT IN NEMA 4 HOUSING.
- ⑩ 1"C-#4 CU XHHW BACK TO CRANE RAIL. PROVIDE EXOTHERMIC WELD TO CRANE RAIL.
- ⑪ SEE CONDUIT AND WIRE SCHEDULE, SHEET E7.
- ⑫ TYPE L CONDUIT BODY.
- ⑬ 4"H x 1/2"W x 8"L SOLID BARE COPPER GROUND BUS WITH 6 SCREW DOWN LUGS SIZED FOR #10 THRU #4 CU WIRE. PROVIDE #6 CU THW GROUND WIRE FROM THE GROUND BUS TO THE VAULT LID FRAME, AND THE ELECTRICAL EQUIPMENT MOUNTING CHANNEL.

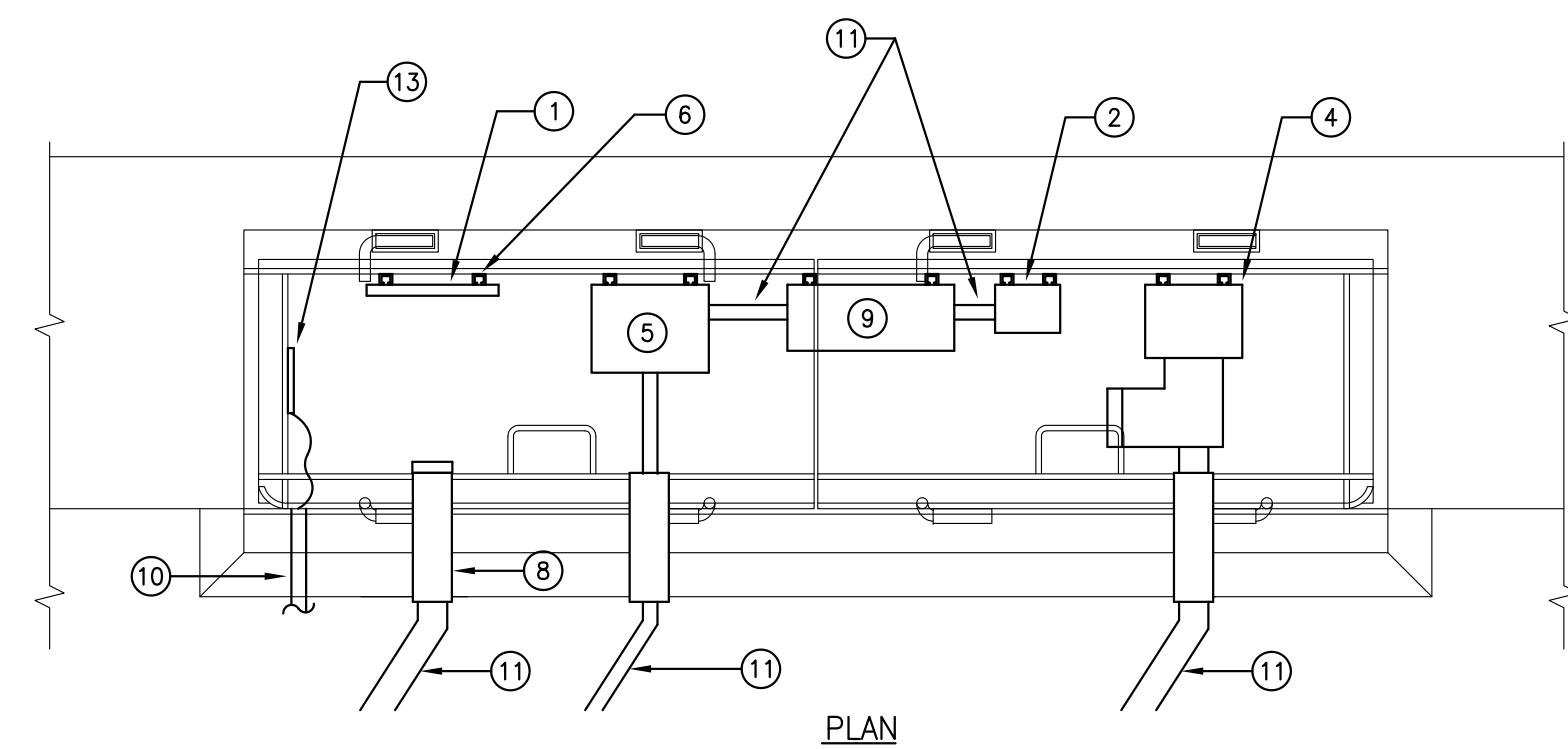


PLAN

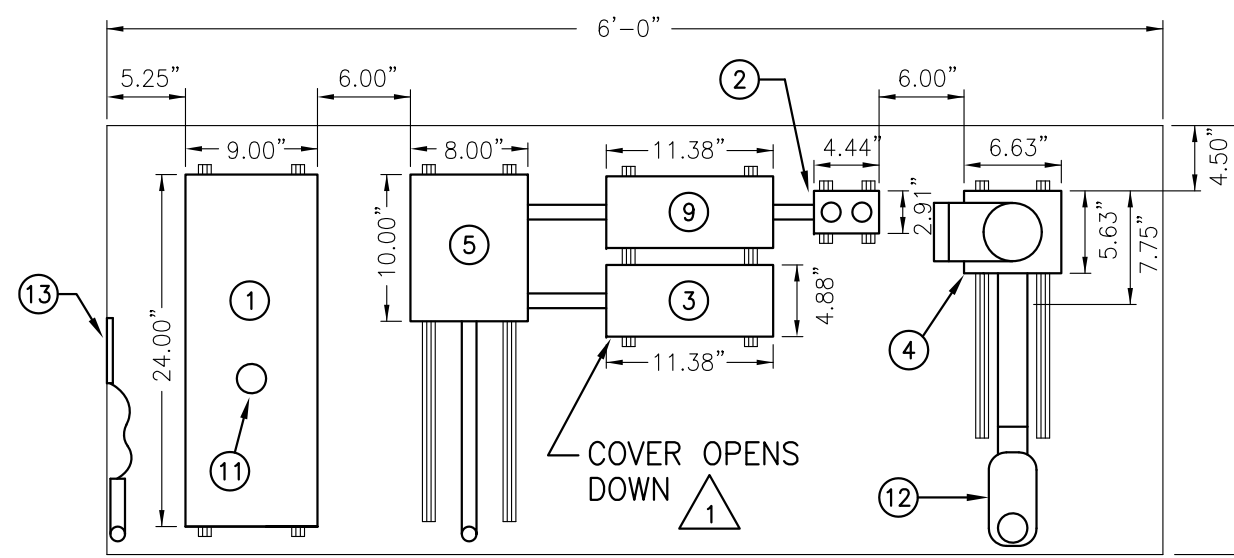


ELEVATION

WHARF POWER VAULT WITH 100A SERVICE
VAULTS PV12, 14, 16, 18, 20, 22
 SCALE: 1"=1'-0"

Ⓐ
E6

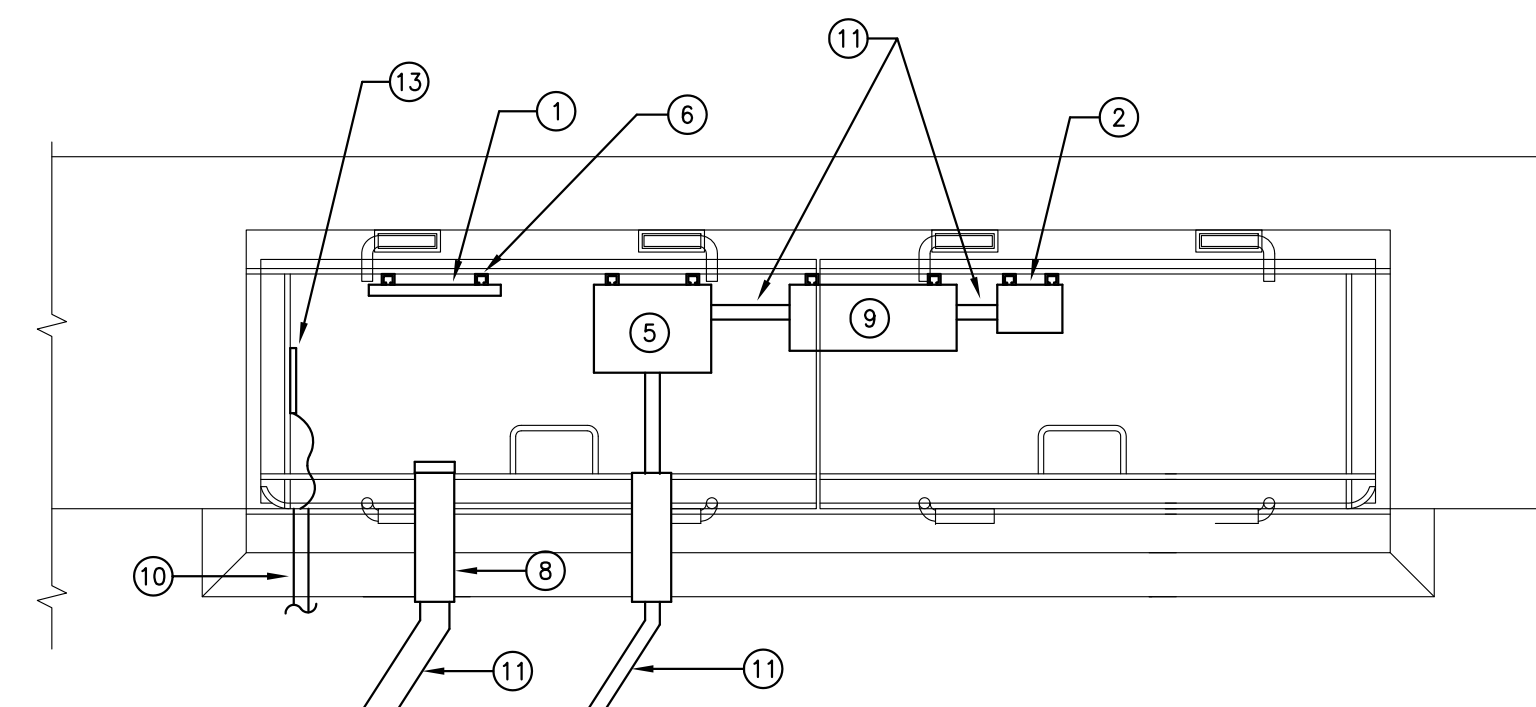


PLAN

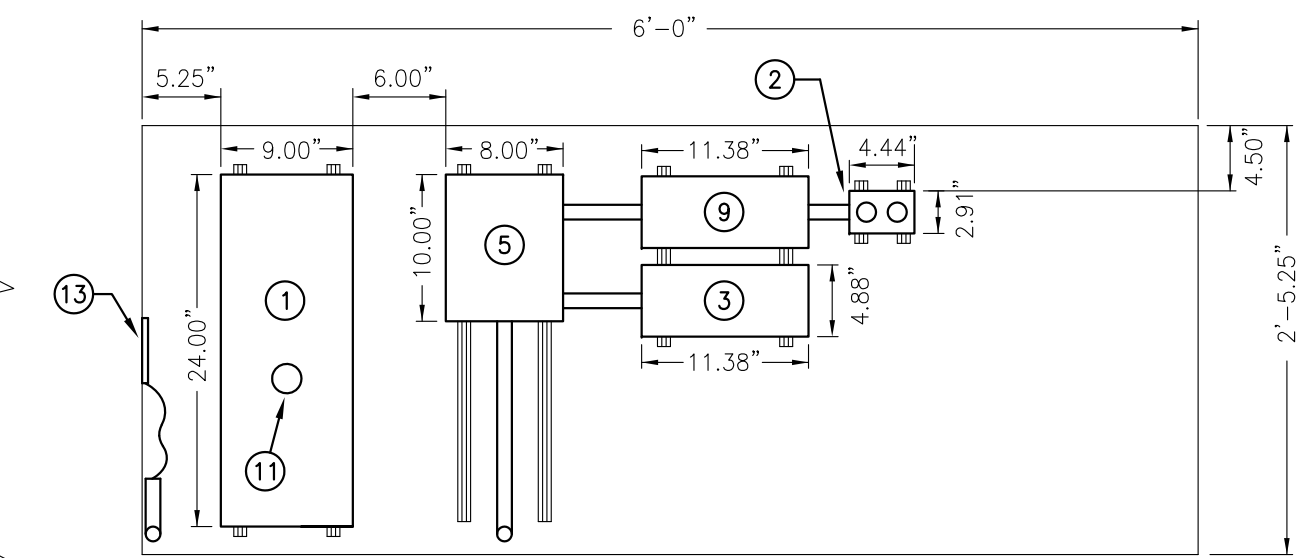

ELEVATION


WHARF POWER VAULT WITHOUT 100A SERVICE
VAULTS PV13, 15, 17, 19, 21
 SCALE: 1"=1'-0"

Ⓑ
E6

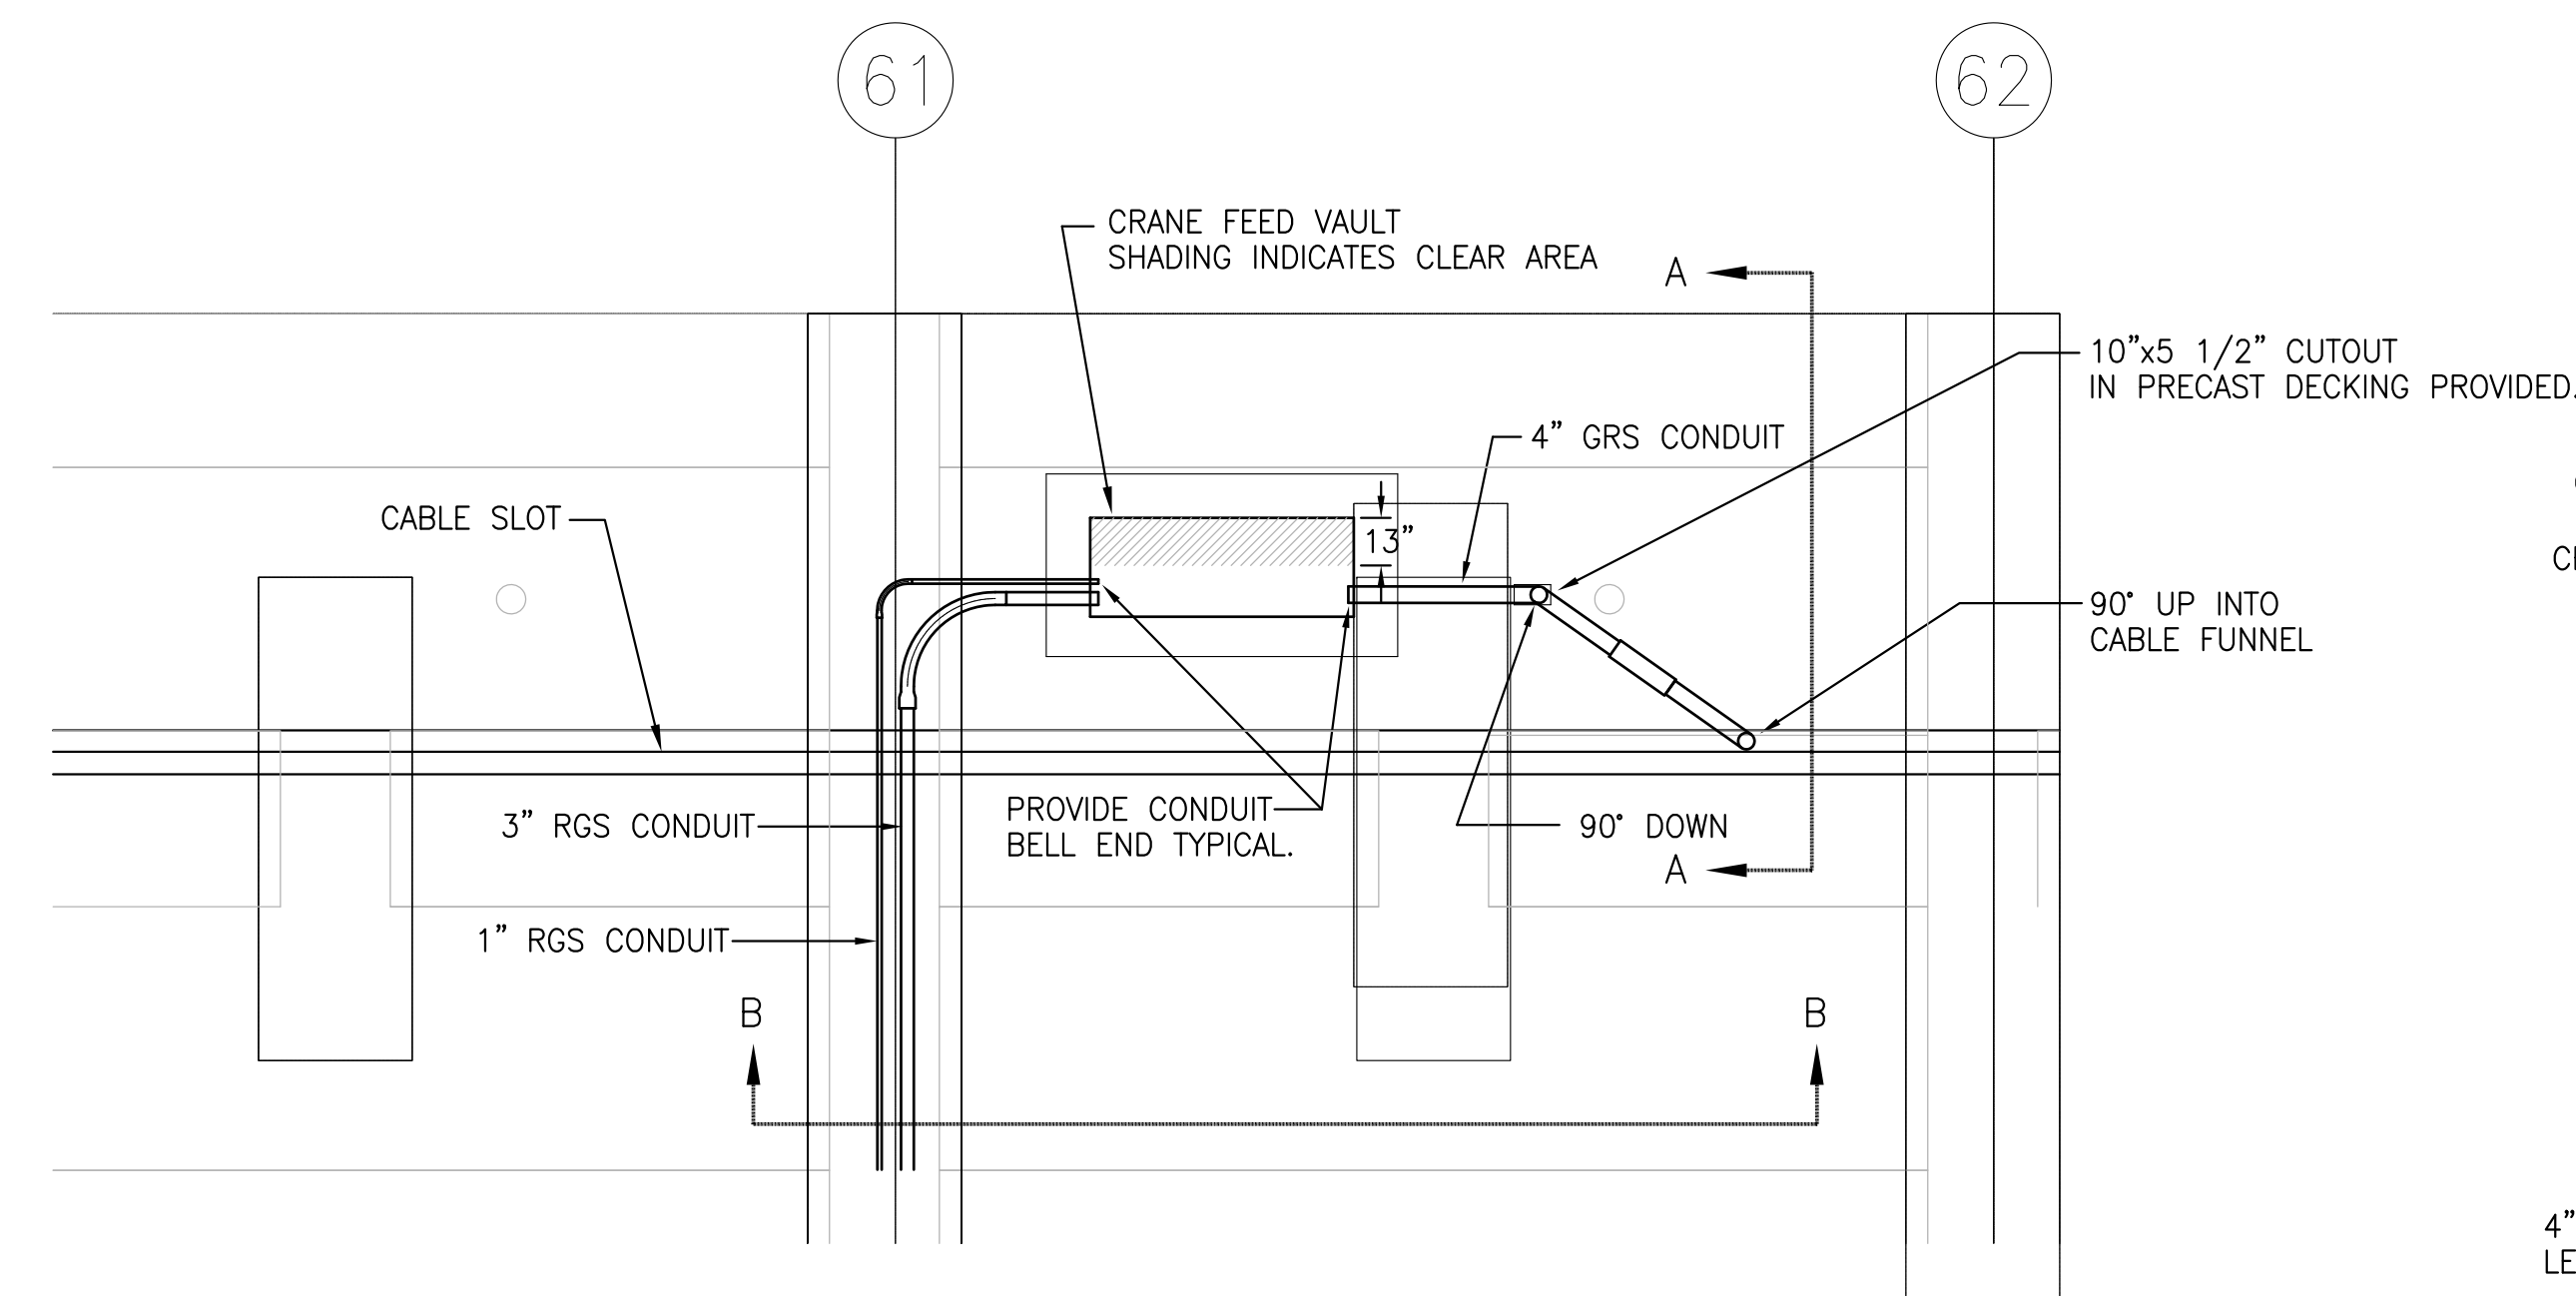


TYPICAL CRANE FEED VAULT - TOP VIEW
 SCALE: 1/4"=1'-0"

Ⓒ
E6

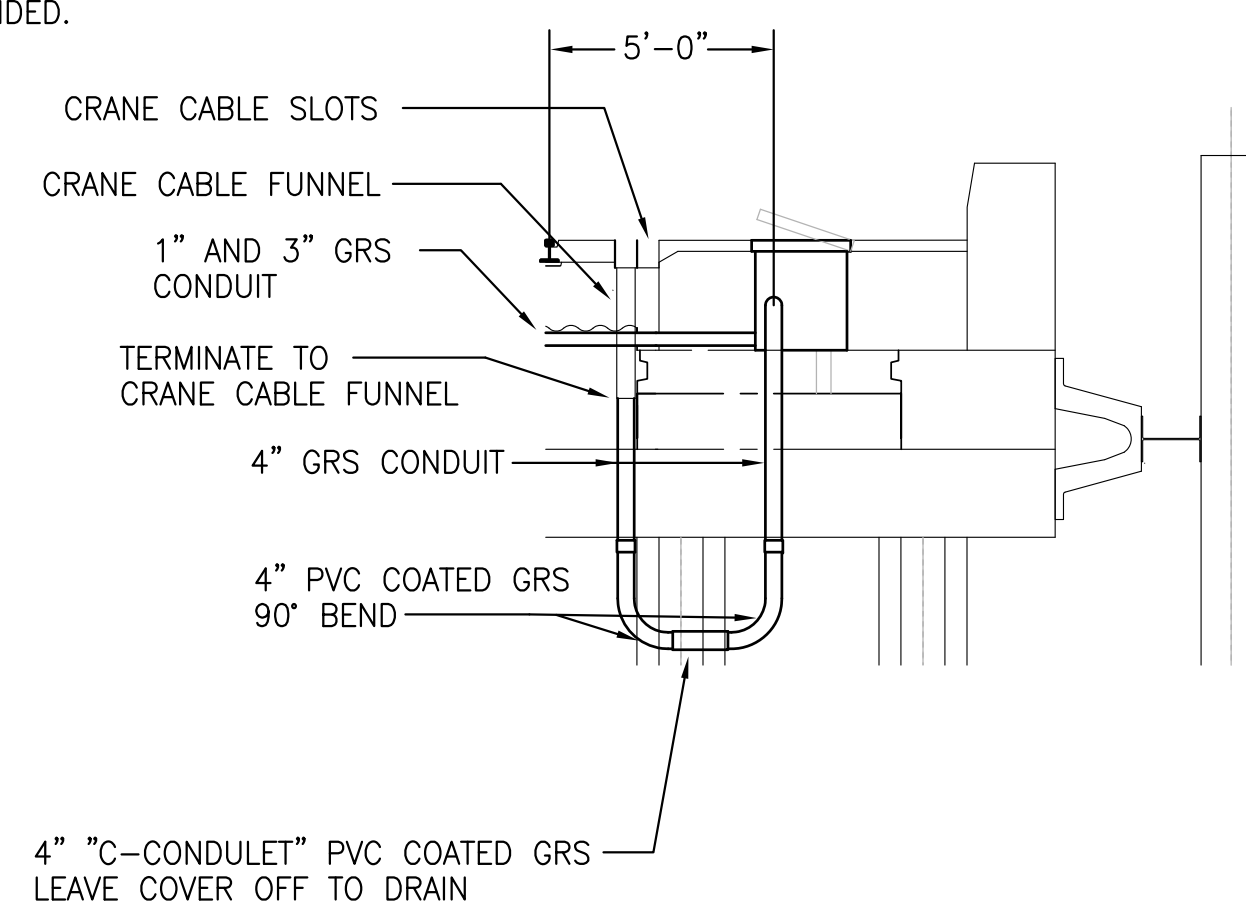

CONDUIT ROUTING A-A
 SCALE: 1/4"=1'-0"

Ⓓ
E6

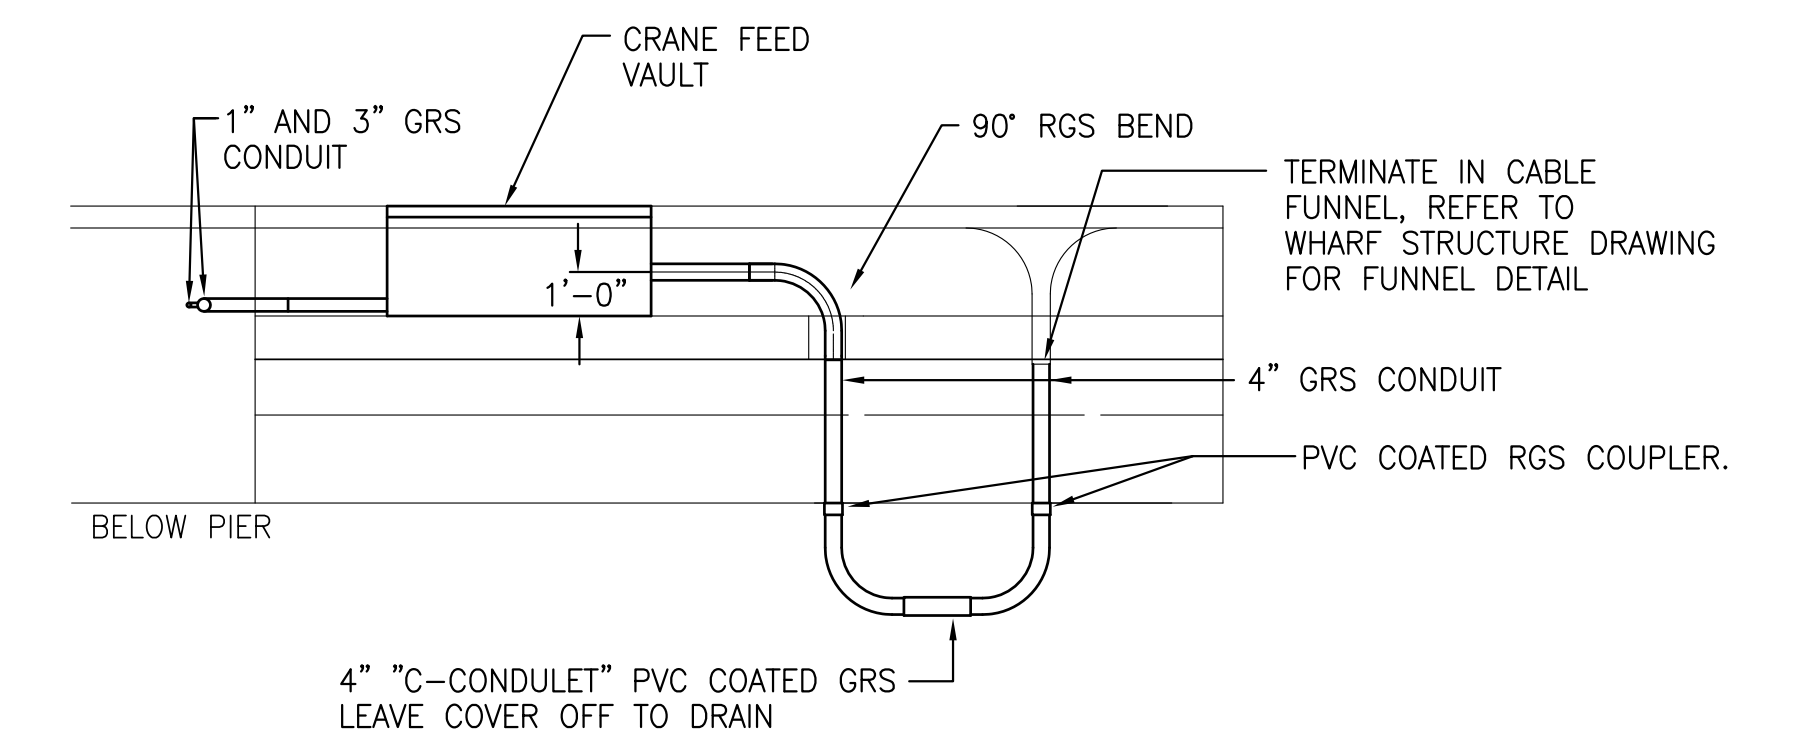

CONDUIT ROUTING B-B
 SCALE: 1/4"=1'-0"

Ⓔ
E6

AS-BUILT

AUTOCAD FILE NO. 5012E6	E6
DRAWING NO. EP-5012-26	
CONTRACT NO. 978038	
SHEET NO. 56 OF 58	



PORT OF TACOMA
 P.O. BOX 1837 TACOMA, WASHINGTON 98401
 (206) 383-5841

CROSS ENGINEERS, INC.
 260 South Fifth St. (253) 383-2544
 Tacoma, Washington 98402 (FAX) 272-5846
 Cross@tacoyon.com

APPROVED _____ DATE _____
CURTIS L. RATCLIFFE P.E.
 CHIEF ENGINEER

NEA 9/23/91
 DRAWN BY DATE
 GLW 9/23/91
 DESIGNED BY DATE

GLW/JAB 9/23/91
 CHECKED BY DATE
 GLW 9/23/91
 PROJ ENGR DATE



AS-BUILT

RNG


GLW

1/4/99

HYUNDAI MERCHANT MARINE TERMINAL
WHARF
PORT OF TACOMA
DETAILS

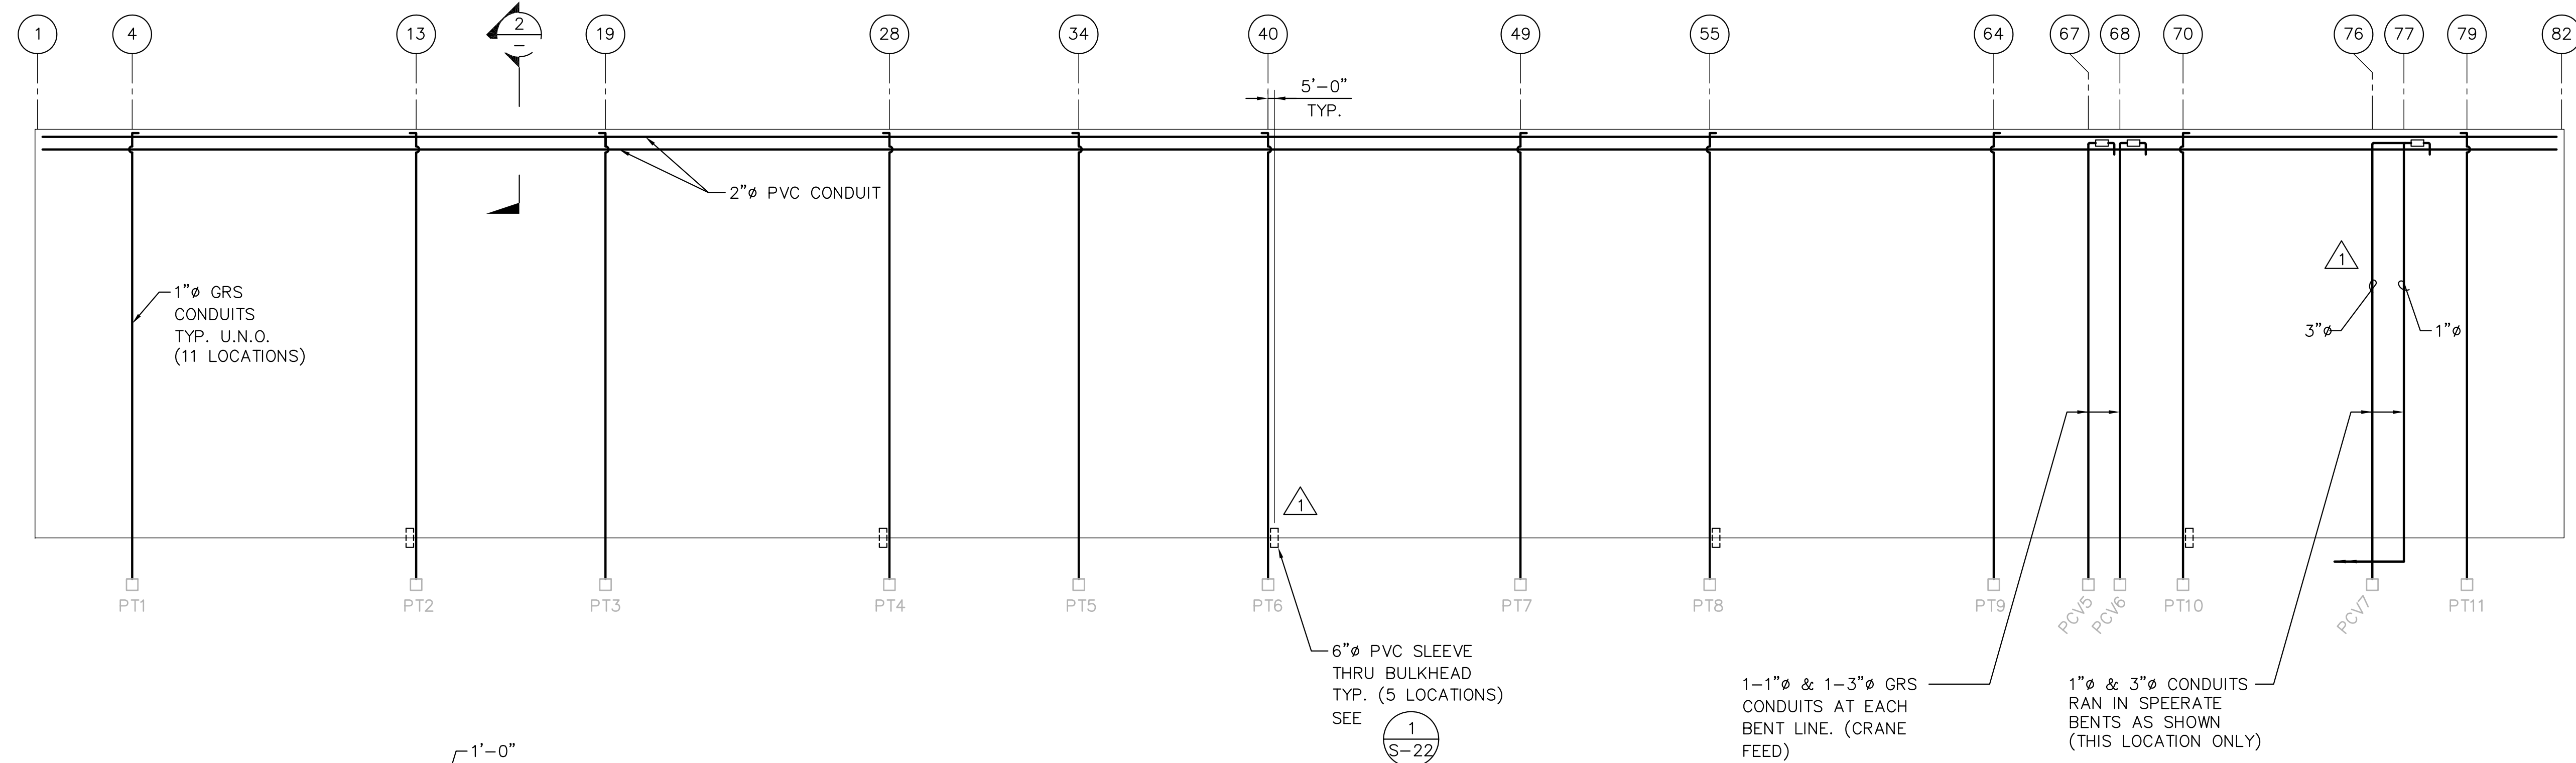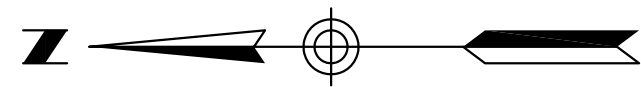

1 PLAN - SPARE CONDUIT
SCALE: NONE

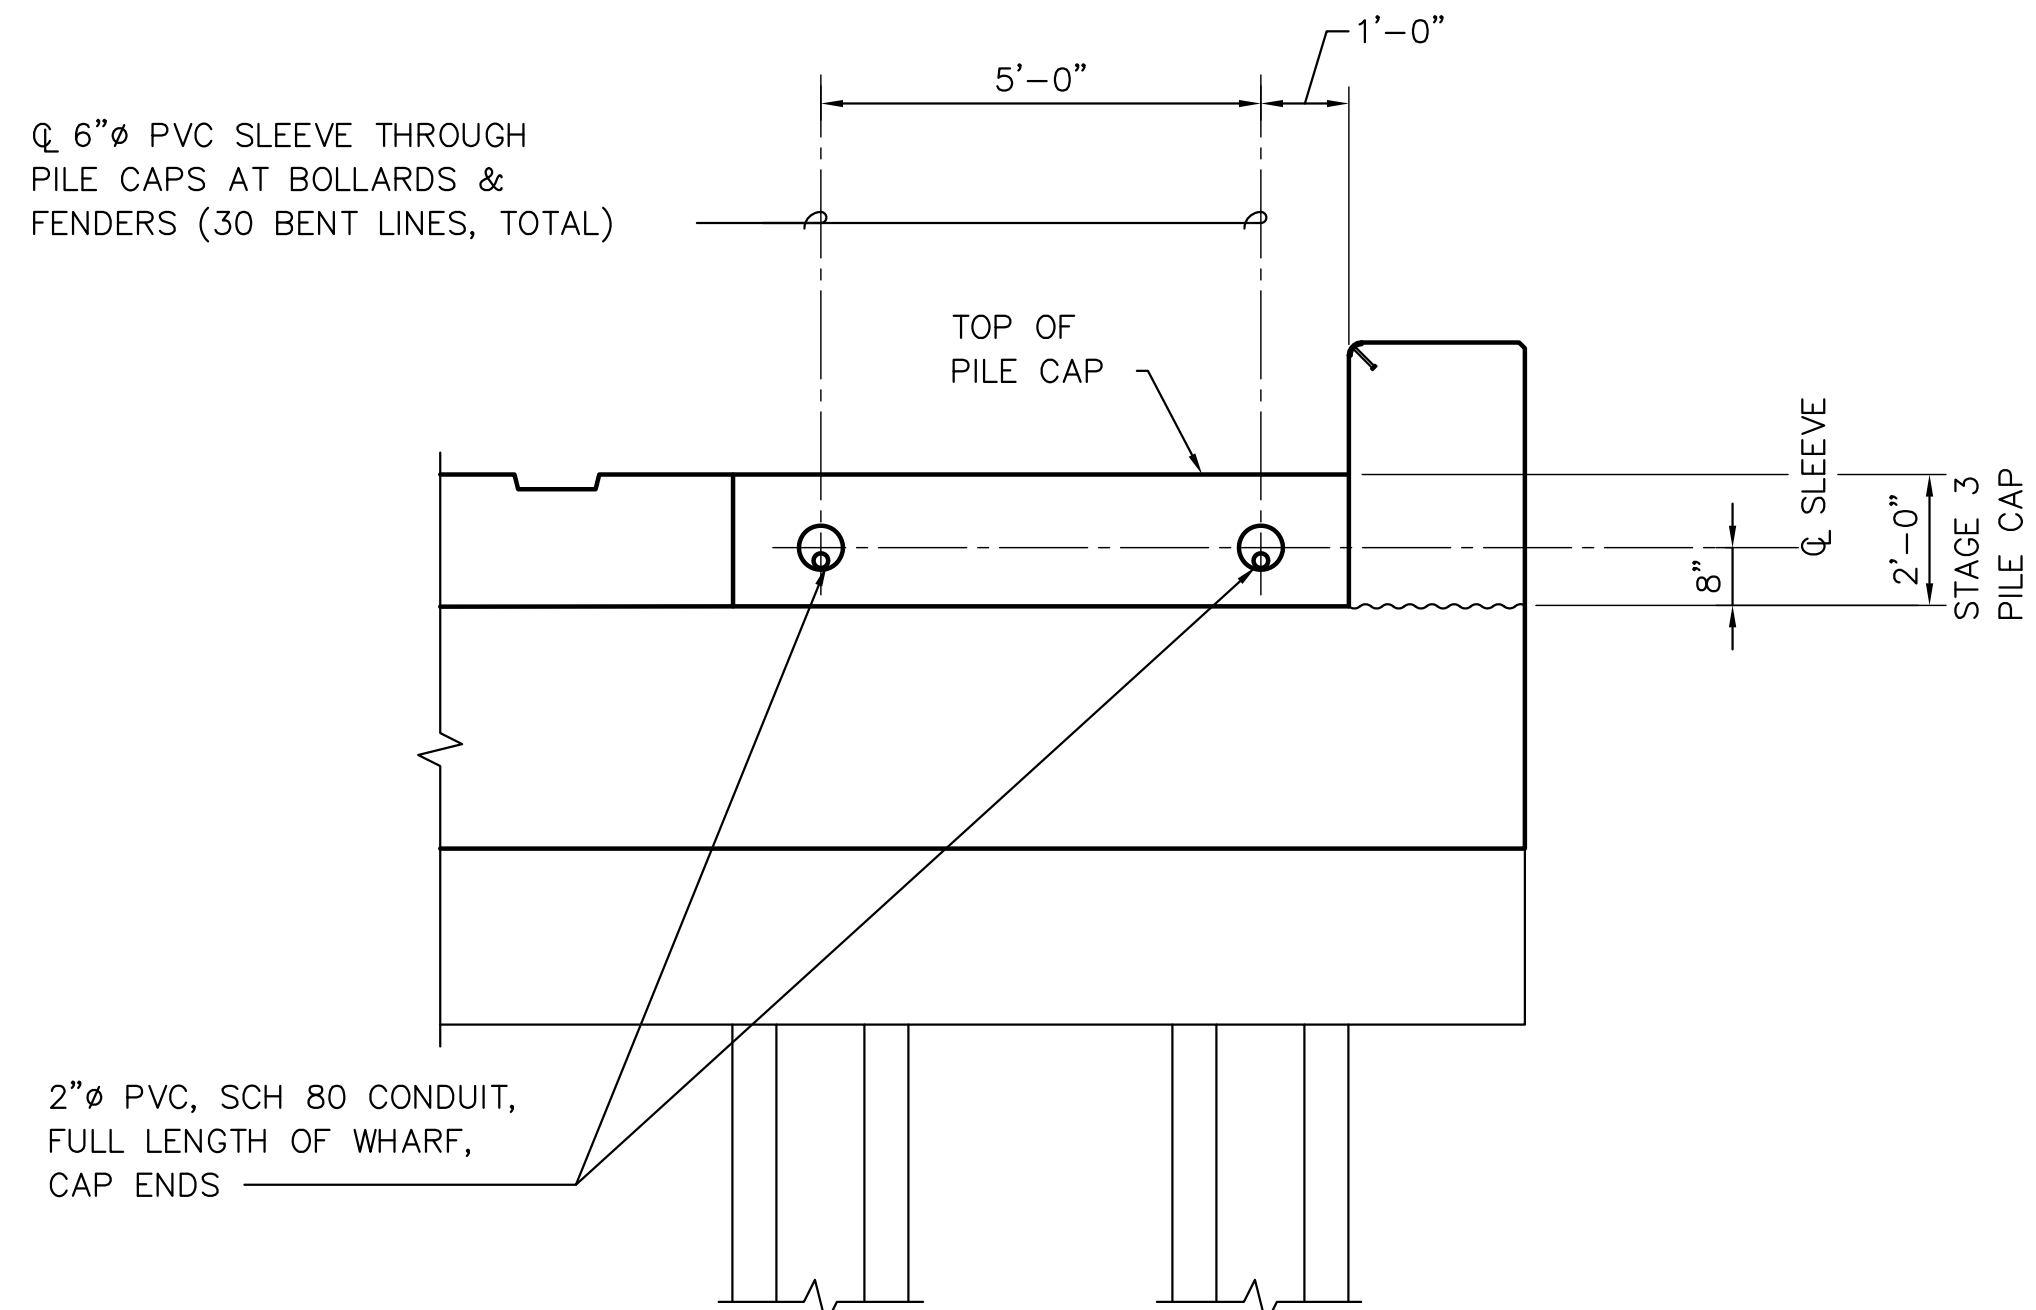

2 SECTION - SPARE CONDUITS
SCALE: NONE

NOTE:
SPARE CONDUITS AND SLEEVES ON THIS DRAWING, ARE TO BE INSTALLED UNDER THIS CONTRACT, AND ARE INTENDED FOR FUTURE USE. THESE FUTURE USE CONDUITS SHALL BE CAPPED AT BOTH ENDS. CONDUITS SHOWN ARE NOT ADDITIONAL TO THOSE SHOWN ON DWG'S S-16, S-18, AND E-1 THROUGH E-5.

AS-BUILT
AUTOCAD FILE NO. 5012SP1
SP-1



PORT OF TACOMA
P.O. BOX 1837 TACOMA, WASHINGTON 98401
(206) 383-5841

BERGER/ABAM
ENGINEERS INC.
33301 9TH AVENUE SOUTH
FEDERAL WAY, WASHINGTON 98003-6395
(206)431-2300 FAX:(206)431-2250

APPROVED
DATE
CURTIS L. RATCLIFFE P.E.
CHIEF ENGINEER

EMR 9/91
DRAWN BY DATE
FDP 9/91
DESIGNED BY DATE

AR 9/91
CHECKED BY DATE
JAS 9/91
PROJ ENGR DATE

AS-BUILT	RDD	JAS	1/4/99
REVISION	BY	APP.	DATE

HYUNDAI MERCHANT MARINE TERMINAL WHARF
PORT OF TACOMA
SPARE CONDUIT PLAN

DRAWING NO. 978038
CONTRACT NO. 978038
SHEET NO. 58 OF 58