# SUITE: 1725 RSF: 4,118


NORTH 200 LASALLE


## AS-BUILT CONFIGURATION

| | |
|---|---|
| OFFICES | 2 |
| RECEPTION | 1 |
| CONFERENCE ROOMS | 2 |
| KITCHEN | 1 |
| OPEN WORK AREA | +/- 15 |

*Not to scale, furniture and appliances not included*

## KEY PLAN

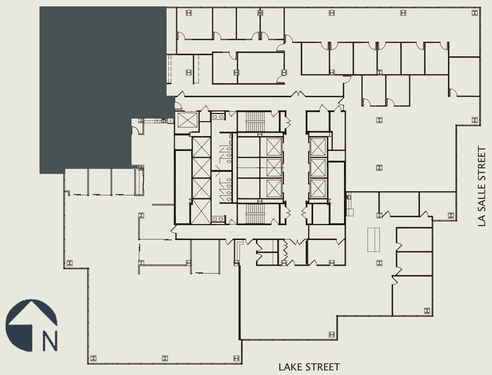

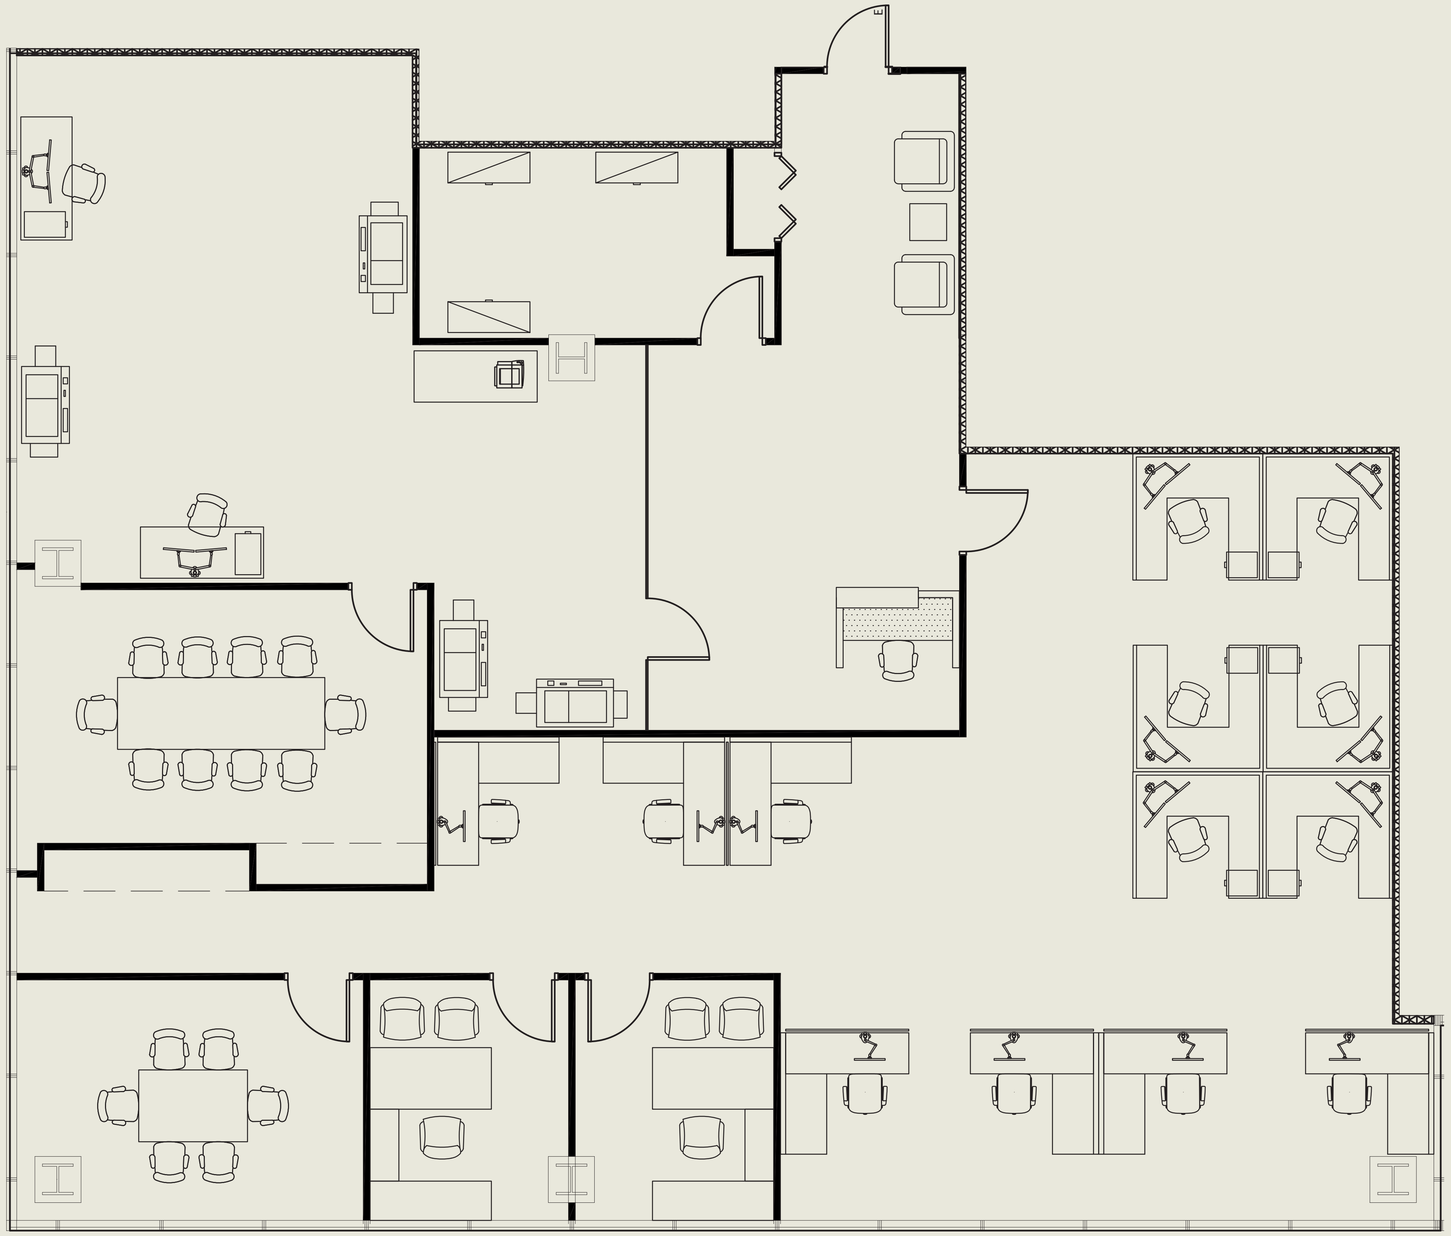FOR LEASING INFORMATION PLEASE CONTACT:

MARK GUNDERSON
312 448 8645 | mark.gunderson@streamrealty.com

BEN CLEVELAND
312 448 6221 | ben.cleveland@streamrealty.com

onni group