SUITE: 420

RSF: 3,868

NORTH 200 LASALLE

AS-BUILT CONFIGURATION

OFFICES..... N/

RECEPTION..... N/


CONFERENCE ROOMS..... N/


KITCHEN..... N/

OPEN WORK AREA..... N/

Not to scale, furniture and appliances not included

KEY PLAN

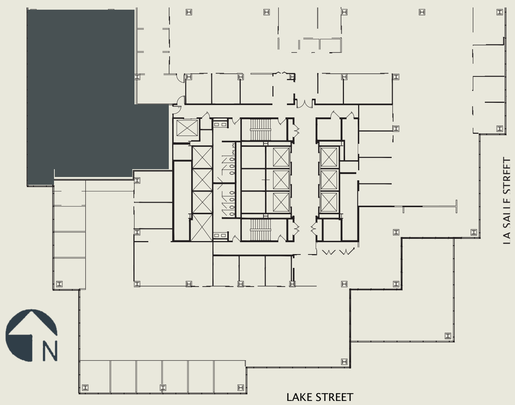

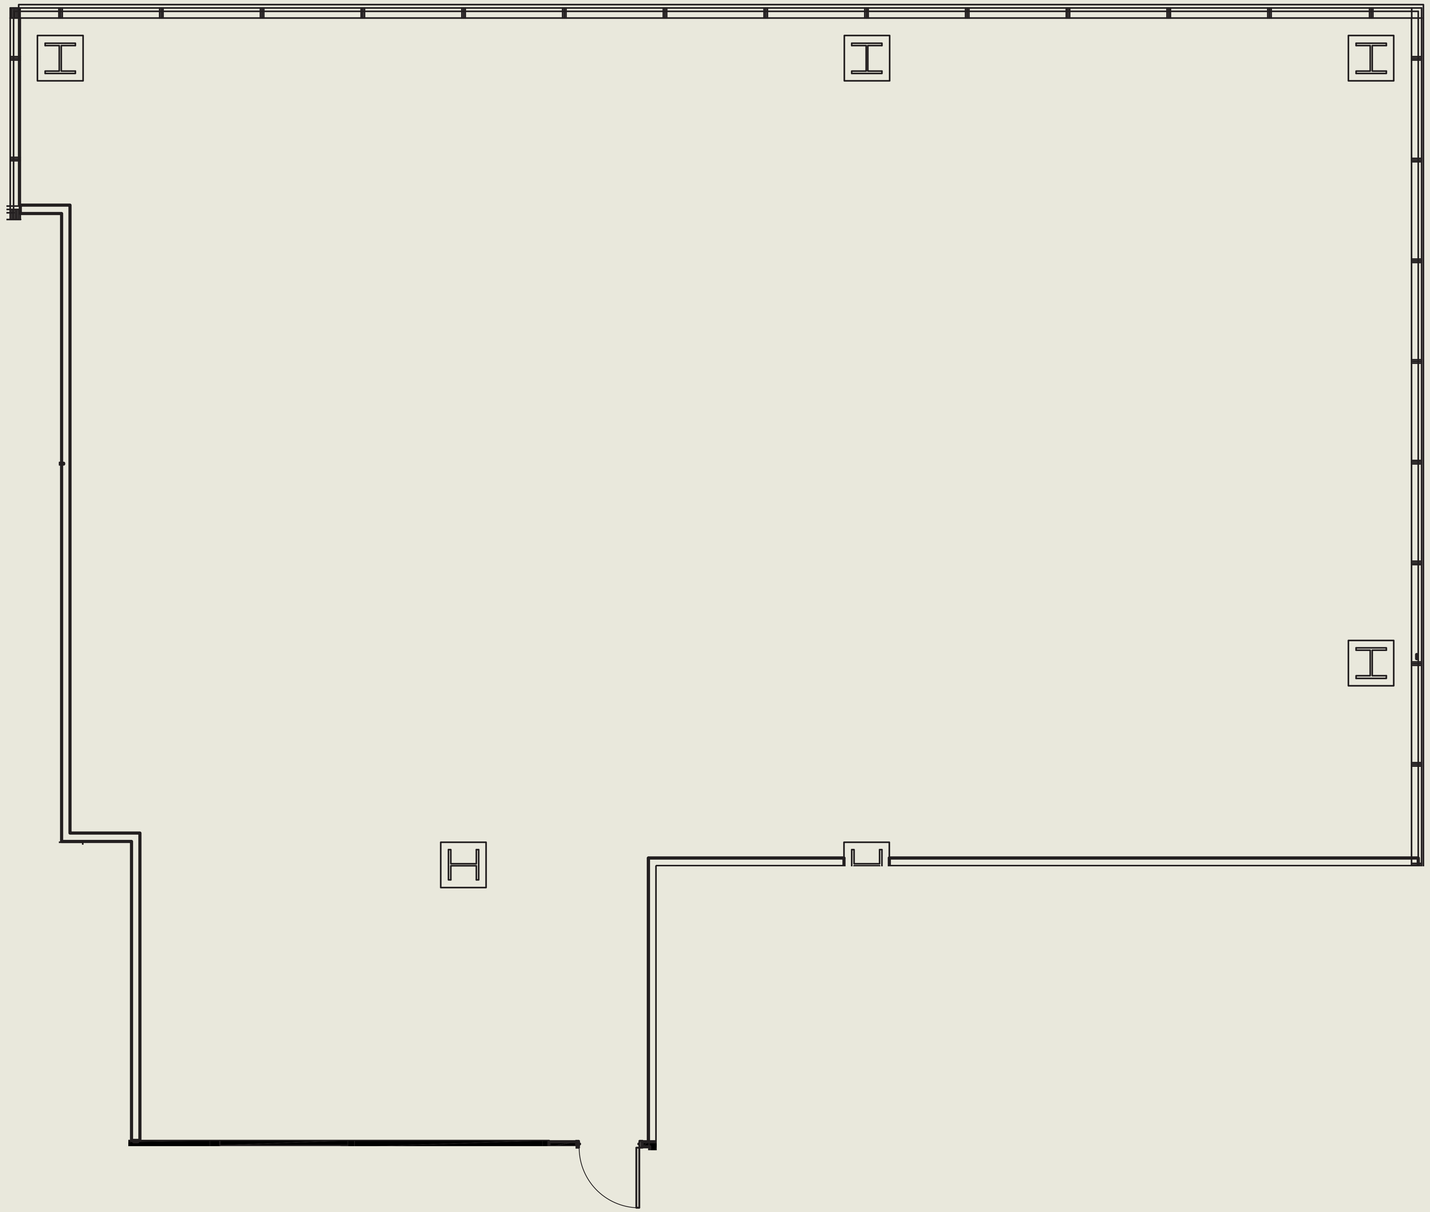

FOR LEASING INFORMATION PLEASE CONTACT:

MARK GUNDERSON
312 448 8645 | mark.gunderson@streamrealty.com

BEN CLEVELAND
312 448 6221 | ben.cleveland@streamrealty.com

onni group