SUITE: 880 RSF: 8,242

NORTH 200 LASALLE

AS-BUILT CONFIGURATION

OFFICES..... 3

RECEPTION..... 1


CONFERENCE ROOMS..... 3


KITCHEN..... 1

OPEN WORK AREA..... +/- 68

Not to scale, furniture and appliances not included

KEY PLAN

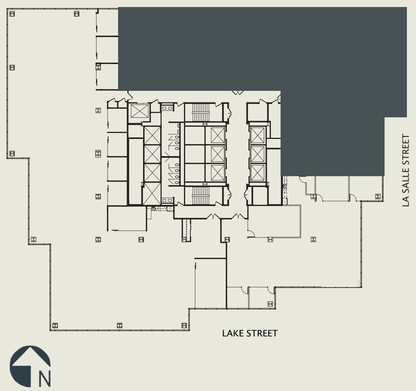

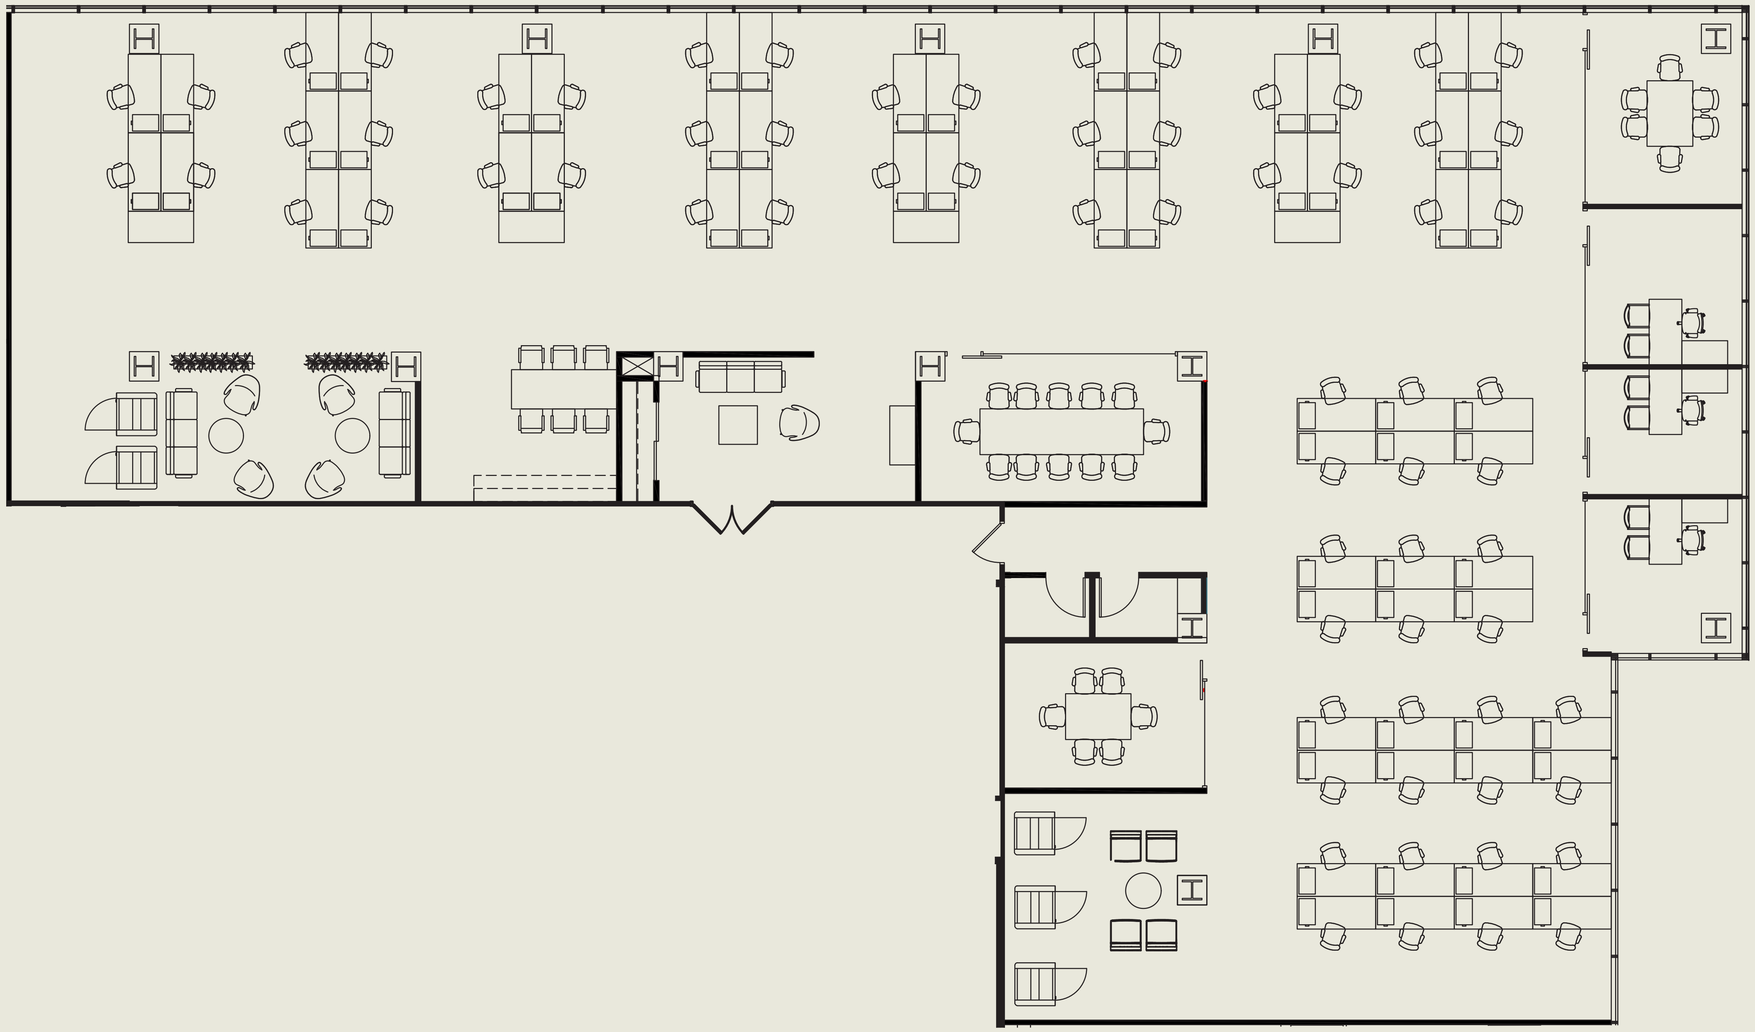

STREAM onni group