SUITE: 400

RSF: 3,929

315 WEST 9TH

AS-BUILT CONFIGURATION

OFFICES..... 4

RECEPTION..... 1

CONFERENCE ROOMS..... 1

KITCHEN/BREAKOUT 1

OPEN WORK AREA..... 10

Not to scale, furniture and appliances not included

KEY PLAN

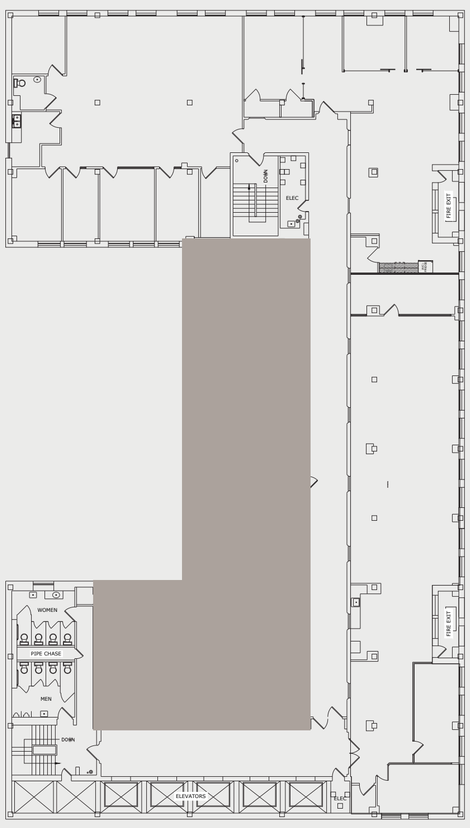

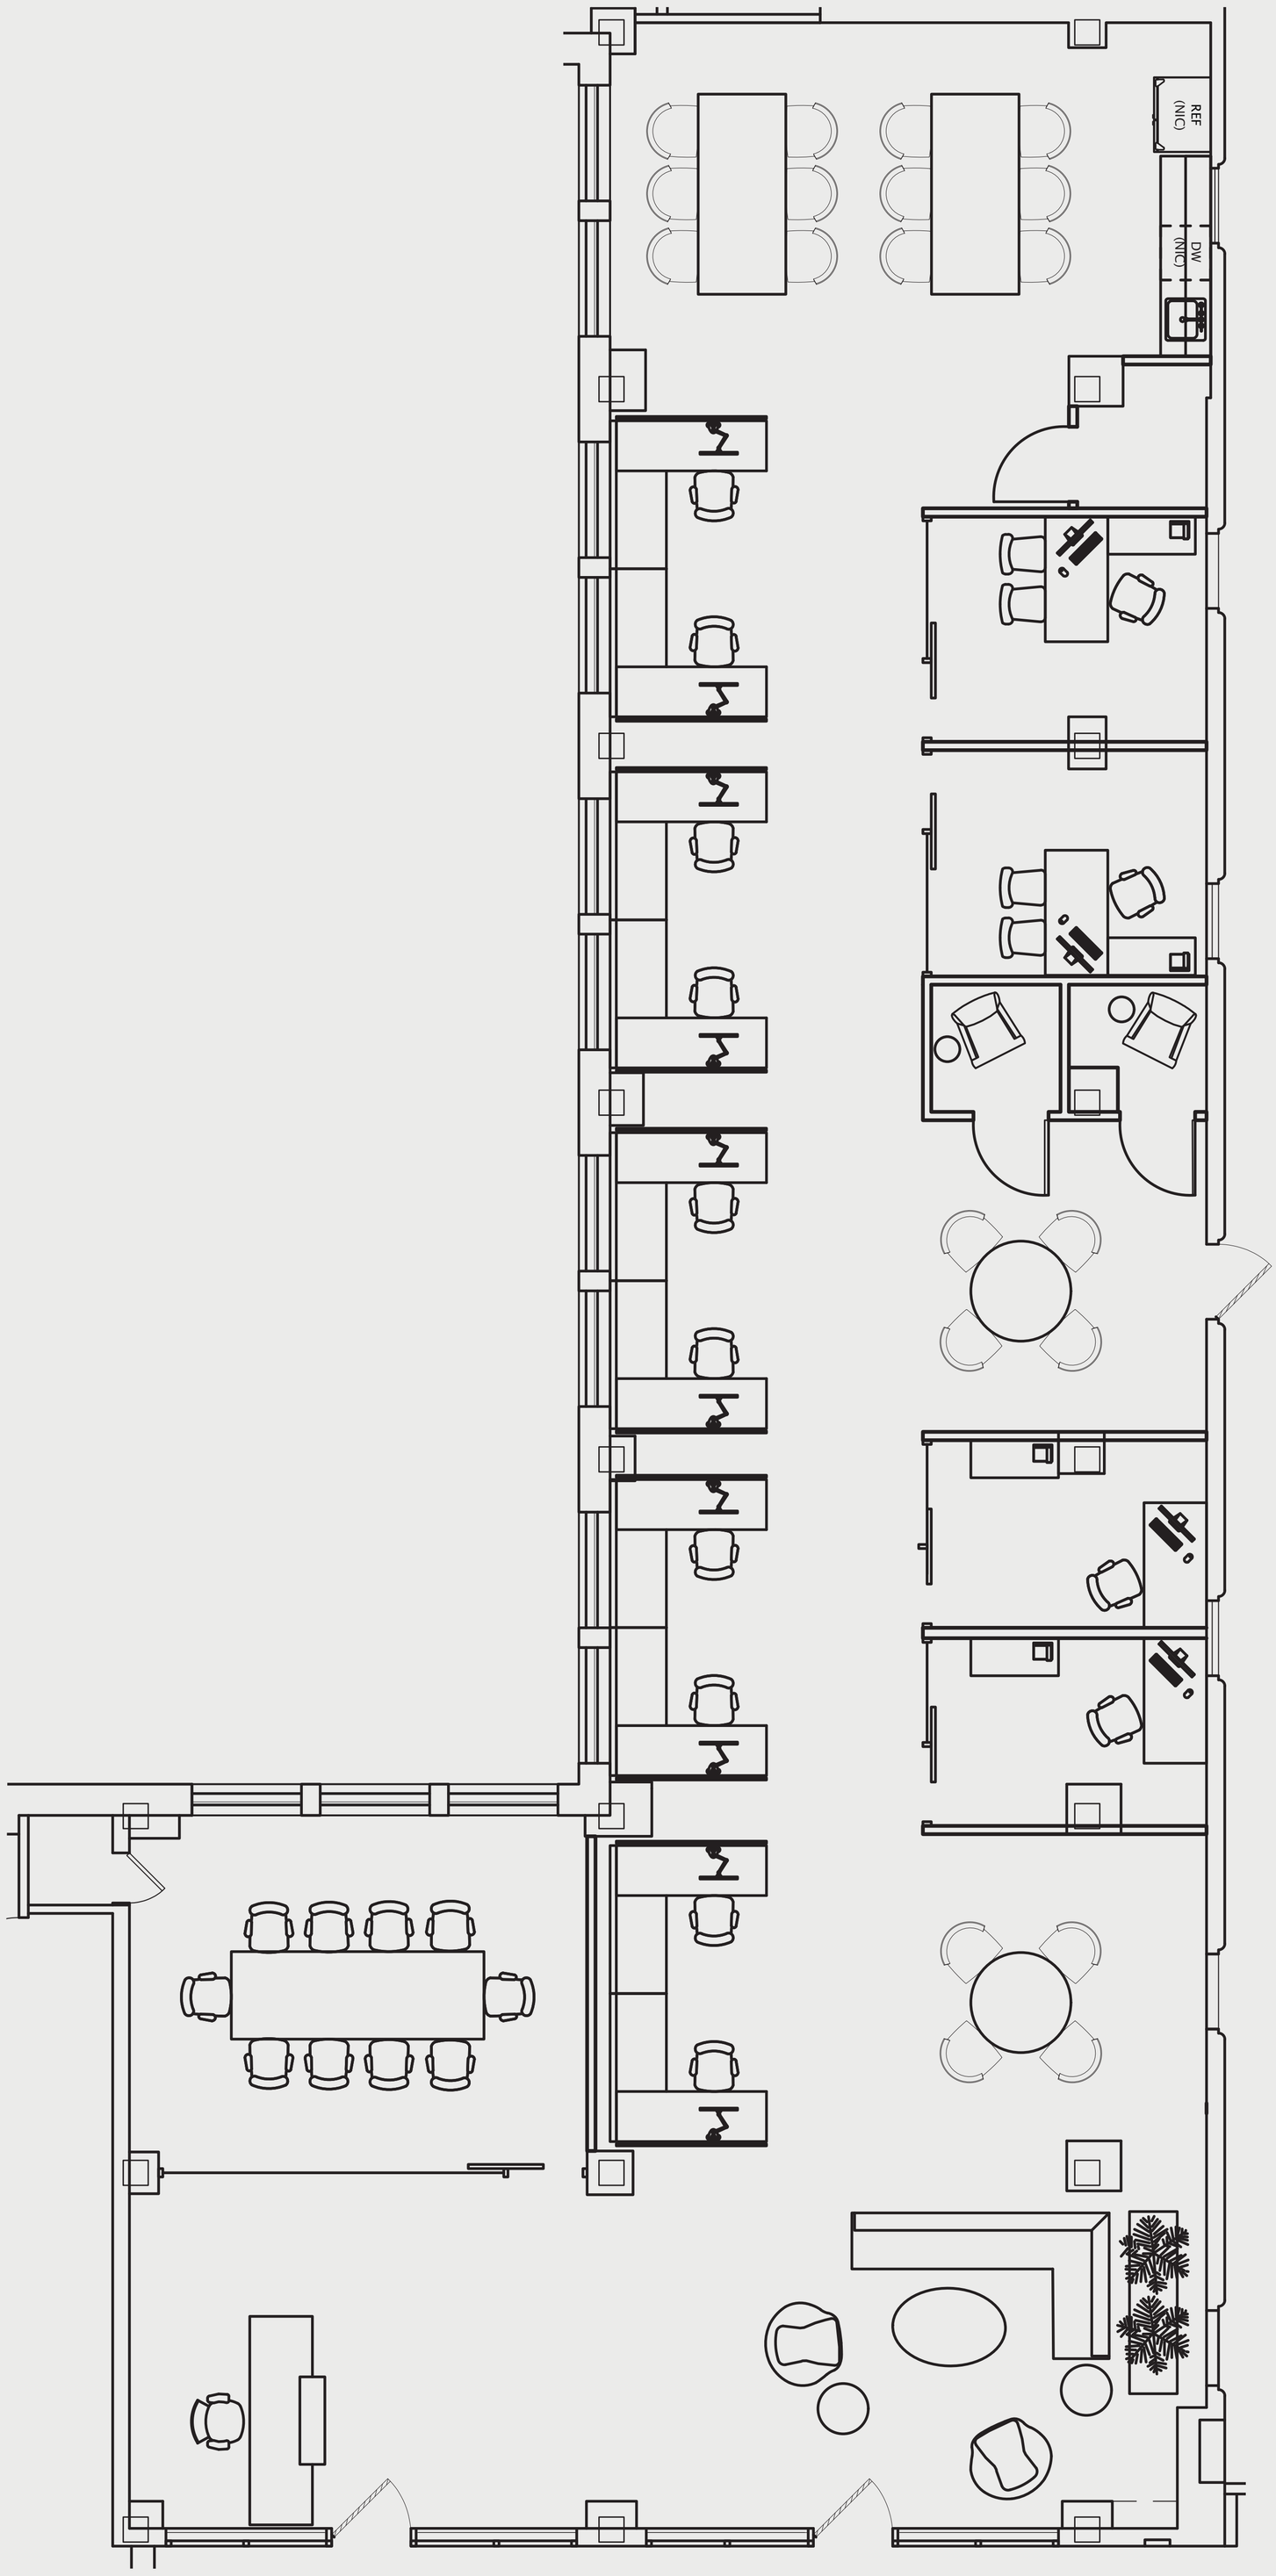

For leasing information please contact:
USALEASING@ONNI.COM
(213) 629-2041

onni group