SUITE: 702 RSF: 2,417

315 WEST 9TH

AS-BUILT CONFIGURATION

OFFICES..... N/A

RECEPTION..... N/A

CONFERENCE ROOMS..... 2

KITCHEN/BREAKOUT 1

OPEN WORK AREA..... +/-10

Not to scale, furniture and appliances not included

KEY PLAN

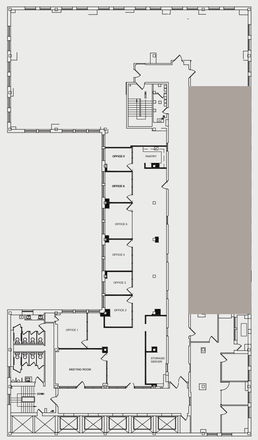

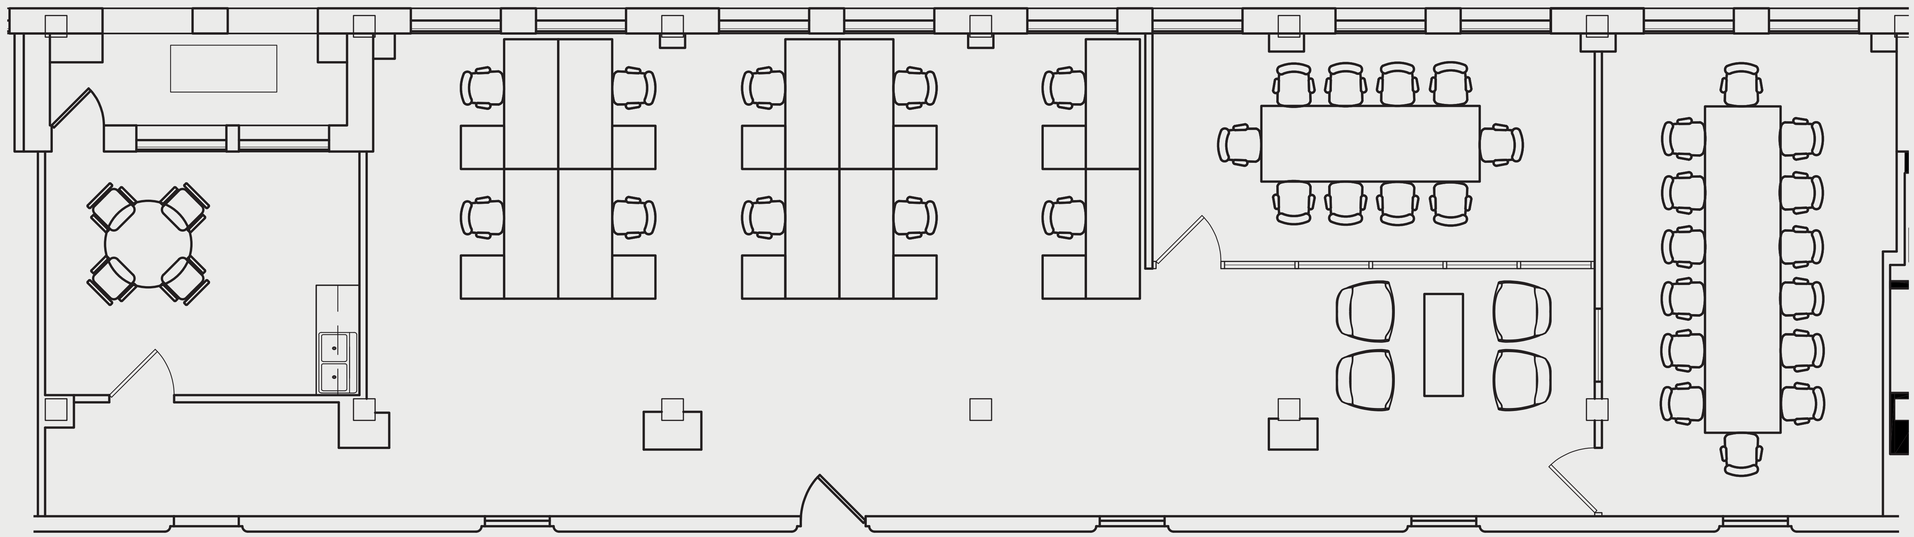

For leasing information please contact:
USALEASING@ONNI.COM
(213) 629-2041

onni group