SUITE: 801 RSF: 4,055

315 WEST 9TH

AS-BUILT CONFIGURATION

OFFICES..... 7

RECEPTION..... 1

CONFERENCE ROOMS..... 2

KITCHEN/BREAKOUT 1

OPEN WORK AREA..... +/- 12

Not to scale, furniture and appliances not included

KEY PLAN

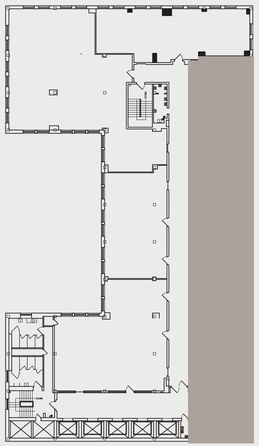

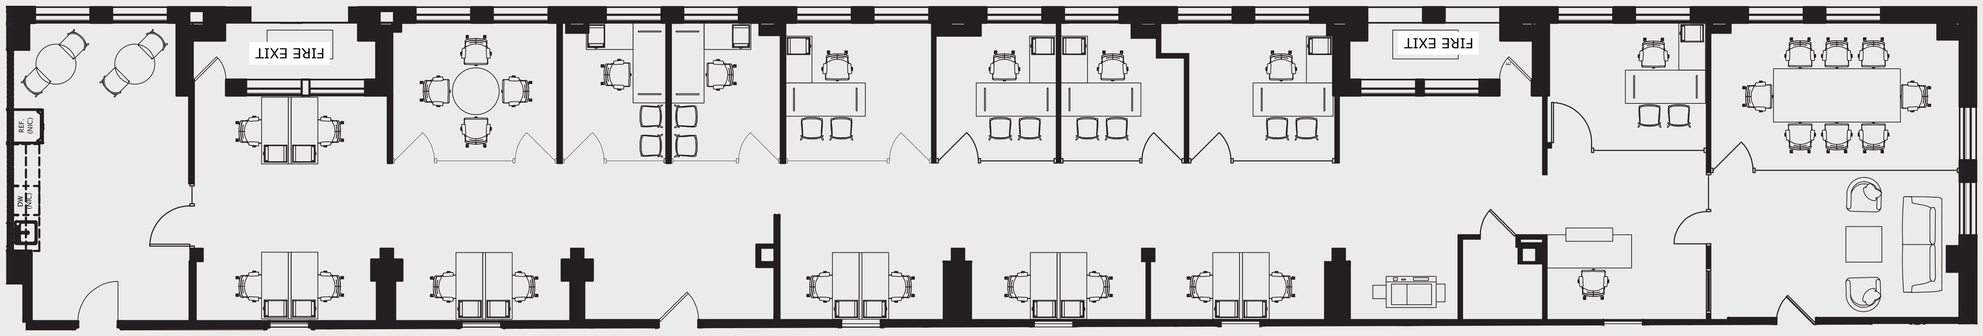

onni group