596-12

726,000

1885'

1068.2

725,000

5'

360'

880'

1729.8'

1053.3

Lot d

1-4
28.05 Ac.
Total

Lot 9

1-5
41.64 AC.

526'

LAKE

1054'

529'

402'

382'

314'

1-8
1.5 Ac.

330'

724,000

STATE HIGHWAY 55

2177'

1-4

4-221

4-210

23
8.16 AC.

1222'

469'

100'

500'

19
.23 Ac.

100'

100'

Lot 10

1-10
10 Ac. Total

Lot 11

1-11

620'

Lot 12

723,500
2,039,500

2,040,000

2,041,000

SHEET 4


SCALE IN FEET
100 0 100 200

GRID IS BASED ON NORTH CAROLINA STATE

MAPPED BY: BOOTHE CO., INC.,
PARK AERIAL SURVEYS, INC.,
MAY 1958

APEX


1 WAKE COUNTY

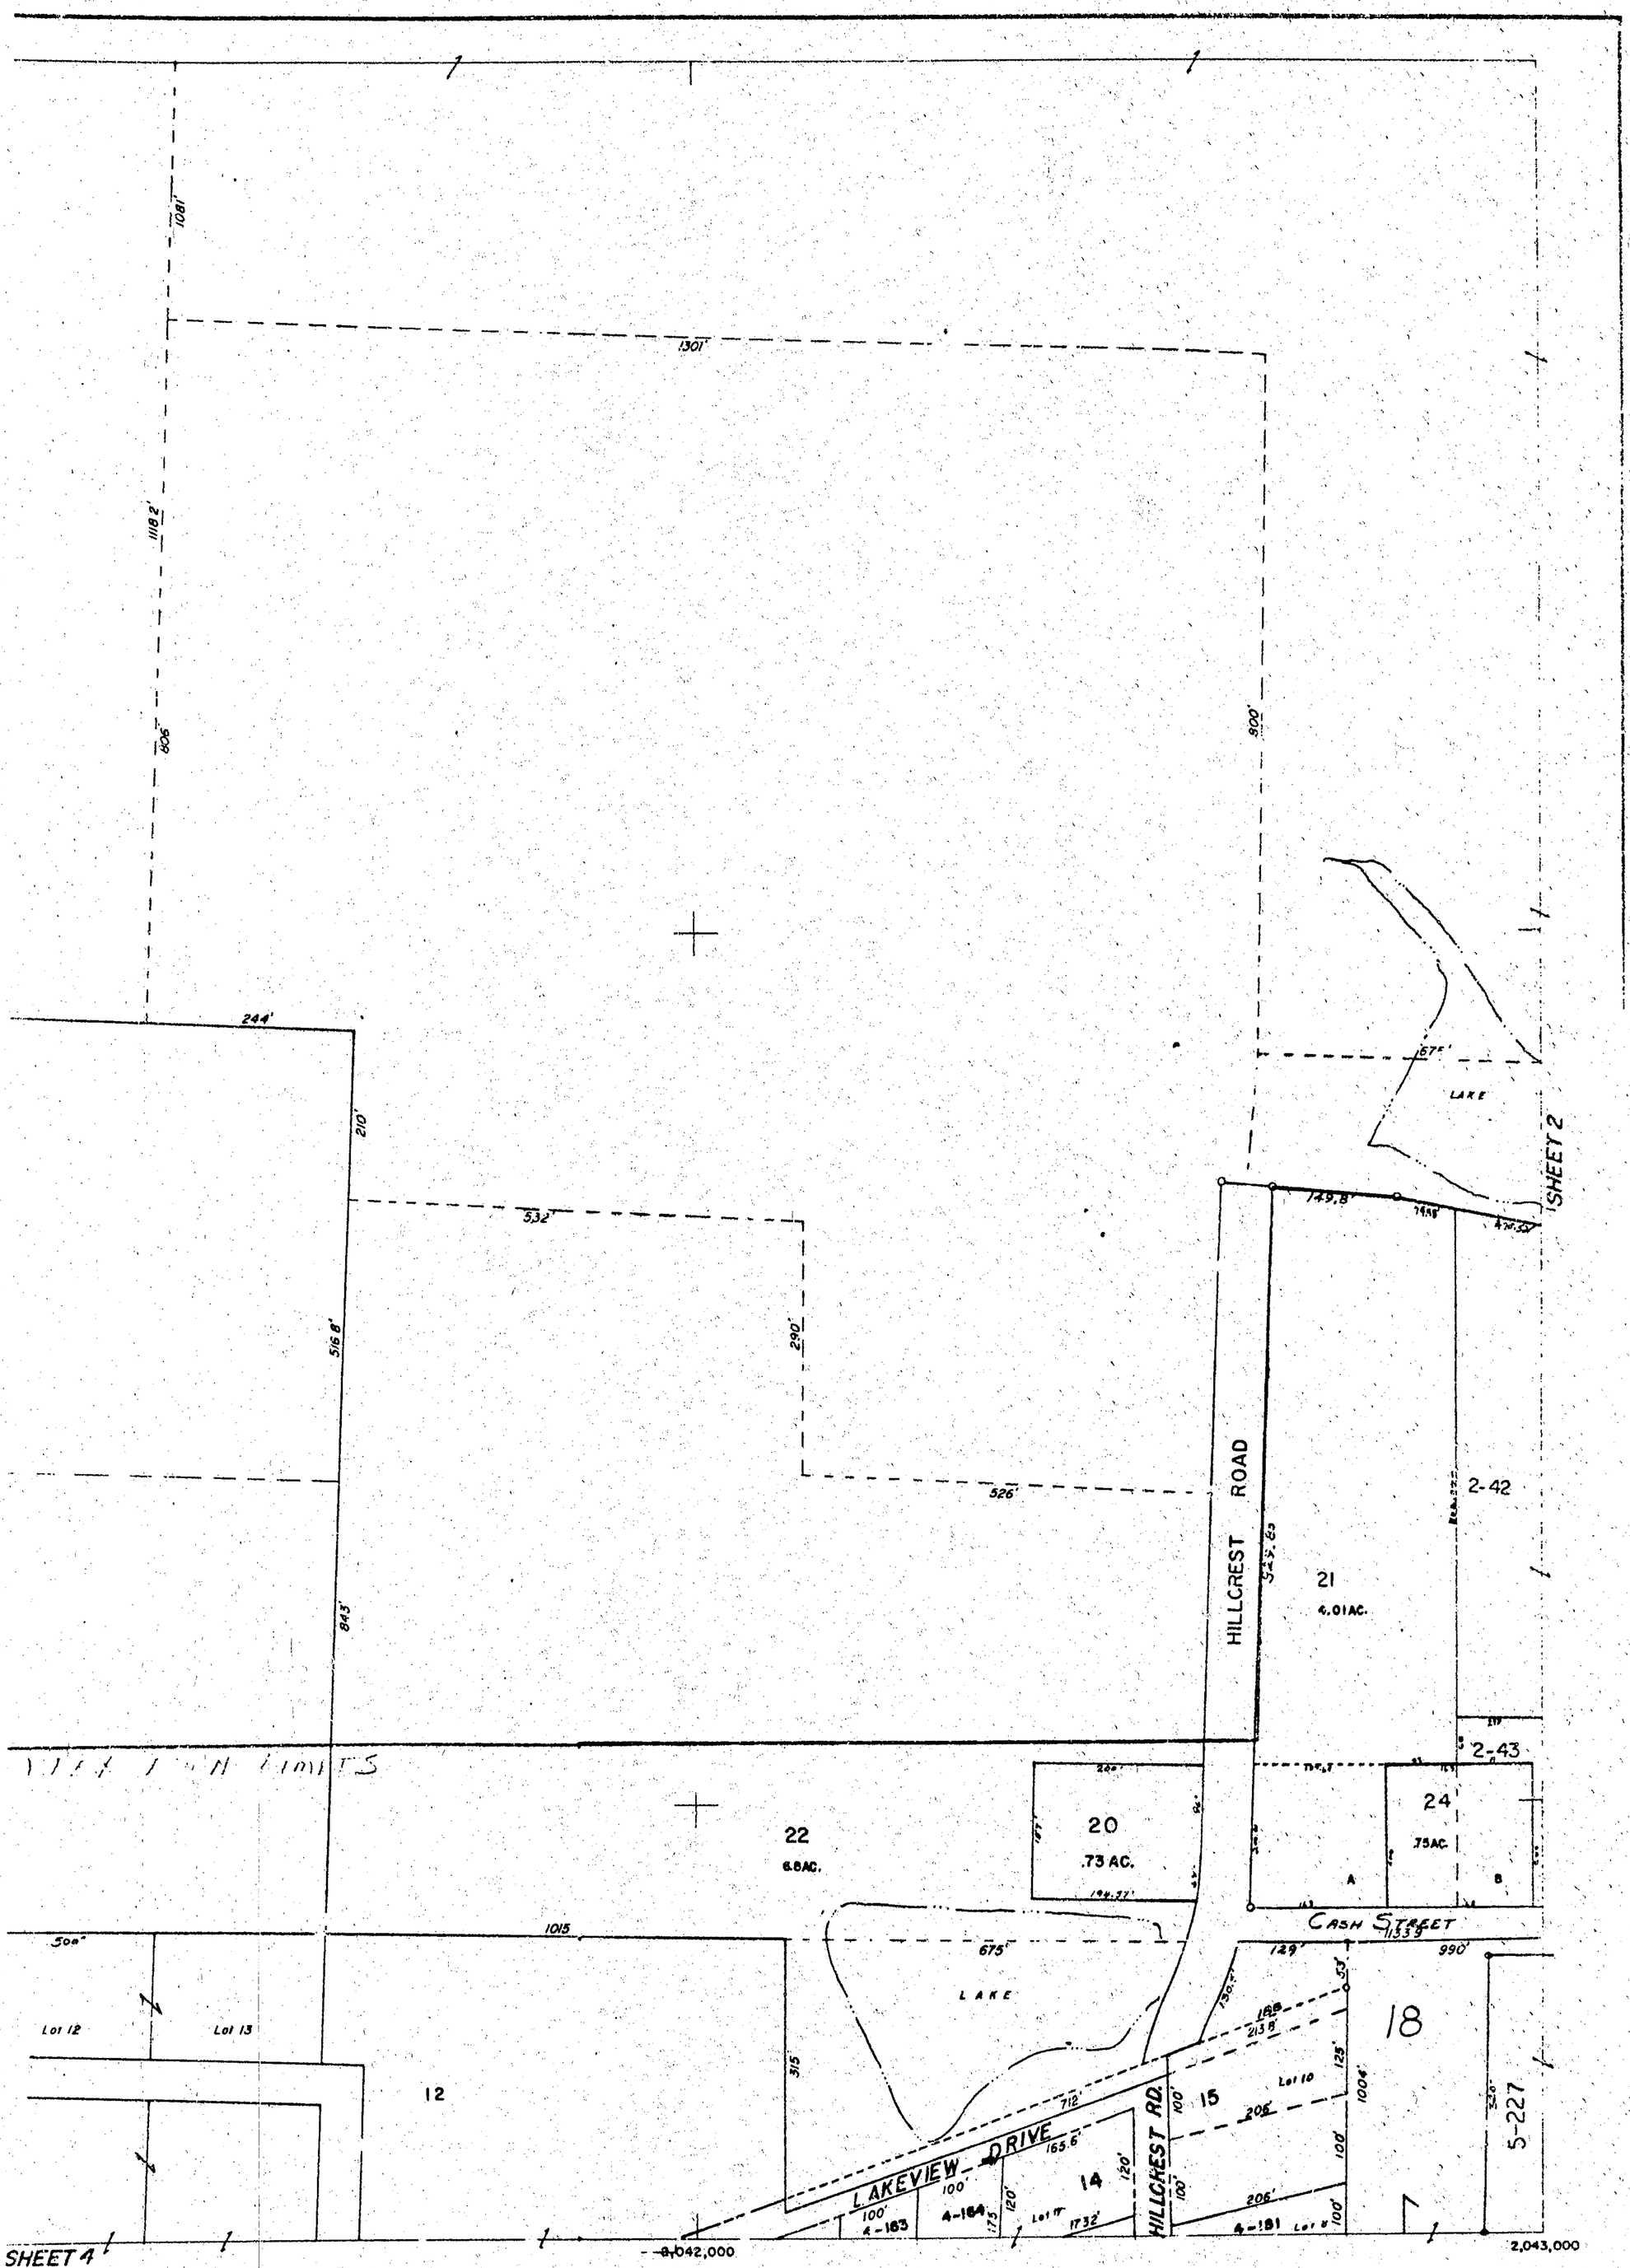


APEX, N.C.

SHEET 1 1

LAST # of 11

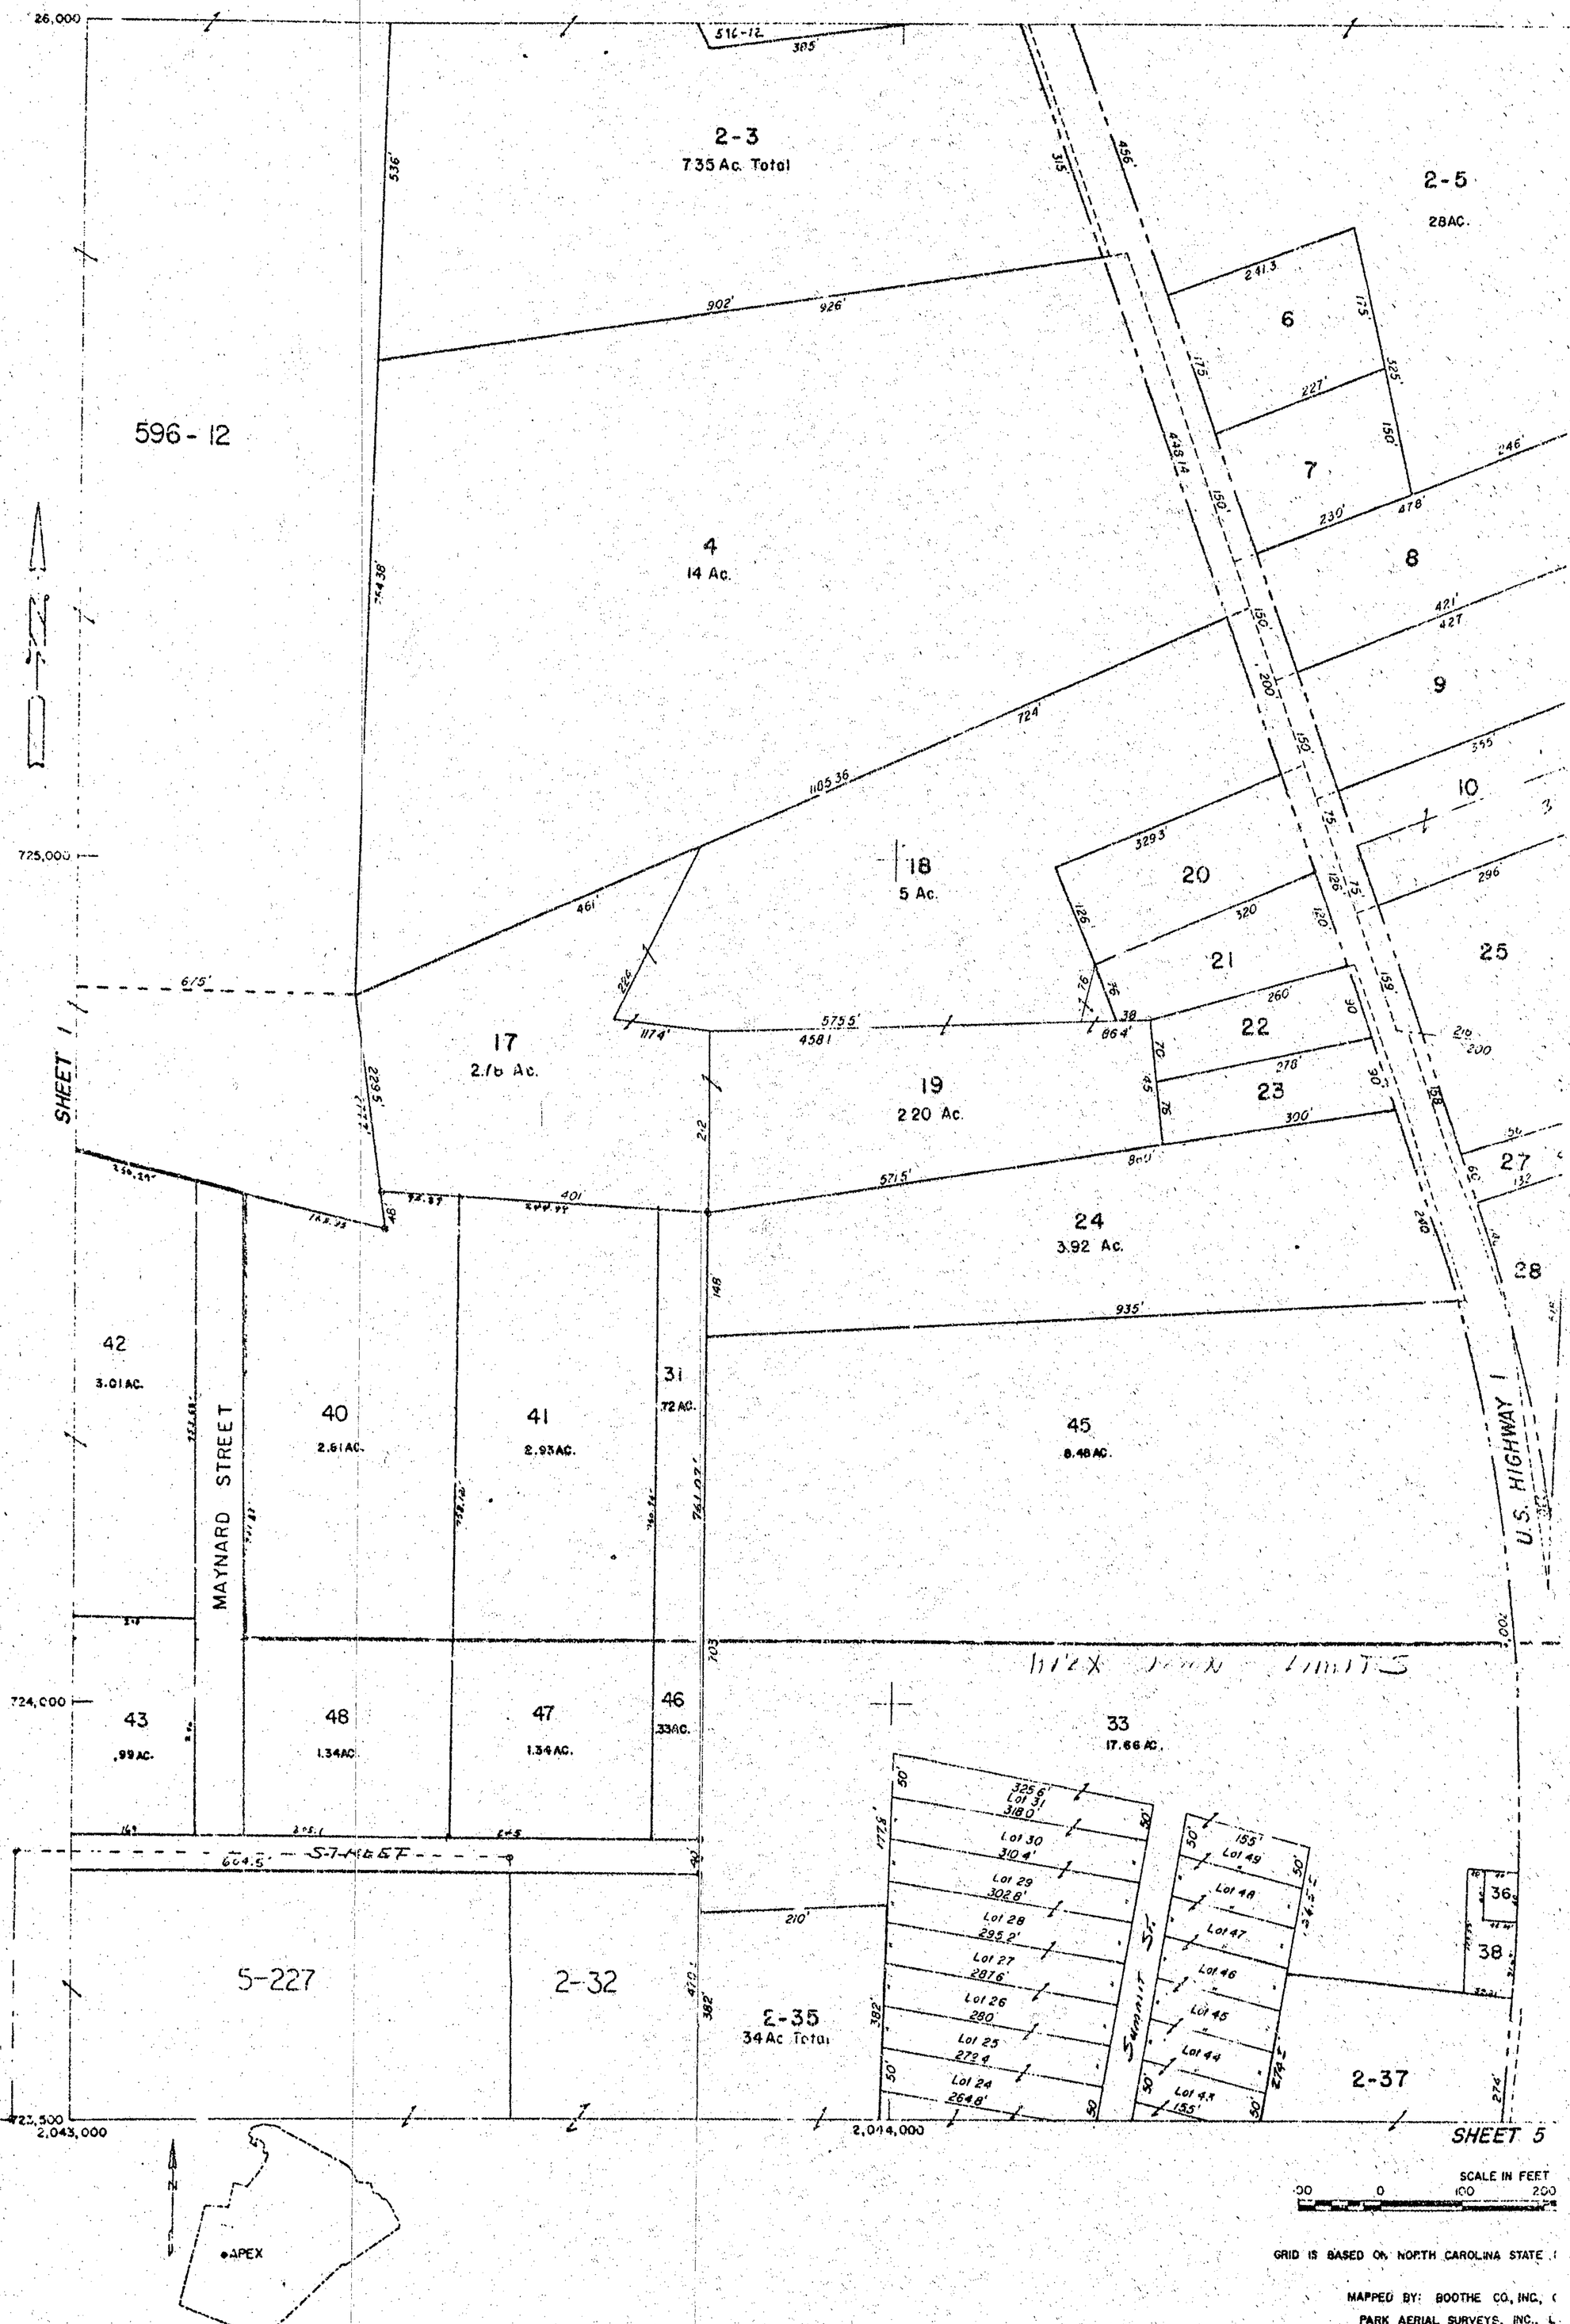
26,000
516-12
385
2-3
735 Ac. Total
536'
315'
456'
2-5
28AC.
241.3
902'
926'
6
175'
325'
227'
150'
7
246'
230'
478'
596-12
4
14 Ac.
754.38'
8
421'
427'
9
150'
200'
724'
1105.36
10
355'
3293'
20
18
5 Ac.
461'
296'
320'
120'
21
25
6/5'
SHEET 1
17
2.16 Ac.
5755'
4581'
1174'
864'
260'
22
19
220 Ac.
278'
23
300'
5715'
24
3.92 Ac.
935'
28
42
3.01 AC.
MAYNARD STREET
40
2.61AC.
41
2.93AC.
31
72 AC.
45
8.48 AC.
U.S. HIGHWAY 1
724,000
43
.99AC.
48
1.34AC.
47
1.34AC.
46
33AC.
33
17.66 AC.
604.5' STREET
5-227
2-32
2-35
34 Ac. Total
210'
325.6'
Lot 31
318.0'
Lot 30
310.4'
Lot 29
302.8'
Lot 28
295.2'
Lot 27
287.6'
Lot 26
280'
Lot 25
272.4'
Lot 24
264.8'
Summit St.
Lot 49
Lot 48
Lot 47
Lot 46
Lot 45
Lot 44
Lot 43
155'
36
38
2-37
722,500
2,043,000
2,044,000
SHEET 5
APEX
SCALE IN FEET
100 0 100 200
GRID IS BASED ON NORTH CAROLINA STATE
MAPPED BY: BOOTHE CO., INC.,
PARK AERIAL SURVEYS, INC.,
MAY 196
2
WAKE COUNTY

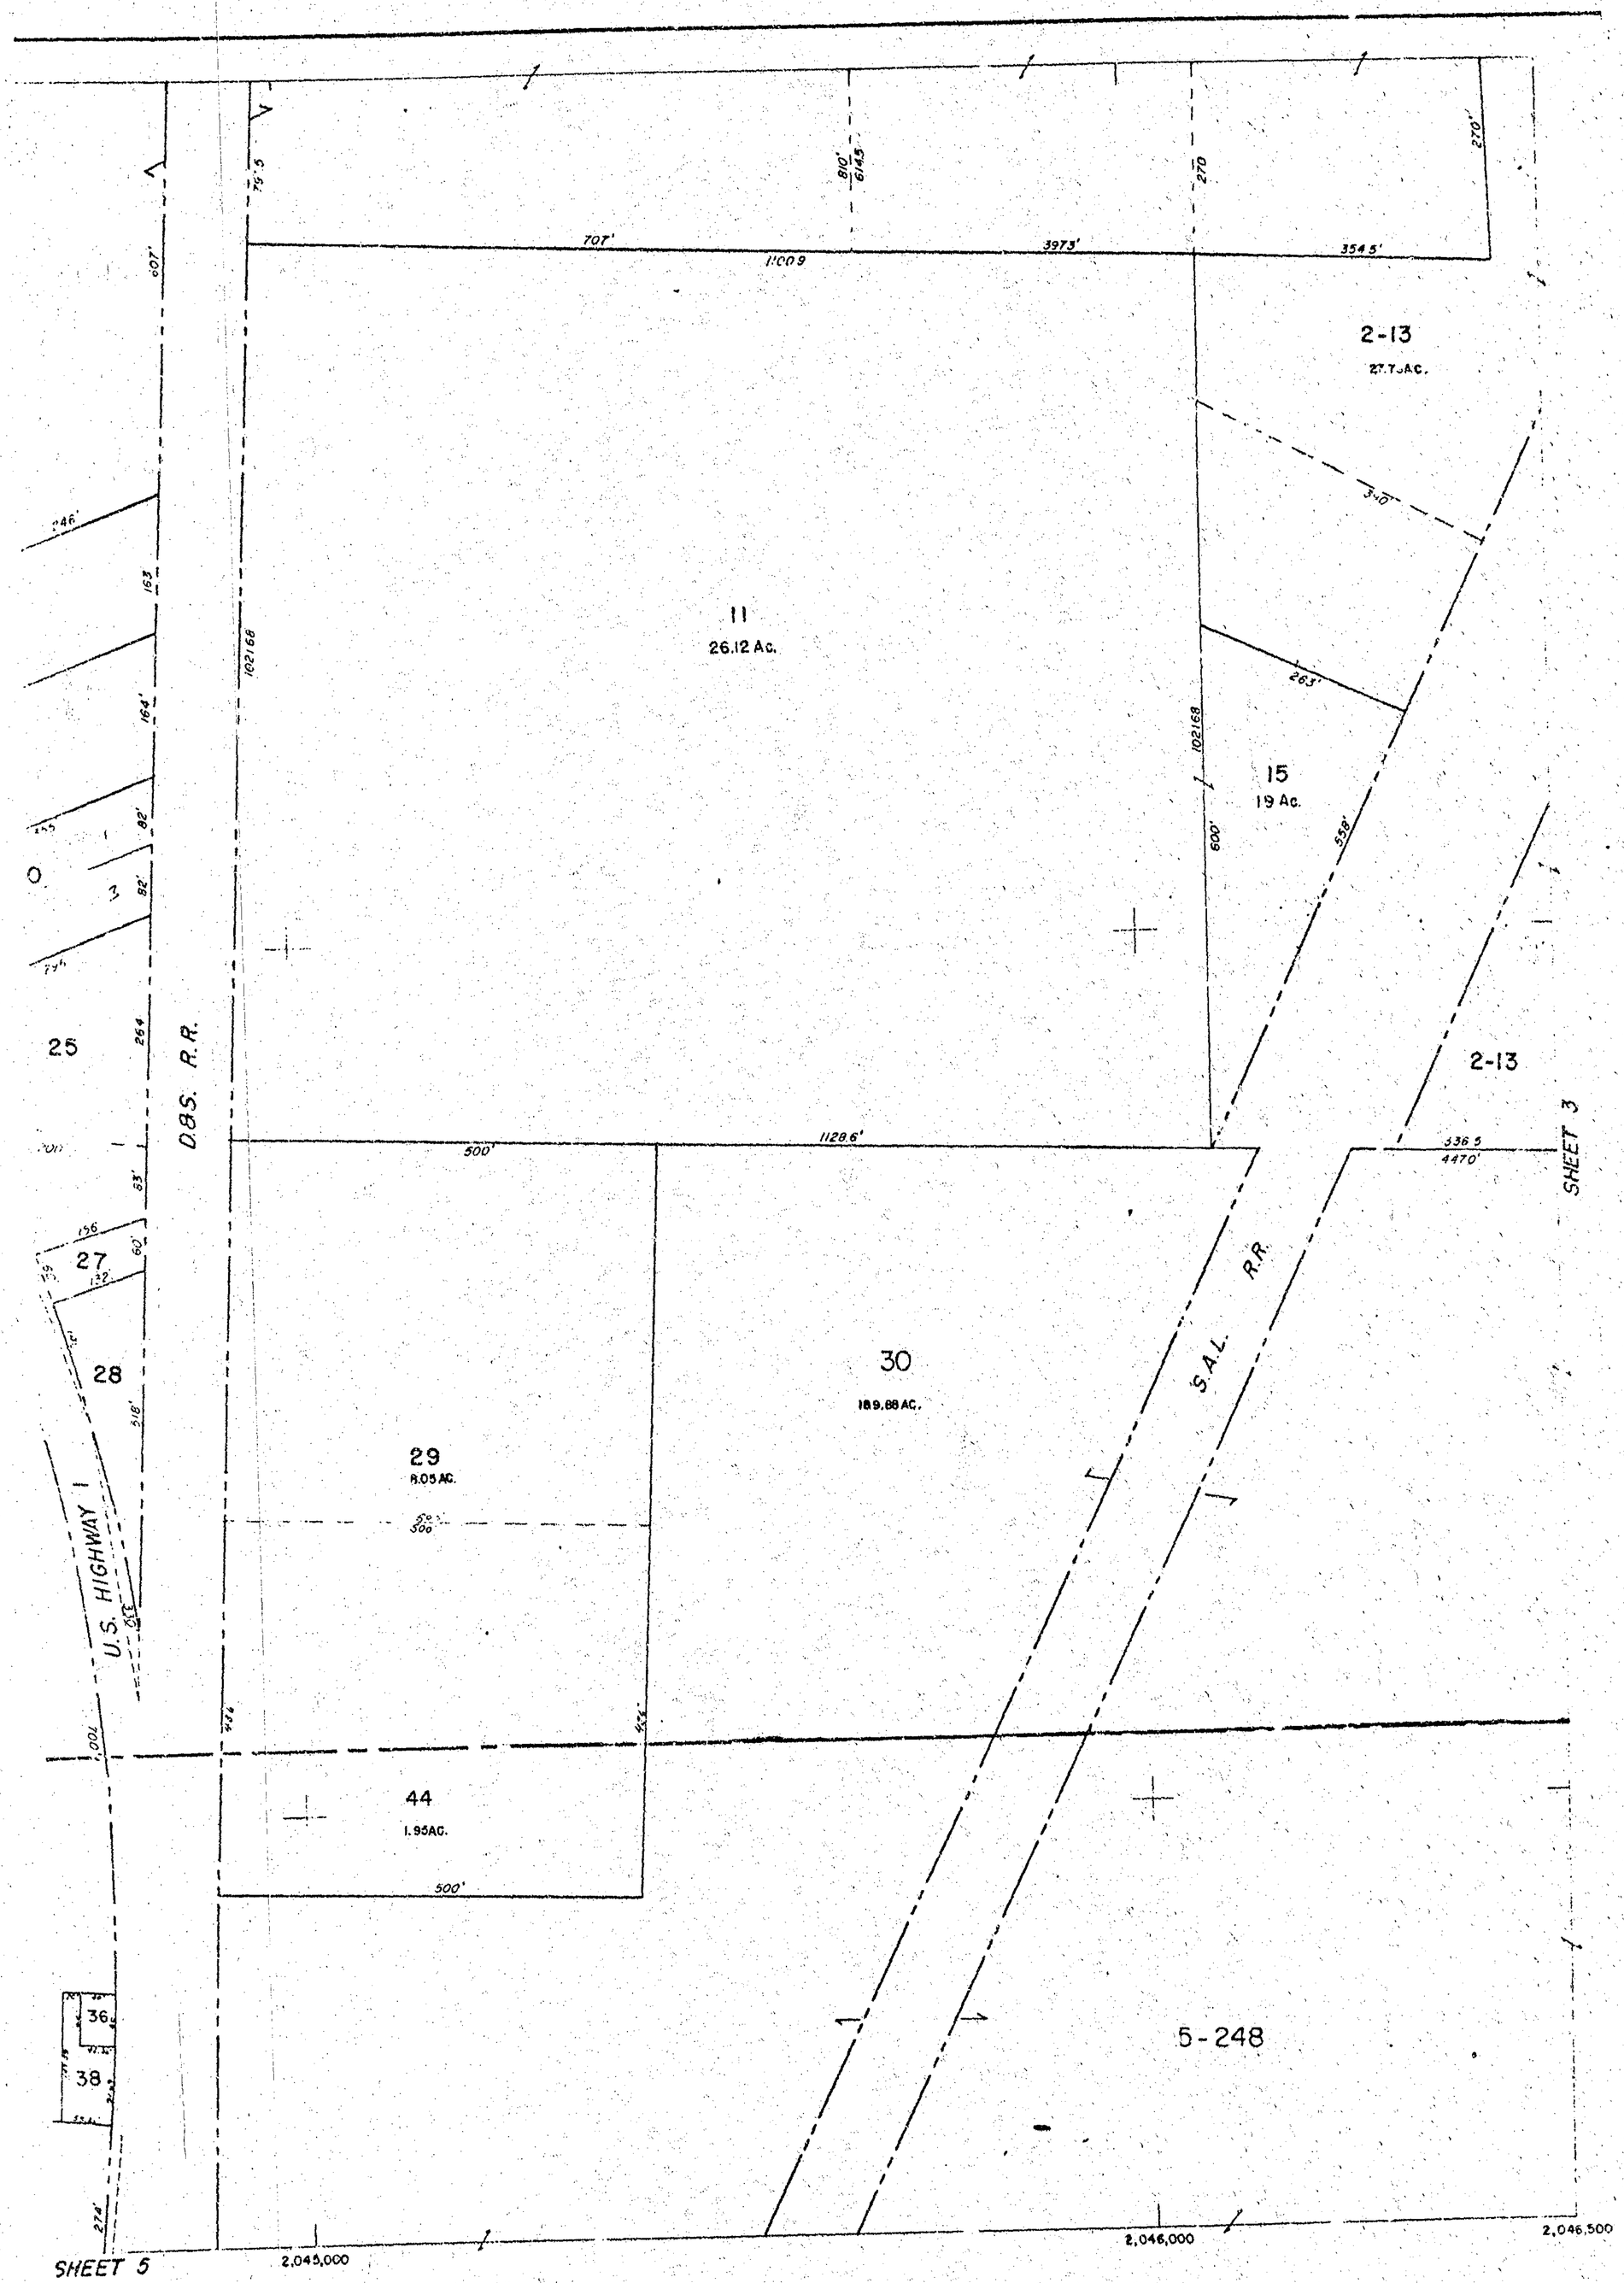

SCALE IN FEET
100 200 300 400

AROLINA STATE PLANE COORDINATE SYSTEM

TITLE CO., INC., GREENSBORO, N.C.
URVEYS, INC., LOUISVILLE, KY.
MAY 1958

APEX, N.C.

LAST No: /

SHEET 2

2

726,000

2-13

S.A.L. R.R.

790

3-1
22.34c. Total

1119'

1308

3184.5'

3
17.67 AC.

1142'

PINEWOOD DRIVE

159 .65AC. ③
160 .53AC. ⑥
161 .53AC. ⑦
162 .53AC. ⑧
163 .53AC. ⑨
164 .53AC. ⑩
165 .53AC. ⑪
166 .53AC. ⑫
168
170 ⑭
167 .63AC. ⑬
169
3.78 AC.
4
5
57 ⑫
136 ⑬
43
1AC.
137 ⑭
138 ⑮
139 ⑯
140 ⑰
141 ⑱
142 ⑲
143 ⑳
144 ㉑
145
146 ㉔
147 ㉕
148 ㉖
149 ㉗
150 ㉘
151 ㉙
152 ㉚
154 (84)
155 (85)
153 (83)
56 ⑪
55 ⑩
54 ⑨
53 ⑧
52 ⑦
51 ⑥
50 ⑤
49 ④
48 ③
47 ②
46 ①
158
2.46AC.
135 (74)
134 (74)
133 (73)
132 (72)
131 (71)
130 (70)
129 (69)
128 (68)
127 (67)
126 (66)
125 (65)
124 (64)
123 (63)
122 (62)
121 (61)
120 (60)
119 (59)
118 (58)
117 (57)
116 (56)
115 (55)
114 (54)
113 (53)
112 (52)
111 (51)
110 (50)
109 (49)
108 (48)
107 (47)
106 (46)
105 (45)
104 (44)
103 (43)
102 (42)
101 (41)
100 (40)
99 (39)
98 (38)
97 (37)
96 (36)
95 (35)
94 (34)
93
32
31 (122)
30 (121)
29 (120)
28 (119A)
74

NORWOOD LANE

PINEWOOD DRIVE

PINEWOOD DRIVE

SHEET 2

336.5'
4470'

998.5'

556.5'

2-30

724,000

5-248

2-30

723,500
2,046,500

2,047,000

2,048,000

SHEET 6


SCALE IN FEET
100 0 100 200

GRID IS BASED ON NORTH CAROLINA STATE PL

MAPPED BY: BOOTHE CO., INC., GR
PARK AERIAL SURVEYS, INC., LO
MAY 1958

APEX

3 WAKE COUNTY

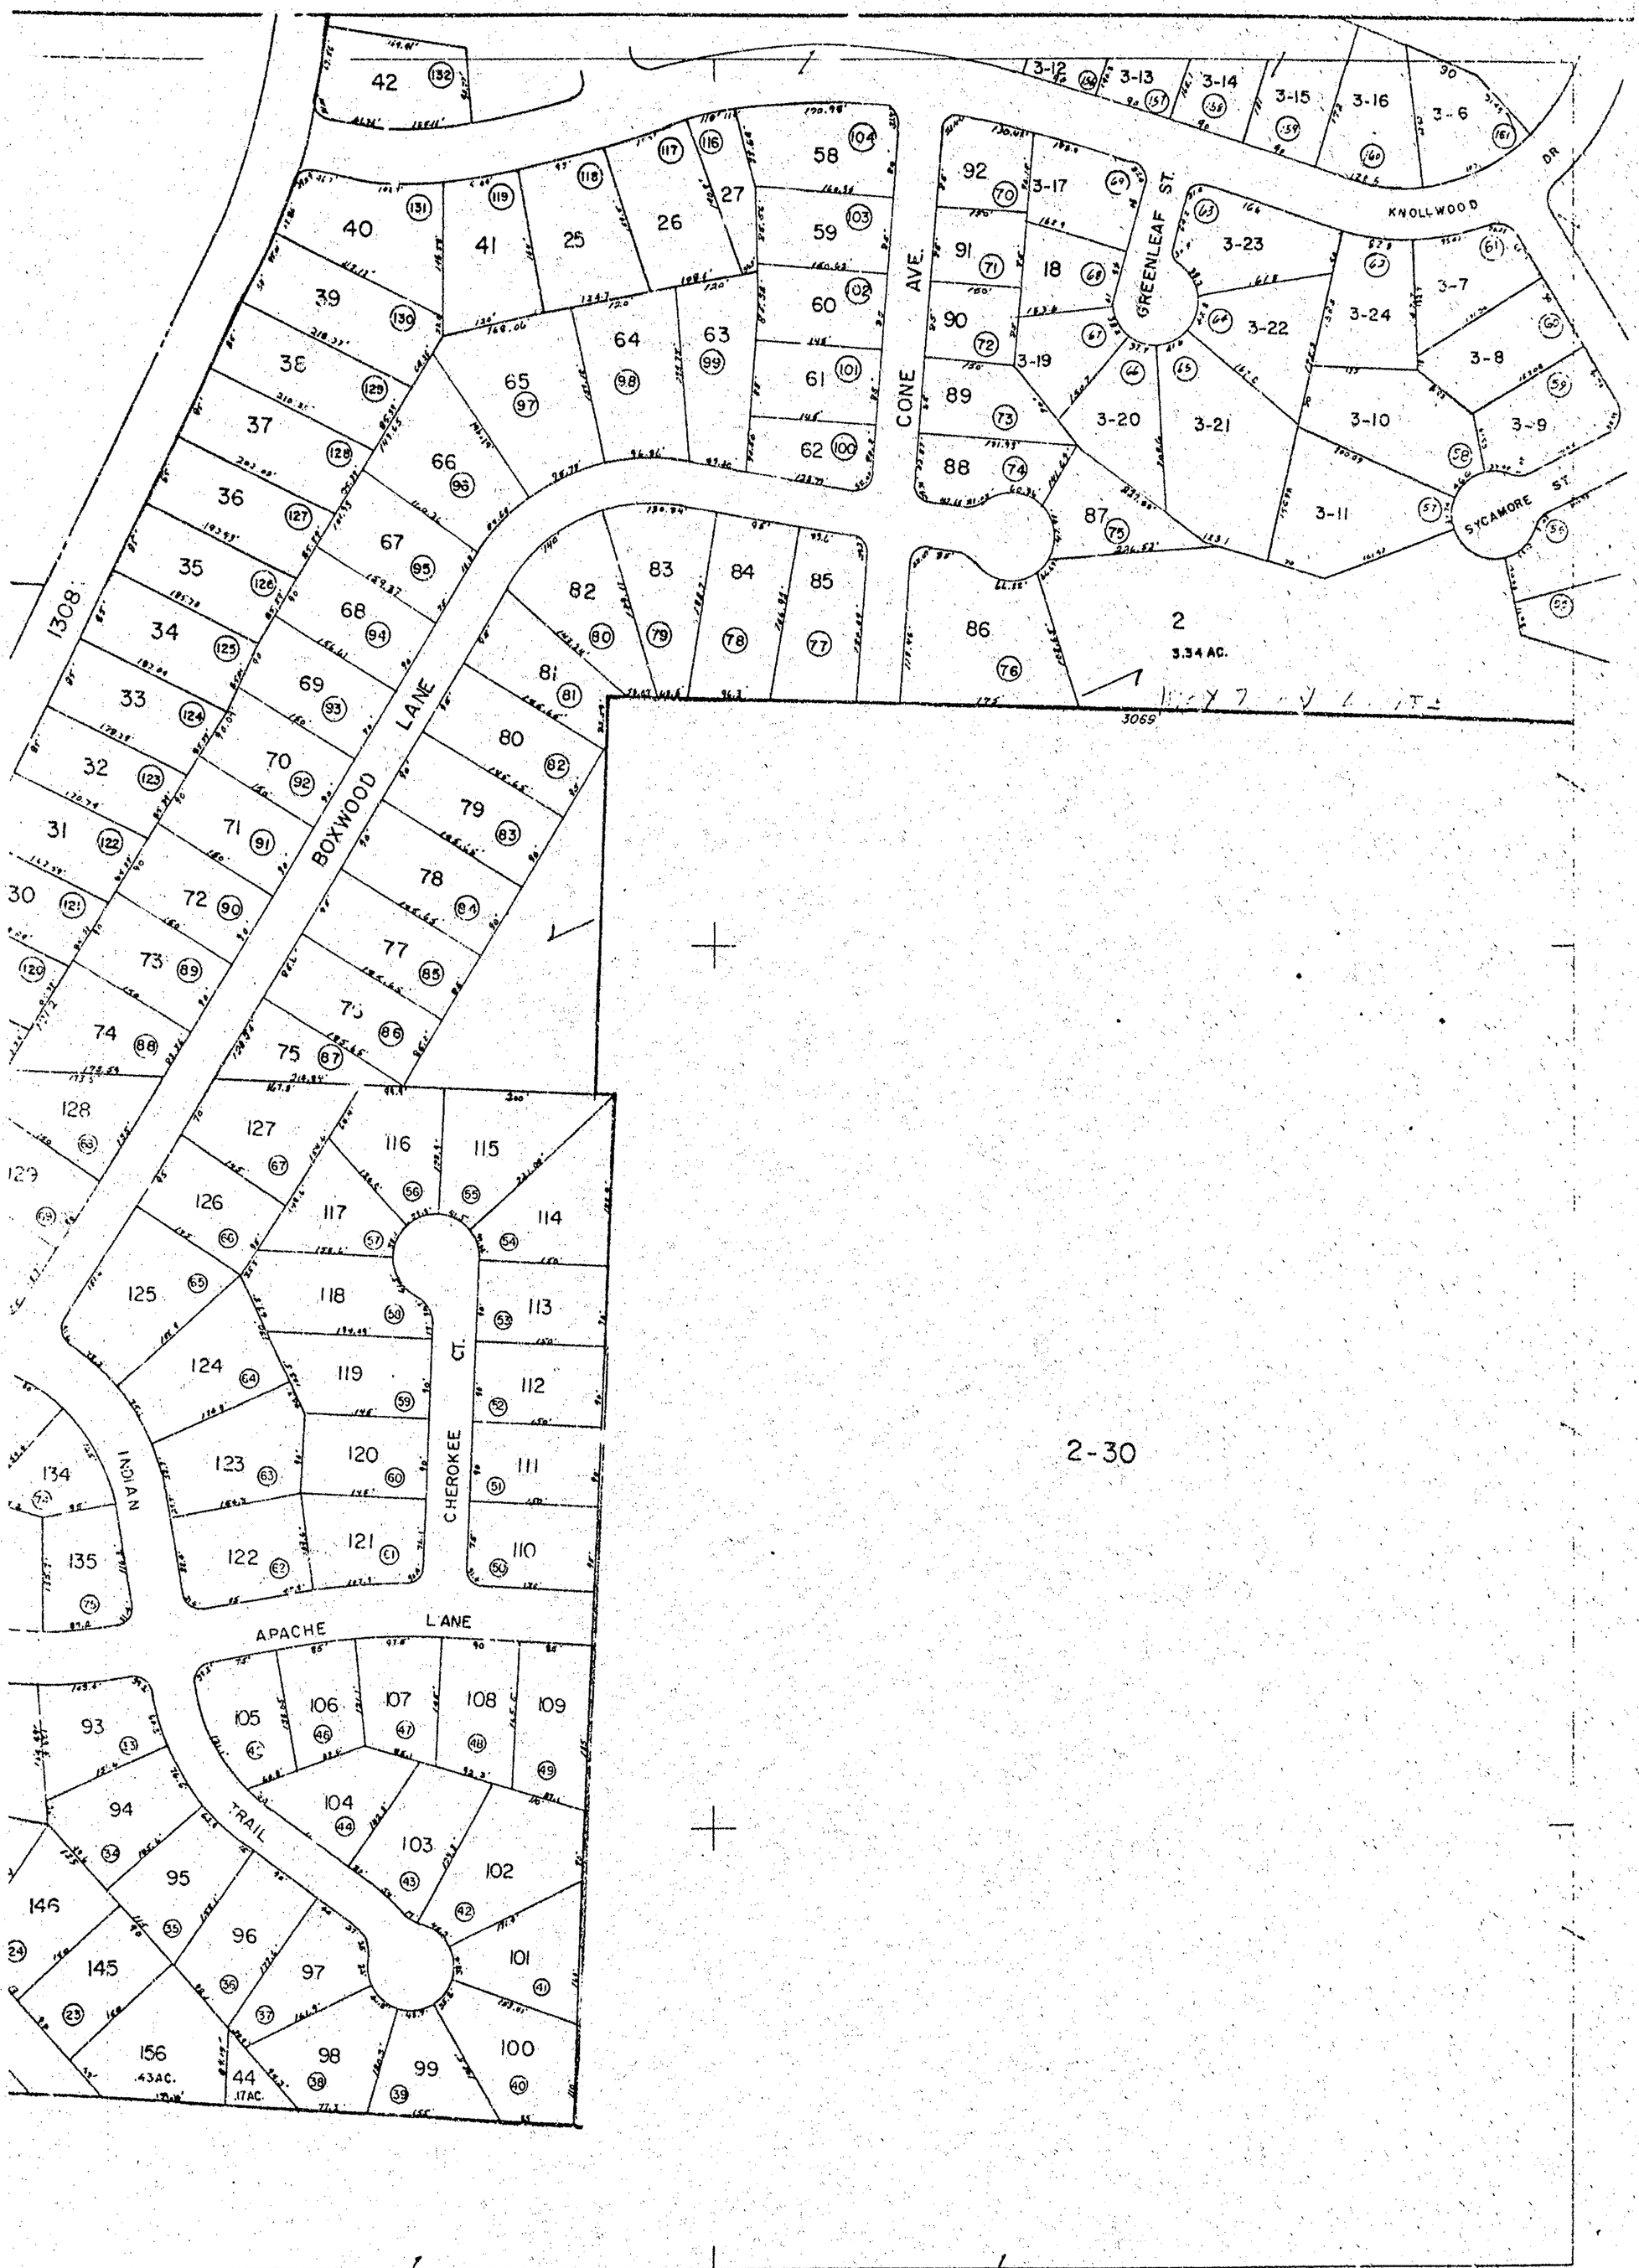

2-30

SHEET 6

2,049,000

2,050,000

SCALE IN FEET
100 200 300 400

AROLINA STATE PLANE COORDINATE SYSTEM

OTHE CO., INC., GREENSBORO, N.C.
URVEYS, INC., LOUISVILLE, KY.
MAY 1958

APEX, N.C.

LAST NO: 1

SHEET 3

SHEE

723,500

1-4
28.05Ac.

400'

LOT 9
1-5

LOT 10

1-10
10 Ac.

LOT 11
1-11

LOT
1-1

620'

67'

382'

STATE HWY 55

1222'

210
7.24 AC.

468'

214
2.76 AC.

2
3.12 Ac. Totc.

3
5 Ac. Total

3

723,000

OLIVE CHAPEL RD.

342'

680'

320'

19
1.5 Ac.

622-14

273'

270'

20

202
1.17 AC.

288.7'

278.86'

212
11.04 AC.

666.5'

220

204

22
1.58AC.

LOT 3

4-
21 AC.

477'

221
8.69AC.

1
2.52AC.

594'

.96 AC.

211

200'

722,000

209
3.87 AC.

208
17.11AC.

STATE HWY 55

222
33.19AC.

2063.3'

721,000
2,039,500

2,040,000

2,041,000

SHE

SCALE
100 0

GRID IS BASED ON NORTH CAROLI

MAPPED BY: BOOTHE
PARK AERIAL SURVEY
M

APEX

4 WAKE COUNTY

SHEET 1

Lockwood Acres 7/D 1959-344

5-227

SHEET 5

SHEET 7

SCALE IN FEET
0 100 200 300 400

ON NORTH CAROLINA STATE PLANE COORDINATE SYSTEM

PED BY: BOOTHE CO, INC. GREENSBORO, N.C.
RK AERIAL SURVEYS INC, LOUISVILLE, KY.
MAY 1938

APEX, N.C.

SHEET 4

LAST #2

4

SHEET 2

723,500

723,000

722,000

721,000
2,043,000

2,044,000

SHEET 4

SHEET 8

HIGHWAY No 1

U.S.

D.B.S.R.R.

HUNTER ST.

GROVE ST.

THOMPSON ST.

SAUNDERS ST.

TEMPLE ST.

TEMPLETON ST.

SALEM ST.

JONES ST.

W. CHATHAM ST.

ELM ST.

S.A.L. R.R.

227
12.11 AC.

241
8.53 AC.

237
1.14 AC.

65
7.41 AC.

188
1.91 Ac.

37
1.55 AC.

2-32 2-35 2-37 2-33 2-33 2-33

1 2 3 4 5 231 36 33 234 235 65 66 68 241 63

17 18 19 20 21 22 23 233 24 25 26

12 13 14 15 16

38 39 40 41 42 43 44 45 46 47 48 49 50 51 52 53 54 55 56 57 58 59 60 61 62 37

4-91 4-92 4-93 4-94

5-176

70 72 75 180 181 188 189 190 193 229 230 194 205 206 207 208 209 210 211 212 223 247 154 155 239 182 183 186 187 77 76 78 79 84 85 88 89 185 90 91 232 93 97 99 104 105 107 111 114

SAPEX

WAKE COUNTY

SCALE IN FEET


GRID IS BASED ON NORTH CAROLINA STATE

MAPPED BY BOOTHE CO., INC.,
PARK AERIAL SURVEYS, INC.,
MAY 1958

5

SHEET 3

2-30

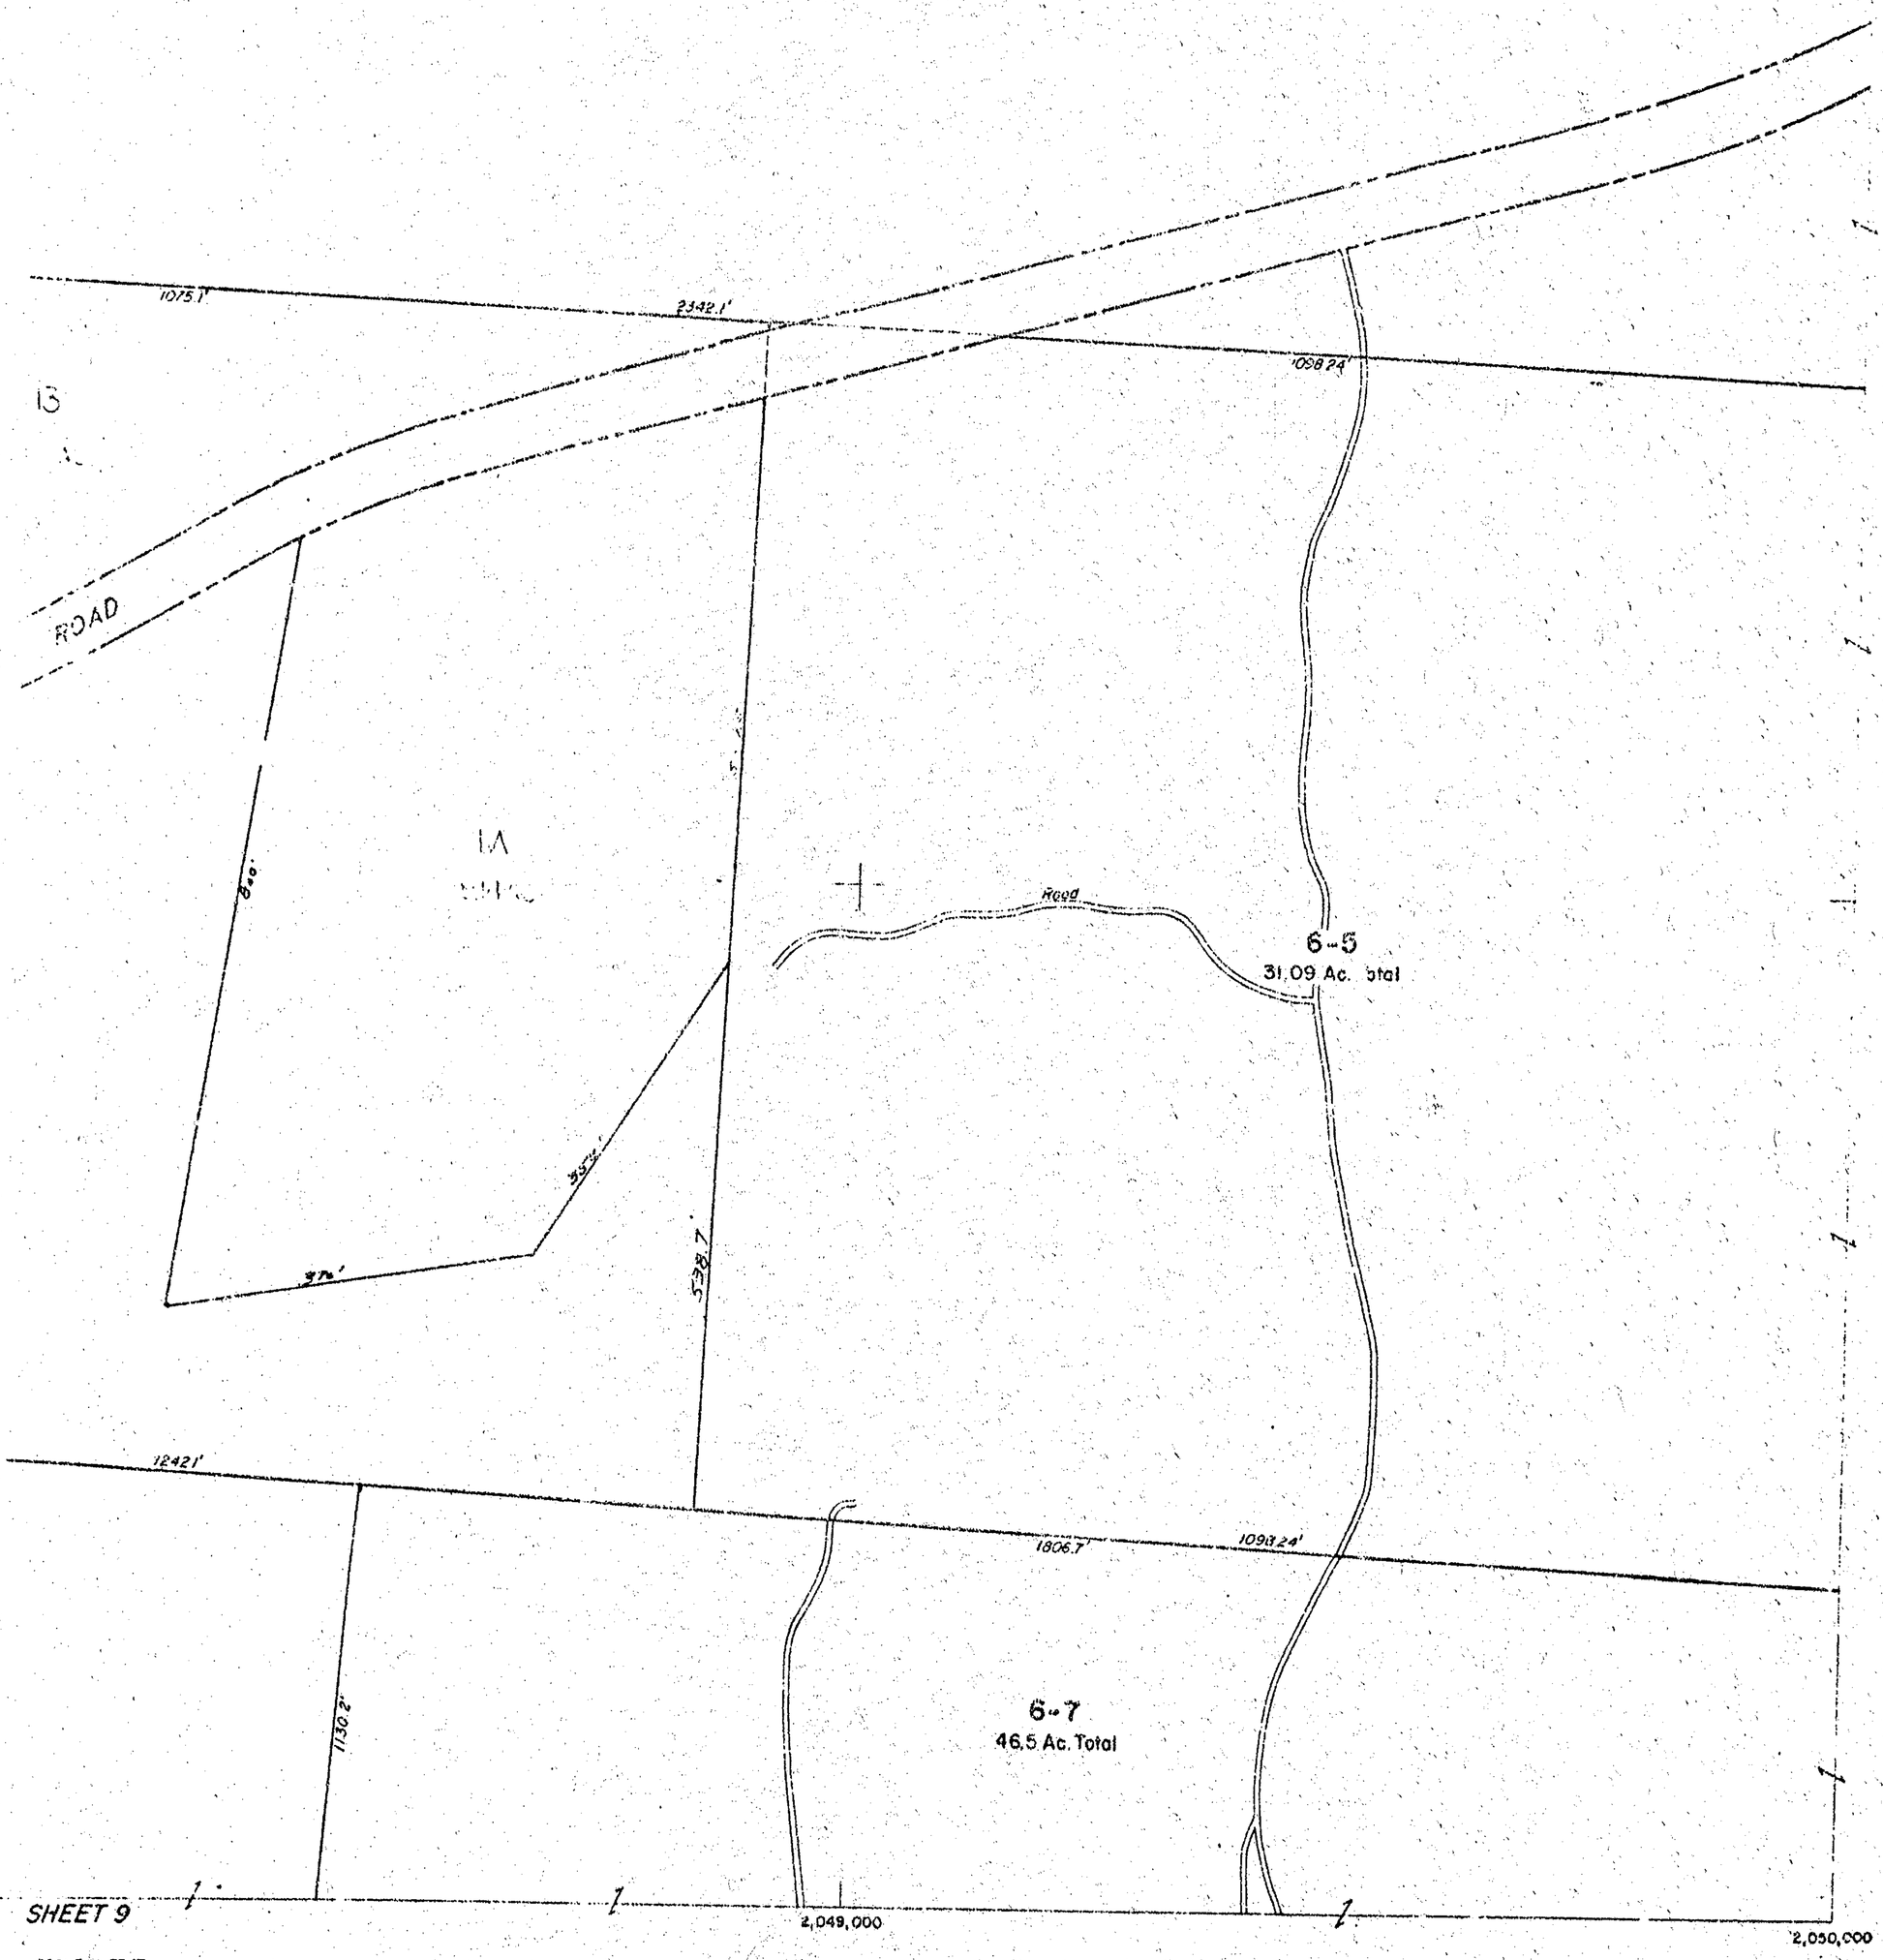

SHEET 9

SCALE IN FEET
100 200 300 400

H CAROLINA STATE PLANE COORDINATE SYSTEM

BOOTHE CO., INC., GREENSBORO, N.C.
AL SURVEYS, INC., LOUISVILLE, KY.
MAY 1958

APEX, N.C.

SHEET 6

LAST SHEET 6

SHEET 4

721,000

4-222

4-208

182

206.3'

ROAD

7-1

6.53 Ac.
W.T. Smith
To
Town of Apex

11.65 Ac
To Town of Apex
145C-16m
1 Pool

1568'

1491'
8°43'

STREAM

700

720,000

Tract # 1

236
10.31 Ac.

8
12.16 AC.

7-2
~~10.5 Ac Total~~

647-8
44.5 Ac. Tract No. 1
4.0 Ac. Tract No. 2
48.5 Ac. Total

1093.1'

420'

Tract # 2
4 Ac.

BULLOCK CT.

ABRAHAM CIRCLE

LYNCH ST.

CORRENNA ST.

201 200 199 202 203 204 205 206 207 208 209 210 211 212 213 214 215 216 217 218 219 220 221 222 223 224 198 197 196 195 194 193 8-A LOT 4 150' 228

1568'

420

248.2'

231
4.6 AC.

232
.18 AC

330.7'

719,000

647-11

230
27.78 AC.

237
8.89 AC.

814'

1780'

LOT 1

LOT 2

LOT 3

7-143
9.55 Ac Tot

10-22

718,500
2,039,500

2,040,000

2,041,000

SHEET 10

SCALE IN FEET
100 0 100 200

GRID IS BASED ON NORTH CAROLINA STATE


MAPPED BY: BOOTHE CO, INC.
PARK AERIAL SURVEYS, INC.
MAY, 1958

APEX

7

WAKE COUNTY

SHEET 4

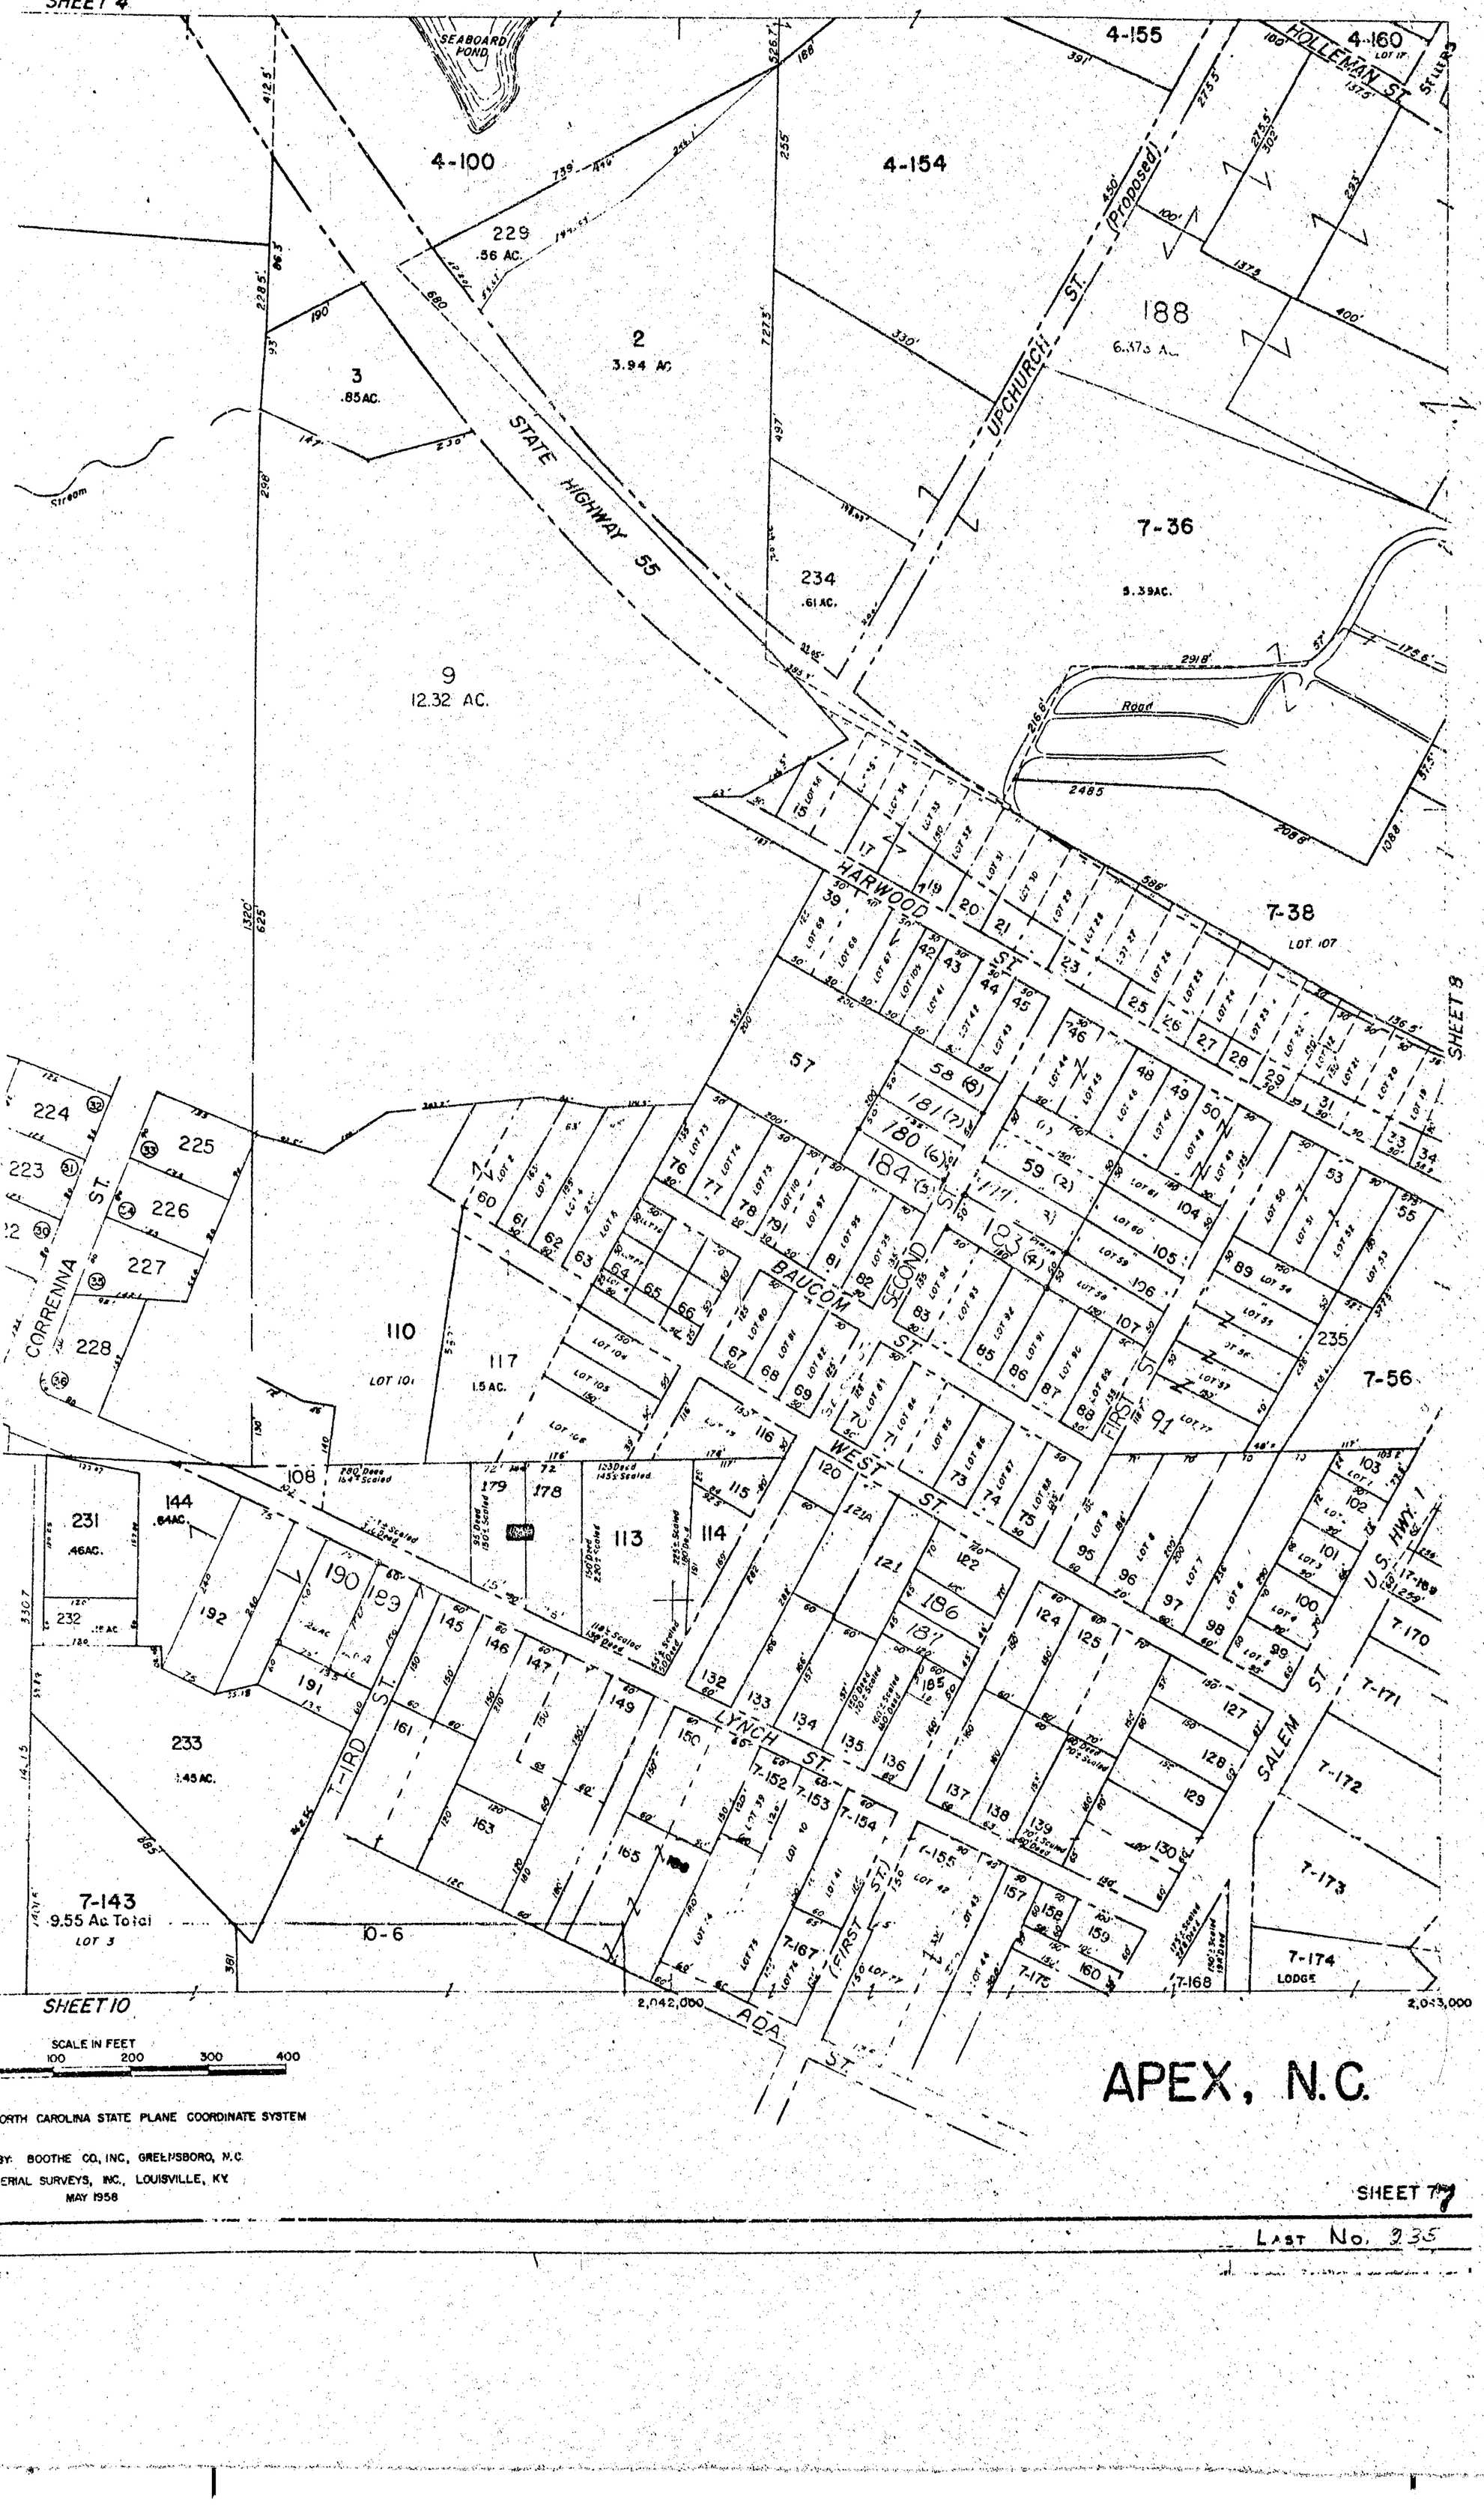

SCALE IN FEET
100 200 300 400


NORTH CAROLINA STATE PLANE COORDINATE SYSTEM


BY: BOOTHE CO, INC, GREENSBORO, N.C.
AERIAL SURVEYS, INC., LOUISVILLE, KY.
MAY 1958

APEX, N.C.

SHEET 7

LAST No. 235

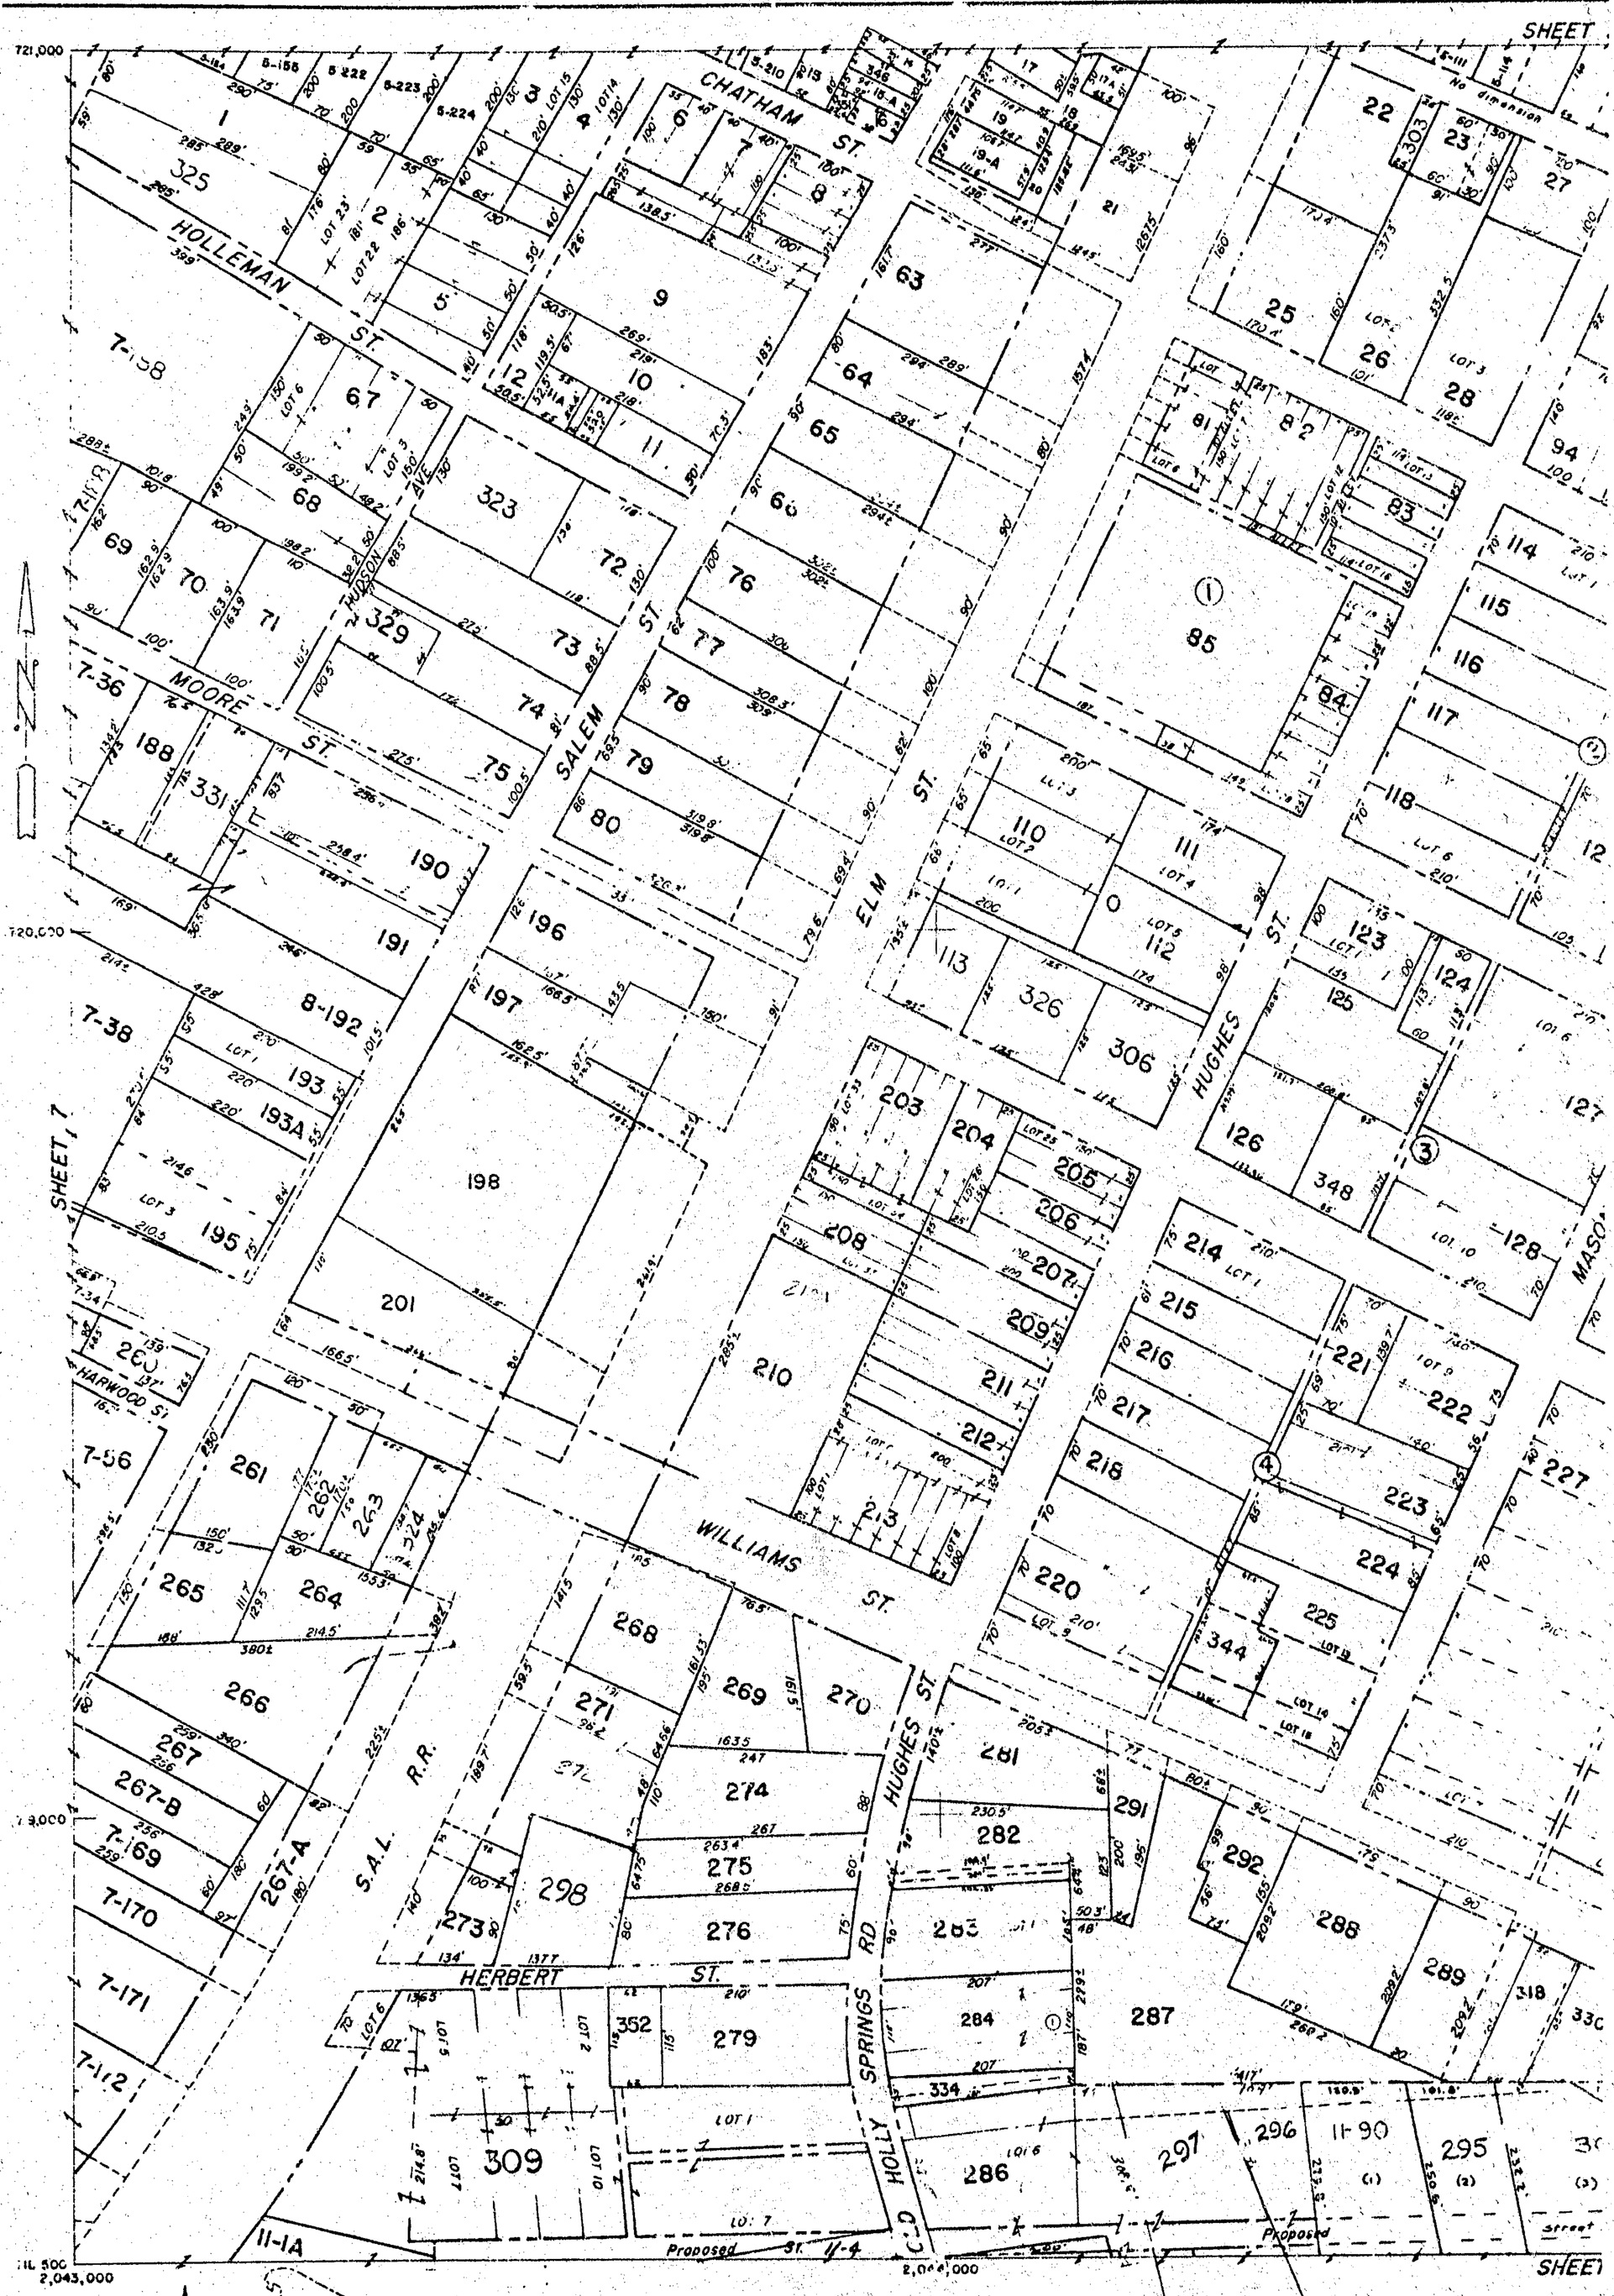
721,000
SHEET
CHATHAM ST.
HOLLEMAN ST.
MOORE ST.
HUDSON AVE
SALEM ST.
ELM ST.
HUGHES ST.
WILLIAMS ST.
HERBERT ST.
HARWOOD ST
S.A.L. R.R.
SPRINGS RD
HOLLY
MASO
Proposed St. 11-4
Proposed
720,000
2,043,000
2,044,000
SCALE IN
100 0 100
APEX
8
WAKE COUNTY

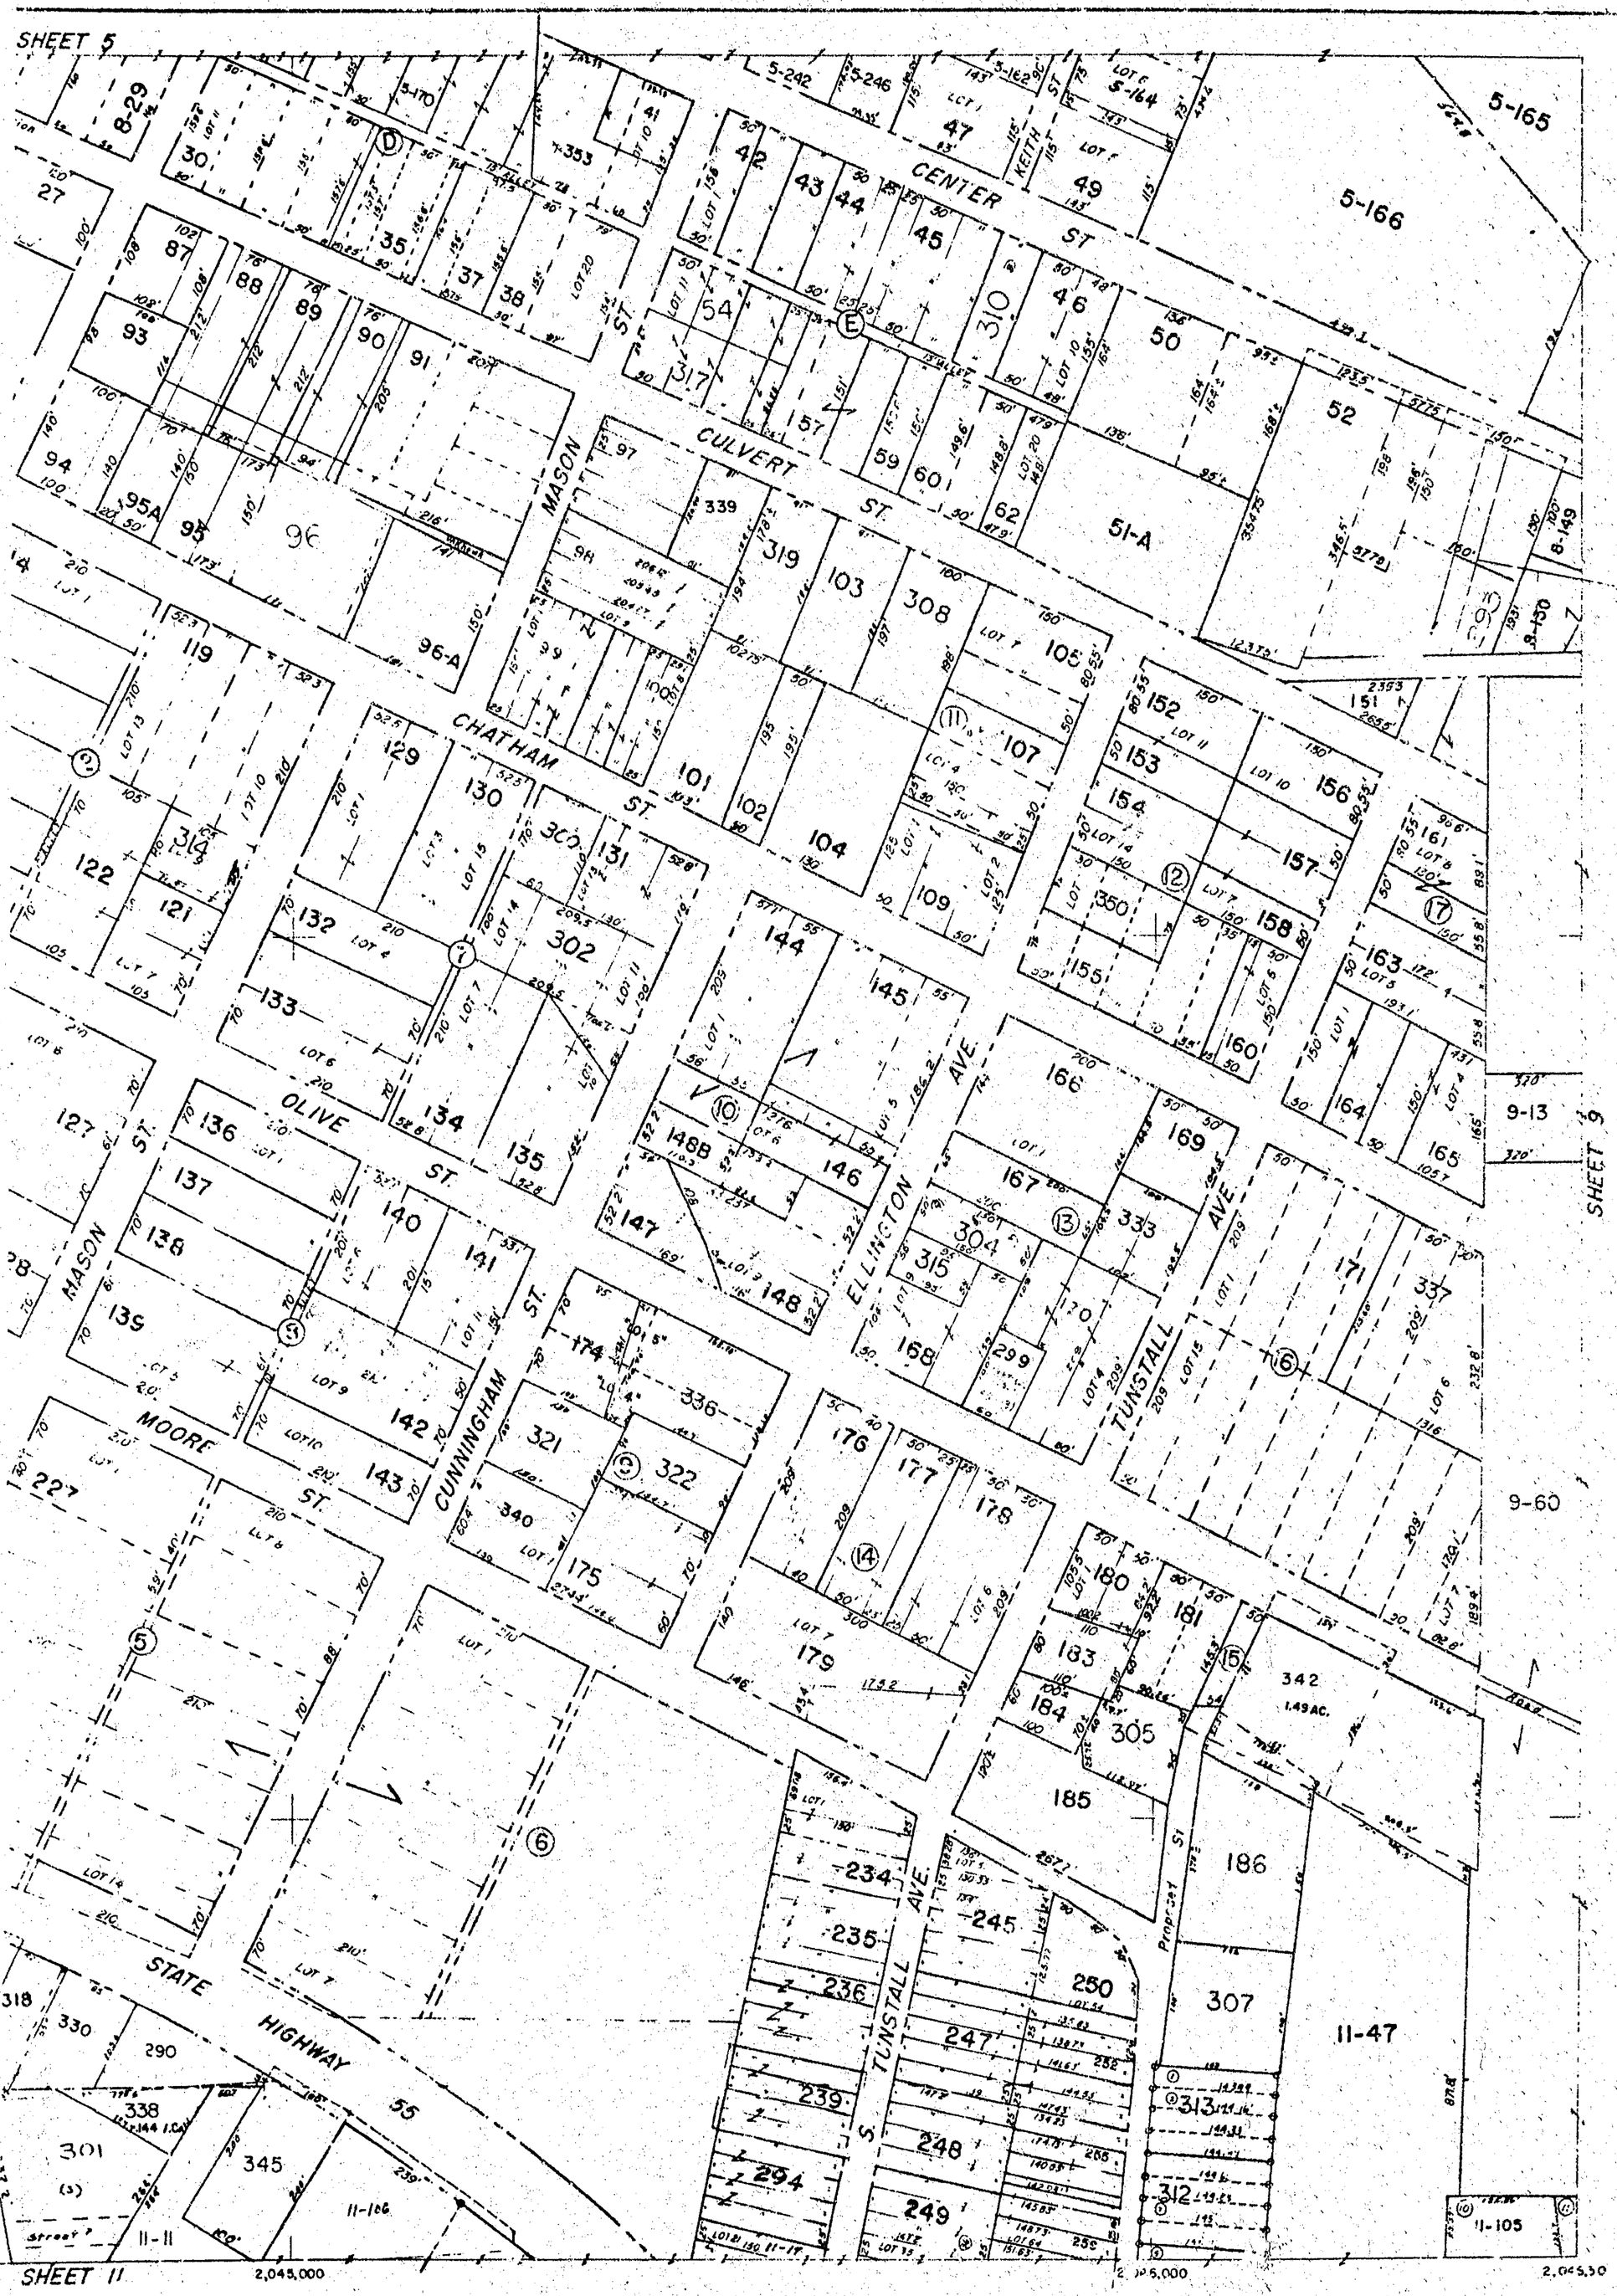

SCALE IN FEET
100 200 300 400

CAROLINA STATE PLANE COORDINATE SYSTEM

DOC NO [illegible], CO. MDC. N. C.
L SURVEYS INC LOUISVILLE, KY.
MAY 1956

APEX, N.C.

(8 OF 12)

LAST NO.

SHEET 8 OF 28

SHEET 6

721,000

6-3

6-17

CORPORATION LIMITS

66
5.23 Ac.
CAR. MFG. CO.
1399 [illegible]

6-6
W. G. COOKE
10.58 Ac.

9-1
3Ac. Total

1.21 Ac.

DURHAM & SOUTHERN R.Y.

3
1.58 Ac.

4
2.97 Ac.
CAR. MFG. CO.

5
2 Ac.
2.97 Ac.

7
2 Ac.

8
1Ac.

9
1 Ac.

10
2.5

CENTER STREET

8-149

8-149A

8-150

9-11

CULVERT STREET
562.7' Deed 662.7'± Scaled

1398'

15

16

73
7.51 AC.

720,000

9-12
7.54 Ac. Total

14

17

S.R. 1306

9-13

SHEET 8

950.4'

70
6.12 AC.

18
13.34 AC.

STATE NORTH LINES

60
22.29 AC.

719,000

Road

61
15 Ac.

DURHAM & SOUTHERN R.R.

69

12-29 12-30 12-31 12-32 12-33 12-34 12-1 63 12-44 12-42

718,500
2,046,500

2,047,000

2,048,000

Lot 21

SHEET 12

SCALE IN FEET
100 0 100 200

GRID IS BASED ON NORTH CAROLINA STATE

MAPPED BY: BOOTHE CO., INC.,
PARK AERIAL SURVEYS, INC.,
MAY 1958

APEX

9 WAKE COUNTY

SHEET 6

APEX, N.C.

SHEET 12

SCALE IN FEET
100 200 300 400

H CAROLINA STATE PLANE COORDINATE SYSTEM

BOOTHE CO., INC., GREENSBORO, N.C.
IL SURVEYS, INC., LOUISVILLE, KY.
MAY 1956

SHEET 9

9

718,500

715,000

717,000

716,000

2,039,500

2,040,000

2,041,000

647-11

BLVD.

CARDINAL

7-230

10-1
68.84 Ac.
Total

10-2
102.4AC.

7-143
LOT 3

LOT 1

LOT 2

LOT 5

LOT 6

43
.46 AC.

Road

U. S. HIGHWAY NO. 1

1104'
880'
716'
250'
286'
556'
270'
580'
1819'
1814'
1401.5'
100'
202'
100'
3290'
3290'
1591'
1610'
3346'
1630'
526'
228'
600'

SCALE IN FEET
100 0 100 200


GRID IS BASED ON NORTH CAROLINA STATE

MAPPED BY: BOOTHE CO., INC., G
PARK AERIAL SURVEYS, INC., L
MAY 1958

•APEX

10 WAKE COUNTY

SHEET 7

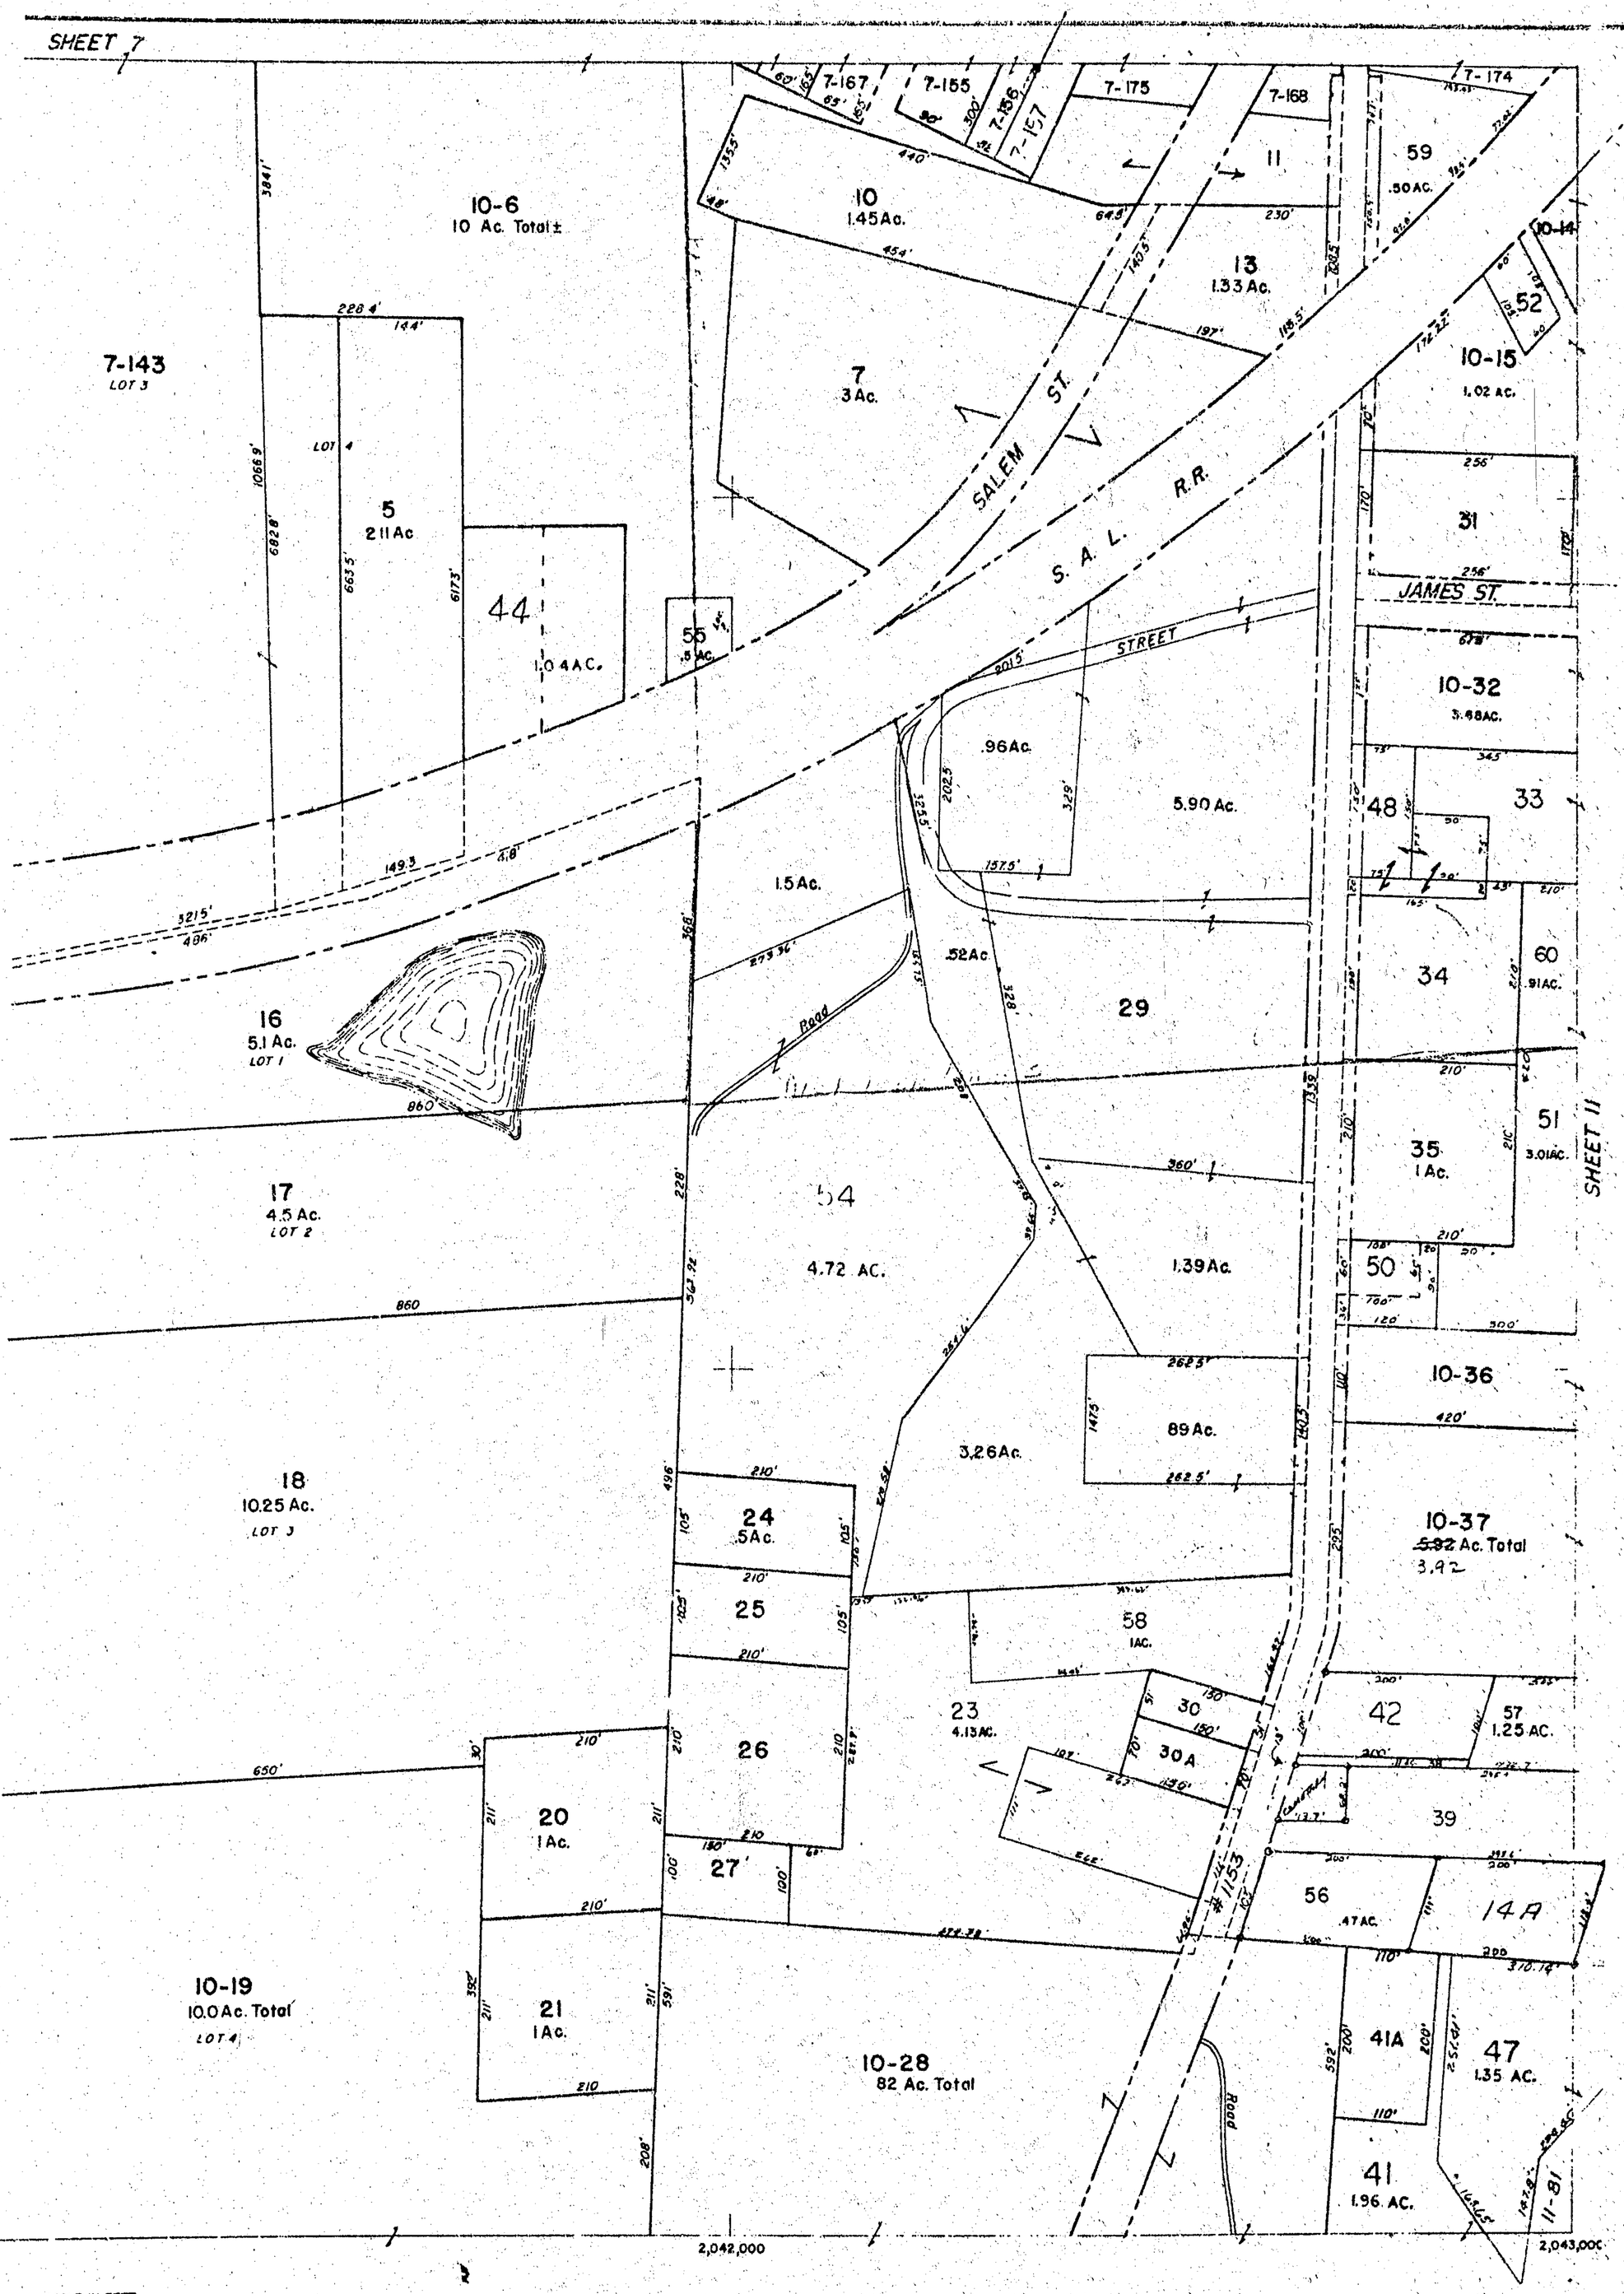

SCALE IN FEET
100 200 300 400

ORTH CAROLINA STATE PLANE COORDINATE SYSTEM

Y: BOOTHE CO., INC., GREENSBORO, N.C.
ERIAL SURVEYS, INC., LOUISVILLE, KY.
MAY 1956

APEX, N.C.

SHEET 10

LAST, No # 10

SHEET 8

718,500

SAL R.R

11-1A

10-14
1.75 AC.

1
.92 Ac.

82
1 Ac.

78

11-4

107
1.52 AC.

Proposed 5th Street

119
.31 AC.

120
.31 AC.

112
.31 AC.

5
4.83 AC.

6

8-286

8-297

90

6A

7

87

84

7B

7C

8

88

77

9

10

JAMES ST.

COOKE ST.

(HA) N. D. 351

10-15
.49 AC.

Z

91

115

109
3.29 AC.

718,000

94

95

96

97

98

99

100

101

LOT 1 … LOT 29

49
7.07 AC.
LOT 30

1.96 Ac.
LOT 31

2.25 Ac.
LOT 32

2.48 Ac.
LOT 33

53
7 AC.

117
2.12 AC.

52

OLD HOLLY SPRINGS ROAD

10-33

10-60

10-32

10-51

116
1.46 AC.

SHEET 10

10-36

10-37

92
2 AC.

717,000

10-57

11-89

108
1.03 AC.

81
4.69 Ac.
O.B. Perry

69
1.81 Ac.
LOT 3

1.75 Ac.
LOT 4

1.8 Ac
LOT 5

72
5.94 Ac
LOT 7

72
8.38 Ac.
LOT 6

11-68
99.1 Ac. Total

11-73
19 Ac. Total
LOT 32

(Dead end road)

716,000
2,043,000

2,044,000

SHEET

SCALE IN F

GRID IS BASED ON NORTH CAROLINA S

MAPPED BY: COOKE CO., I
PARK MAPPING SURVEYS, I

APEX

11

WAKE COUNTY

SHEET 8

106
6.69 AC.

15

86
.42 AC.

79
.5 Ac.

21

28

34

40

46

85

11-47
4.43 AC.

105

104

103

102

OLD HAYWOOD RD.

54
3.4 Ac.
LOT 10
17.85 TOTAL AC.

3.3 Ac.
LOT 9

2.75 Ac.
LOT 11

2.13 Ac.
LOT 12

2.12 Ac.
LOT 13

2.11 Ac.
LOT 14

60
2.997 AC.
LOT 15

LOT 16

67
7.6 AC.
LOT 17

118
4 AC.
LOT 8

64

66

STATE HIGHWAY 55

12-43
.66 AC.

93

11-62

113
.27 AC.

74

72
5.94 Ac.
LOT 7

72
8.78 Ac.
LOT 6

65
18.34 Ac.

11-73
21.7 Ac. Total
LOT 33
90.53 AC. TOTAL

11.46 Ac. Total
LOT 34

LOT 42

11-75
95.36 Ac. Total

Figure

SHEET 12

SHEET

2,045,000

2,046,000

SCALE IN FEET
100 200 300 400

CAROLINA STATE PLANE COORDINATE SYSTEM

11

7:8,500

BRYN-MAWR COURT

BRIARCLIFF STREET

29 30 31 32 33 34 35 36 37 38 39 40 41 28 27 26 23 24 25

OLD HAYWOOD RD.

718,000

13 1 Ac. THO. as E.

12-1A

11-67

12-1 LOT 19 (2.9 Ac.)

14 7.29 AC. PT. TRACT-18

EASTWOOD DR.

13 .39 AC.

21 .33 AC.

968

42 .65AC.

44 5.57AC.

2 3.73AC.

12-15 16.55 Ac.

Road

DURHAM & SOUTHERN RY.

1242.54'

1429.64' Road

Road

43 6.23 AC.

SHEET 11

717,000

11-62

22 1.729 AC.

19 20 AC. PT. TRACT-18

STATE HWY 55

11.75

11-75 LOT 42

B. F. M. LEOD Jr. 12-9 Ac. Total 3.01 Part LOT 42

2,047,000

APEX

12 WAKE COUNTY

SCALE IN FEE

GRID IS BASED ON NORTH CAROLINA SYSTEM

MAPPED BY: BOOTHE CO., INC
PARK AERIAL SURVEYS, INC
MAY 1958

SHEET 9

12-3
1 Ac. Total

12-4
13 Ac. Total
(8Ac.)

12-4
13 Ac. Total
(5Ac)

12-6

648-9

12-15
16.55 Ac.

7
23.74 Ac.
LOT 23

LOT 24

648-5

648-3

Road

NEW U.S.-1 R/W - 260'

LOT 25

SCALE IN FEET
100 200 300 400


NORTH CAROLINA STATE PLANE COORDINATE SYSTEM

BY: BOOTHE CO., INC., GREENSBORO, N.C.
AERIAL SURVEYS, INC., LOUISVILLE, KY.
MAY 1958

APEX, N.C.

LAST NO: 41

SHEET 12

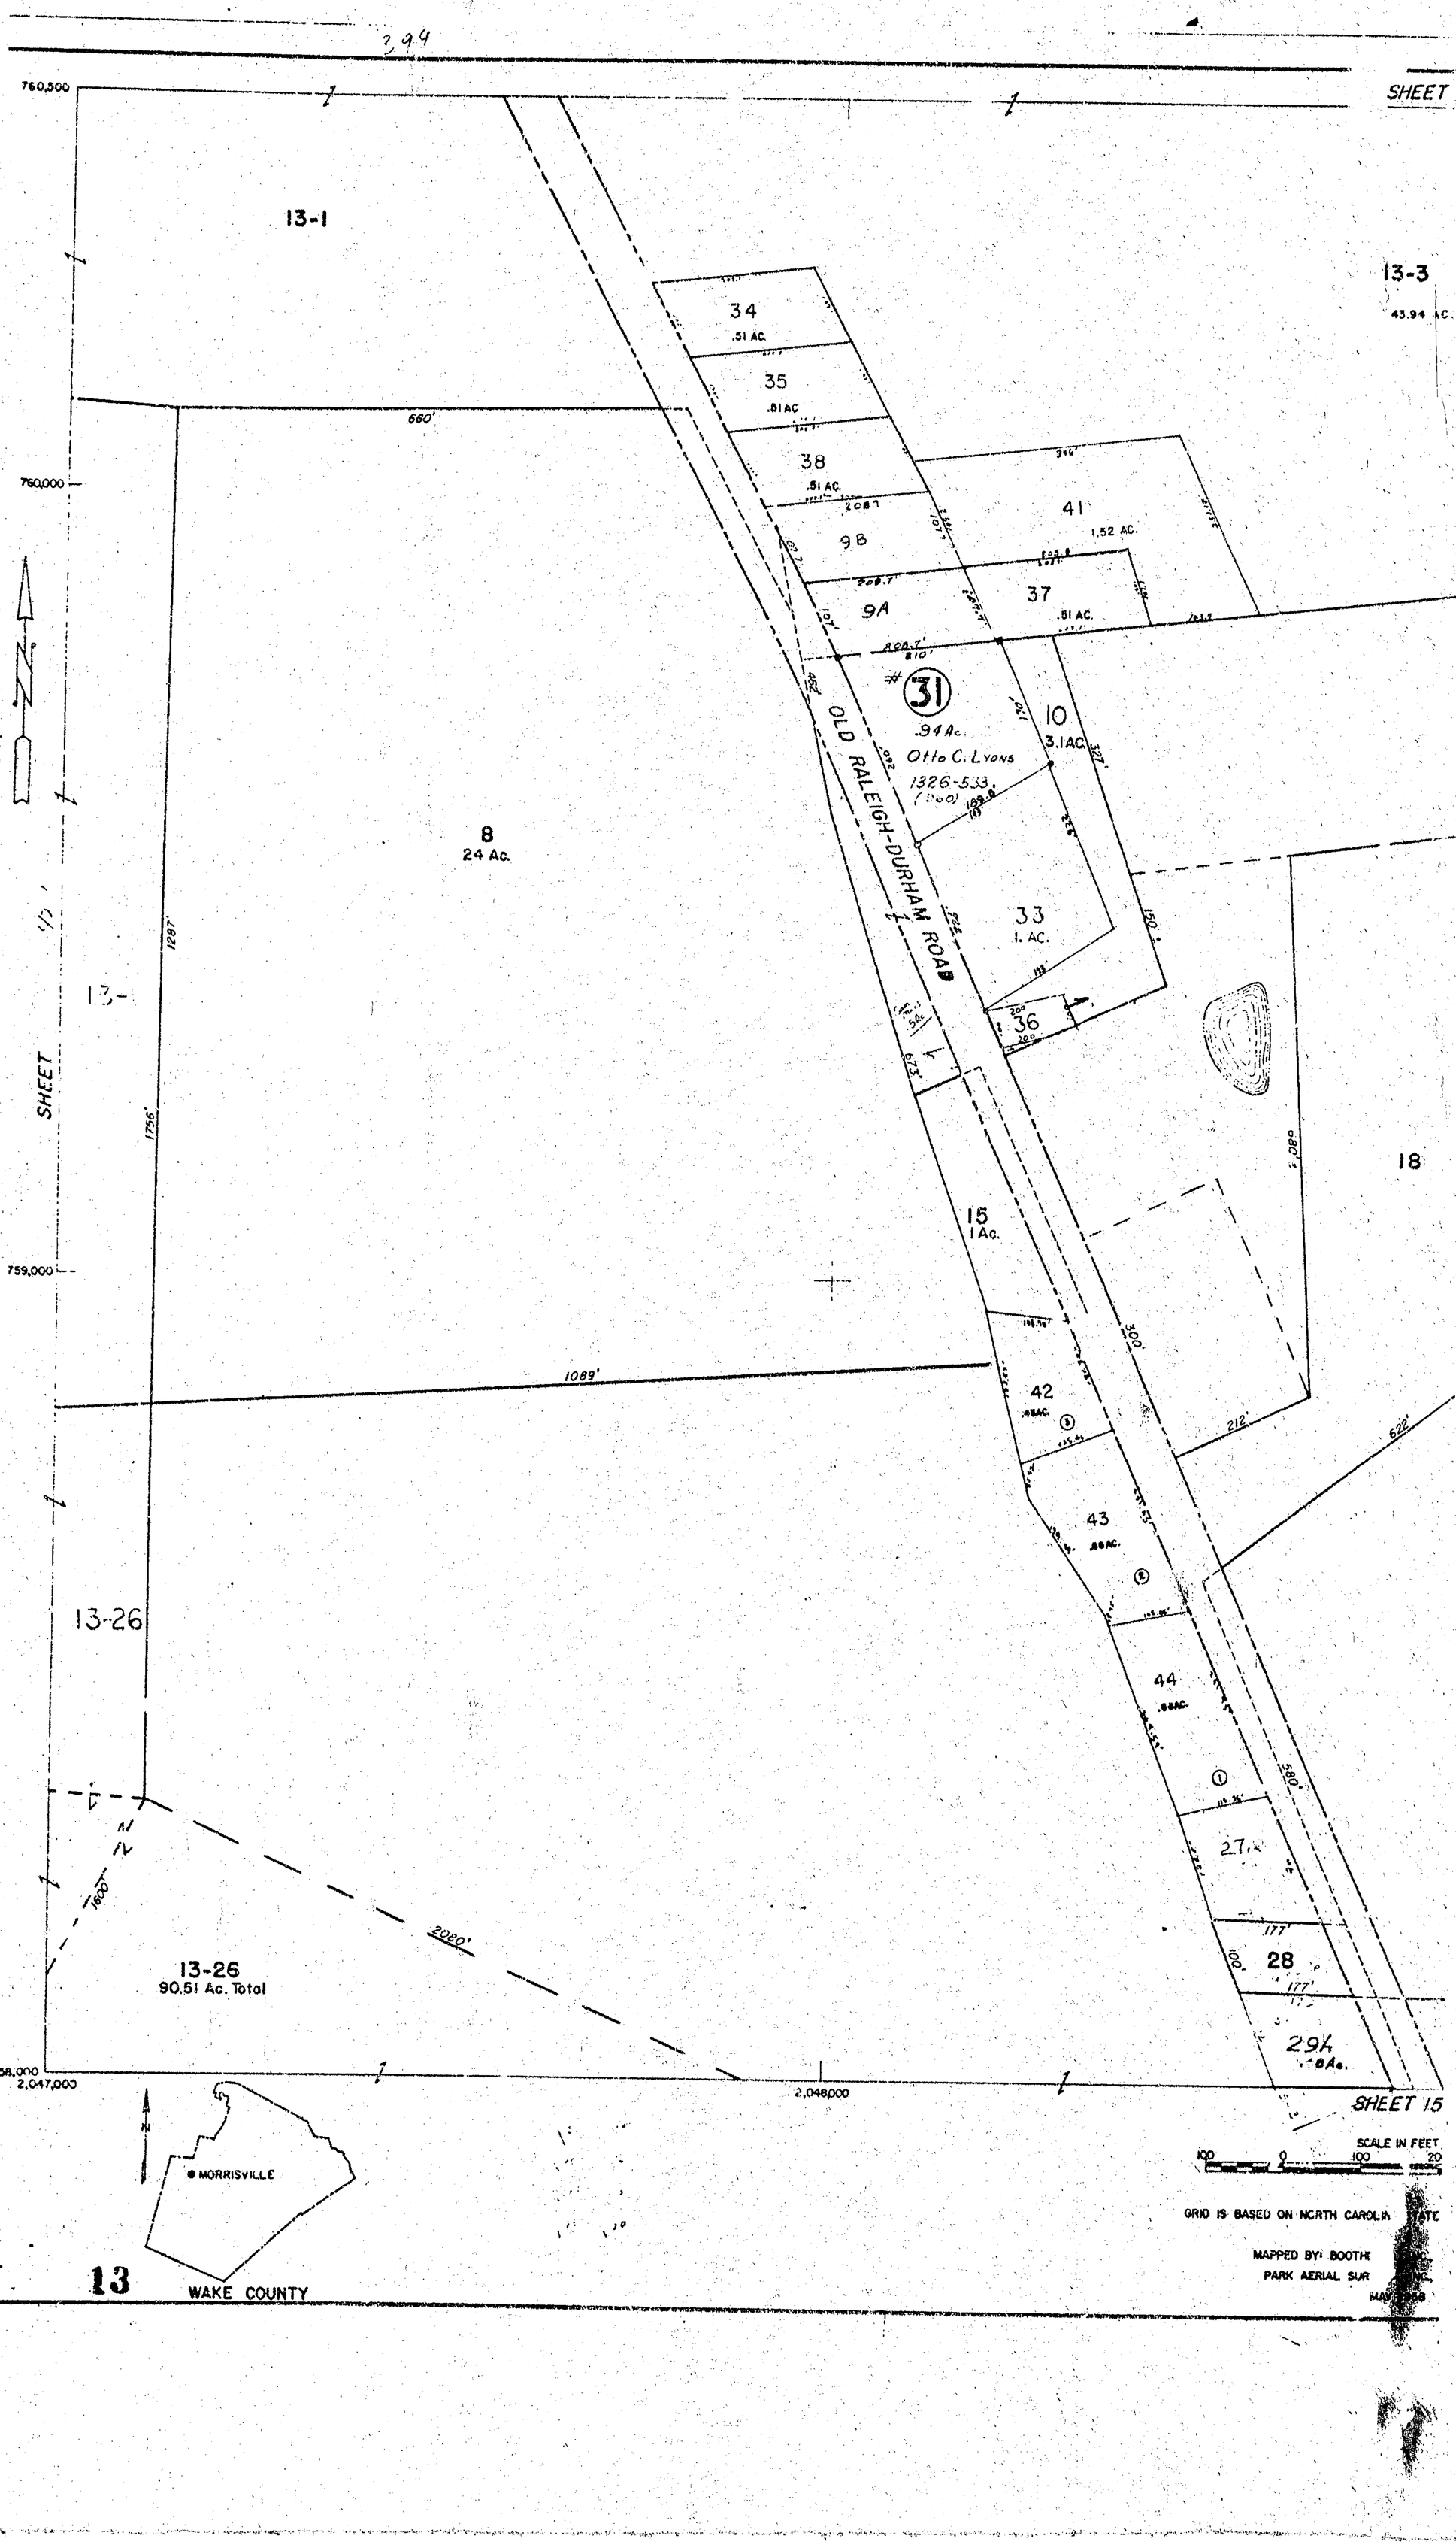
SHEET
760,500
13-1
660'
760,000
SHEET
1287'
1756'
759,000
1089'
13-26
1600'
2080'
13-26
90.51 Ac. Total
758,000
2,047,000
2,048,000
34
.51 AC.
35
.51 AC.
38
.51 AC.
208.7'
98
41
1.52 AC.
9A
37
.51 AC.
#31
.94Ac.
Otto C. Lyons
1326-533
(1900)
10
3.1AC
OLD RALEIGH-DURHAM ROAD
33
1. AC.
36
8
24 Ac.
15
1Ac.
42
.93AC.
43
.88AC.
44
.93AC.
13-3
43.94 AC.
18
212'
622'
300'
580'
27
177'
28
177'
29A
1.0Ac.
SHEET 15
SCALE IN FEET
100 0 100 200
GRID IS BASED ON NORTH CAROLINA STATE
MAPPED BY: BOOTH
PARK AERIAL SUR
MAY 1968
MORRISVILLE
13
WAKE COUNTY

SHEET

13-3

43.94 AC.

13-4

907.5'

32

5 Total

13-6
2.78 Ac. Total

13-13
3± Ac. Total

534'

13-14
4.24 Ac. Total

1430'

372'

11

14.45 AC.

1123'

625'

392'

18

622'

19
31.4 Ac.

SOUTHERN RY.

U.S. HIGHWAY 70-A

UNKNOWN

12

501.3'

2.89 Ac.
F.E. Godbold Jr.

13-20

237.6'

203.2'

78.5'

1.09 Ac.

0.40 Ac.

238.3'

202.8'

101.4'

30

21

.67 AC.

504.2'

39

3.2 AC.

1939'

709'

985'

40

6.75 AC.

314'

760'

319'

14-13

369'

424'

13-25
11.5 Ac. Total

1013'

1370'

13-29

SHEET 14

SHEET 15

2,049,000

2,050,000

2,050,500

SCALE IN FEET
100 200 300 400

CAROLINA STATE PLANE COORDINATE SYSTEM

DOTHE CO., INC., GREENSBORO, N.C.
SURVEYS, INC., LOUISVILLE, KY.
MAY 1958

MORRISVILLE, N.C.

SHEET 13

Case H .4

13

760,500

13-4

854'

90.5

1092'

356'

13-5

163'

865'

13-6

Road

760,000

13-13

534'

Road

13-14

446.1'

582'

Road

SHEET 13

354'

187'

552'

209'

13-21

759,000

106Ac.

13-40

468'

209'

5

209'

209'

528'

319'

HIGHWAY 70-A

8.1 Ac.
LOT 1

866'

319'

13

1.75 AC.

208.7

83'

7
LOT 2

129'

48'

208.7

556

8
2.83 AC.

710'

676.19'

393.1'

424'

210'

20
4.19 AC

13-25

598.97

161.8'

41.7'

190'

419.8'

15

16

14

16-2

15

S1

16-128

756,000
2,050,500

2,051,000

2,052,000

SHEET

SCALE IN F

100 0 100

GRID IS BASED ON NORTH CAROLINA S1

MAPPED BY: BOOTHE CO., II
PARK AERIAL SURVEYS, II
MAY 19!

N

MORRISVILLE

14 WAKE COUNTY

2060±

14-1
90.39 AC.
TOTAL AC. 99.56

1230'

320.7'±

2446'

2801.5'

14-6
48 Ac.
LOT 1

3445'

664'

16 (17) | 17 (18) | 18 (19) | 19 (20)

STELLA CT.

16-129

14-12

2,053,000

2,054,000

SHEET 16

SCALE IN FEET
100 200 300 400

AROLINA STATE PLANE COORDINATE SYSTEM

THE CO., INC., GREENSBORO, N.C.
SURVEYS, INC., LOUISVILLE, KY
MAY 1958

MORRISVILLE, N.C.

LAST No. 20

SHEET 14

14

758,000

SHEE

18

13-26

1
11.06 AC.

N

2215'

138'

131'

757,000

427-13

437'

427-20

Lot 12

427-9

Lot 12 A

669'

500'

2493'

SHEET

Lot 10

UTILITY LINE

4
18 Ac. Total
Lot 10A

232'

2220'

756,000

17-1

755,500

2,047,000

2,048,000

SHE

SCAL
100 0 100


GRID IS BASED ON NORTH CAROL

MAPPED BY: BOOTHE
PARK AERIAL SURVI
M

MORRISVILLE

15

WAKE COUNTY

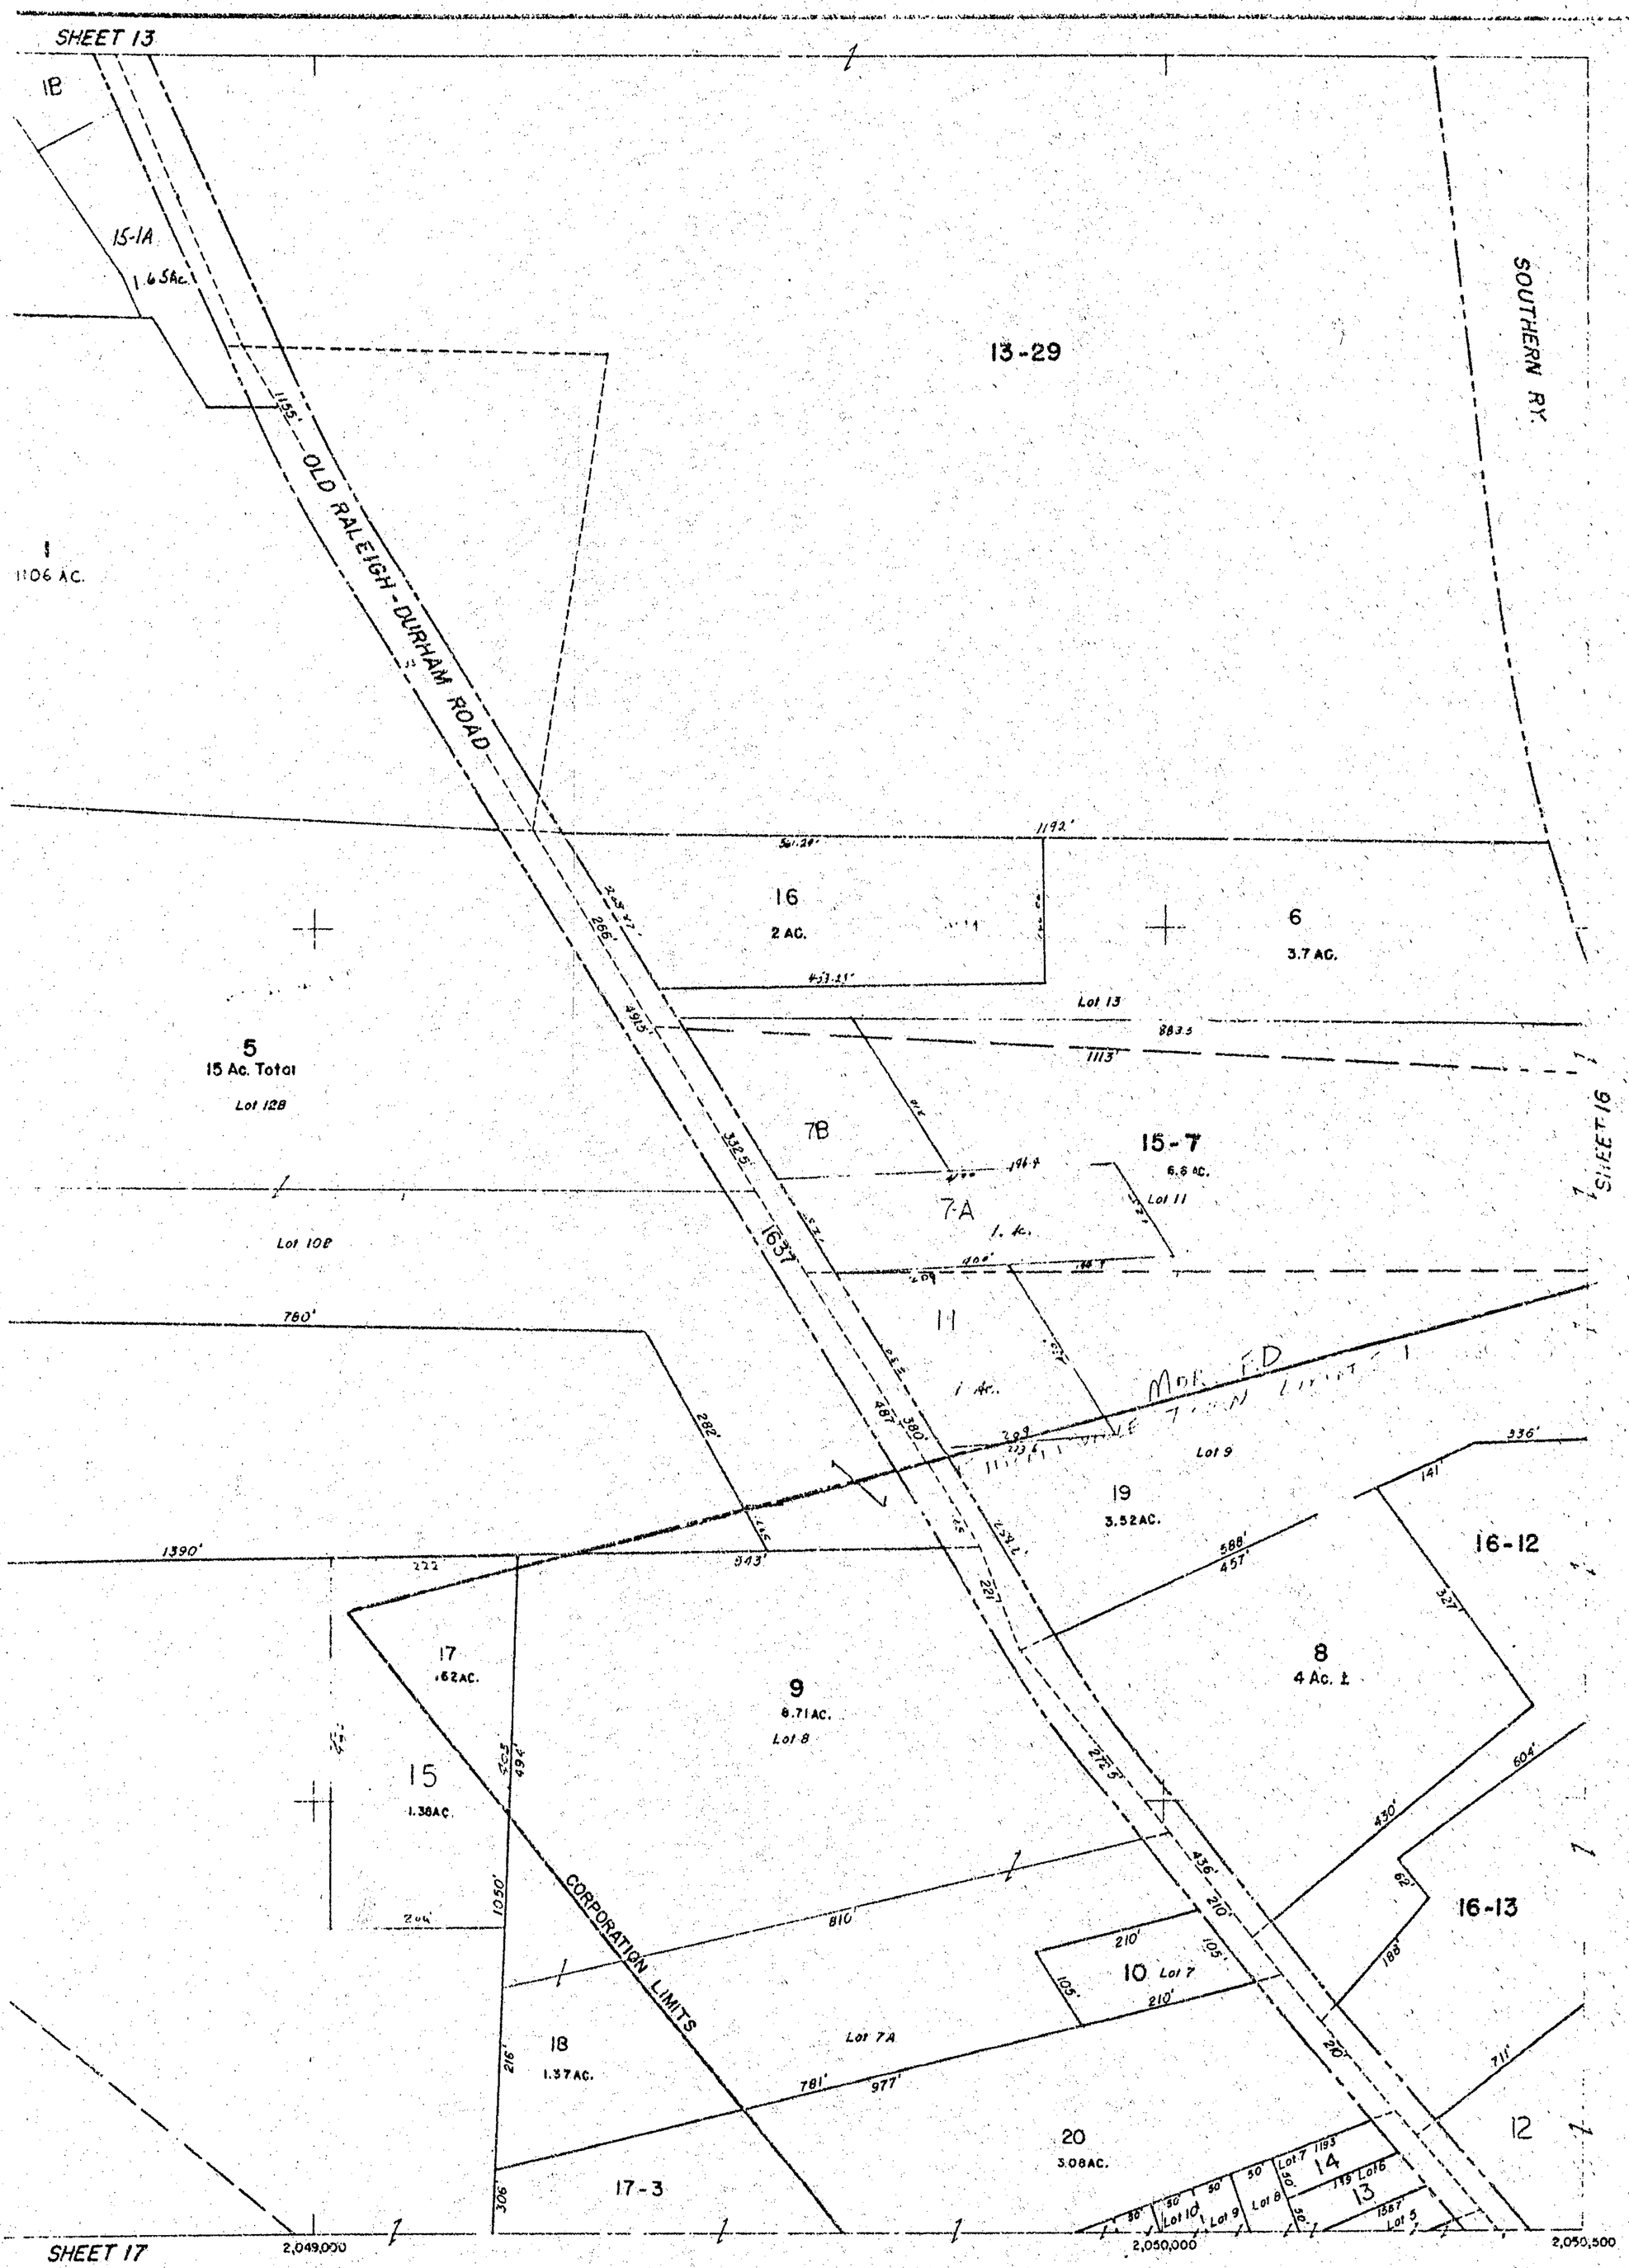

SCALE IN FEET
100 200 300 400

ORTH CAROLINA STATE PLANE COORDINATE SYSTEM

Y: BOOTHE CO., INC., GREENSBORO, N.C.
ERIAL SURVEYS, INC., LOUISVILLE, KY.
MAY 1958

MORRISVILLE, N.C.

LAST NO:

SHEET 15

15

SHEET 14

'58,000

2
11.32 AC.

95
3.31AC.

151
1AC.

87
3.61 AC.

3
5.76 AC.

4
2.13 AC.

5

113
.52 AC.

6

11
3.85 Ac.

U.S. HIGHWAY 70-A

GREEN DR.

115 116 117 118 119 120 121 122

128 127

150 96 .74AC. 153 .46AC. 149 1.17AC.

101 .94AC. 97 .83AC. 102 1.12AC.

98 .86AC. 110 1.15AC. 109 2.31AC.

99 .83AC.

FAIRVIEW

SUNSET AVENUE

100 .55 AC.

93 1.55 AC.

91 2.84 AC.

92 3.52 AC.

SORRELL GROVE ROAD

SOUTHERN RY.

T4

LOT 1 LOT 2 LOT 3 LOT 4 LOT 5 LOT 6 LOT 7 LOT 8 LOT 9 LOT 10 LOT 11 LOT 12 LOT 13 LOT 14 LOT 15 LOT 16 LOT 17 LOT 18 LOT 19 LOT 20 LOT 21 LOT 22 LOT 23 LOT 24 LOT 25 LOT 26 LOT 27

60 LOT 54 LOT 53 LOT 52 LOT 51 LOT 50 LOT 49 LOT 48 LOT 47 LOT 46 LOT 45 LOT 44 LOT 43 LOT 42 LOT 41 LOT 40

154

70

(84)

SHEET 15

15-7 LOT 11

15-19 LOT 9

16-12 3Ac. Total LOT 58

16-13 LOT 11

15-12

17-68

'56,000

75,000

2,050,500

2,051,000

2,152,000

SHEET

SCALE IN FE
100 0 100

GRID IS BASED O NORTH CAROLINA ST

MAPPED BY: BOOTHE CO., IN
PARK AERIAL SURVEYS, IN
MAY 195


W.J.
153

MORRISVILLE

16

WAKE COUNTY

SHEET 14

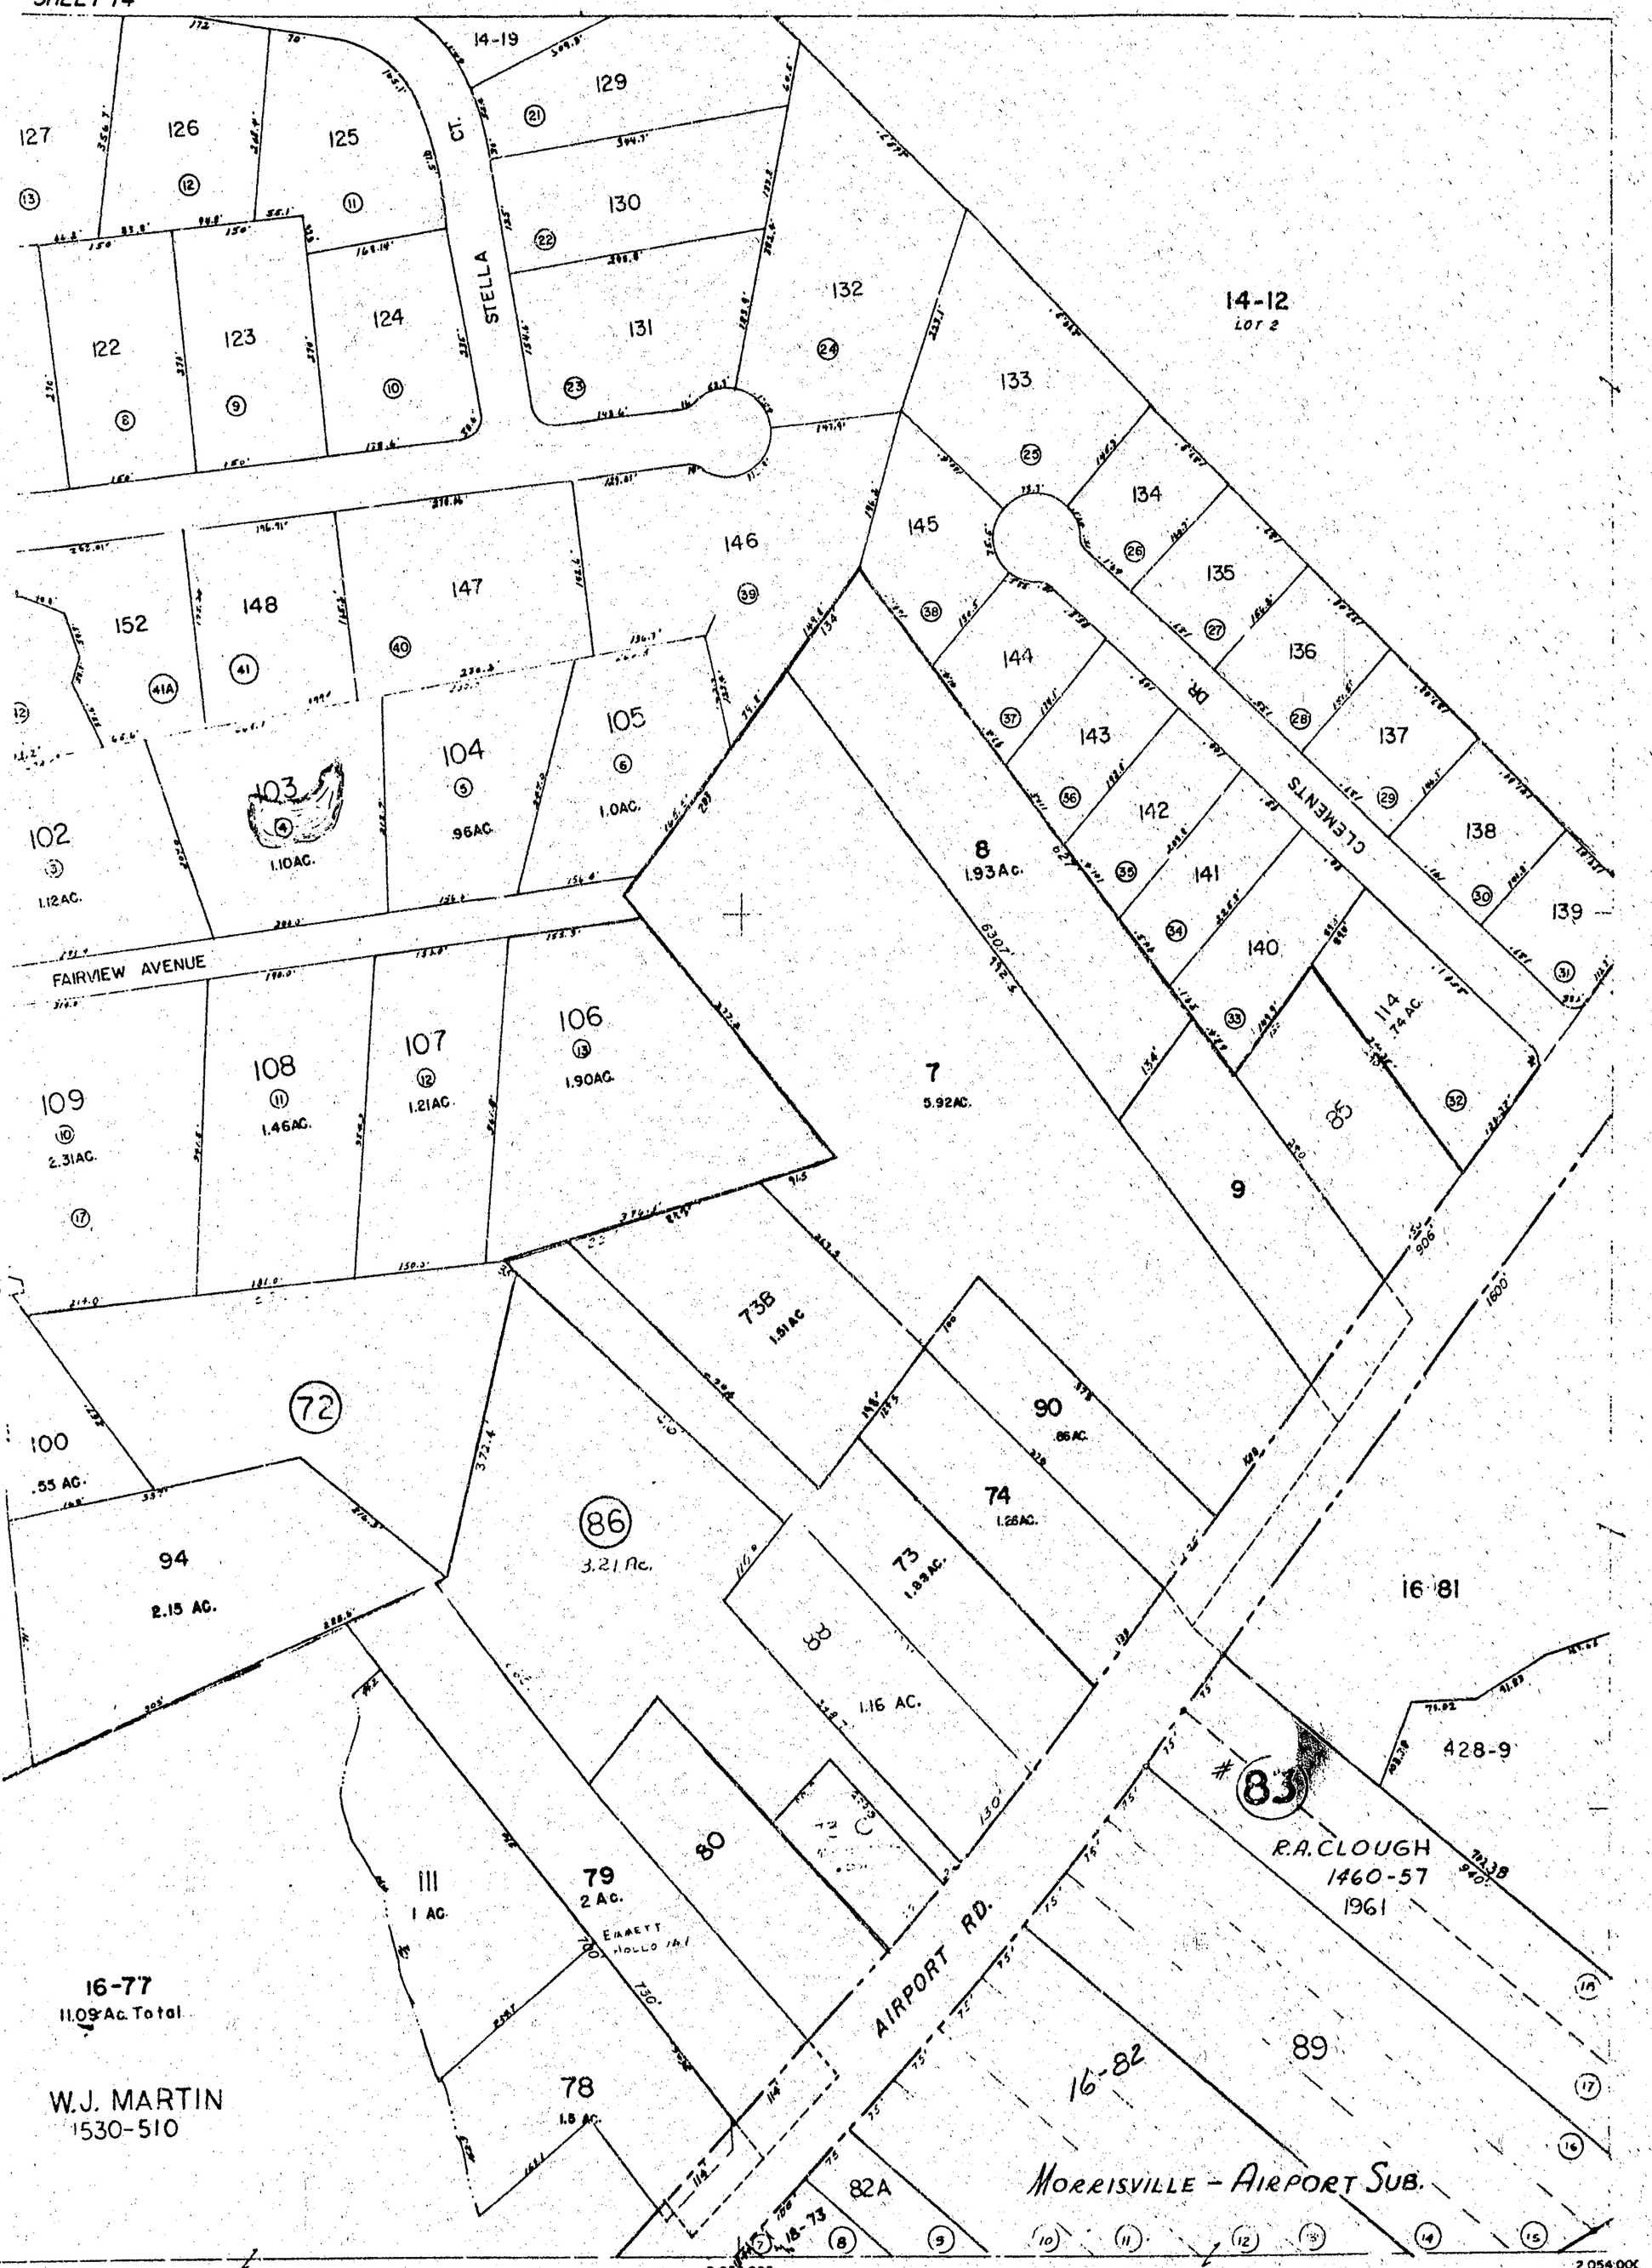

SHEET 18

SCALE IN FEET
100 200 300 400

TH CAROLINA STATE PLANE COORDINATE SYSTEM

BOOTHE CO., INC., GREENSBORO, N.C.
AL SURVEYS, INC., LOUISVILLE, KY.
MAY 1958

MORRISVILLE, N.C.

SHEET 16

LAST No. 1-4

16

SHEET 15

755,500

755,000

754,000

753,000
2,047,000

2,048,000

17-1
83.88 Ac. Total

2
20.92 Ac.

Road

1023'

990'

1301'

870'

128'

891'

860'

SHEET

456-22

456-23

1330'

1428'

19-1

Road

77
4 AC.

76
39.[illegible] AC.

SHEET 19

SCALE IN FEET
100 0 100 200

GRID IS BASED ON NORTH CAROLINA STATE P

MAPPED BY: BOOTHE CO., INC., C
PARK AERIAL SURVEYS, INC., L
MAY 1958


MORRISVILLE

2/1-34

17 WAKE COUNTY

SHEET 15

MORRISVILLE, N.C.

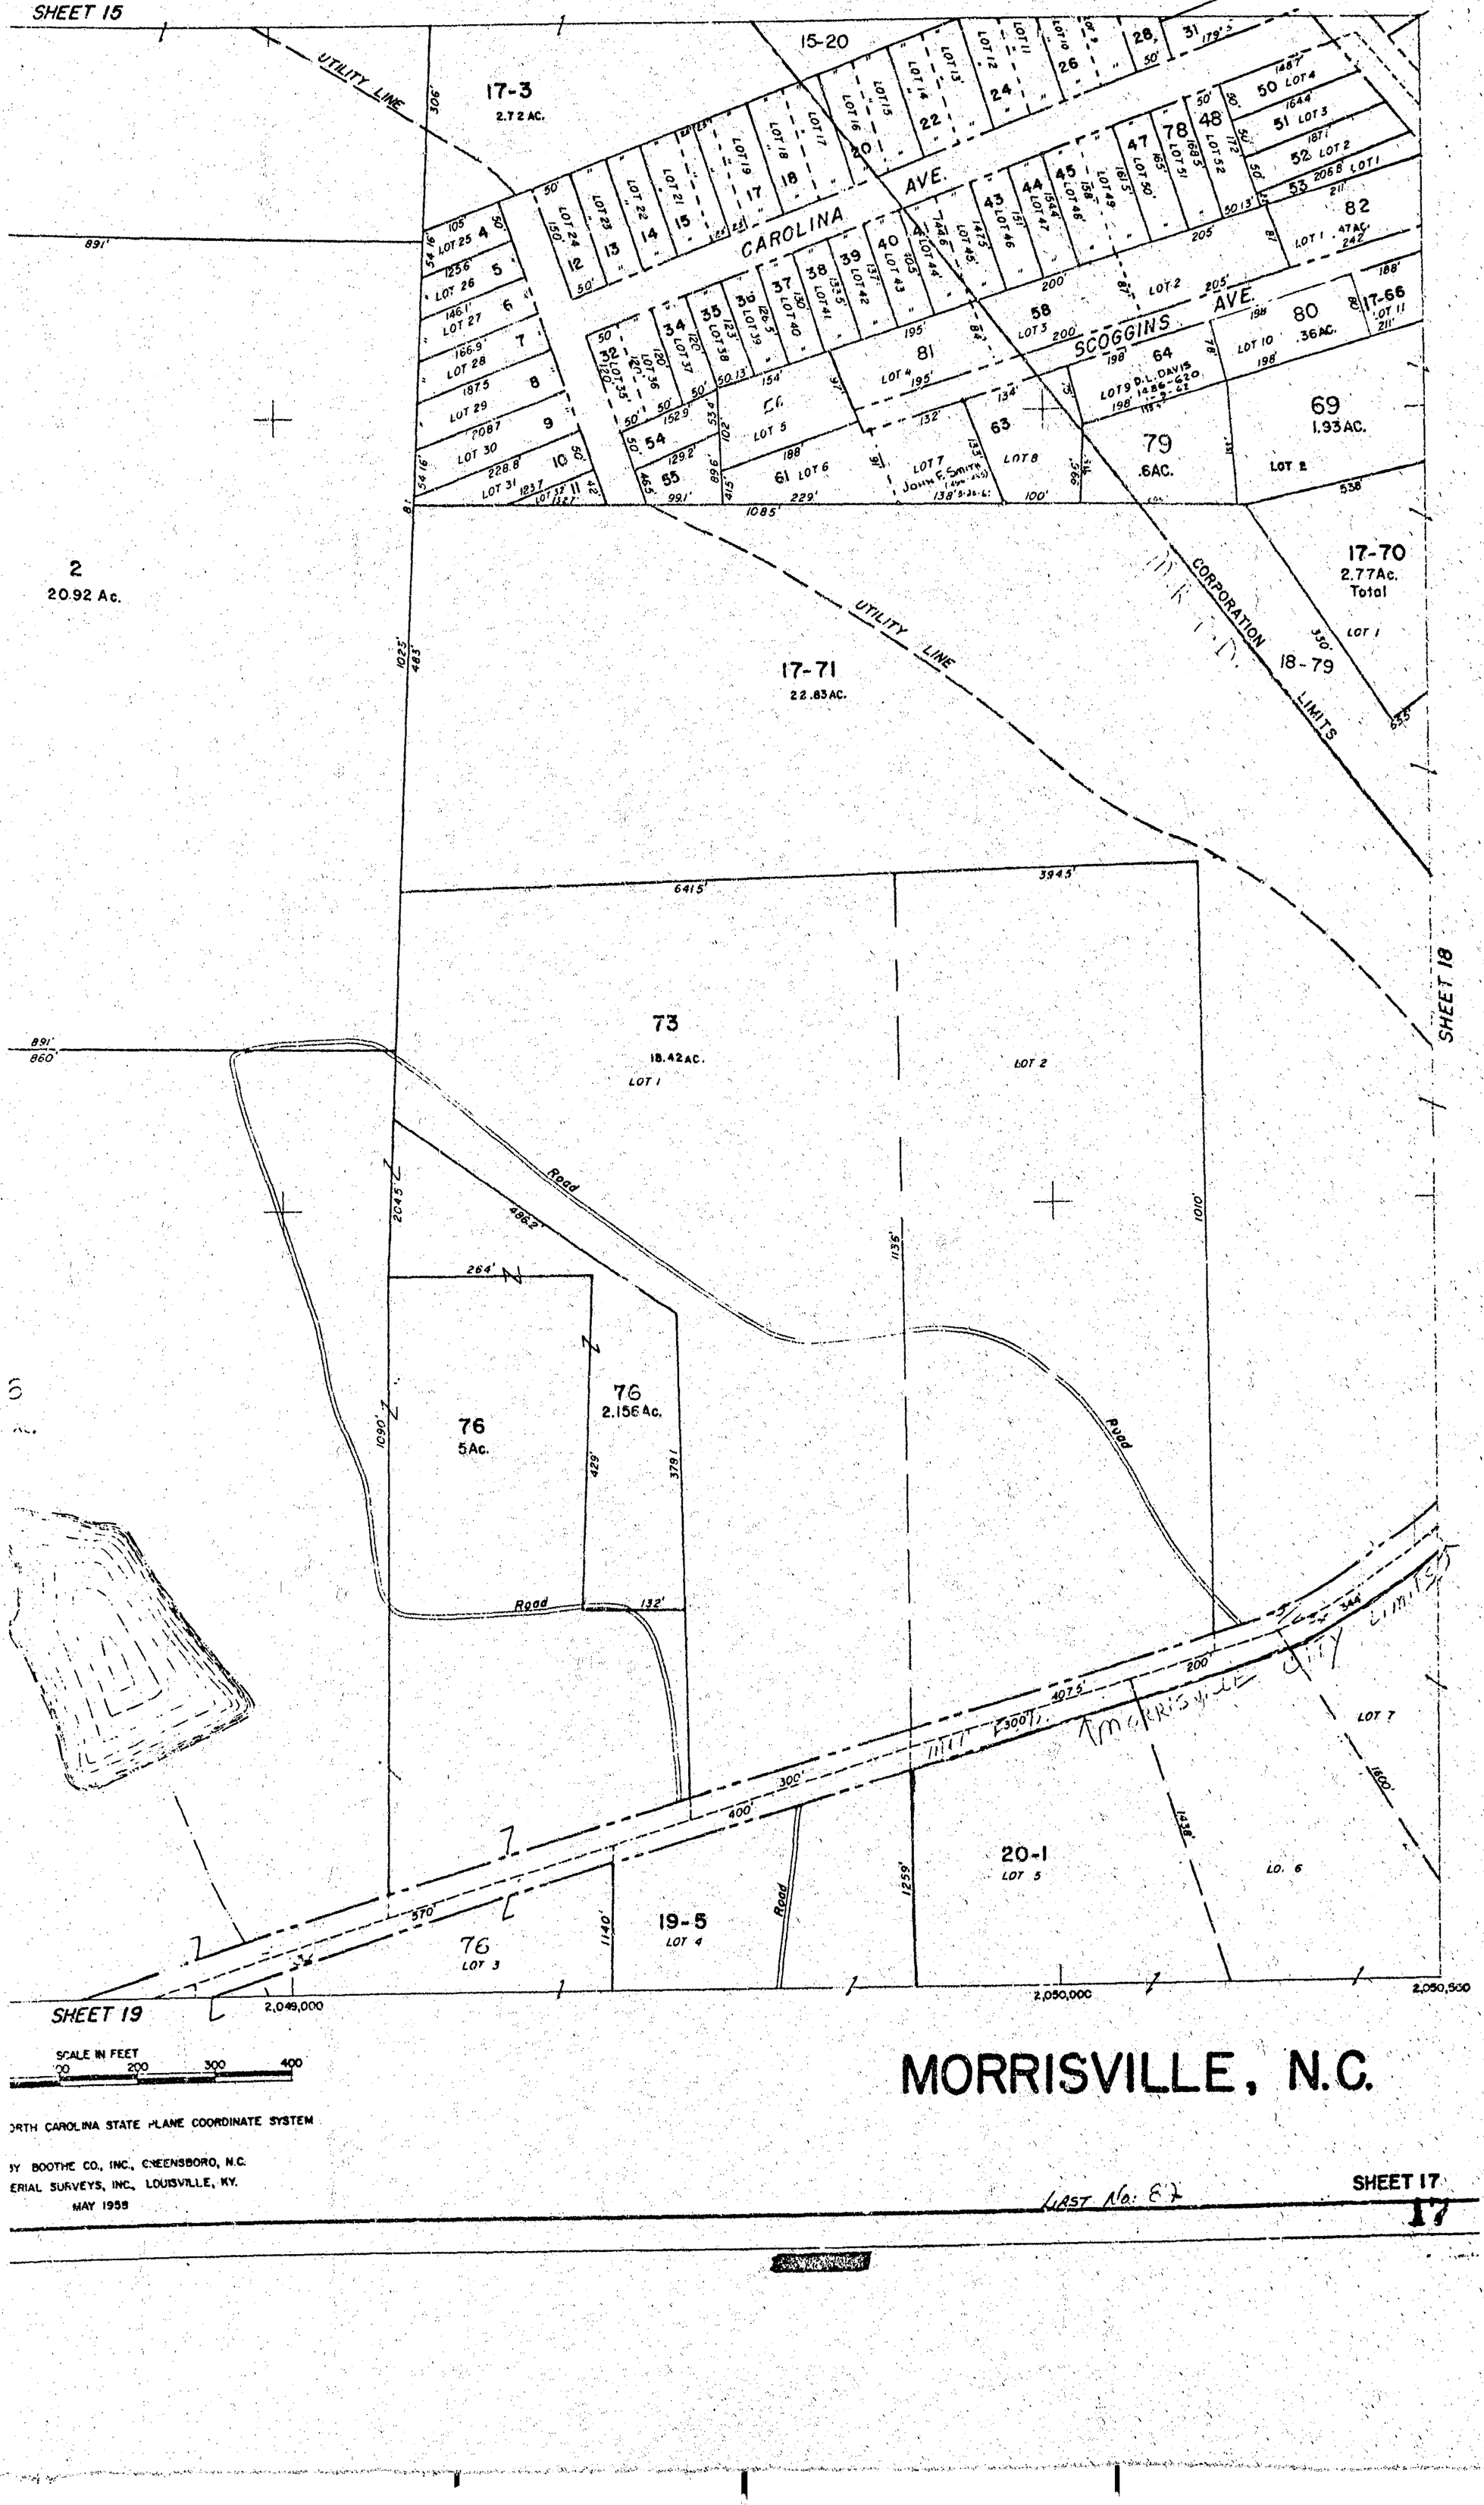


LAST No. 87


SHEET 17

Virgia Wilson (56)
1975-57

SHEET 16

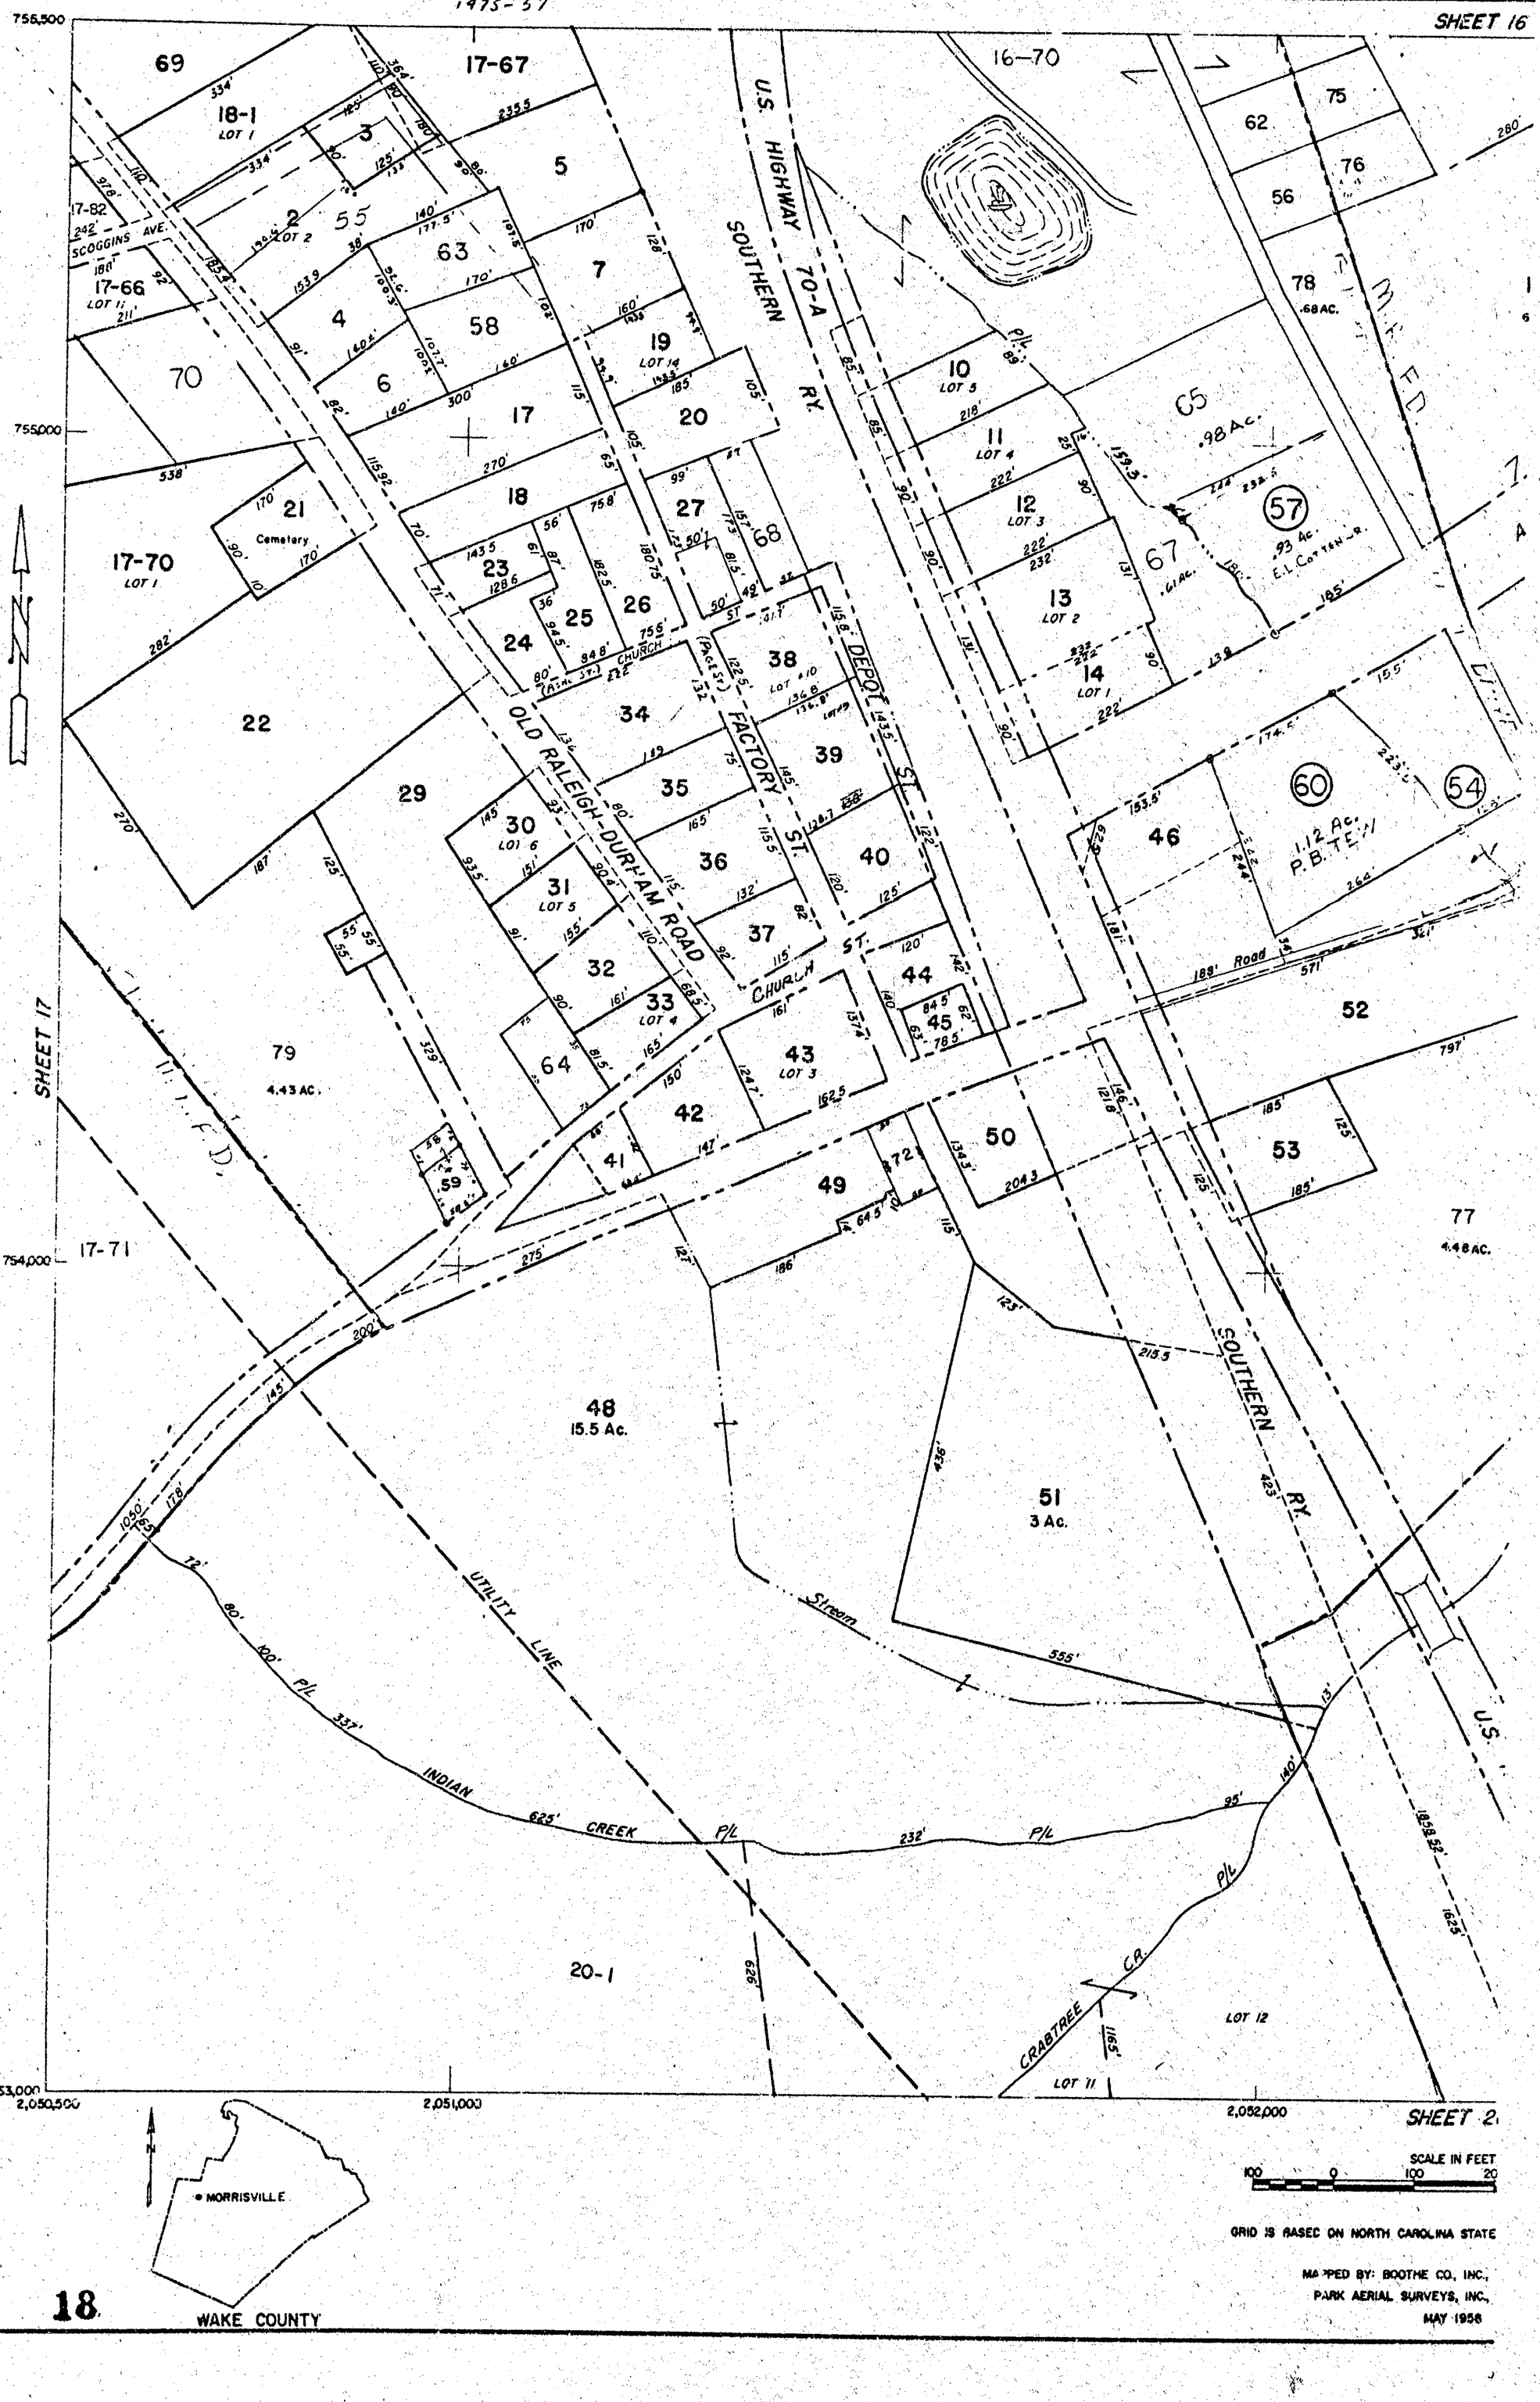

18 WAKE COUNTY

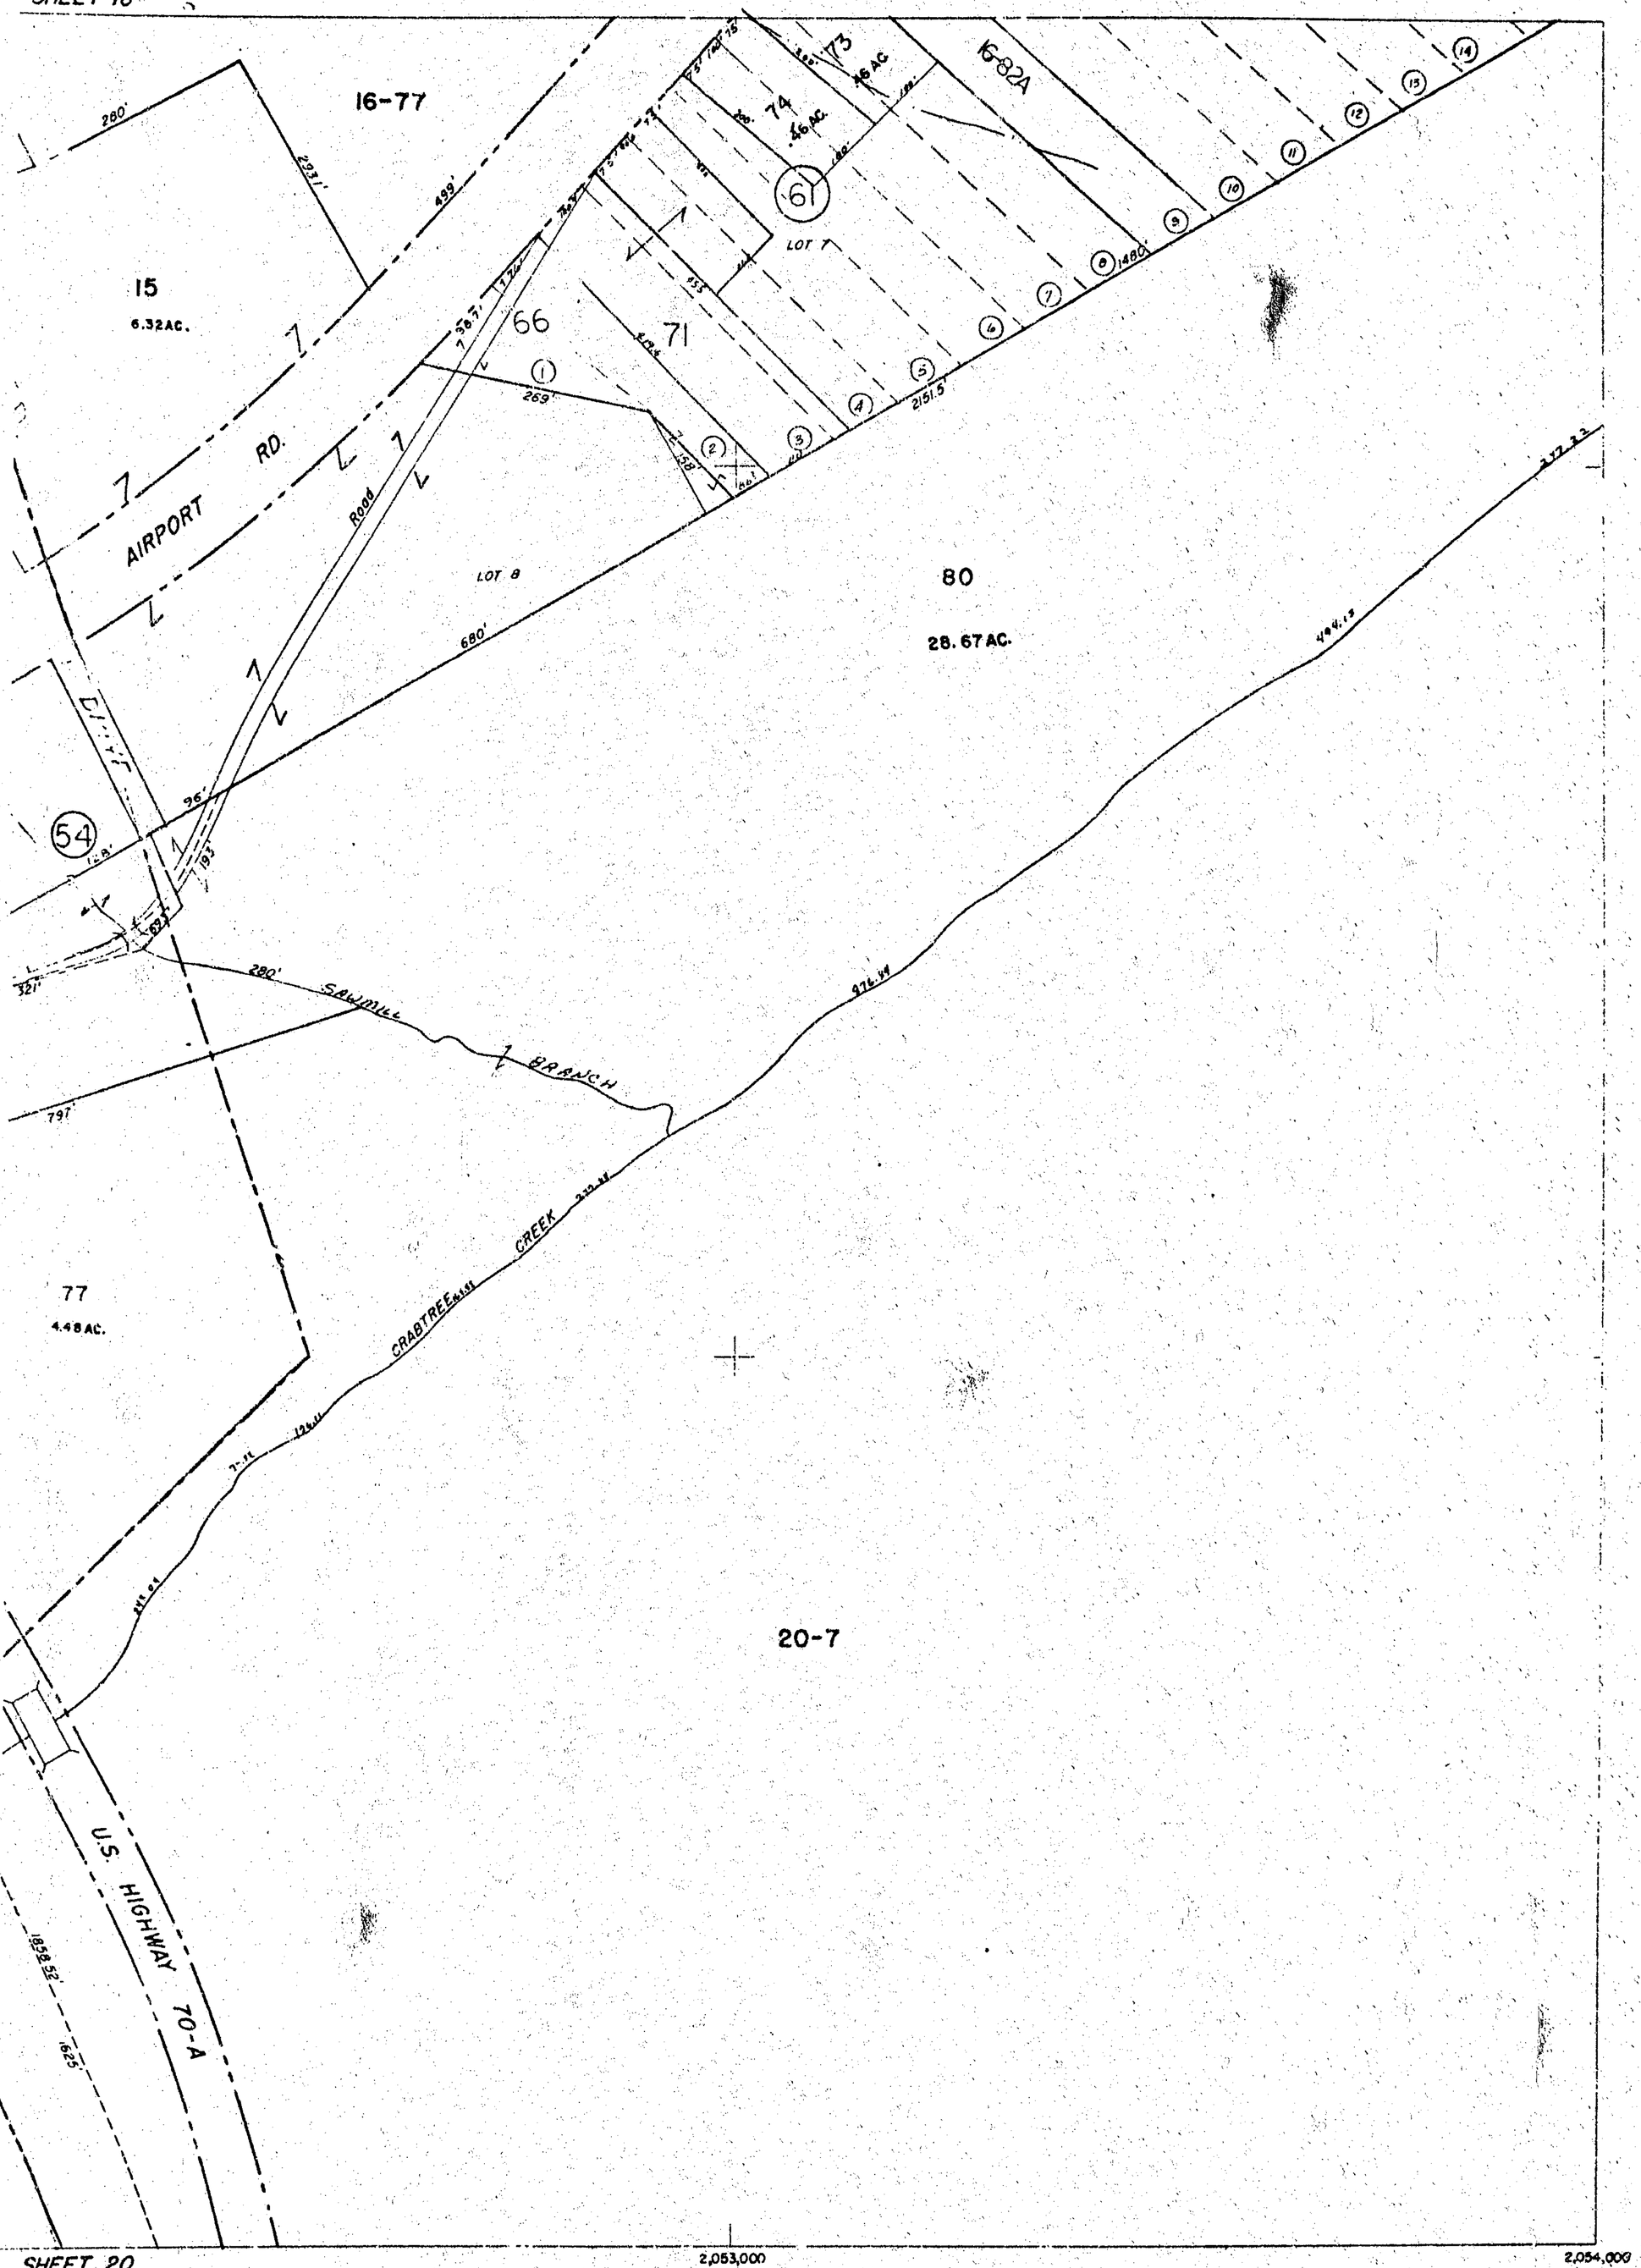

SCALE IN FEET
100 200 300 400

H CAROLINA STATE PLANE COORDINATE SYSTEM

BOOTHE CO., INC., GREENSBORO, N.C.
IL SURVEYS, INC., LOUISVILLE, KY.
MAY 1956

MORRISVILLE, N.C.

SHEET 17

753,000

456-23

1330'

19-1
29 Ac. Total

650'

1081.5'

2081.5'

1428'

17-77

17-76

886'

747.6'

128'

2

60.5 AC.

Check distance
T.K 1330 - 3544

3417'

525'

592'

500'

Road

1071'
By B.M. 1911 P.77

542'

752,000

SHEET 18

19-7
13.3 Ac. Total

1115'

8
12.7 Ac.

1144 By B.M. 1911 P.77

1115'

9
26.9 AC.

1115'

1138'

Lot 5.5

Lot 5

Lot 4.5

Lot 4

S/O S

545'

502'

525'

545'

186.4 By B.M. 1911 P.77

751,000

750,500
2,047,000

2,048,000

SHEET 20

SCALE IN FEET
100 0 100 200

GRID IS BASED ON NORTH CAROLINA STATE PLA

MAPPED BY: BOOTHE CO., INC., GREE
PARK AERIAL SURVEYS, INC., LOU
MAY 1958

MORRISVILLE

19

WAKE COUNTY

SHEET 17

Stream

13 Ac.

19-5
10.53 Ac. Total

20-1

Lot 3

Lot 4

Lot 5

9112'

936'

1140'

1259'

Limits

5455'

1140'

382.5'

738'

1590'

Road

11
31.5 Ac.

1138'

Limits of Morrisville City

Stream

20-8

1227'

SOUTHERN PINE
MANAGEMENT CO.

S/O S. T. HORNES PROP. BM-1911-P-77

LOT 3

LOT 2

1160'

2264'

1879'

SHEET 20

SHEET

2,049,000

2,050,000

2,050,500

SCALE IN FEET
100 200 300 400

NORTH CAROLINA STATE PLANE COORDINATE SYSTEM

BY: BOOTHE CO., INC., GREENSBORO, N.C.
AERIAL SURVEYS, INC., LOUISVILLE, KY.
MAY 1958

MORRISVILLE, N.C.

SHEET 19

LAST 19

SHEET 18

753,000

1600

625'

CREEK

CRABTREE

20 - 1

77.9 IAC.

511'

UTILITY LINE

512'

650'

MORRISVILLE CITY LIMITS 550'

752,000

Stream

SHEET 19

20-8

42.4 Ac. Total

LOT 2

20-9

LOT 1

CRABTREE CREEK

MORRISVILLE CITY LIMITS

MUR. FLY

SOUTHERN R.Y.

438

MORRISVILLE

751,000

750,500

2,050,500

2,051,000

2,052,000

SHEET

SCALE IN FEET

100 0 100 200

GRID IS BASED ON NORTH CAROLINA STATE PL

MAPPED BY: BOOTHE CO., INC., GRE
PARK AERIAL SURVEYS, INC., LOU
MAY 1958

MORRISVILLE

20 WAKE COUNTY

SHEET 18

20-7

151.85 AC.

1625'

LINE

968'

3242.58'

10

10.01 Ac.

LOT 1

650'

550'

991'

11

5.02 Ac.

LOT 5

5.02 Ac. Total

LOT 6

13

5.99 Ac.

LOT 1

248'

939'

276'

SHEET

272'

5.31 Ac.

LOT 2

752'

2427'

120'

200'

U. S. HIGHWAY 70-A

5.37 Ac. Total

LOT 3

2281'

TRANSMISSION LINE

232'

7.56 Ac. Total

LOT 4

2107'

225'

115'

6.94 Ac. Total

LOT 5

1948'

221'

6.19 Ac. Total

LOT 6

1784'

165'

3.92 Ac. Total

LOT 7

1600'

271'

9.91 Ac. Total

LOT 8

213'

1.4 Ac. Total

LOT 9

42'

23

19 AC.

1220'

N R.Y.

1430'

Road

438'

355'

2,053,000

2,054,000

SHEET

SCALE IN FEET

0 200 300 400

TH CAROLINA STATE PLANE COORDINATE SYSTEM

: BOOTHE CO., INC., GREENSBORO, N.C.

IAL SURVEYS, INC., LOUISVILLE, KY.

MAY 1956

MORRISVILLE, N.C.

LAST No: 23

SHEET 20

20

746,500

LOT 3

21-1
8.39 Ac Total
LOT 1

Trail

1365'

372'

2
6.86 AC.
LOT 7

1081'

323'

LOT 2

746,000

1049'

1375'

275.2'

38

LOT 4
2.55 Ac.

21-8
2 Ac Total
LOT 2

364.4'

U S HIGHWAY 1 (54)

60
2.48 AC.

61
1.80 AC.

59
1.46 AC.

58
21.25 AC.

MARVIN AVENUE

50 (6)
49 (5)
48 (4)
A
47 (3)
46 (2)
39 (1)
51
52
53
54
43
44

CHESTERFIELD

20
21
22

21-17

9
1.34 AC.

745,000

13
6.84 Ac
LOT 4

14
5.26 Ac
LOT 3

15
4.3 Ac
LOT E

16
3.8 Ac
LOT 1

21-17
50 Ac Total

SOUTHERN RAILWAY

Dirt Road

21-18
9.79AC.

744,000
2,060,000

2,061,000

SHEET 24

SCALE IN FEET
100 0 100 200

GRID IS BASED ON NORTH CAROLINA STATE PL

MAPPED BY: BOOTHE CO., INC., GR
PARK AERIAL SURVEYS, INC., LO
MAY 1958

CARY

21 WAKE COUNTY

458

4
19.83 AC.
LOT 1

5
33 1/2 Ac. Total
LOT 3

22-1
LOT 2
See Sheet #468
For Complete Tract

10
7.75 AC.

11
8.6 AC.

42
18± AC.

12
9.57AC.
LOT 5

22-6
LOT 6

57
22.28 AC.

MARVIN AVENUE

SHEET 22

SHEET 24

SCALE IN FEET
0 200 300 400

CAROLINA STATE PLANE COORDINATE SYSTEM

...E CO., INC., GREENSBORO, N.C.
...VEYS, INC., LOUISVILLE, KY.
MAY 1968

CARY, N.C.

SHEET 21

61

21

SHEET

746,500

746,000

745,000

744,000

2,063,500

2,064,000

2,065,000

SHEET 211

SHEET 2

LAURIE LANE

NORTHWOODS DR.

ASHLEY DR.

HARRISON STREET

WINSLOW CT.

ROANOKE DR.

BELHAVEN RD

KINGSWOOD DRIVE

BRUNSWICK PLACE

NORTHAMPTON DRIVE

BOUNDARY ST.

1 40.93AC.

16

75 1.50 AC.

22-3 107.54 AC.

7 2.05 AC.

18 0.8 AC.

17 .6 AC.

151

164 .44AC.

150

163 .36AC.

146 1.49AC.

22-7

22-8 356 Ac

22-6 9.2AC. LOT 6

22-6A 2.21 Ac

21-57

9 4.5 AC.

108 .39 AC.

25-1 | 25-2 | 25-3 | 25-4 | 25-5 | 25-6 | 25-16 | 25-17 | 25-18 | 25-19 | 25-21 | 25-31 | 25-37 | 25-43 | 25-44 | 25-45 | 25-46 | 25-47

SCALE IN FEET

100 0 100

GRID IS BASED ON NORTH CAROLINA STATE

MAPPED BY: BOOTHE CO., INC.,
PARK AERIAL SURVEYS, INC.,
MAY 1958

CARY

22

WAKE COUNTY

EET

22-11
6 Ac. Total

1237.5'

V. Cary Town Limits

This Boundary Line Called To Follow Rock Creek

23-1
19 Ac.

144 (110)
143 (109)
142 (108)
(107)
(106)
(105)

22-4
7.7 Ac.

10
14.68 AC.

CARY CITY LIMITS

SHEET 23

22-12
35 1/2 Ac Total

Trail

KORNEGAY PLACE

42 (41) 43 (42) 44 (29) 45 (29) 46 (30) 47 (31) 48 (32) 49 (33) 50 (34) 51 (35) 52

907.5'

22-14

101 (26) 100 (27) 99 (28) 98 (29) 106 (25) 105 (24) 104 (23) 103 (31) 107 (32) 102 (30)

GREGORY DR.

BRANNIFF DR.

23-110

23-106

25-73

25-47 25-53 25-54 25-55 25-56 25-57 25-58 25-59 25-60 25-61 25-62 25-63 25-64 25-65 25-66 25-67 25-68

2,066,000

2,087,000

SHEET 25

ALE IN FEET
200 300 400

XLINA STATE PLANE COORDINATE SYSTEM

E CO., INC., GREENSBORO, N.C.
VEYS, INC., LOUISVILLE, KY.
MAY 1956

CARY, N.C.

SHEET 22

LAST NO. 22

746,500

745,000

744,000

2,067,000

2,068,000

23-1
20Ac. Total

23-2
89.14AC.

IC5
3.082 AC.

3
30Ac

Dirt Road

7

9

11

Dirt Road

12
3.46Ac.

14
2.8Ac

.48 AC.

16
18.40AC.

110

111

106

107

112

113

114

115

23-22
LOT 64

23-51A
2.15 AC.

23-51B

109
52AC.

23-52

98

LOT 71

23-67

LOT 84

SHEET 22

22-12

SHEET 2

SCALE IN FEET
100 0 100

CARY

GRID IS BASED ON NORTH CAROLINA STATE

MAPPED BY: BOOTHE CO., INC.,
PARK AERIAL SURVEYS, INC.,
MAY 1953

23

WAKE COUNTY

Dirt Road

841'

222'

REEDY CREEK RD.

222

Dirt Road

6
8.90 Ac.

Dirt Road

600'

10

99

102
2.5 AC.

13
5 AC.

65

4
8 Ac

15

100

17

18
1.09AC.

97

101

104
2.7 AC.

103
1.04 AC.

87A
2.7Ac.

87B
1 Ac.

87C

W. A. BLAKE

LOT 82

71

W. M. BLAKE

73

74

53
54
55
56
57
58
59
60
61
62
63
64
65
66
68

83

26-380

87
10.18AC.

STATE HWY. 54

2,069,000

2,070,000

2,070,500

SHEET 26

SCALE IN FEET
100 200 300 400

CAROLINA STATE PLANE COORDINATE SYSTEM

...OTHE CO., INC., GREENSBORO, N.C.
SURVEYS, INC., LOUISVILLE, KY.
MAY 1958

CARY, N.C.

SHEET 23

LAST NO. ... 23





































SHEET 2

744,000

21-17

21-18

Pond

Dirt Road

462'

1402.5'

1400.5'

517-72

517-71

743,000

742,000

HEMLOCK ST.

WHITE OAK DRIVE

WHITE OAK DRIVE

MORNINGSIDE DR.

MAPLE ST.

MAYFAIR ST.

MADISON AVE.

MADISON AVE.

KING ST.

CREST ROAD

MAGNOLIA DR.

SHEET 517

LOT 6

LOT 7

LOT 13

LOT 1

LOT 11

LOT 9

LOT 16

LOT 17

LOT 8

LOT 6

LOT 1

LOT 7

LOT 1

429 430 431 432 439 440

428 438 441

427 433 437 442

415 434 436 443 141 142

404 426 444 414 435 140 139 143

403 402 401 398 399 395 396 367 LOT 1 138 144 145 146 147 148 149 150 151 152

379 378 377 376 375 368 206 207 208 209 210 211 212

380 381 382 383 384 385 386 387 388 389 390 369 205 214 215 216 217 218 219 213

418 405 406 407 408 409 410 411 370 204 203 202 201 200 199 198

517-130 517-129 517-140 420 419 284 285 286 287 288 299 271 272 273 274 275 276 277 278 279 280 281

422 421 289 300 220 222 223 224 225 226 227 234

424 423 290 301 221 228 229 230 231 232 233 235

294 295 296 303 234

293 297 304

292 291 298

A B C D E

1

517

SHEET

24-305

2,061,000

SCALE IN 1

100 0 100


GRID IS BASED ON NORTH CAROLINA S

MAPPED BY

PARK AERIAL SURVEYS

CARY

24

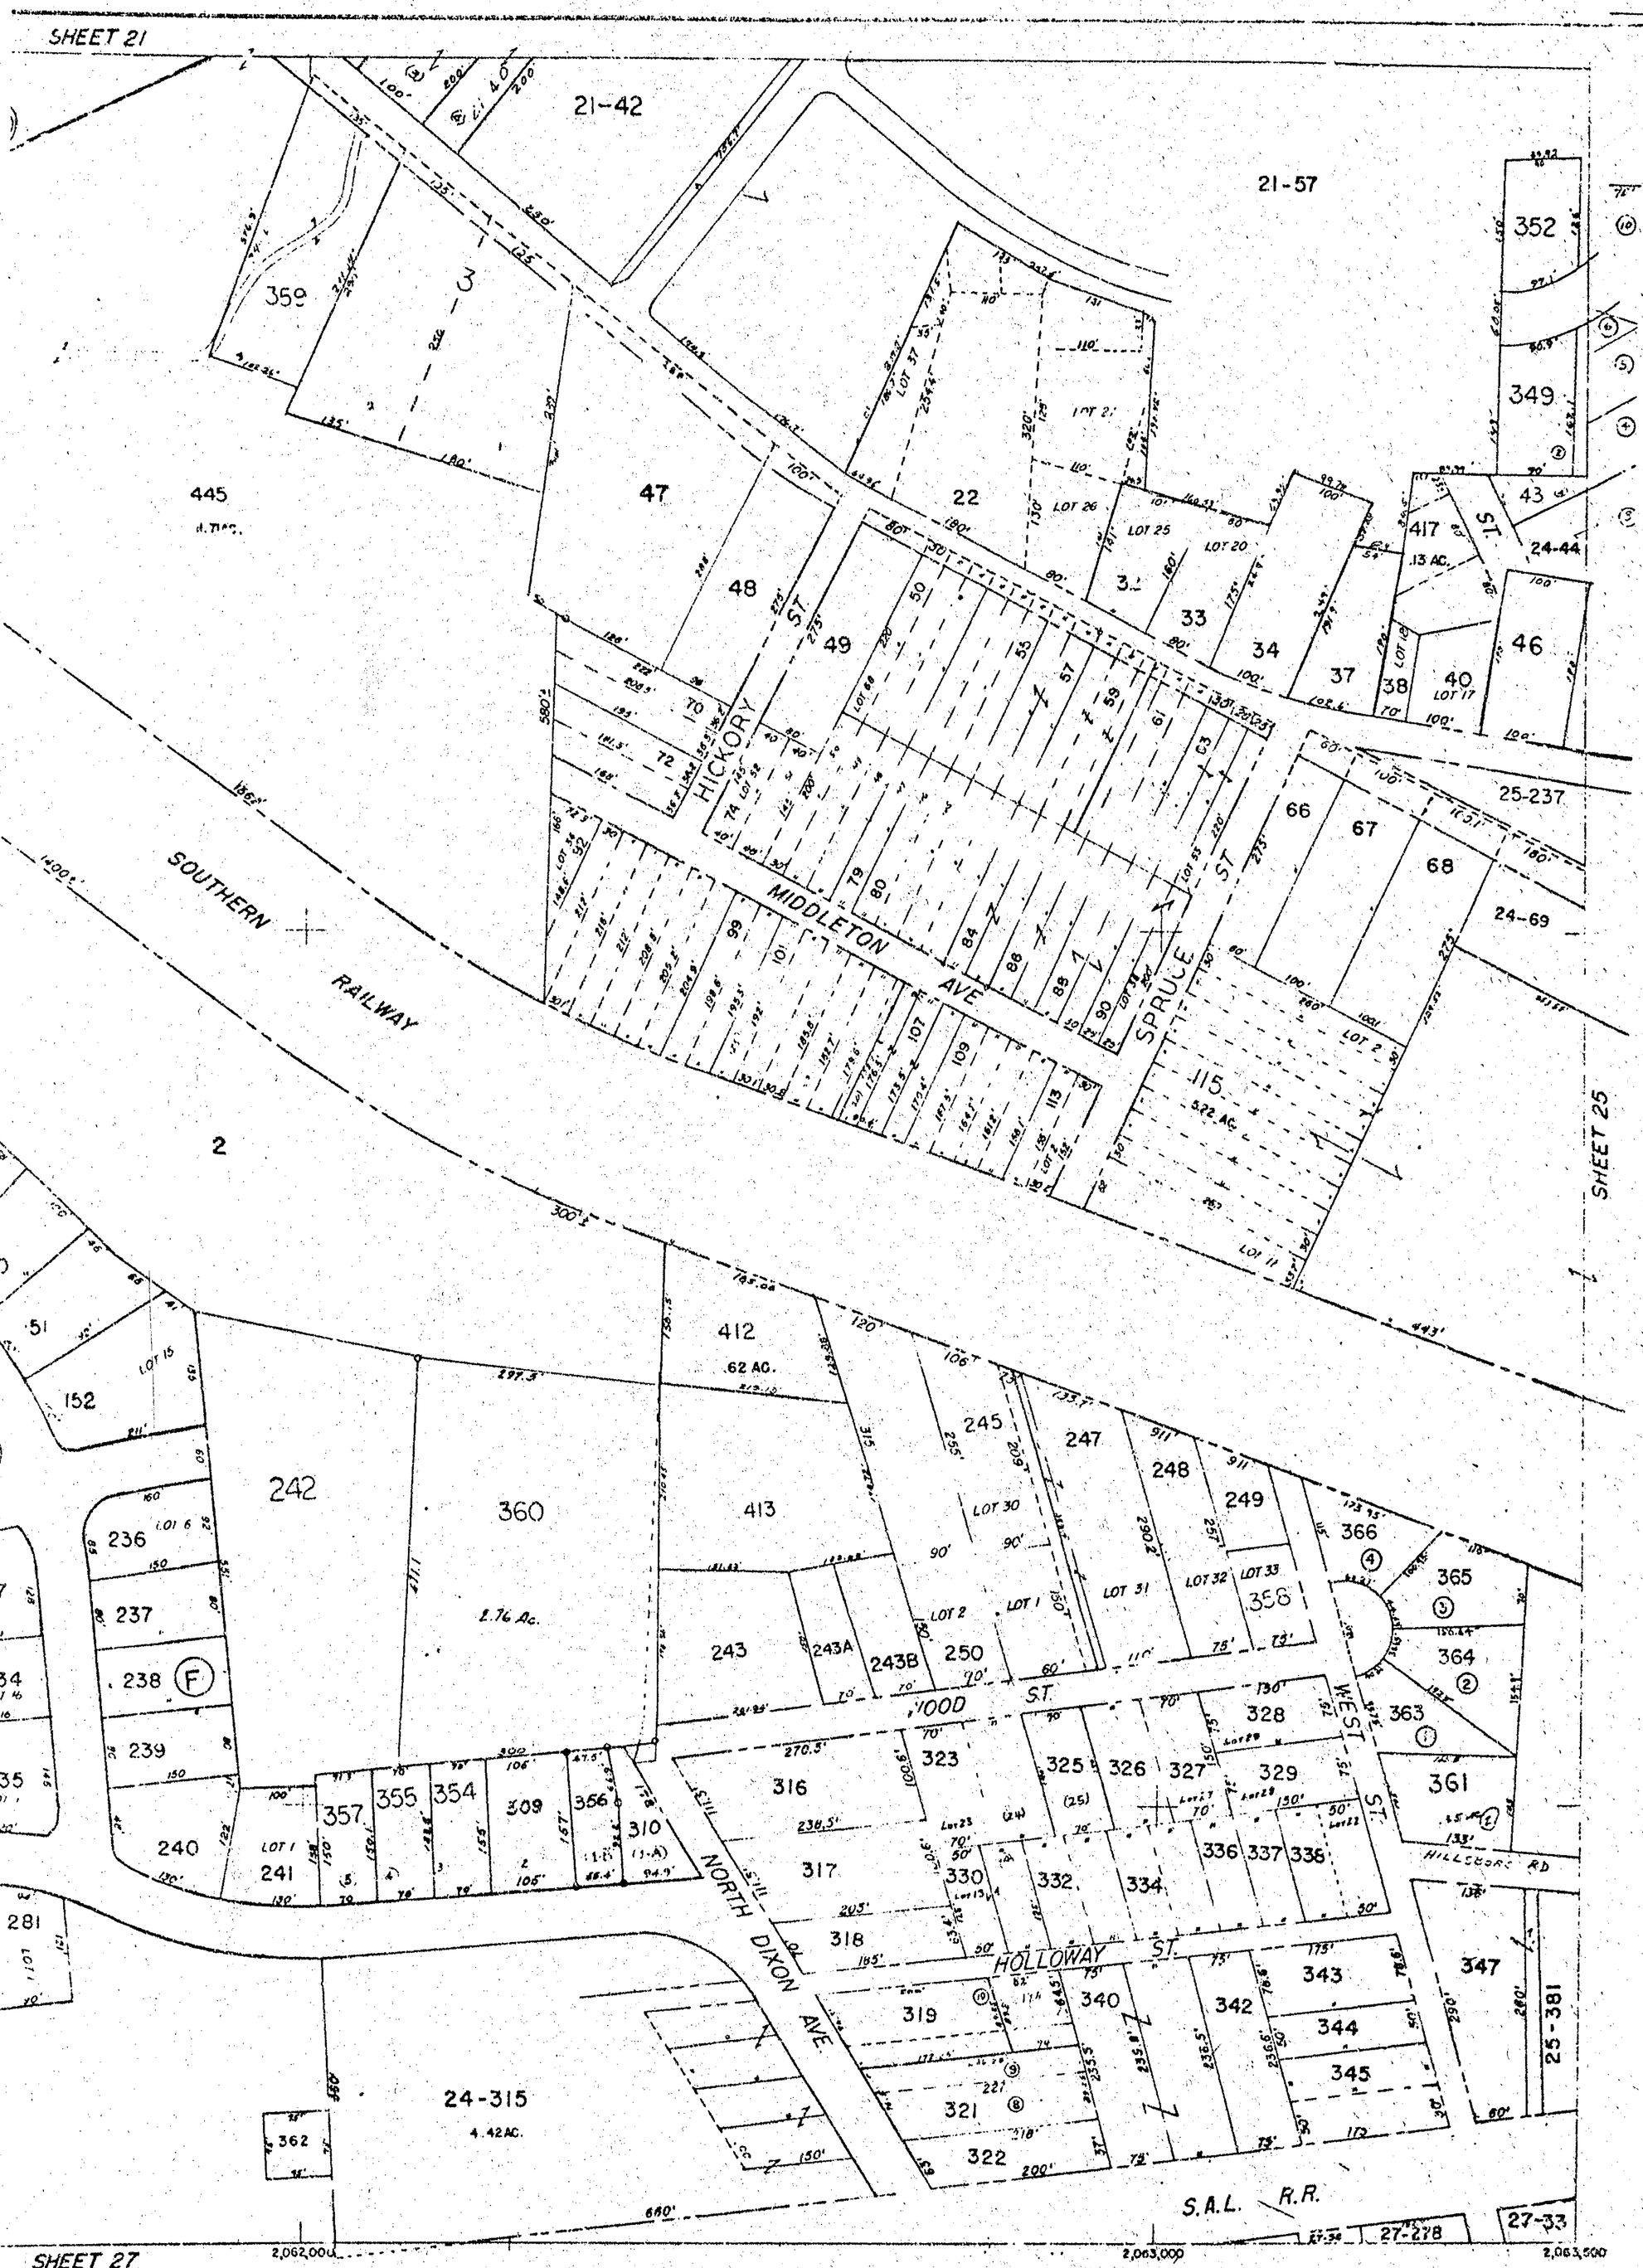
SHEET 21
21-42
21-57
359
445
47
48
49
22
LOT 26
LOT 25
LOT 20
LOT 21
33
34
37
38
40
LOT 17
LOT 19
46
417
.13 AC.
43
24-44
352
349
HICKORY ST.
MIDDLETON AVE.
SPRUCE ST.
SOUTHERN RAILWAY
25-237
24-69
66
67
68
115
5.22 AC.
LOT 2
SHEET 25
2
51
LOT 15
152
242
360
2.76 Ac.
412
.62 AC.
413
243
243A
243B
250
LOT 2
LOT 1
LOT 30
LOT 31
LOT 32
LOT 33
358
245
247
248
249
366
365
364
363
361
236
LOT 6
237
238
F
239
240
241
LOT 1
357
355
354
309
356
310
(1-A)
281
316
317
318
323
325
326
327
329
328
330
332
334
336
337
338
WOOD ST.
WEST ST.
NORTH DIXON AVE.
HILLSBORO RD
HOLLOWAY ST.
319
321
322
340
342
343
344
345
347
25-381
24-315
4.42 AC.
362
S.A.L. R.R.
27-278
27-33
SHEET 27
2,062,000
2,063,000
2,063,500
SCALE IN FEET
100 200 300 400
CARY, N.C.

JOHNSON STREET

GRAY STREET

U.S. 70-A & STATE HIGHWAY 54

ADAMS STREET

(PROPOSED STREET)

SOUTHERN RAILROAD

HILLSBORO STREET

SEABOARD AIRLINE RAILROAD

NORTH HARRISON AVENUE

JONES STREET

NORTH ACADEMY STREET

JONES ST.

30' STREET

SHEET 24

SHEET 2

297 1.64 AC.

391

491 1.49 AC.

744,000

743,000

742,000

741,500

2,063,500

2,064,500

2065,000

SHEET

SCALE IN FI

100 0 100

GRID IS BASED ON NORTH CAROLINA ST

MAPPED BY: BOOTHE CO., IN


PARK AERIAL SURVEYS, II

MAY 19E

CARY

25

WAKE COUNTY

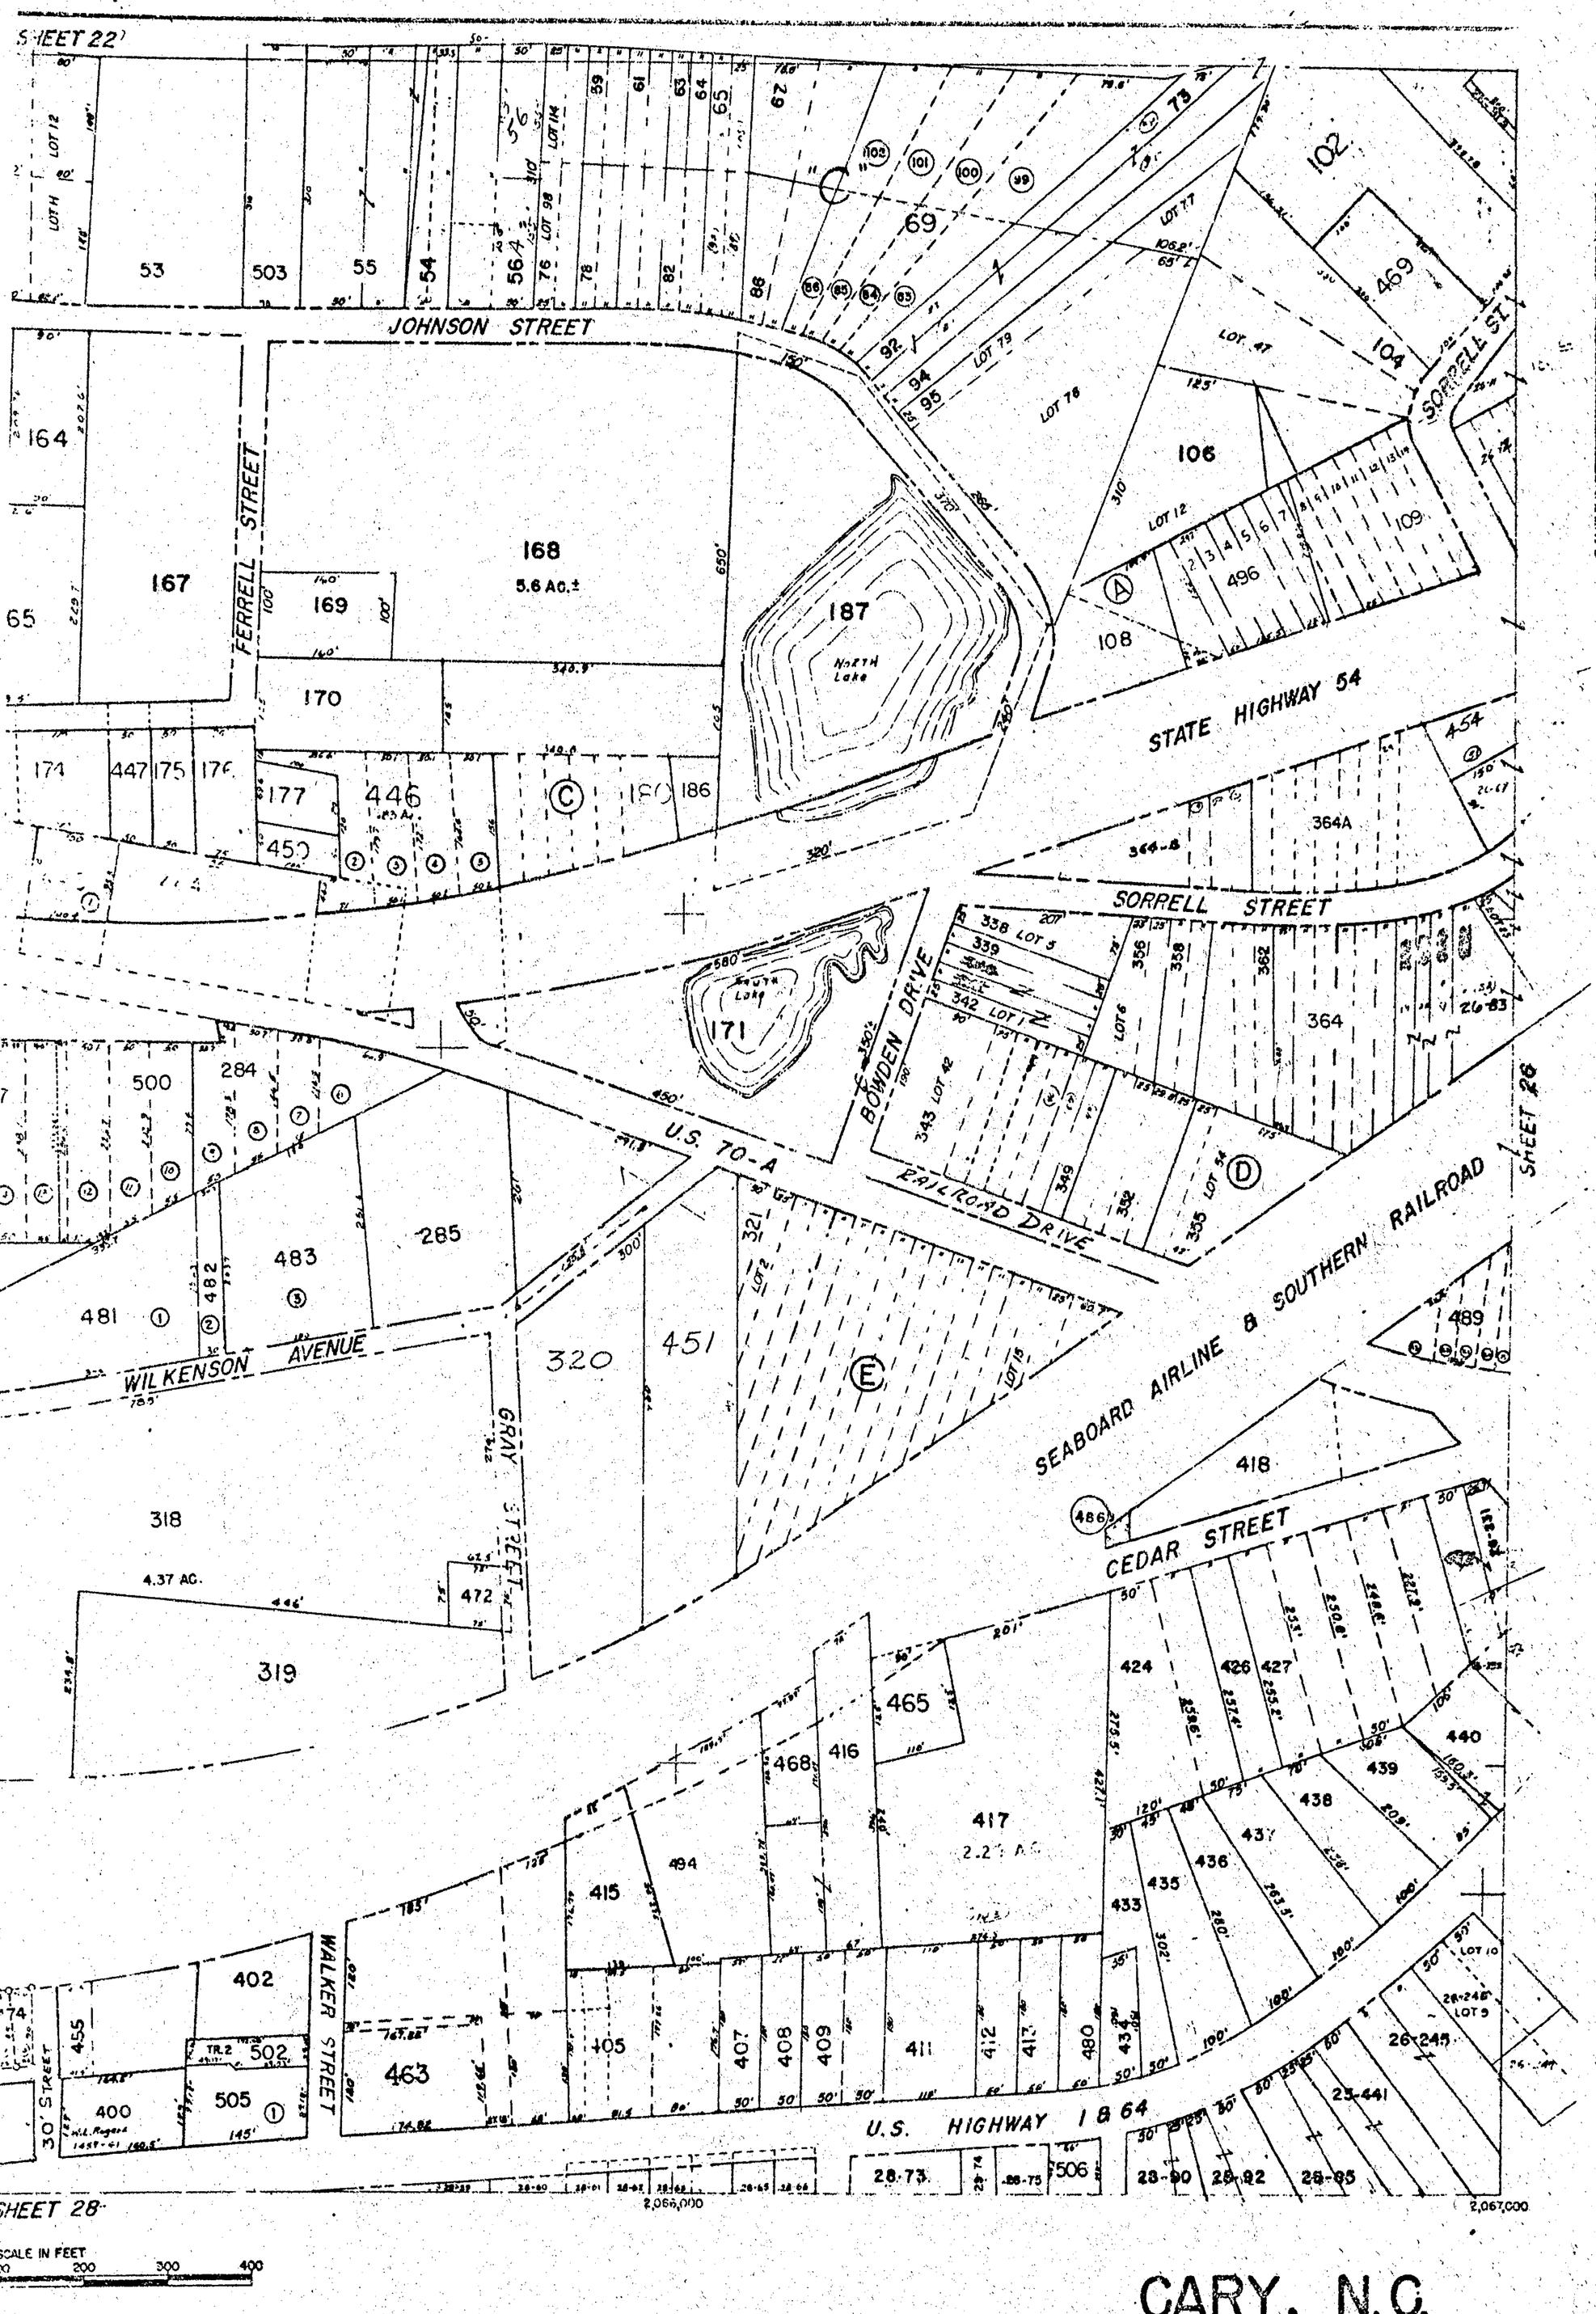

SCALE IN FEET
100 200 300 400

CAROLINA STATE PLANE COORDINATE SYSTEM

OTHE CO., INC., GREENSBORO, N.C.
SURVEYS, INC., LOUISVILLE, KY.
MAY 1958

CARY, N.C.

SHEET 25 **25**

SORRELL ST
STATE HIGHWAY 54
SEABOARD AIRLINE
REEDY CREEK RD
U.S. HIGHWAY 64
SORRELL ST.
EAST CIRCLE DRIVE
WEST CIRCLE DRIVE
URBAN DRIVE
WALDO ST
CLAY ST
RAINBOW COURT
WALDO STREET
CORPORATION LIMITS
CARY
744,000
743,000
742,000
741,500
2,067,000
2,068,000
180
3.97 AC.
179
4.60 AC.
383
.57AC.
336
1.38
317
1.53 AC.
348
.74AC.
29-82
29-88
SHEET 25
SHEET
SCALE IN F
100 0 100
GRID IS BASED ON NORTH CAROLINA S
MAPPED BY: BOOTHE CO., I
PARK AERIAL SURVEYS, I
MAY 19
26
WAKE COUNTY

SHEET 23

141

142

380
5.02AC.

Dirt Road

23-87

LOT 117

50'

AIRLINE & SOUTHERN RY.

215
(29)

221

230

212

208

64 & 70-A

319
4.42 AC.

324
2.59 AC.

384
1.4AC.

326
USA.

376
.98AC.

325
10.75AC.

377
.75 AC.

379
.23AC.

370
1.04 AC.

344
1.745 Ac.

318

328

372
.68 AC.

381
.74 AC.

Pond

TR. 1

LOT 1

LOT 2

LOT 3

Dirt Road

MAYNARD ROAD

340
46.67 AC.

375
32.3AC.

T. 3

T. 4

SHEET 518

SHEET 29

2,069,000

2,070,000

2,070,500

SCALE IN FEET
100 200 300 400

NORTH CAROLINA STATE PLANE COORDINATE SYSTEM

BY: BOOTHE CO., INC., GREENSBORO, N.C.
AERIAL SURVEYS, INC., LOUISVILLE, KY.
MAY 1958

CARY, N.C.

SHEET 26

LAST No. 26

SHEET 2

27-1-21 24-305

CREST ROAD

SEABOARD AIRLINE RR.

HIGH HOUSE ROAD

U.S. HIGHWAY 1

CHARLES CT.

PALMER PL.

RIDGE

Trail

Trail

Pond

Pond

Called 206'

SHEET 517

741,500

741,000

740,000

739,000

2,060,000

2,061,000

1853.5' (112 1/3 Poles)

984.5' (59 2/3 Poles)

344.5'

420'

280.5'

233'

360' DEED

517-68

304
24.34 AC.
TR.2

27-253
29.3 Ac. Total

27-145

27-144

27-143

30-259

307 298 299 300 301 302 12 11 10 9 8 (C)

11 13 (B) 14 15 16 17 18 19 20 (A) 21

22
1.22 AC.

303
.60 AC

306
.78 AC.

23

34
44 Ac

35

36

265
37

74

271

268

98
LOT 26

75

73
34 Ac.

LOT 7
76

118

119

LOT 27

LOT 6
130

309

132

283 284 285 286 287 288 289 290 276 172 297 295 296 294 291 292 293

315
1.46 AC.

316
2.2 AC.

180
5.47 AC.

153

152

164
4.13 Ac.

Pond

SCALE IN FE
100 0 100


GRID IS BASED ON NORTH CAROLINA STA

MAPPED BY: BOOTHE CO., INC
PARK AERIAL SURVEYS, INC
MAY 19[illegible]

27 WAKE COUNTY

CARY

SHEET 24

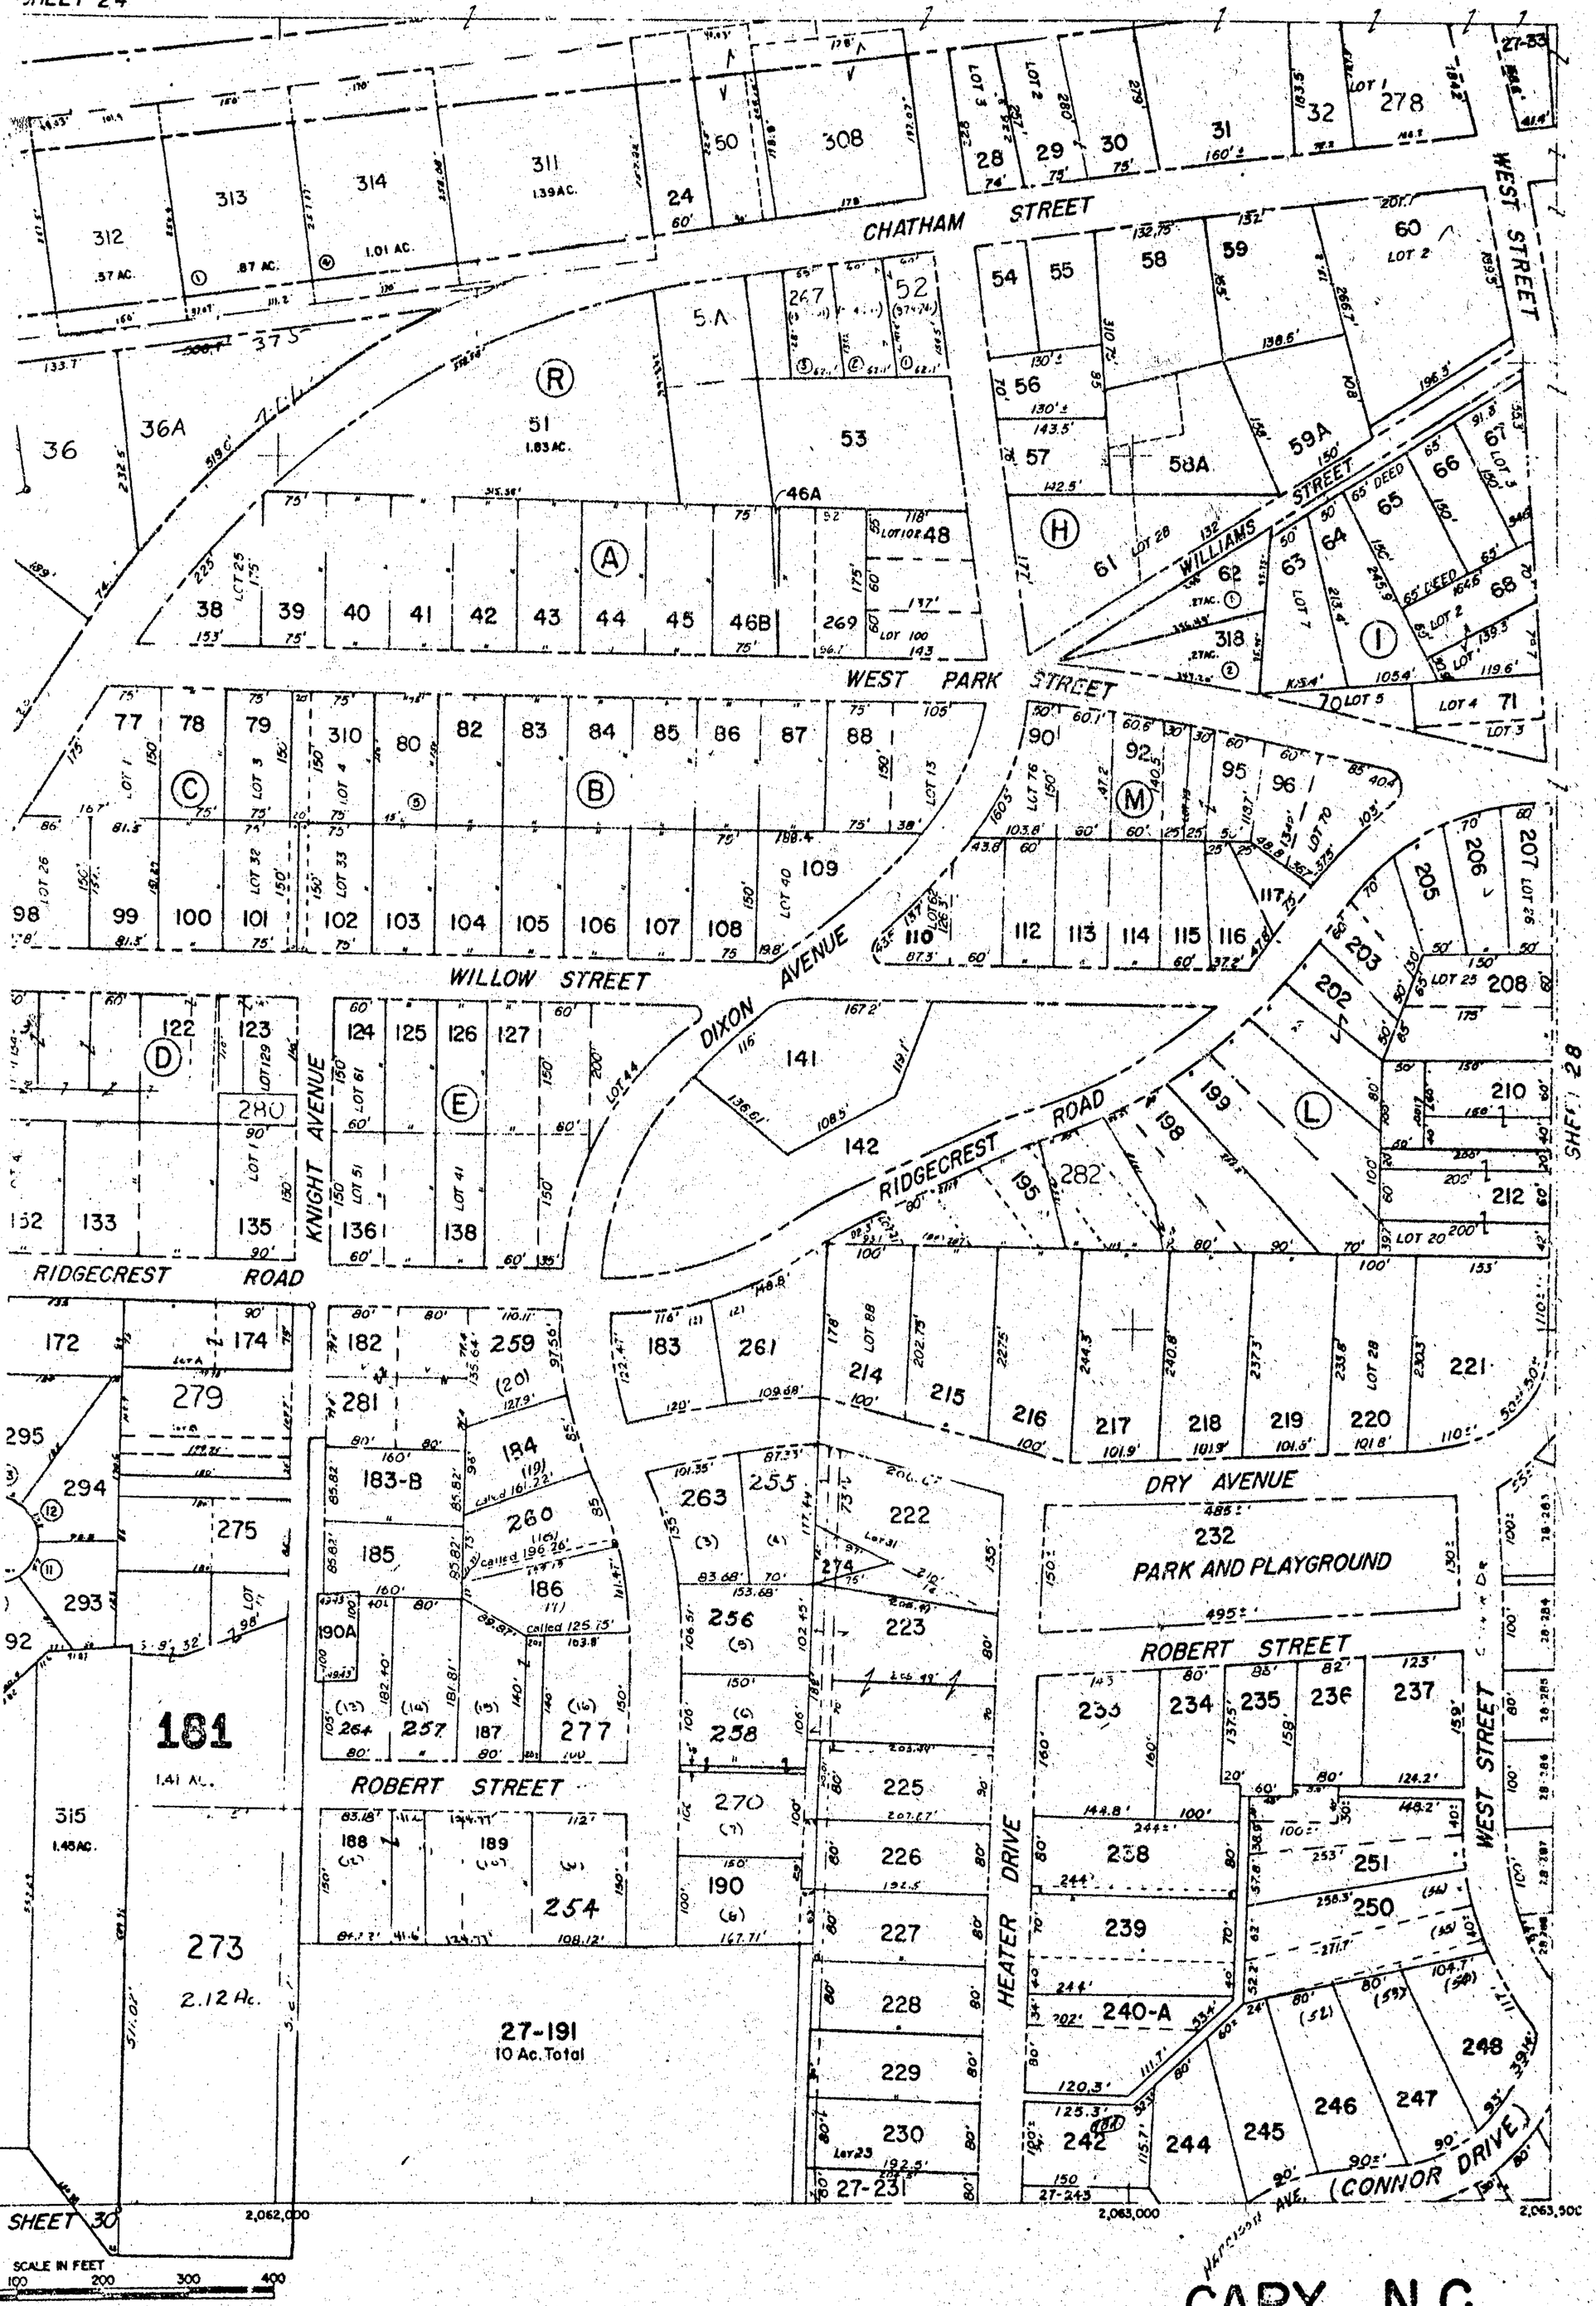

CAROLINA STATE PLANE COORDINATE SYSTEM


CARY, N.C.


27-181

SOTHE CO., H.C., GREENSBORO, N.C.
SURVEYS, INC., LOUISVILLE, KY.
MAY 1958

SHEET 27


LAST NO. 27

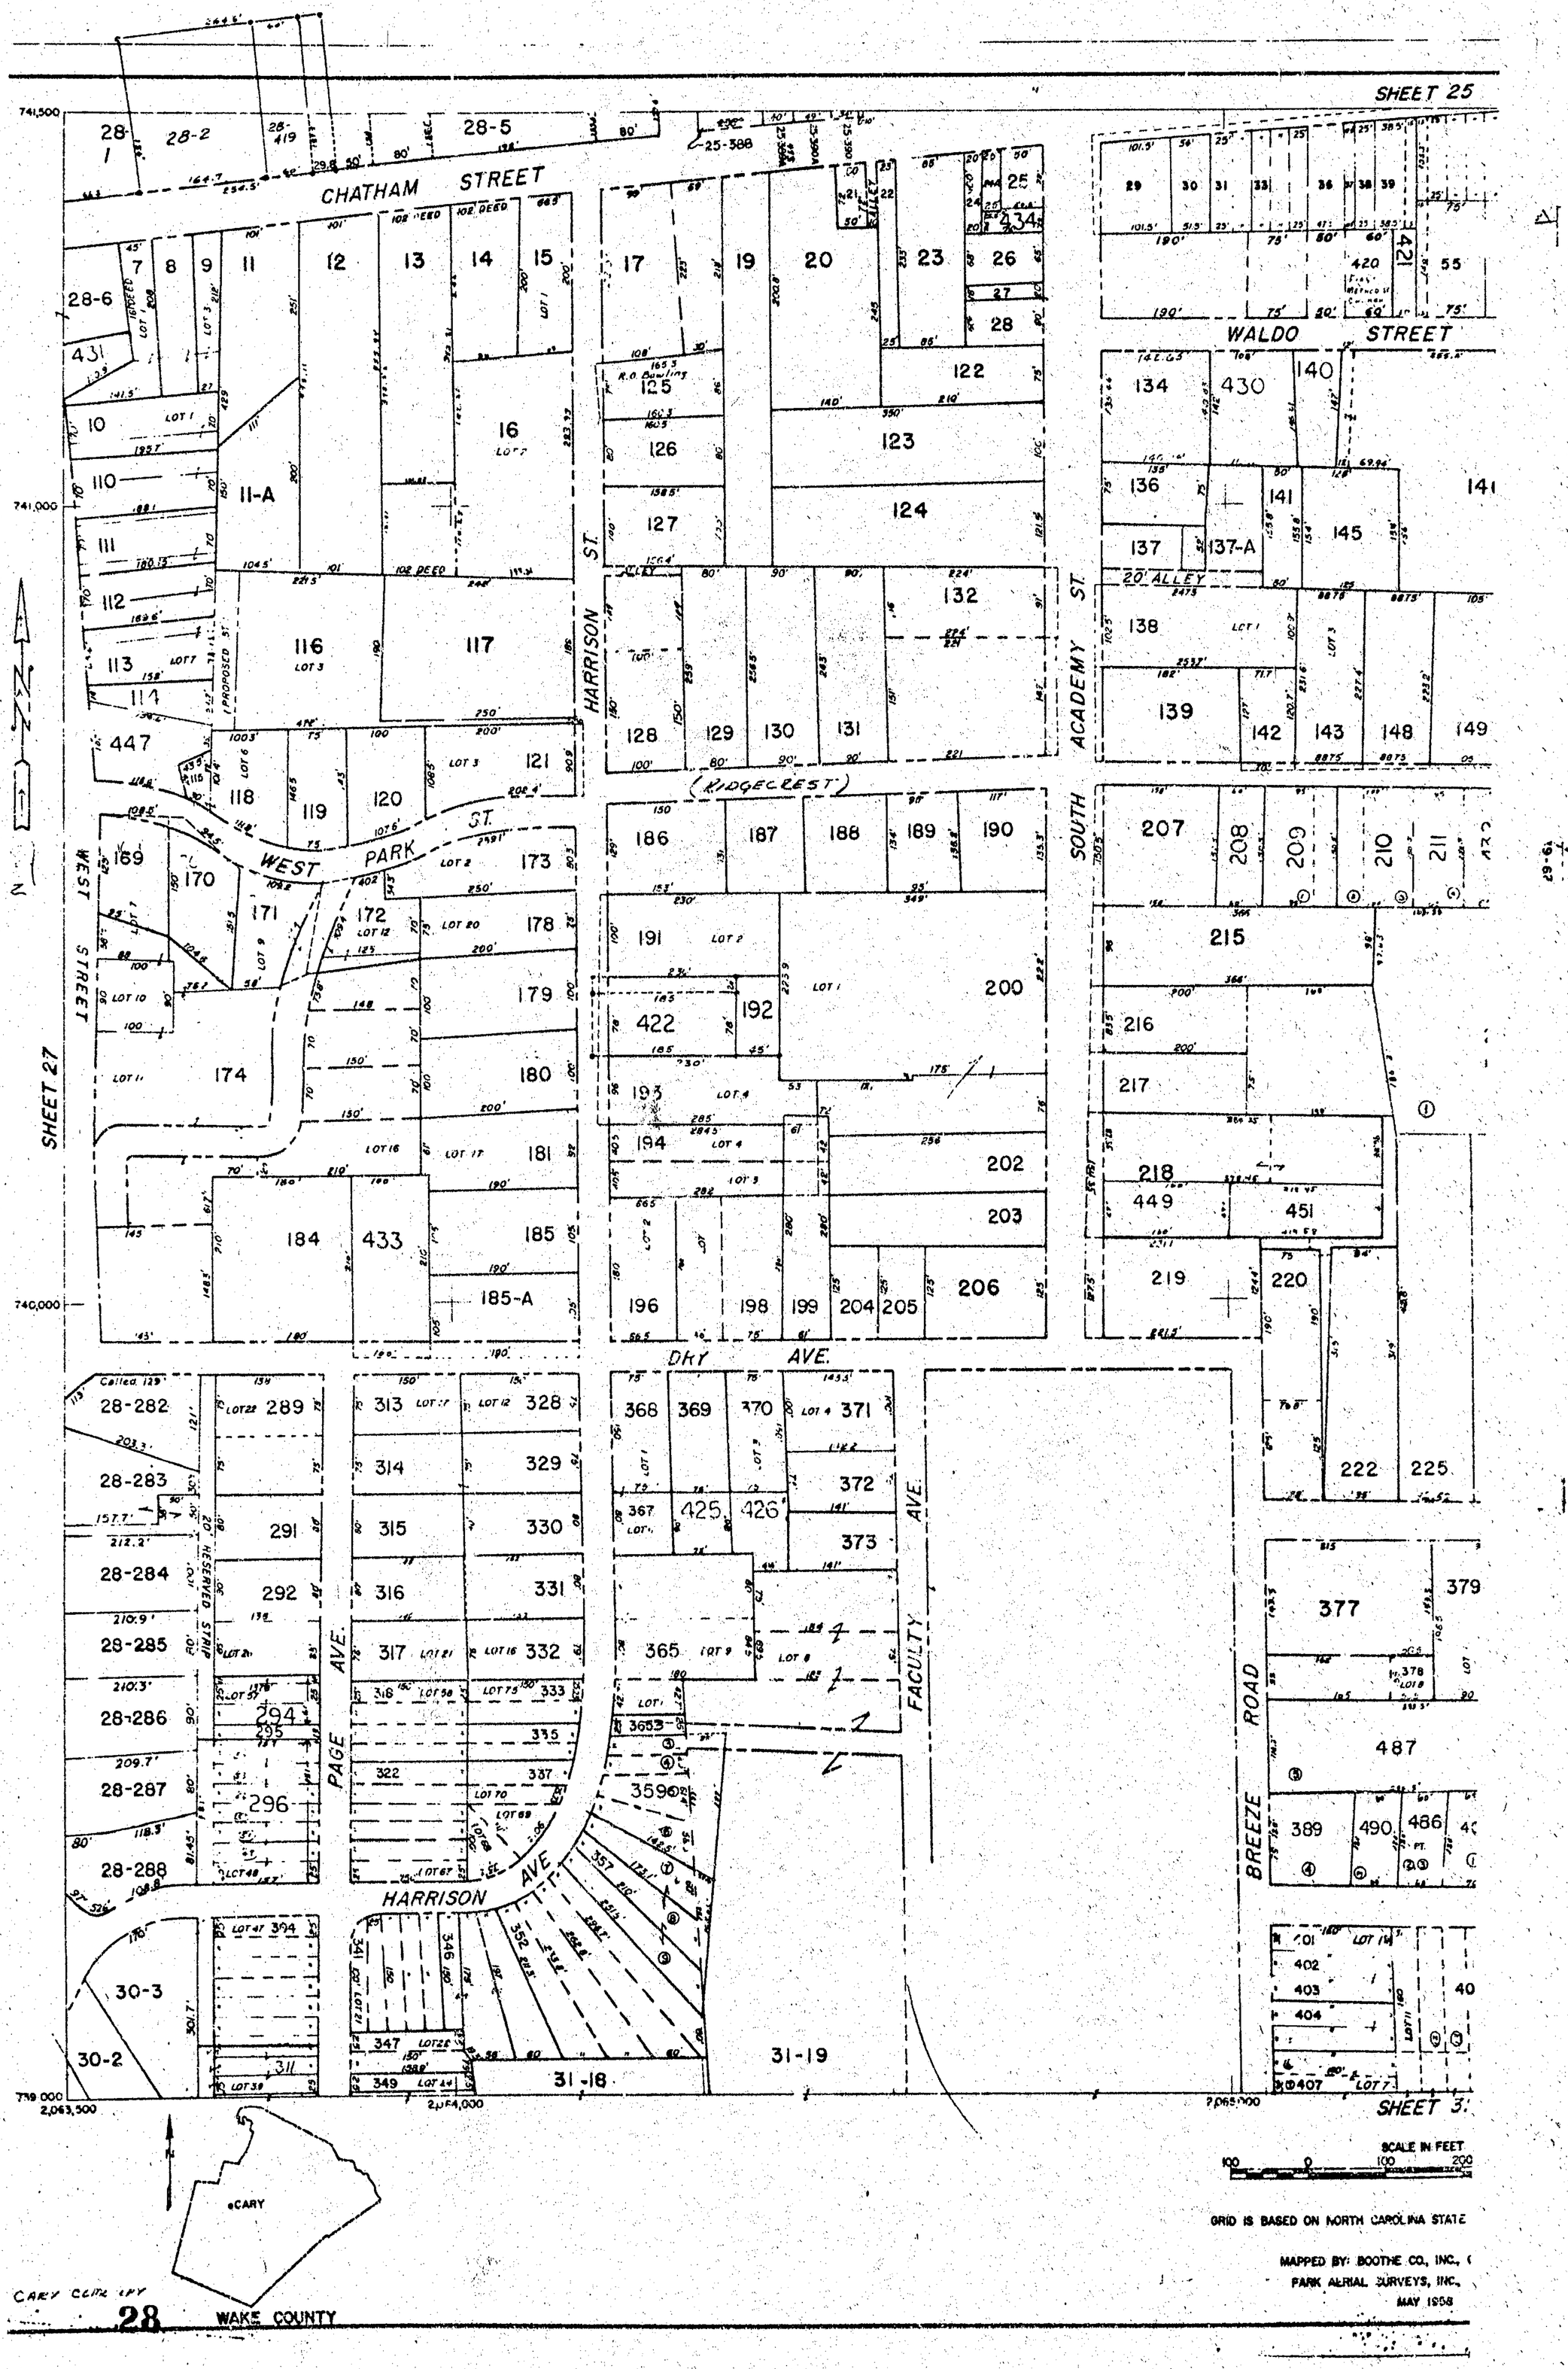

SHEET 25
CHATHAM STREET
WALDO STREET
HARRISON ST.
ACADEMY ST.
WEST PARK ST.
(RIDGECREST)
WEST STREET
SOUTH
DRY AVE.
PAGE AVE.
FACULTY AVE.
HARRISON AVE
BREEZE ROAD
20' ALLEY
(PROPOSED ST.)
741,500
741,000
740,000
739,000
2,063,500
2,064,000
2,065,000
SHEET 27
SHEET 3
CARY
CARY COMPANY
28 WAKE COUNTY
SCALE IN FEET
100 0 100 200
GRID IS BASED ON NORTH CAROLINA STATE
MAPPED BY: BOOTHE CO., INC.,
PARK AERIAL SURVEYS, INC.,
MAY 1958

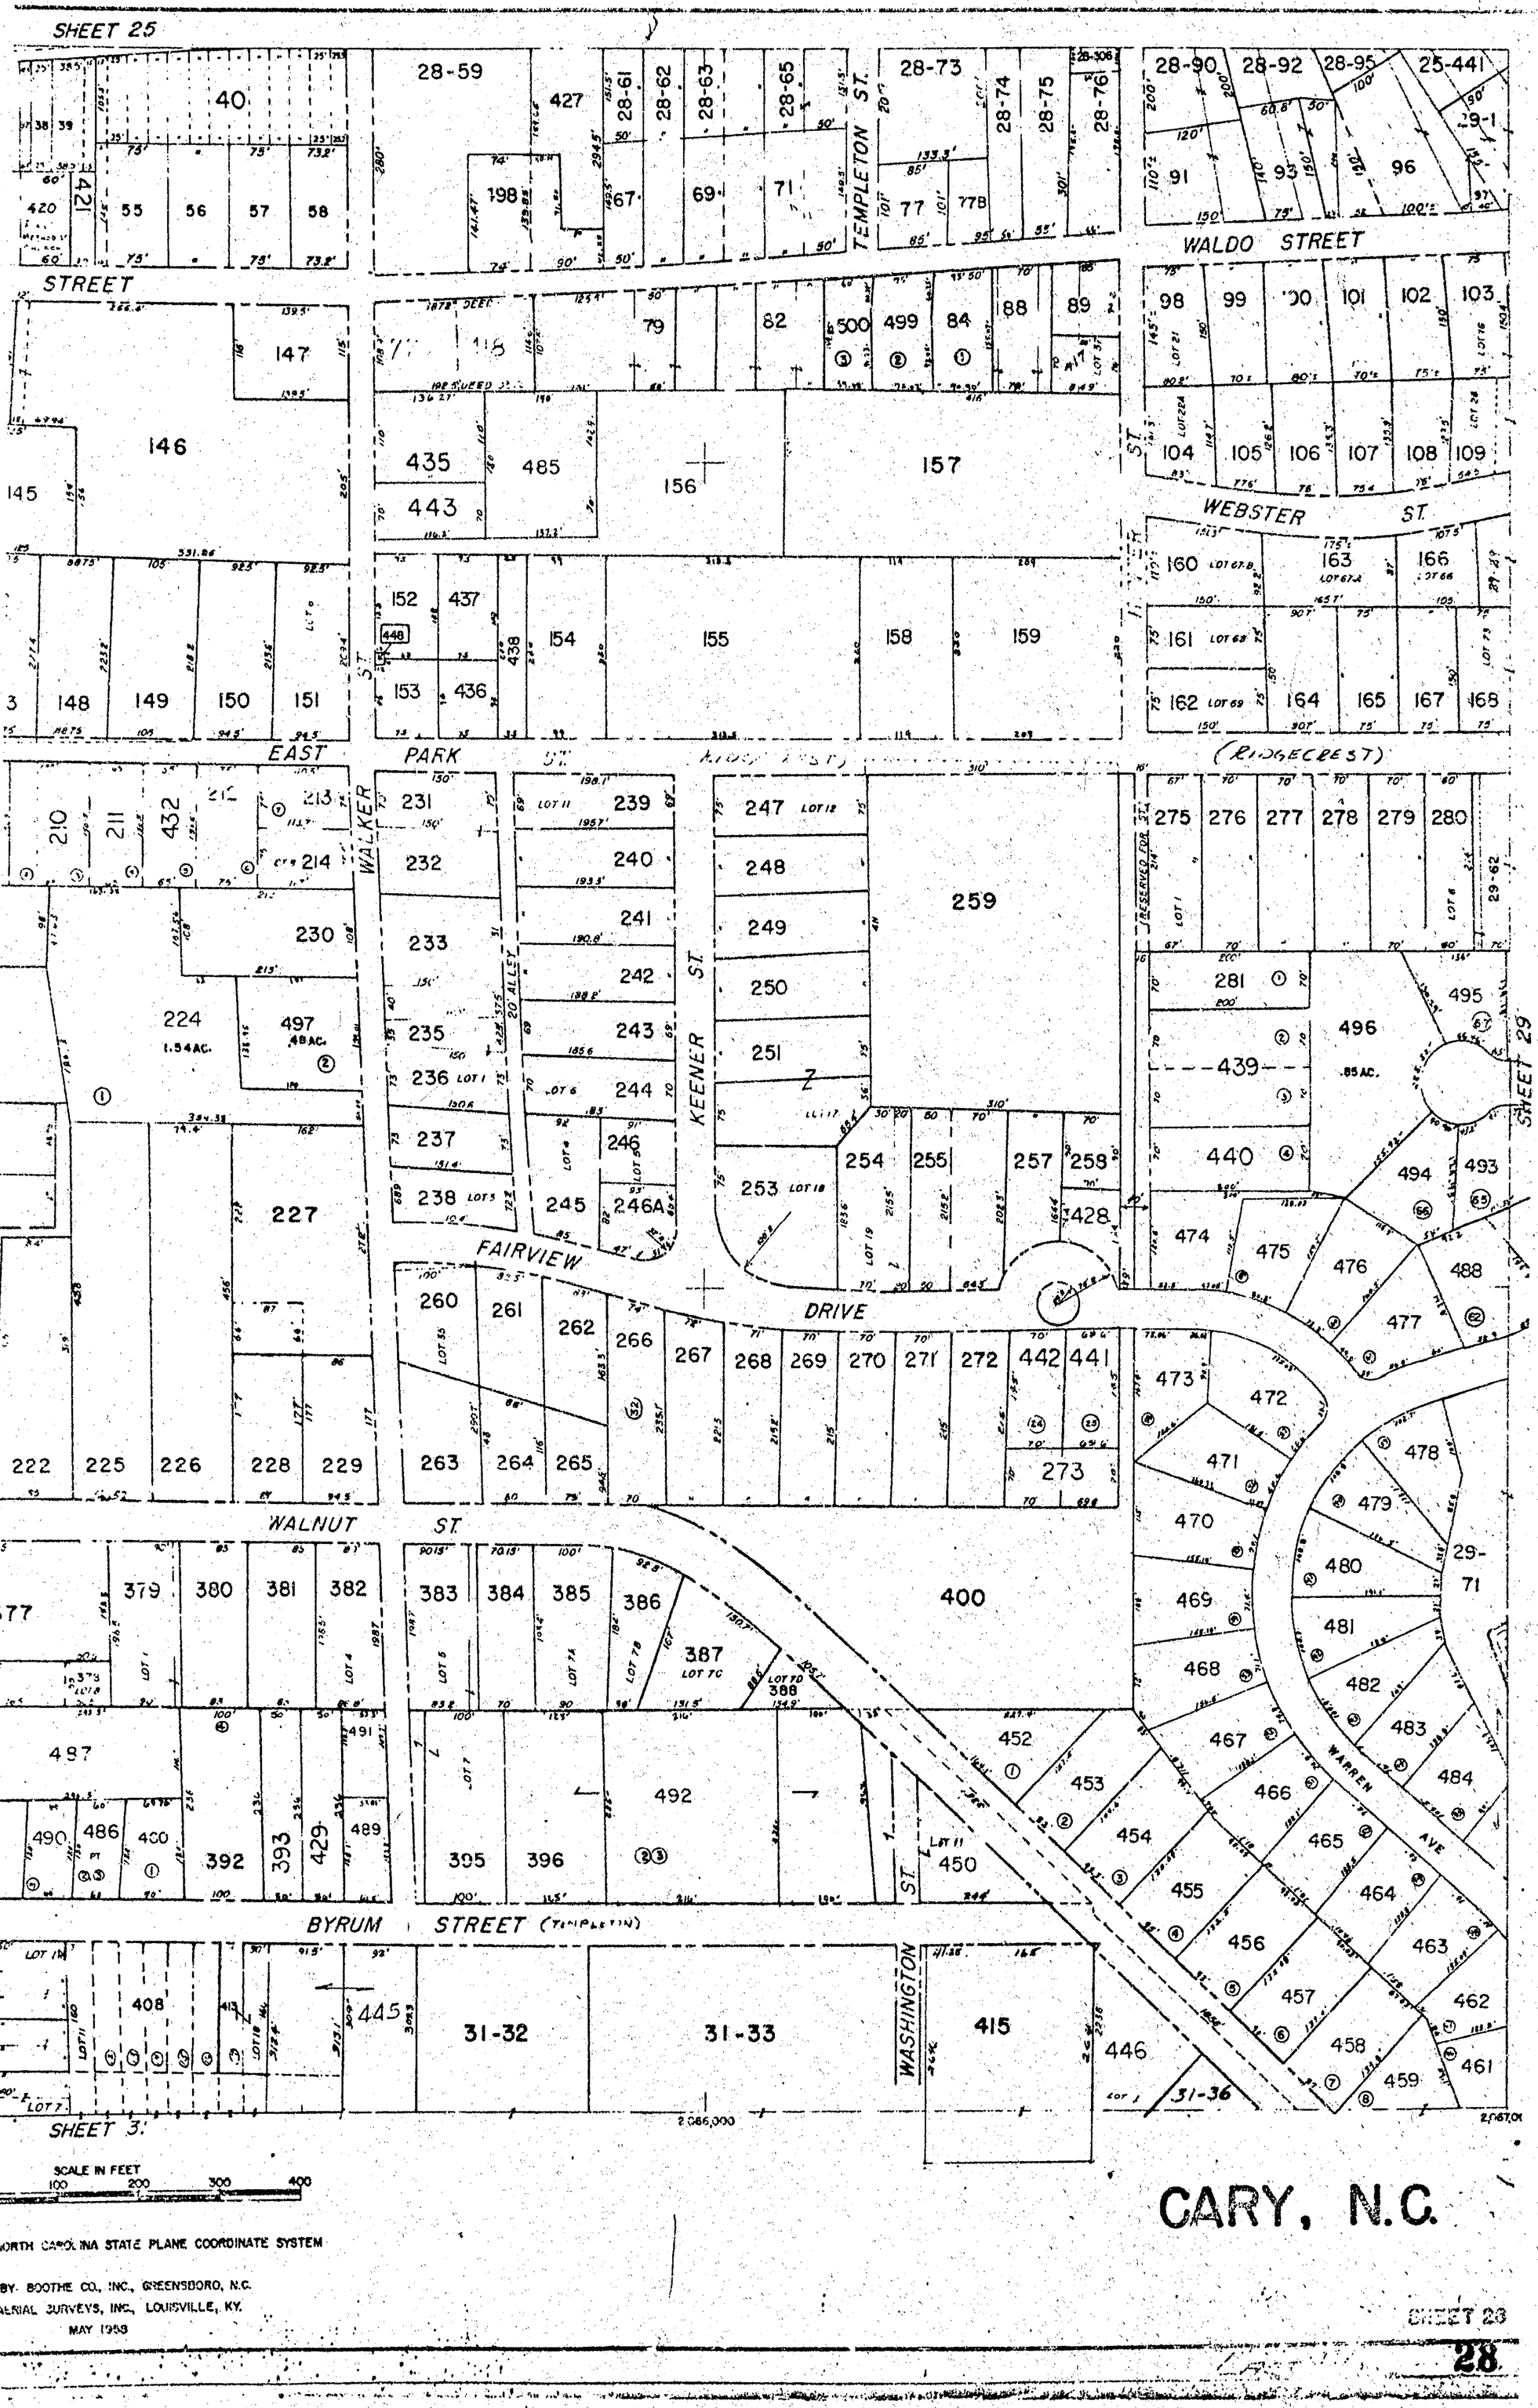

NORTH CAROLINA STATE PLANE COORDINATE SYSTEM

D BY- BOOTHE CO., INC., GREENSBORO, N.C.
K AERIAL SURVEYS, INC., LOUISVILLE, KY.
MAY 1959

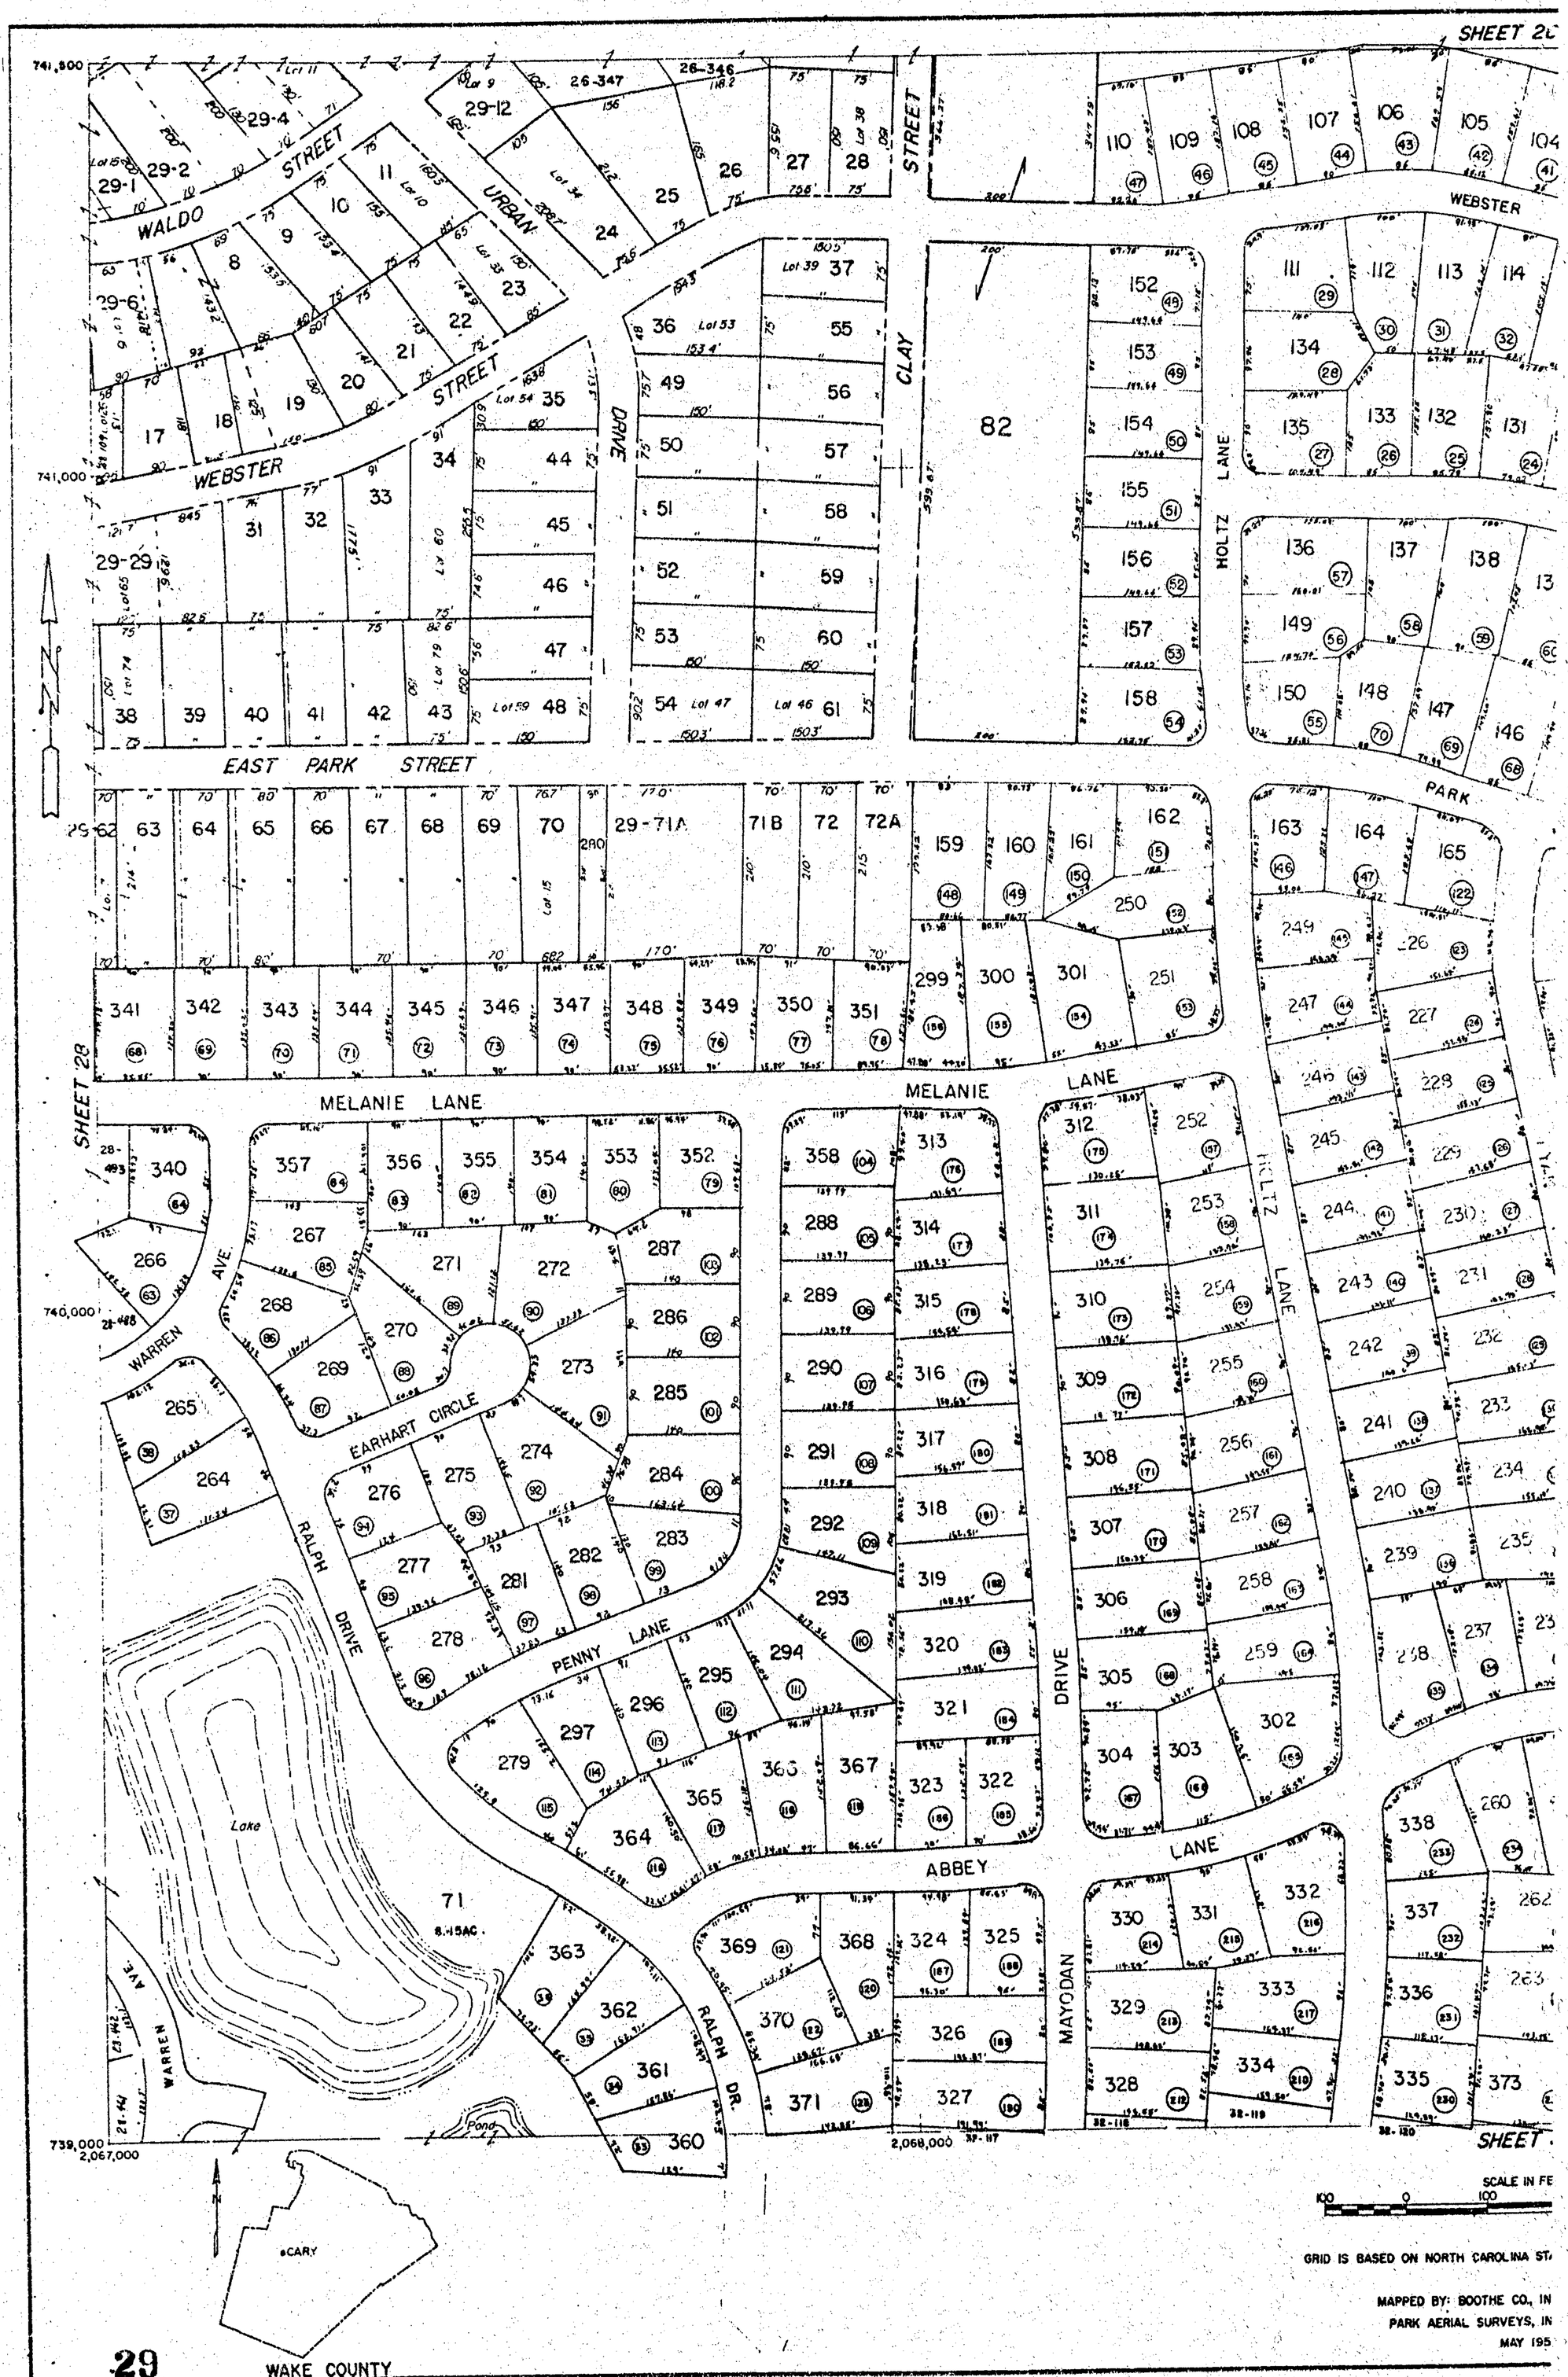
SHEET 28
741,800
741,000
740,000
739,000
2,067,000
2,068,000
WALDO STREET
URBAN STREET
CLAY STREET
WEBSTER STREET
EAST PARK STREET
WEBSTER
PARK
HOLTZ LANE
MELANIE LANE
EARHART CIRCLE
PENNY LANE
ABBEY LANE
RALPH DRIVE
MAYODAN DRIVE
WARREN AVE
Lake
Pond
CARY
71
8.15AC.
SCALE IN FE
100 0 100
GRID IS BASED ON NORTH CAROLINA ST
MAPPED BY: BOOTHE CO., IN
PARK AERIAL SURVEYS, IN
MAY 195
29
WAKE COUNTY

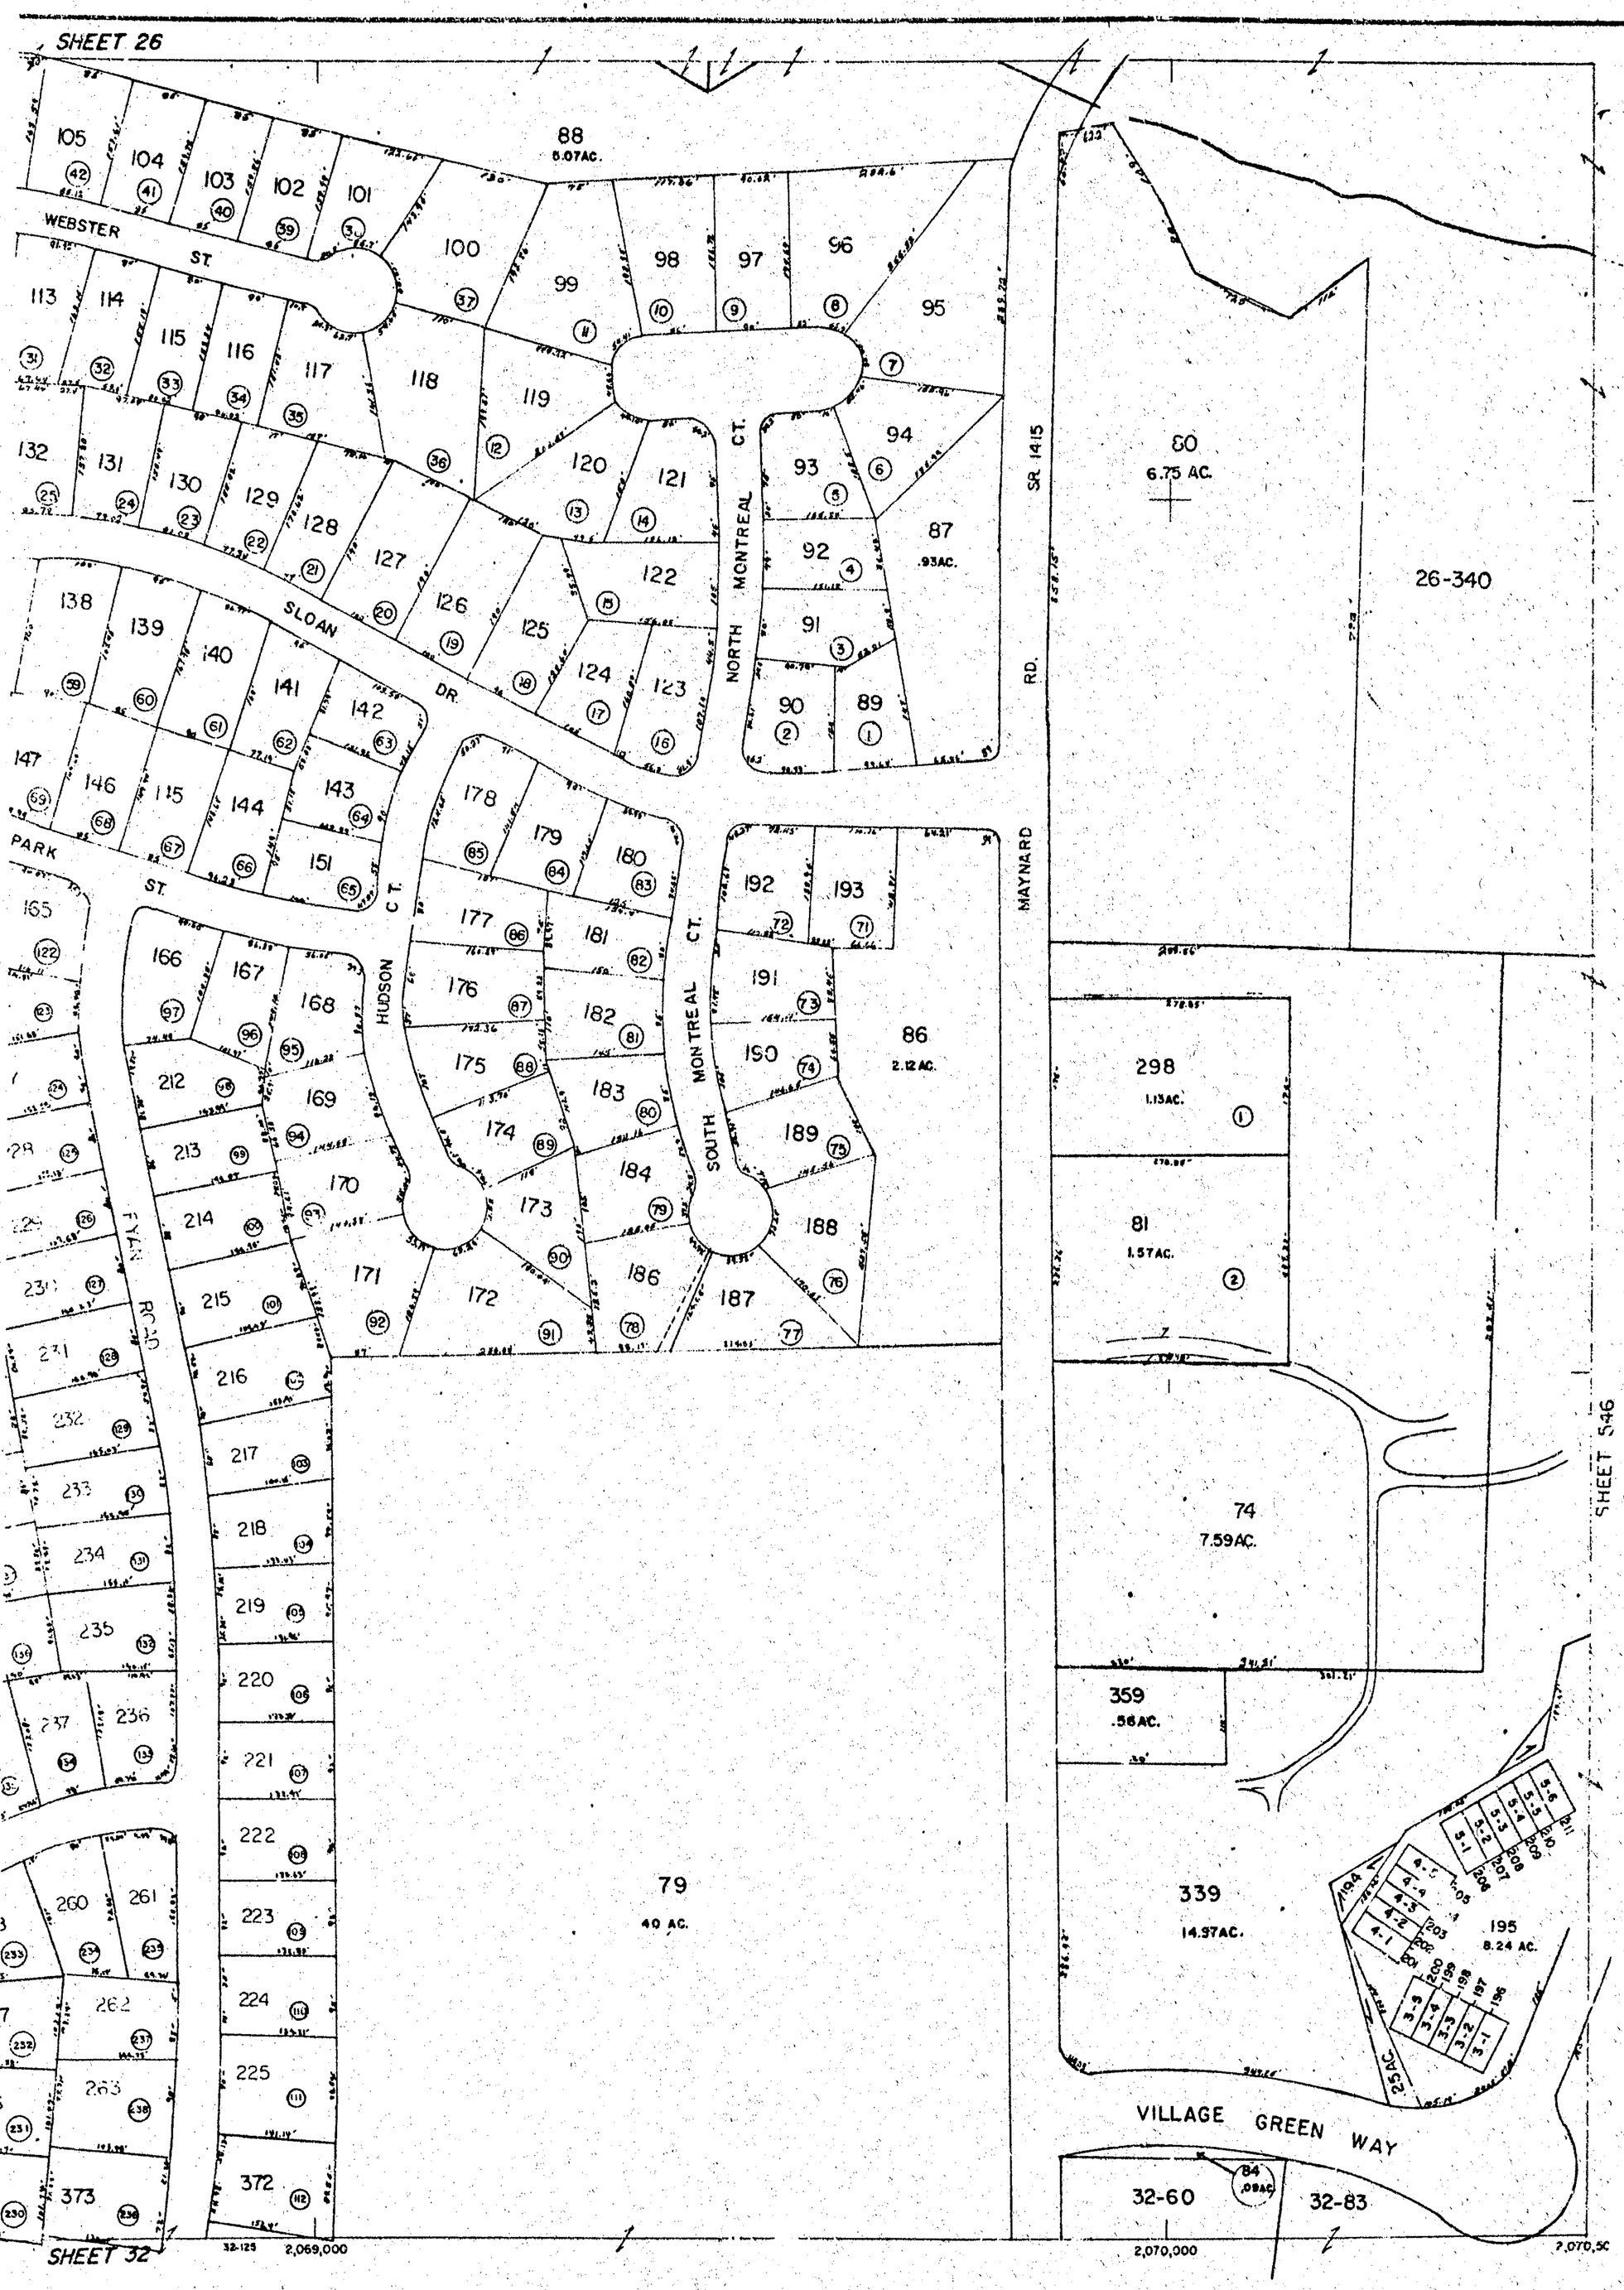

SCALE IN FEET
100 200 300 400

NORTH CAROLINA STATE PLANE COORDINATE SYSTEM

BY: BOOTHE CO., INC., GREENSBORO, N.C.
AERIAL SURVEYS, INC., LOUISVILLE, KY.
MAY 1958

CARY, N.C.


SHEET 29

LAST No: 29

SHEET 27

27-143
27-144
27-145
27-180
263
264
265
262
JASON CT.
1
268
1.94 AC.
259
12.8 AC.
30-2
16.36 AC.
3
7.06 AC.
70
261
1.01 AC.
71
72
73
74
75
76
77
212
211
210
209
208
207
206
205
204
98
100
120
121
186
187
188
189
220
219
218
217
216
215
221
69
96
93
94
95
107
108
109
110
111
133
134
214
213
122
123
124
125
126
127
128
129
130
131
132
146
147
148
151
149
190
193
191
194
192
195
152
153
154
155
156
157
158
159
196
197
198
199
15
16
17
18
19
20
49
50
51
21
22
23
32
33
40
41
52
54
53
78
60
79
112
113
135
136
137
160
161
SWIFT
DRIVE
DORSET
DR.
NORMANDY
CORNWALL
DRIVE
PAMLICO
HILLVIEW
UNION
STREET
ROAD
JASON CT.
CALLED 1000'
545-8
SHEET
PROJECT
EPISCOPAL C
738,000
737,000
736,500
2,060,000
2,061,000
SEE WISHING WELL VII
SHEET
SCALE IN FEET
100 0 100 200
GRID IS BASED ON NORTH CAROLINA STATE PI
MAPPED BY: BOOTHE CO., INC., GR
PARK AERIAL SURVEYS, INC., LC
MAY 1956

30 WAKE COUNTY

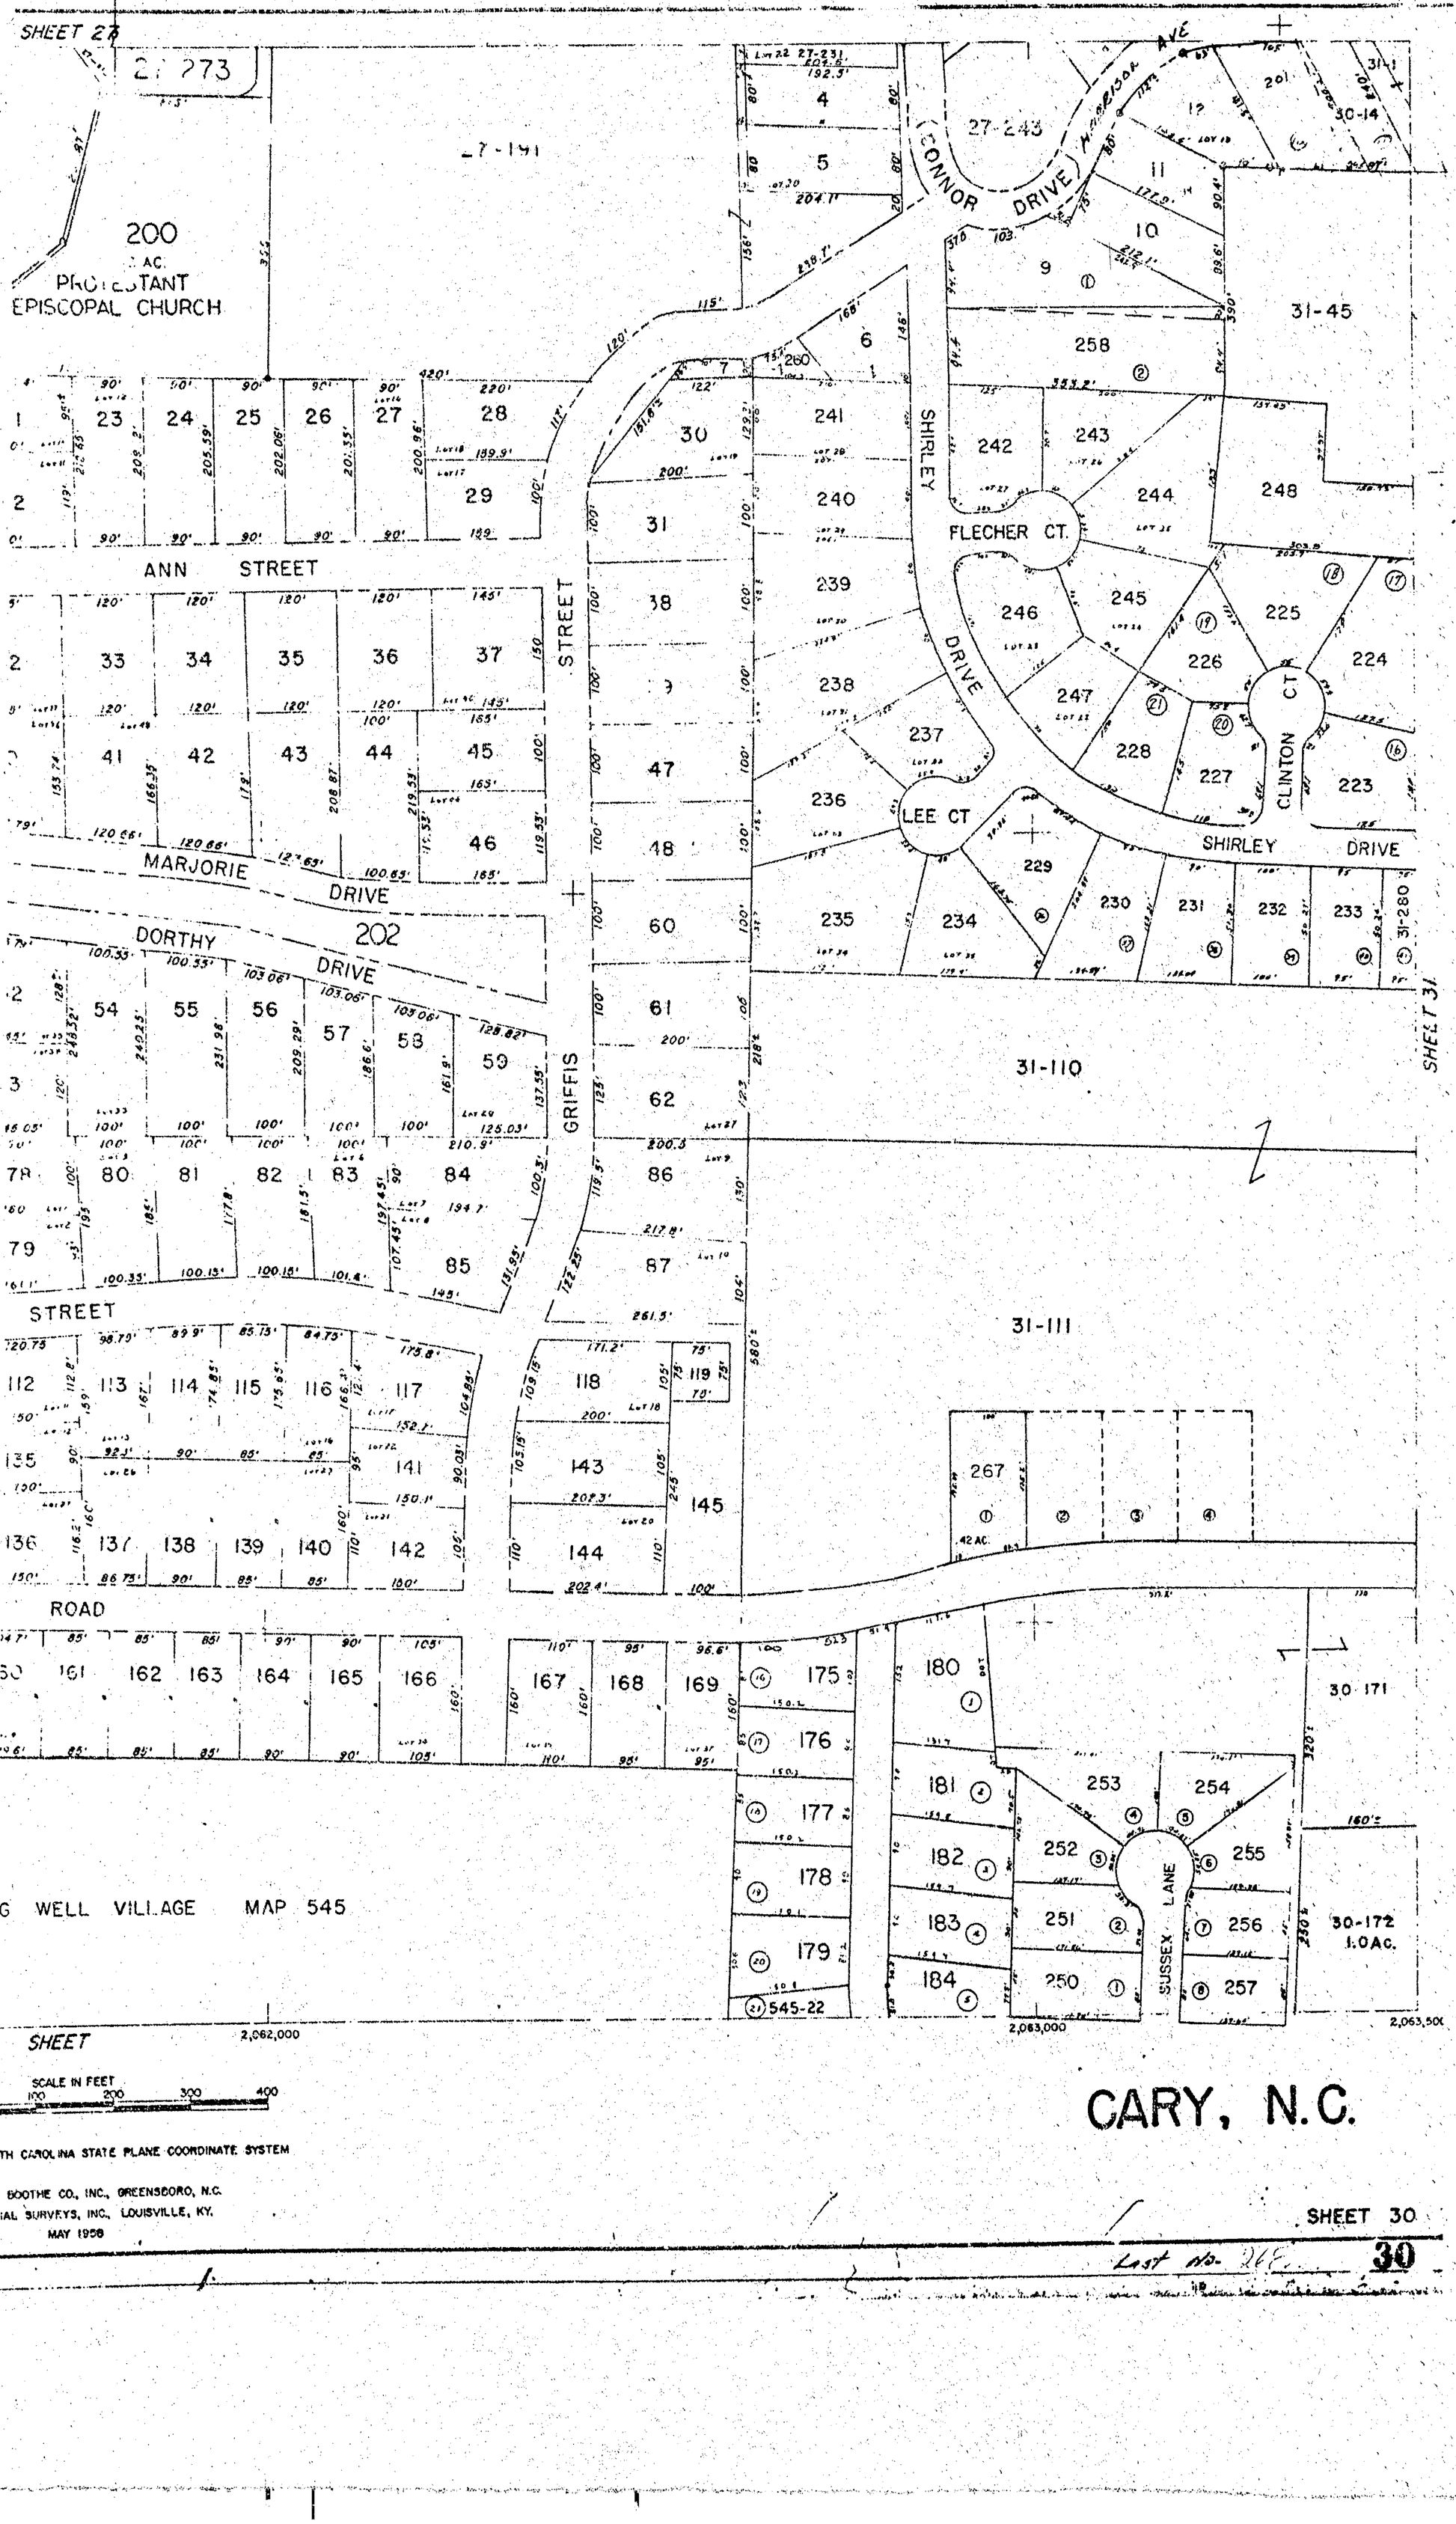
SHEET 28
2: 273
200
: AC.
PROTESTANT
EPISCOPAL CHURCH
27-141
27-243
CONNOR DRIVE
HARRISON AVE
ANN STREET
MARJORIE DRIVE
DORTHY DRIVE
202
STREET
GRIFFIS
SHIRLEY DRIVE
FLECHER CT.
LEE CT
CLINTON CT
SHIRLEY DRIVE
31-45
31-110
31-111
30-14
31-280
SHEET 31
ROAD
267
42 AC.
30-171
180
253
254
252
255
251
256
250
257
SUSSEX LANE
30-172
1.0Ac.
545-22
G WELL VILLAGE MAP 545
2,062,000
2,063,000
2,063,500
SHEET
SCALE IN FEET
100 200 300 400
TH CAROLINA STATE PLANE COORDINATE SYSTEM
BOOTHE CO., INC., GREENSBORO, N.C.
AL SURVEYS, INC., LOUISVILLE, KY.
MAY 1958
CARY, N.C.
SHEET 30
Last No. 26E
30

SHEET 2

735,000

31-1

31-2

31-3

31-18

31-19

258
1.04 AC.

46
1.87Ac.

31-45

47
1.21 AC

48

49

301

22

50

5'

52

109

57

169

170

171

172

173

174

DOWELL

184

185

186

187

188

205

204

203

202

201

200

189

191

190

192

193

194

195

196

199

198

197

SPRING CIRCLE

240

241

242

243

244

245

266

267

265

264

263

262

261

268

269

270

271

272

273

274

275

291

276

289

288

287

277

278

286

108
.9AC.

284

285

292

310
.99AC.

280

281

282

283

SHIRLEY

COLE CT

AVERY CIR.

DR

30-248

736,000

SHEET 30

2058'

110
32.5AC.
32.98 AC.

Pond

KILDAIRE FARM ROAD

112

113

114

260
.53

302
33AC.

116 A
.89 AC.

116
.61 AC.

299
.32 AC.

PLEASANTS FARM ROAD

737,000

117

118

119

120

121
1.4Ac.

122
1.18 AC.

124

125

126

130

131

295

294

296

293

31-129

257
1 Ac.
E.G. Northcutt
1504/105
5-11-62

300
.44AC.

2,067,500

2,064,000

2,065,000

SHEET

SCALE IN
100 0 100

GRID IS BASED ON NORTH CAROLINA

MAPPED BY: BOOTHE CO.
PARK AERIAL SURVEYS,
MAY

•CARY

31

WAKE COUNTY

SHEET 28

28-408
31-32
1.417 Ac Total
31-33
4.5 Ac Total
31-34
28-459
WALNUT STREET
WARREN AVE.
PLEASANTS AVENUE
(OLD AUSTIN AVE.) PLEASANTS AVE.
AUSTIN AVENUE
DOWELL DRIVE
SPRING STREET
CAROLYN COURT
WASHINGTON STREET
CORNWALL ROAD
Dirt Road
(No Deed For Line)
546-94
SHEET 32
SHEET 546

SCALE IN FEET
0 200 300 400

AROLINA STATE PLANE COORDINATE SYSTEM

THE CO., INC., GREENSBORO, N.C.
...VEYS, INC., LOUISVILLE, KY.
MAY 1973

CARY, N.C.

LAST NO:

SHEET 31 **31**

739,000

CORONADO WAY

WALNUT ST.

PLEASANTS AVE

RALPH DR.

MAYODAN DRIVE

HOLTZ LANE

MAYODAN DRIVE

RALPH DRIVE

CAROLYN COURT

ELLYNN DRIVE

CORNWALL RD.

IRHAMKATTE OR MACEDONIA RD)

CORPORATION LIMITS

SHEET 31

SHEET 33

Old Road

738,000

737,000

736,500

2,067,000

2,068,700

29-360

29-71

32-1 LOT 10

32-2 LOT 1

32-9

32-10 LOT 21

32-17

32-21 LOT 39

32-22

32-24 LOT 5

106 105 104 107 108 109 110 88 89 90 103 102 91 92 101 100 99 98 93 94 95 97 96

3 4 5 6 7 8 LOT 17 11 12 14 15 LOT 26

18 19 20 LOT 34 23 LOT 41

32 LOT 42 31 30 29 28 27 26 LOT 48 25 LOT 47

37 LOT 41 38 LOT 122 39 40 41 LOT 123 42 LOT 126 45 43 46 LOT 128 44 LOT 127 47 LOT 129 48 LOT 136 49 LOT 137 50 LOT 130

121 122 123 111 112 113 114 115 117 134 135 136 137 138 139

80 1.07 AC.

73 .97 AC.

.65 AC.

#61 .88 Ac.

72 1.06 AC.

33 5.74 AC.

34 16.20 AC.

77 12.2 AC.

116 3.06 AC.

32-35A 8.76 AC.

62 5.15 AC.

546-115

118 119 152 124 151 153 150 154 149 155 148 156

120 161 160 162 159 163 158 164 157 166 165

140 141 142 143 144 145 146 147 167

SCALE IN FEE


100 0 100

GRID IS BASED ON NORTH CAROLINA STA

MAPPED BY: BOOTHE CO., INC.
PARK AERIAL SURVEYS, INC
MAY 1958

CARY

32 WAKE COUNTY

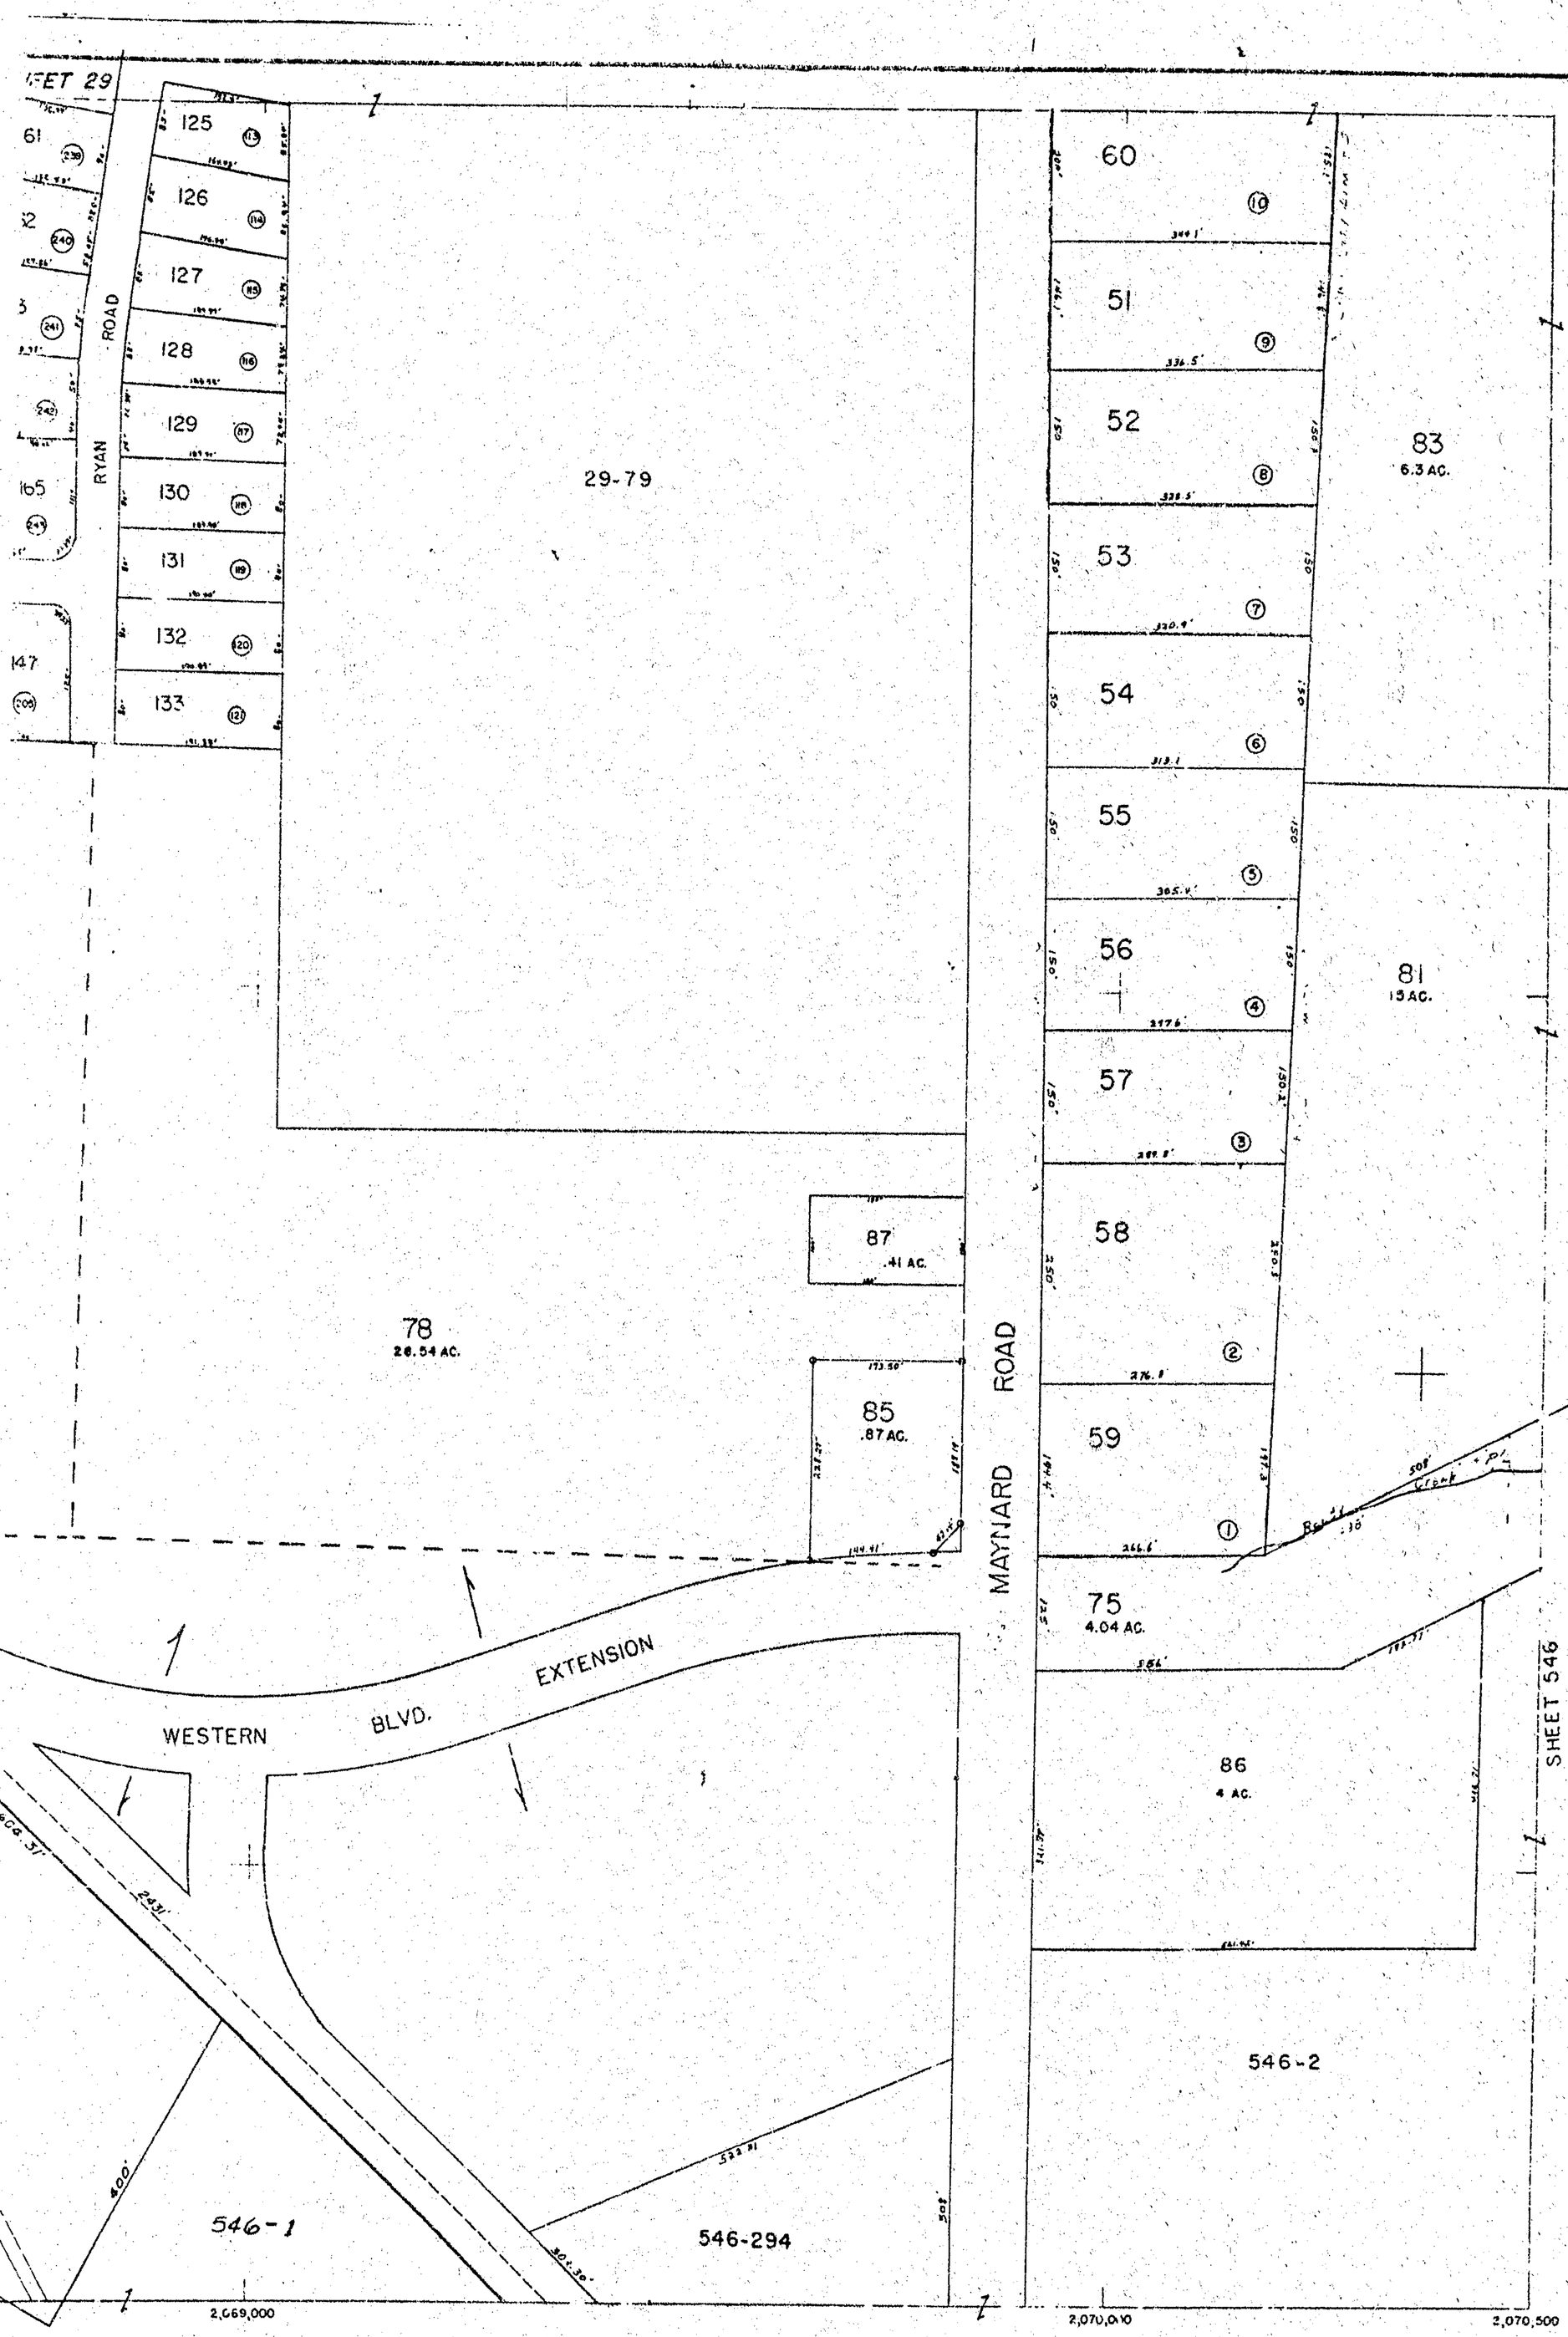

AROLINA STATE PLANE COORDINATE SYSTEM

THE CO., INC., GREENSBORO, N.C.
SURVEYS, INC., LOUISVILLE, KY.
MAY 1958

CARY, N.C.

SHEET 32 32

LAST NO

SHEET

718,500

657-10

33-1
6.7 Ac.± Total

33-2

33-3
5.79 AC.

33-4
34.8 AC.

718,000

33-8

81
3.2 AC.

N

657-20

12
0.5 Ac.

63

14
0.24 Ac.±

15
0.32

16
0.31

17
0.3 Ac.

18
0.56 Ac.±

65
.86 Ac.

66

76
.92 AC.

13
.43 AC.

18A

84

64

18B

717,000

19
3.69 AC.

80
.46 AC.

20

23

53

73

69

70

71

HENRY DR.

56

24

75

74

26

27

72

30

LOOP ROAD

21
2.21 AC

78
1.1 AC.

85
1.09 AC.

25
0.4 Ac.±

54

657-23

32

32-A

(23)
(24)
(25)
(26)
(27)
(28)
(29)

U.S. HWY. 70

77
16.51 AC.

36-9

716,000
2,108,250

2,109,000

SHEET

SCALE IN I
100 0 100

GRID IS BASED ON NORTH CAROLINA S


MAPPED BY: BOOTHE CO., I
PARK AERIAL SURVEYS,
MAY 1S

GARNER

33

WAKE COUNTY

SHEET 657

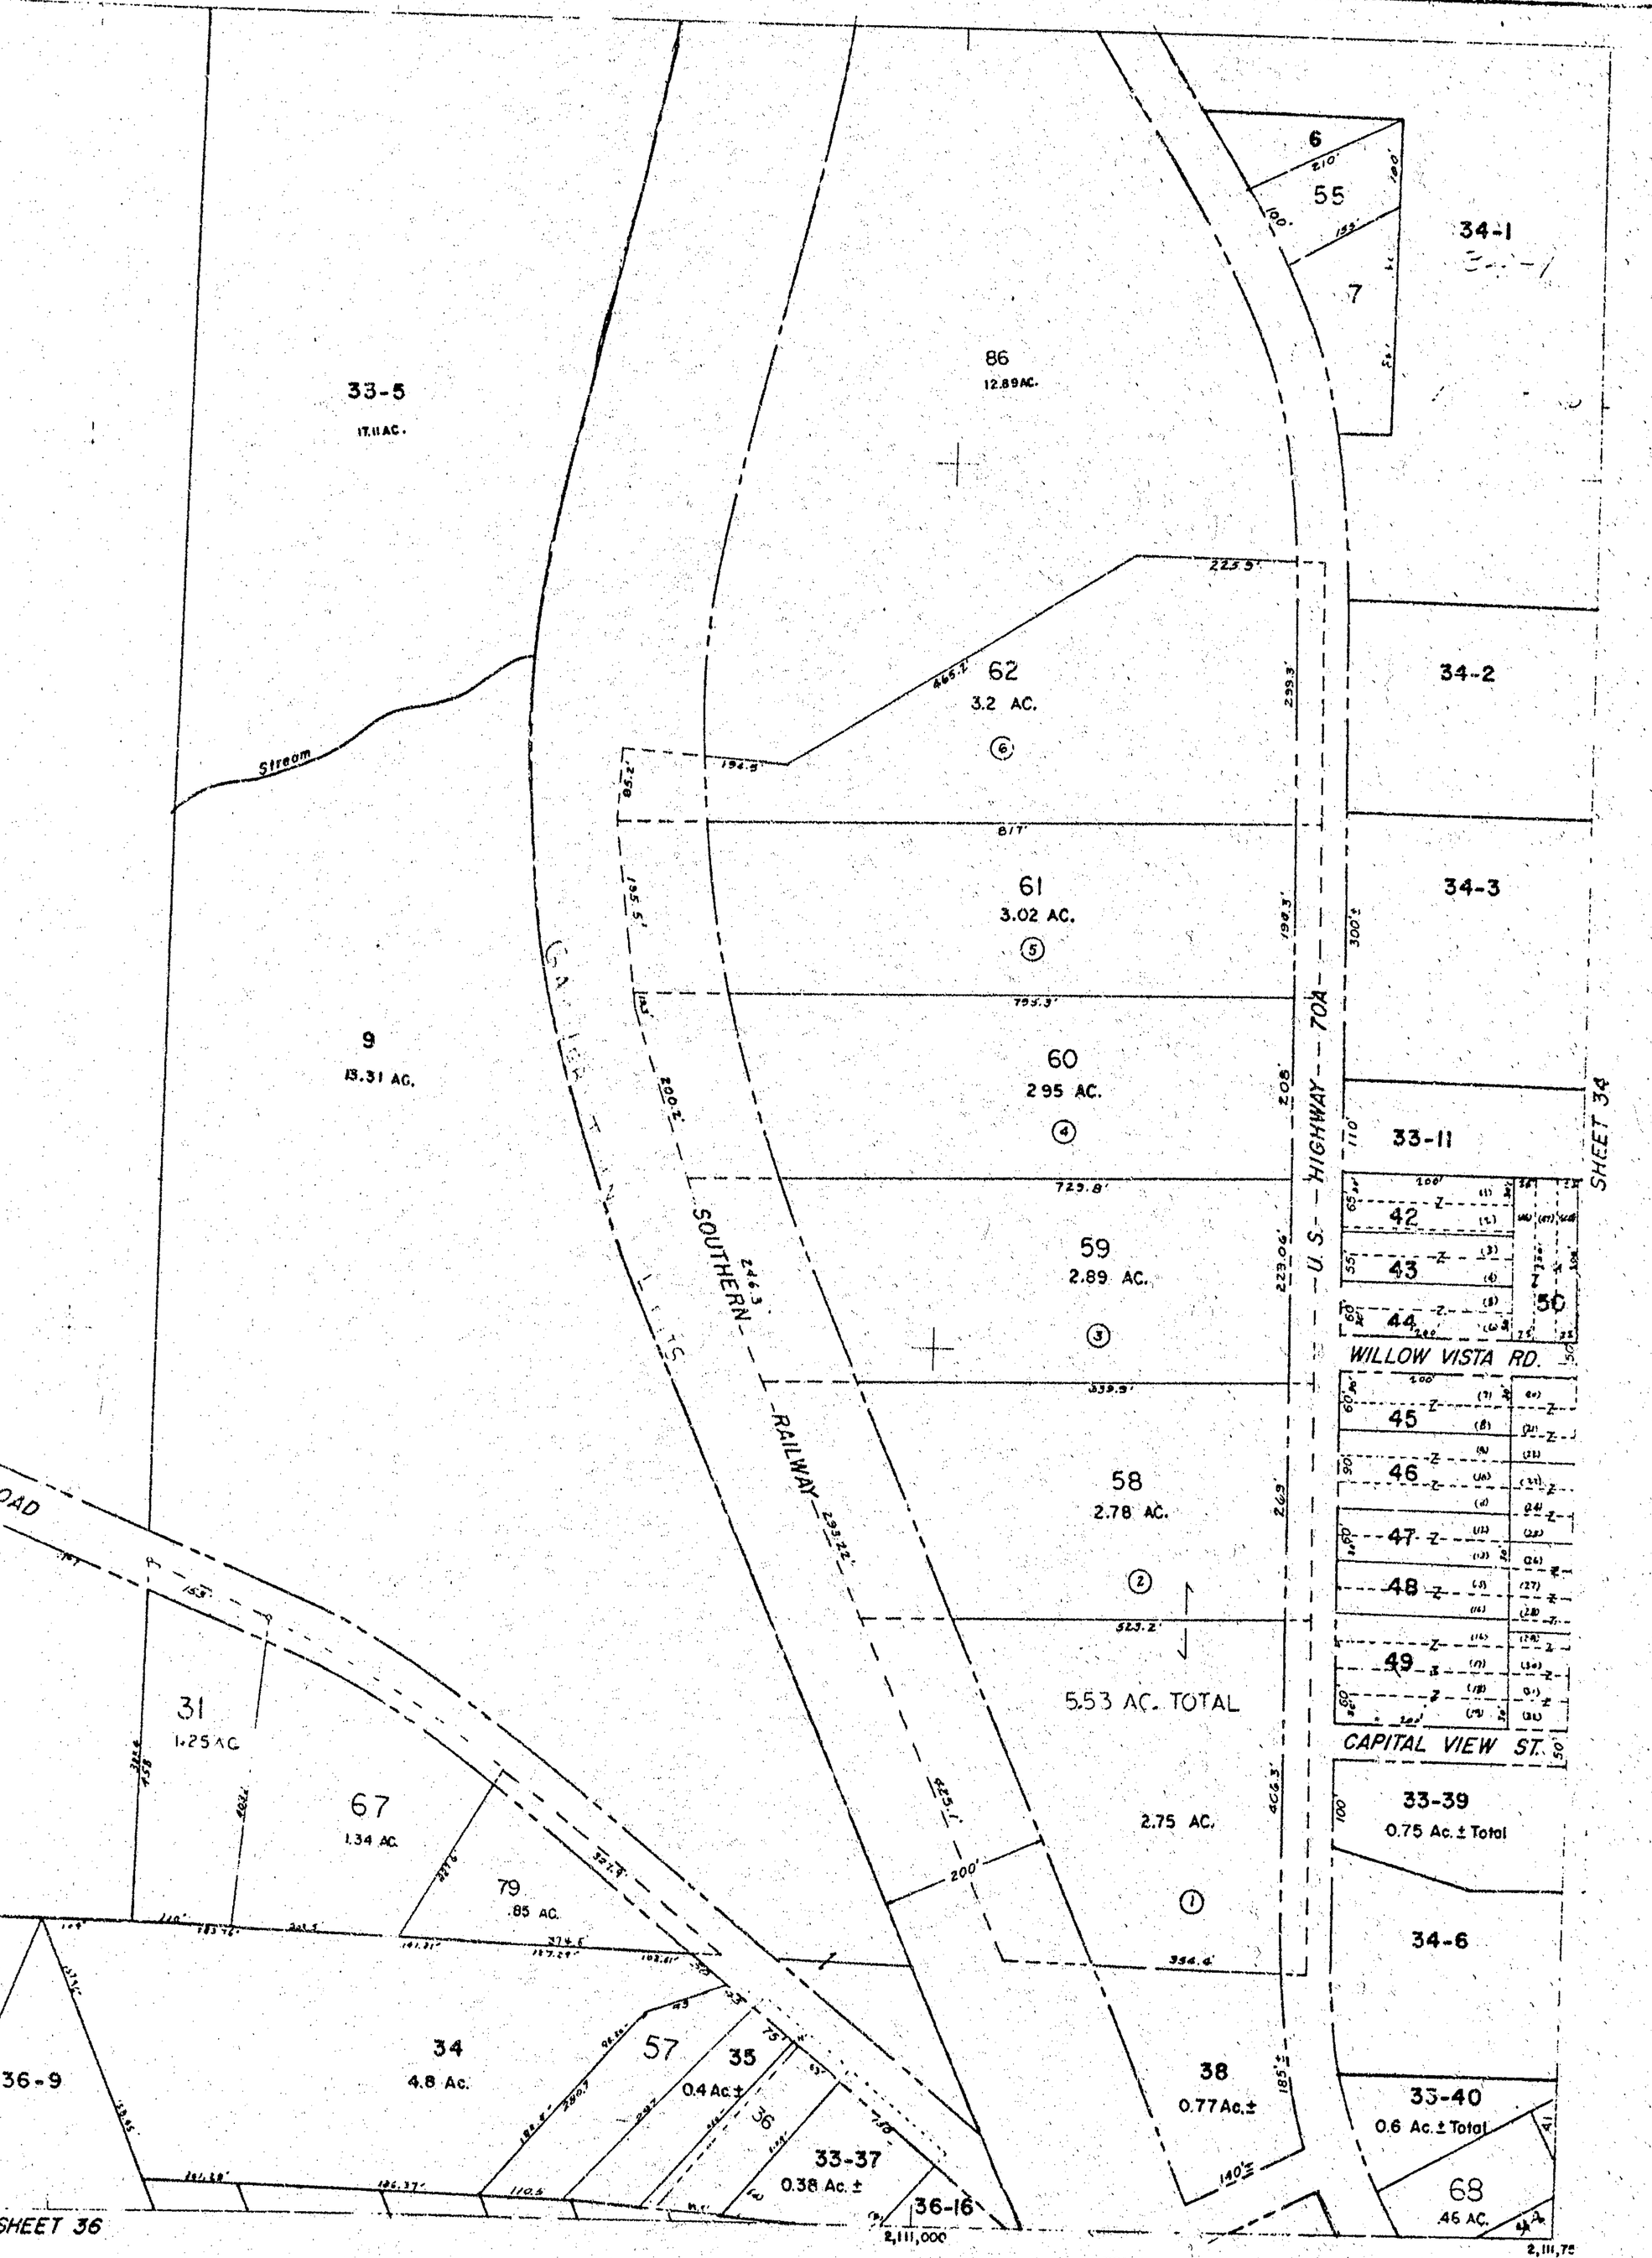

SCALE IN FEET
100 200 300 400

I NORTH CAROLINA STATE PLANE COORDINATE SYSTEM

D BY BOOTHE CO., INC., GREENSBORO, N.C.
K AERIAL SURVEYS, INC., LOUISVILLE, KY.
MAY 1958

GARNER, N.C.

33
SHEET 33

LAST No. 64

718,500

718,000

717,000

716,000
2,111,750

2,113,000

LAKE

LAKE

LAKE

LAKE

2

3

O.Q. JOHNSON
27 ACRES

SHEET 33

33-11

81
48 AC.

33 34 36 37

WILLOW VISTA RD.

38 82 39 40 41

GREEN SPRINGS DR.

46 45 44 43 42

CAPITAL VIEW ST.

7

6
5.3 AC.

76
46.57 AC.

33-41

83
1.35 AC

37-1

37-185

37-184

N

GARNER

34 WAKE COUNTY

SHEET 37

SCALE IN FEET
100 0 100 200

GRID IS BASED ON NORTH CAROLINA STATE PLAN

MAPPED BY: BOOTHE CO NC., GREEN PARK AERIAL SURVEYS, C., LOUIS
MAY 1958

SHEET 657 + 658

RICHARDSON ROAD

WESTON ROAD

SHEET 35

12

20-B

LAKE

LAKE

85
13.08 AC.

84
1.11 AC.

77
1.5 Ac.

88
10.43 AC.

79

78

80
2 AC.

11
5.06 AC.

53 54 55 56 57

10
1.28 AC.

83
7.2 AC.

58

59

60

90
1.01 AC.

89
6 AC.

47 13 14 51 15 16 17 18 19 48 49 50 61

690.54'

24815'

STREET

62 63 64 65 66 67 68 69 70 71 72 73

CURTIS STREET

24 25 LOT 17 LOT 16 37-58

29 31 74 75 37-175

34-30 LOT 8

JOHNSON

38-1

SHEET 37

2,114,000

2,115,000

2,115,250

SCALE IN FEET
100 200 300 400

RTH CAROLINA STATE PLANE COORDINATE SYSTEM

f: BOOTHE CO., INC., GREENSBORO, N.C.
RIAL SURVEYS, INC., LOUISVILLE, KY.
MAY 1958

GARNER, N.C.

SHEET 34

LAST No. 34

SHEET 65

718,500

658-64

658-63

Road

CEM

Road

Road

716,000

34-90

34-89

114

5

23

Stream

SHEET 34

717,000

34-208

119

10.82 AC.

115

.65 AC.

⑥	⑤	④	③	②(J)	①	①	②	③	M ④	⑤	⑥
108	109	110	2	3	4	5	6	7	8	9	10
85'	85'	230'	100'	100'	110'	110'	85'	"	"	85'	91.13'

CURTIS DRIVE

38-1

BRYAN ST.

AVERY ST.

LONGVIEW

	14 LOT 9	15 (H)	16 LOT 11			19 LOT 14	20 (I)	21 LOT 16		11 (G)	12
	35-17 LOT 8		35-18 LOT 12			35-22 LOT 13		112 LOT 17			

716,000
2,115,250

2,116,000

SHEET 3

SCALE IN FEE
100 0 100

GRID IS BASED ON NORTH CAROLINA STA

MAPPED BY: BOOTHE CO., INC
PARK AERIAL SURVEYS, INC
MAY 1958

GARNER

35

WAKE COUNTY

25A
2.4AC.

658-65 ②

25
Ⓐ
1.72 AC.

26
Ⓑ
1.9 Ac.

27
Ⓒ
1.9 Ac.

113
①
14.25AC.

122
.85AC.
Ⓓ

28
1.05AC.

29
Ⓔ
1.9 Ac.

30
1.9 Ac.

31
5.8 AC.
MAP 1938-52)

125
.69 AC.

32
6.9 Ac.

DAN DIXON DR.

116
3.31 AC.

117
②
2.98AC.

105
106
107
60
118

36
20 Ac.

38-105A

47
123
121
120
65
66
JEWEL ST.
57
68
69
46
ISLES ST.
45
72
48
38
104
75
76
77
DAPHINE ST.
44
39
79
80
81
82
39A
111
103
ROAD
CREECH
COOK ST.
40A
40
43
59
58
55
56
84
85
86
50
51
88
89
90
91
52
53
54
92
93
94
95
ARELEAN ST.
49
41
42
96
97
98
99
100
101
102
38-149
38-150
38-151
38-152
38-153
38-154
39-3

GARNER, N.C.

SHEET

IEET 38

ALE IN FEET
200 300 400

LINA STATE PLANE COORDINATE SYSTEM

CO., INC., GREENSBORO, N.C.
VEYS, INC., LOUISVILLE, KY.
MAY 1958

SHEET 35

LAST No. 125 35

SHEET 33

716,000

715,000

714,000

713,500
2,108,250

2,109,000

169
.47 AC.

33-77

171
.58AC.

3
1.03AC.

2

36-1
LOT 3

LOT 1

SEE MAP
657-23
LOT 2

LOOP ROAD

17

18

20

24

21

101

101

103

106

23

27

28

25

Road

Road

#74

#80

6

109

172
.34 AC.

8

LOOP

95

M.A.

657-26

#99

657-23

37
LOT A
4 Ac.

38
LOT B
5 Ac.

39
5 Ac.

40
1.98 Ac.

39A

108

104
.52 Ac.

116
2.8 AC.

SHEET 657-681

36

GARNER TOWN LIMITS

681-1

681-4

173
18.37AC.

157
158
159
160
161
162
163
164
124
125
126
137
138
139
140
129
130
131
132
118
136
168
167
166
165
123
122
121
120
119
117
134
127
128
BLK 'D'
135
141
142
143
144
145
146
147
149
BLK 'B'
BLK 'C'

BEICHLER RD.

FOX WOOD DR.

BUCK BRANCH DR.

ROYAL OAK DR.

SHEET 4

GARNER

WAKE COUNTY

SCALE IN FEE
100 0 100

GRID IS BASED ON NORTH CAROLINA STAT

MAPPED BY: BOOTHE CO., INC.
PARK AERIAL SURVEYS, INC.
MAY 1958

SHEET 33

36-10 36-11 36-12 36-13 36-13A 14 36-15 36-16 29 30 32 33 36-34 35 107 89 90 91 36-92 33-68 37-1 37-173 37-174 OLD U.S. HWY. 70 SOUTHERN RAILWAY 36-9 5.66 AC. 172 34 AC. LOOP ROAD 41 4.33 AC. 113 3.44 AC. 112 2.93 AC. 42 17.37 ACRES 212 R/W 15.25 ACRES UTILITY LINE 115 3.31 AC. 114 1.93 AC. 36-110 174 .62 AC. 43 .88 AC. 36-111 BOBBITT STREET 36-44 4 AI AC. 45 1 Ac. WAKE GROVE CEMETERY 36-46 3.67 Ac. ± Total 47A 133 2.09 AC. 46A 49 2.04 Ac. 96 1.94 Ac. NORENE CIRCLE BEICHLER RD. VIRGINIA AVENUE FAYE DRIVE ADRIAN DR. 36-86 LOT 35 .37 Ac. 36-84 LOT 25 U.S. HIGHWAY 70

SHEET 37

SHEET 40

2,111,000

2,111,750

SCALE IN FEET
100 200 300 400

CAROLINA STATE PLANE COORDINATE SYSTEM

IOOTHE CO., INC., GREENSBORO, N.C.
. SURVEYS, INC., LOUISVILLE, KY.
MAY 1958

GARNER, N.C.

SHEET # 36

LAST No. # 114 36

SHEET

716,000

34-86

LOT 19

185
1.31 AC.

184
2.75 AC.

173

176
1.19 AC.

179

34-76

LOT 4

LOT 5

Road

141

OLD U.S. HIGHWAY 70

11
(3 AC.)
LOT 7

LOT 6

13
6.5 Ac
LOT 5

LOT 28

LAKE

715,000

36-111

SHEET 36

BOBBITT STREET

164

160

165

181

187

36-44
4.71 AC.

.5AC.

159

183

36-46

172

145
1.35 AC.

36-46A

178
4.02 AC.

170
1.03AC.

SOUTHERN RAILWAY

AVERSBORO ROAD

36-133

714,000

GARNER Town Limits

LOT 18

15

16

17

18

19

20

21

22

23

24

25

26A

26

27

28

29

30

31

32

LOT 4

LOT 3

LOT 2

LOT 1

PERDUE STREET

41-3

41-2

U.S. HIGHWAY 70

713,500
2,111,750

2,113,000

41

SHEE

SCALE IN
100 0 100

GRID IS BASED ON NORTH CAROLINA


MAPPED BY: BOOTHE CO.,
ARK AERIAL SURVEYS
MAY

37

WAKE COUNTY

GARNER

SHEET 34

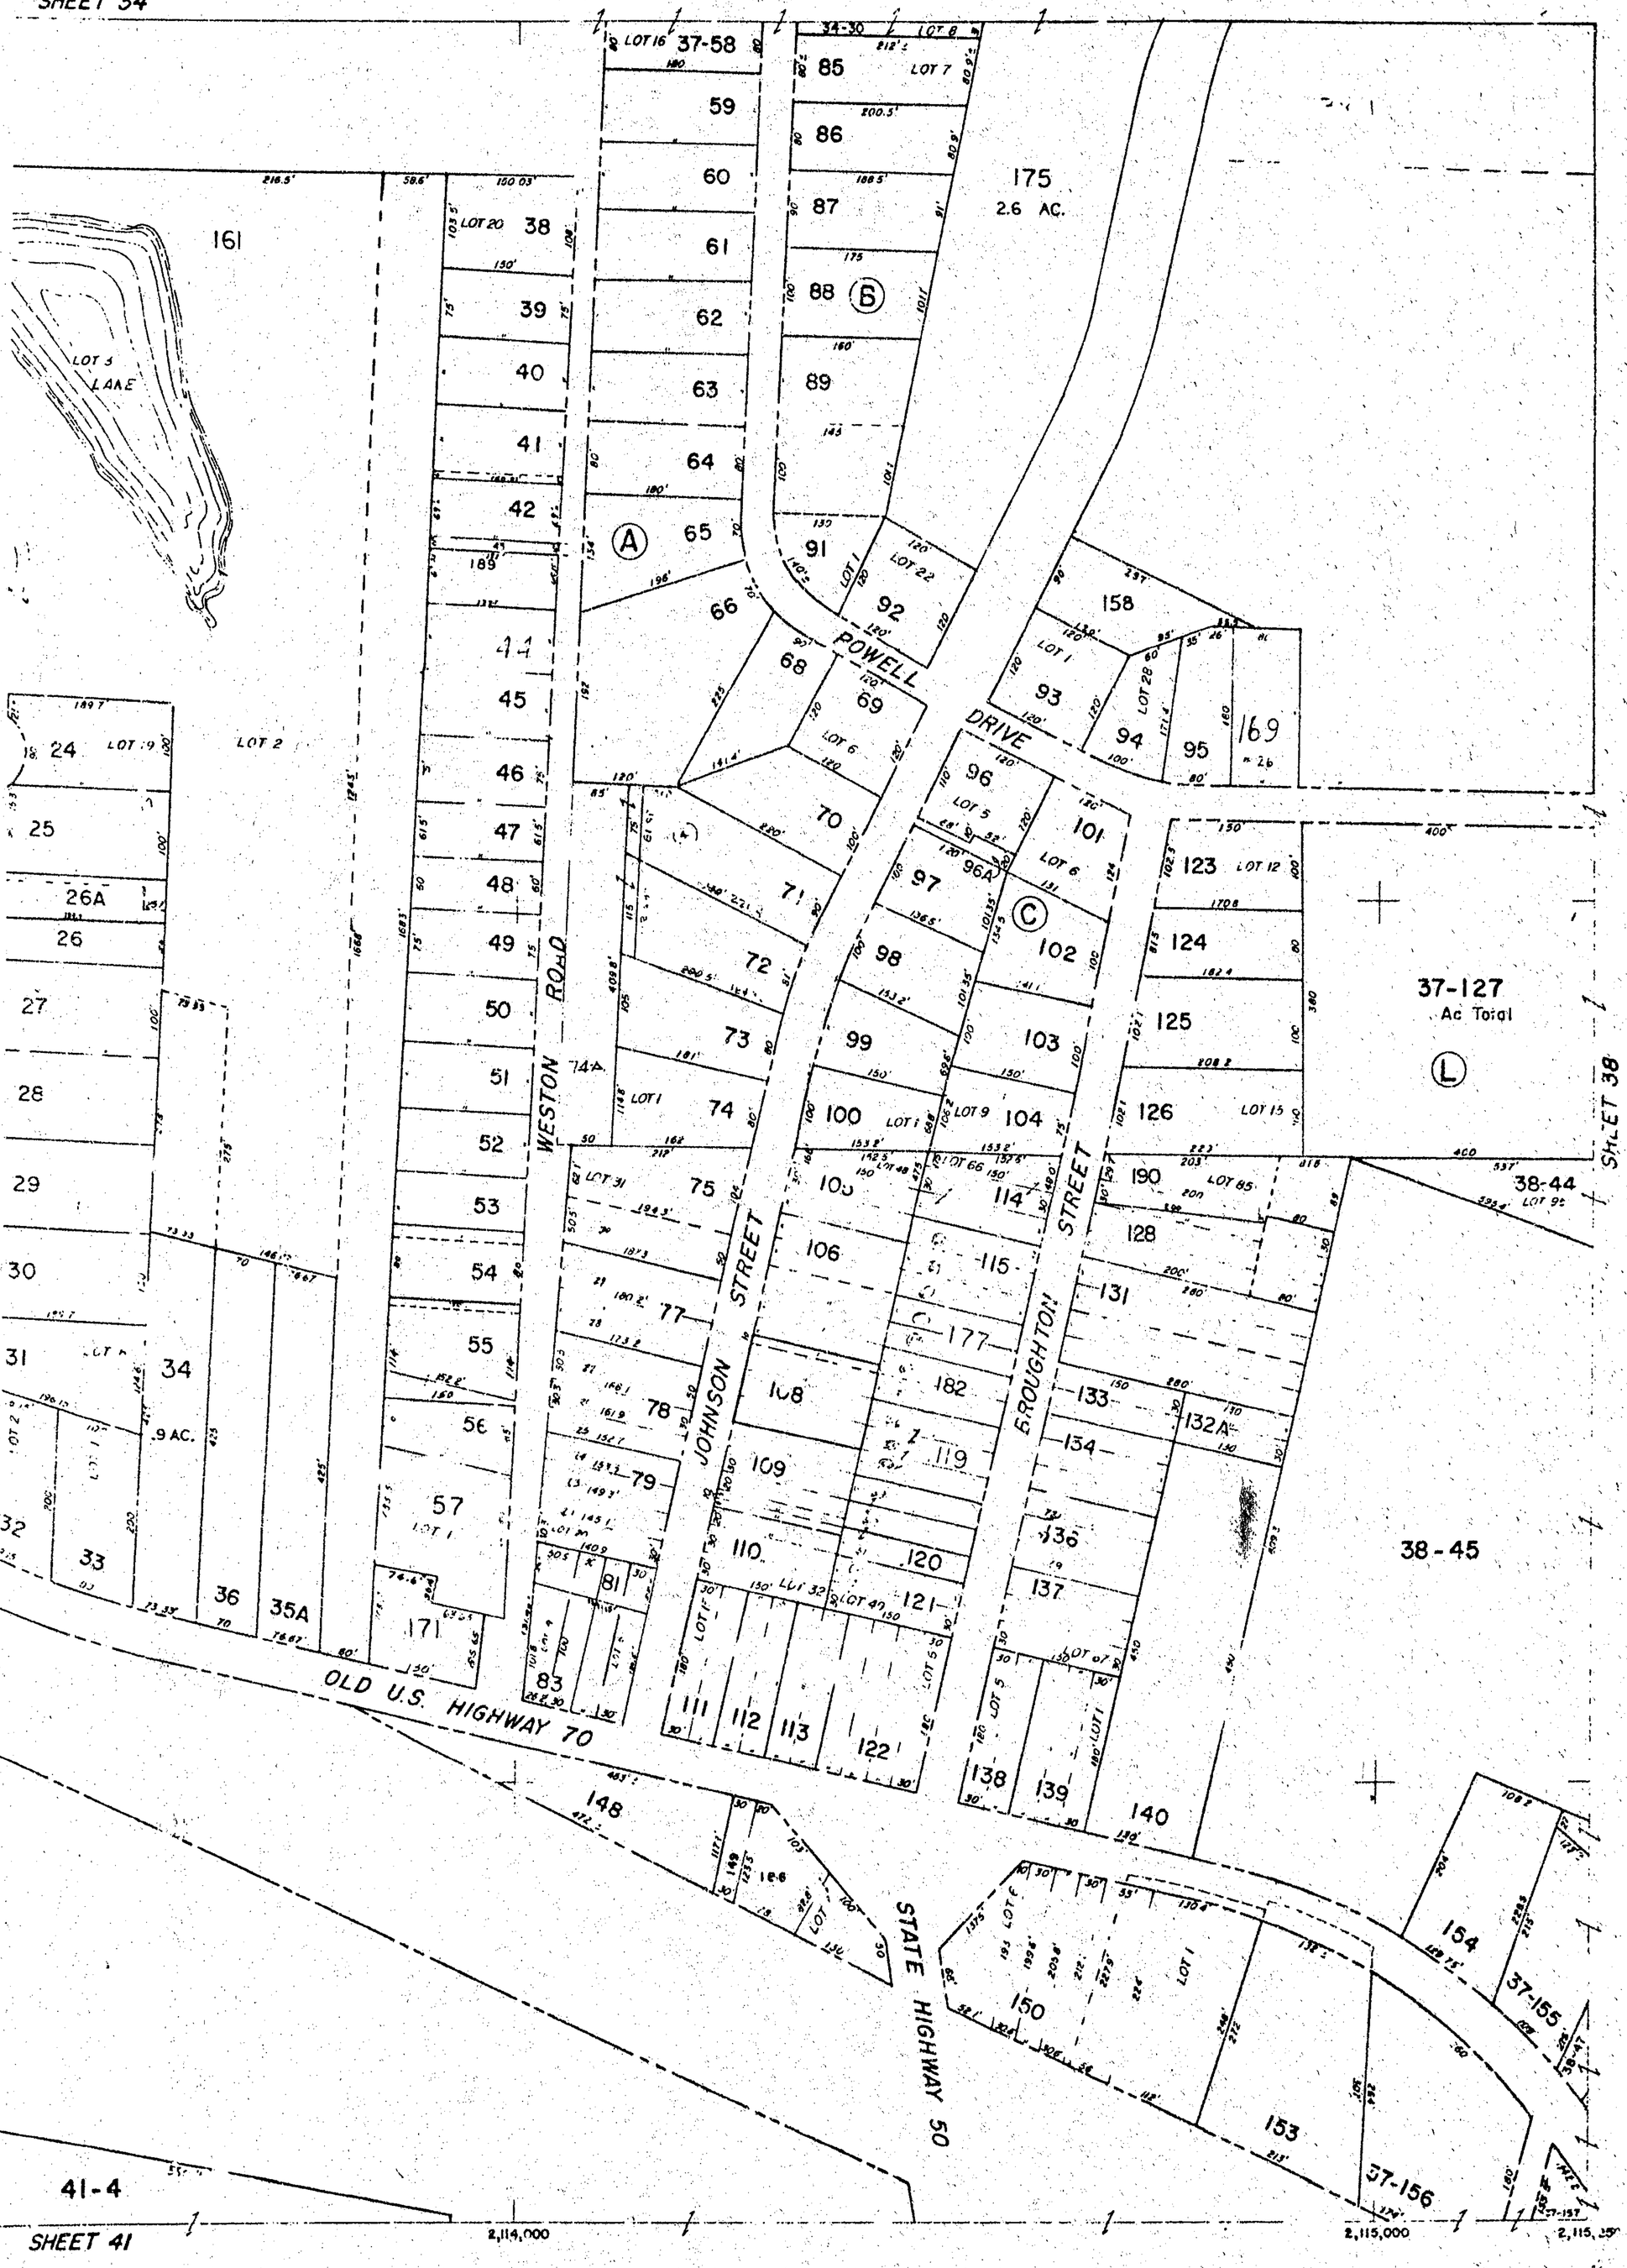

SCALE IN FEET
100 200 300 400

ITH CAROLINA STATE PLANE COORDINATE SYSTEM

: BOOTHE CO., INC., GREENSBORO, N.C.
RIAL SURVEYS, INC., LOUISVILLE, KY.
MAY 1956

GARNER, N.C.

SHEET 37

LAST No. ~~37~~ 37

716,000

















SHEET 37

SHEET 42

713,000

714,000

713,500
2,115,250

2,116,000

SCALE IN FEET
100 0 100 200

GRID IS BASED ON NORTH CAROLINA STATE PLAI

MAPPED BY: BOOTHE CO., INC., GREE
PARK AERIAL SURVEYS, INC., LOUI
MAY 1956

GARNER

SHEET 35

105 A
18 7AC.

105
9.7AC.

106
17.8AC.

117
.4 ACRES

108
.0AC

109

118
3.23AC.

140
E.P. SAULS
1.55 ACRES

136
E.P. SAULS

194
2.23AC.

158
2.0 Ac.

658-66

42-59

38-135

42-57

42-58

43-43

149 150 151 152 153 154

CHARLES ST. CHARLES STREET

143 144 145 146 148

141

LOT 16

LOT 12

LOT 11

LOT 10

LOT 9

LOT 8

LOT 7

LOT 2

120 116 121 128 129 134 130 131 192 122 123 124 132 LOT 3 193

111 112 113 114

PENNY STREET

AVENUE

CREECH RD.

R GARNER TO N UNITED

SHEET 39

SHEET 42

2,118,000

2,118,750

SCALE IN FEET
100 200 300 400

ORTH CAROLINA STATE PLANE COORDINATE SYSTEM

BY: BOOTHE CO., INC., GREENSBORO, N.C.
ERIAL SURVEYS, INC., LOUISVILLE, KY.
MAY 1958

GARNER, N.C.

SHEET 38

LAST NO. 194 38

SHEET

716,000

38-154

3

(166)

CHARLES STREET

658-6

38-148

(168)

735.74'

1

38-108

658-6

LAKE

715,000

SHEET 38

43-16
15.5AC.

43-1A

43-11
W.J. BUFFALOE

43-17
47.45AC.

43-43

LOT #13

LOT #12

LOT #11

LOT #10

34

25

33

24

32

23

714,000

713,500
2,118,750

2,120,000

SHEET 4

SCALE IN FEET
100 0 100 2

GRID IS BASED ON NORTH CAROLINA STATE

MAPPED BY: BOOTHE CO., INC.,
PARK AERIAL SURVEYS, INC.,
MAY 1958

SHEET

658-16

659-15

659-16

LAKE

WHITE OAK ROAD

SHEET

6
3 AC.

7
1 AC.
377.1'

39-2
4 AC.

39-1

39-8
4 AC.

5

1296'

1244'

1234'

1230'

140'

140'

140'

140'

139'

188'

28'

30'

600.7'

220'

2,121,000

2,122,000

2,122,250

SHEET 43

SCALE IN FEET
100 200 300 400

NORTH CAROLINA STATE PLANE COORDINATE SYSTEM

BY: BOOTHE CO., INC., GREENSBORO, N.C.
AERIAL SURVEYS, INC., LOUISVILLE, KY.
MAY 1958

GARNER, N.C.

SHEET 39

LAST No: #8

39

SHEET 36

713,500

713,000

712,000

711,500

2,108,250

2,109,000

681-4

36-173

206
3.9AC.

284
9.87AC.

66
25AC.

ROYAL OAK DR.

BUCK BRANCH DR.

FOREST RIDGE RD.

SPRINGVIEW TRAIL

GLENVIEW CT.

VILLA DR.

BLK. 'A'

BLK. 'E'

BLK. 'F'

BUCKHORN RD.

SPRING DR.

DE VON CT.

ROLLING RIDGE CIRCLE

MANOR DR.

FOREST

VAL DEL

PROPOSED STREET

LAKE

SHEET 44

SHEET 40

GARNER


WAKE COUNTY

SCALE IN FEET

100 0 100 200

GRID IS BASED ON NORTH ... STATE P...

MAPPED BY: B... CO., INC., GR...
PARK AERIAL ...VEYS, INC., L...
MAY 1958

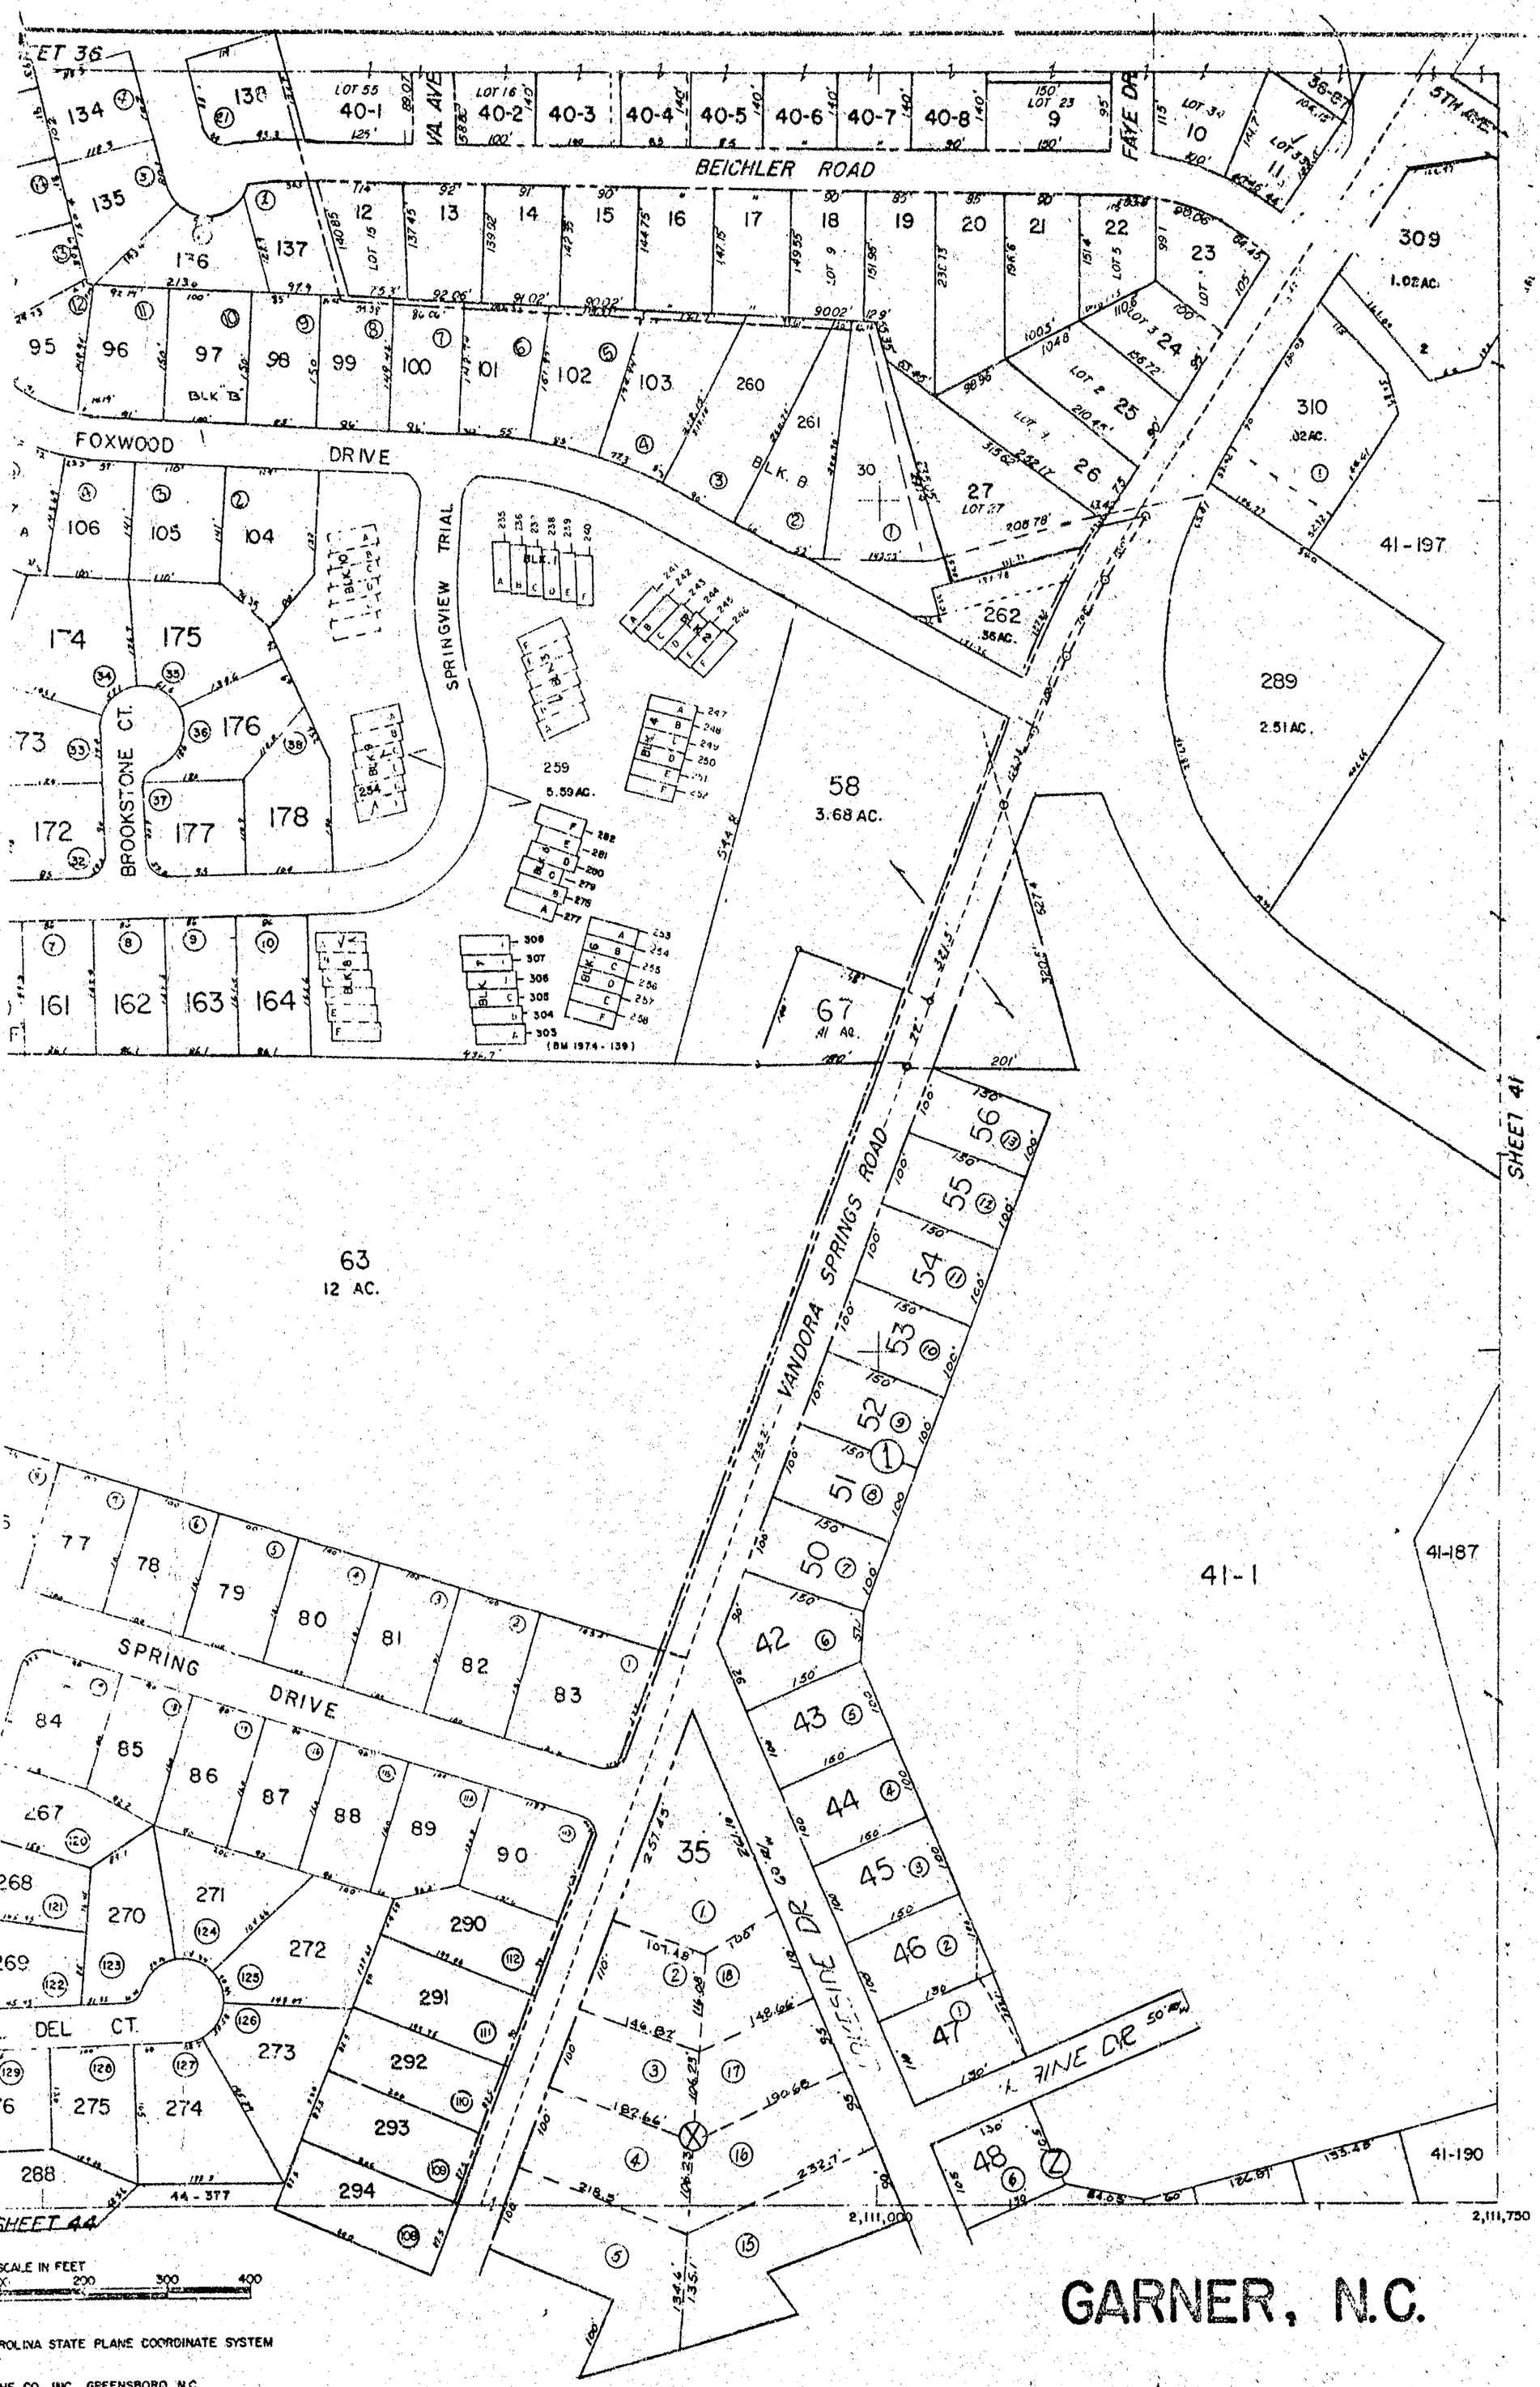

SCALE IN FEET
200 300 400

ROLINA STATE PLANE COORDINATE SYSTEM

HE CO., INC., GREENSBORO, N.C.
URVEYS, INC., LOUISVILLE, KY.
MAY 1958

GARNER, N.C.

SHEET 40

LAST NO. 40

713,500
713,000
712,000
711,000
2,111,750
2,113,000

178 1.14 AC.
197 21.17 AC.
195 2.18 AC.
196 .70 AC.
199 .43 AC.
184 1.40 AC.
192 4.05 AC.
187 7.58 AC.
185 7.5 AC.
191 .6 AC.
200 .43 AC.
164
194
193
183
143A J.L. PERRY
41-2 4 Ac. Total
41-3 21.17 Ac. Total
1 26.85 AC.
6 2.12 A
152 BLOCK 4
143 144 145 146 147 148 149 150 151
153 154 155 156 157
158 159 160 161 162
104 106 102 41-109 41-110 41-111
41-103 41-101 41-100 41-99 41-98 45-22 45-21 45-20
134 136 137 138 139 140 141 142
188 189 190
BLOCK 3 BLOCK 2

5TH AVENUE
AVE. OSBORO ROAD
NORTHWOOD DRIVE
VANDORA AVENUE
FRANCES DR.
C.P.&L. UTILITY EASEMENT 450 ±S
RESERVED
Road

SHEET 40
SHEET 45
GARNER

SCALE IN FEET
100 0 100 200

GRID IS BASED ON NORTH CAROLINA STATE PL

MAPPED BY: BOOTHE CO., INC., GU
PARK AERIAL SURVEYS, INC., LO
MAY 1958

EET 37

41-4
[illegible] Ac. Total

41-3

SOUTHERN RAILWAY

LAKE DRIVE

HILL TOP AVENUE

STATE HIGHWAY 50

ST. MARY'S AVE.

U.S. HIGHWAY 70

UMSTEAD LANE

DURREE STREET

SUNSET DRIVE

BUTLER DRIVE

LAKE

SHEET 42

SHEET 45

2,114,000

2,115,000

2,55,250


SCALE IN FEET
[illegible] 200 300 400

[illegible] STATE PLANE COORDINATE SYSTEM

[illegible] CO., INC., GREENSBORO, N.C.
[illegible] SURVEYS, P.C., LOUISVILLE, KY.
[illegible] 1960

GARNER, N.C.

SHEET 41

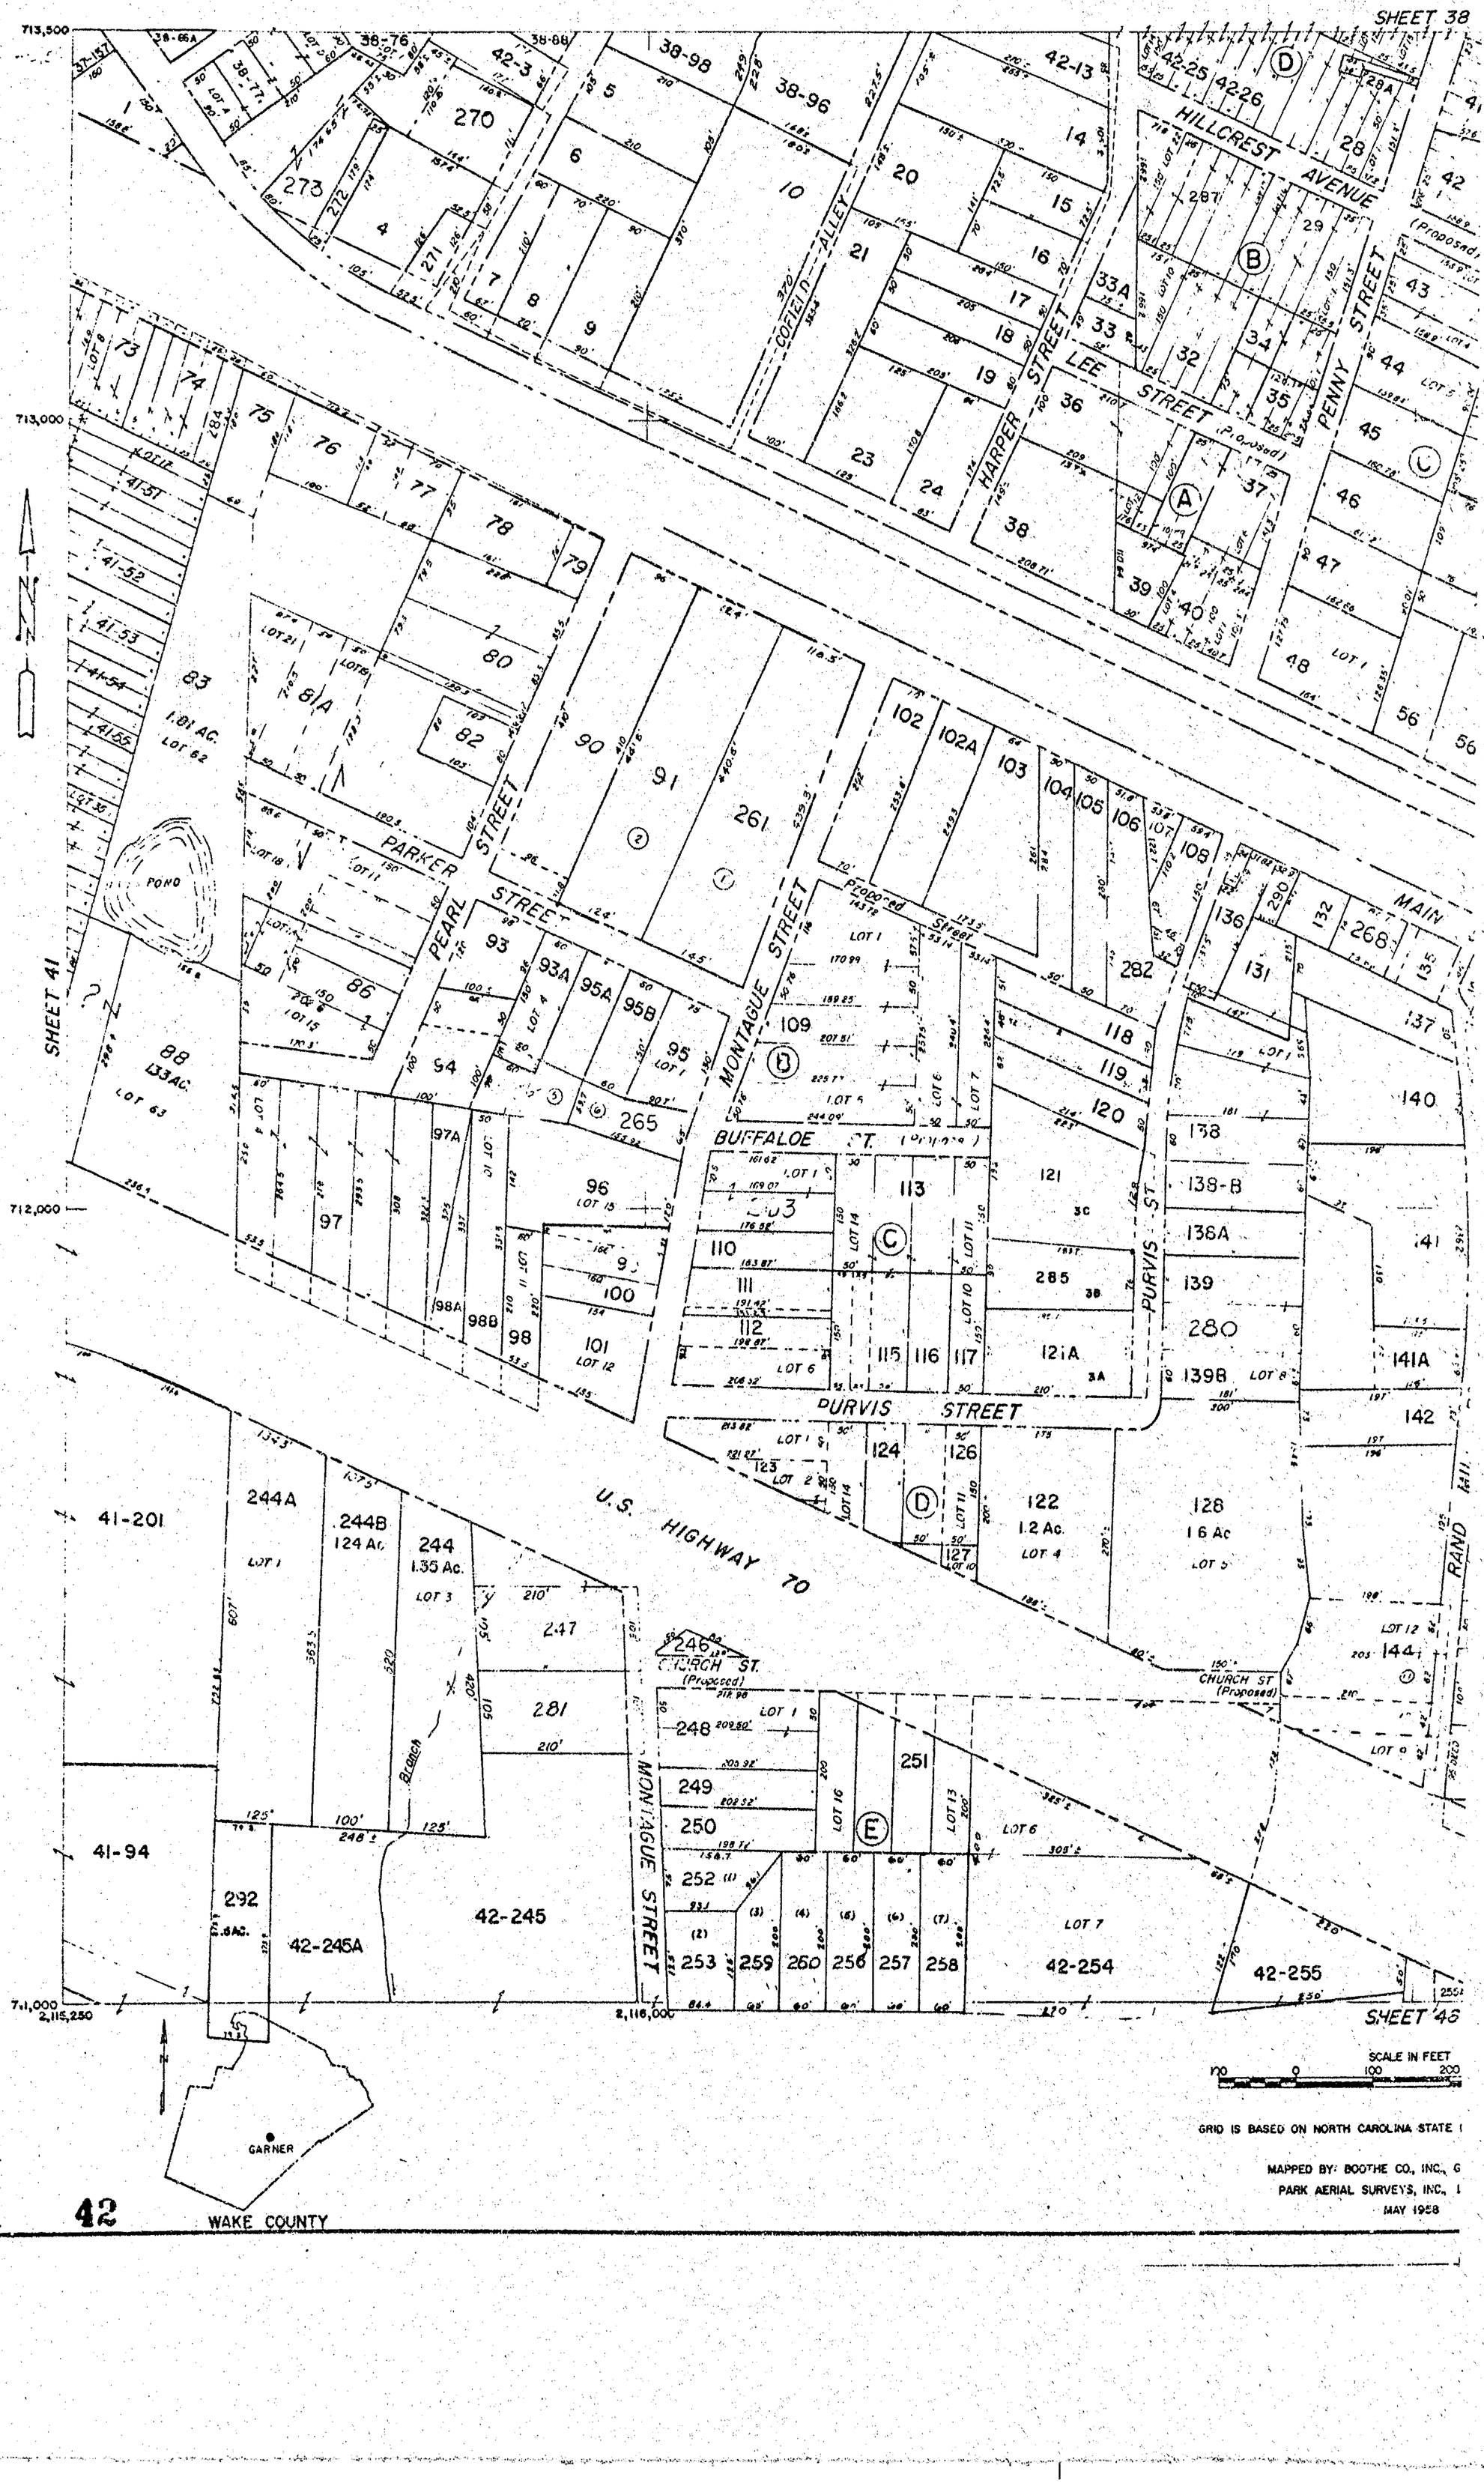

42 WAKE COUNTY

SHEET 38














SHEET 43

SHEET 46

SCALE IN FEET
100 200 300 400

CAROLINA STATE PLANE COORDINATE SYSTEM

XOTHE CO., INC., GREENSBORO, N.C.
SURVEYS, INC., LOUISVILLE, KY.
MAY 1958

GARNER, N.C.

LOT No: 25

SHEET 42

42

SHEE

713,500

713,000

712,000

711,000
2,119,750

2,120,000

SHE

31

22

9

43
9.48 AC.

30

16
15.5 AC.

8

17
47.45 AC.

29

20

7

Road

28

19

6

27 43-13
10 AC.

43-1
16.52 AC.

18

5

26

17

43-2
26.3 Ac. Total

SHEET 42

LOT #4

16

42-72

LOT #3

12
W.J. BUFFALOE

43-6

15

LOT #2

14

LOT #1

23

7

OLD U.S. HIGHWAY 70

SOUTHERN RAILWAY

8

9

OLD RALEIGH - CLAYTON RD

46-40

47-1

47-2

10
2.25 Ac

Road

Road

Road

391'

187'

105'

233'

814'

450'

329.01'

368.03'

859'

320'

500'

210'

125'

228'

810'

180'

SCAL
100 0 100

GRID IS BASED ON NORTH CAROL

MAPPED BY: BOOTHE
PARK AERIAL SURV
M

GARNER

43

WAKE COUNTY

SHEET 39

43-4
27.75 AC.

3
12.5 Ac.

18
7.25 AC.

5
16.08 AC.

26
.57 AC.

47-3


47-4
.9 Ac.

47-5


47-6

19 · 41 · 27 · STREET · 28 · 29 · 24 · 21 · 25 · 30 · 31 · 32 · 33 · 34 · STREET · 35 · 22 · 20 · 14 · 15 · 36 · 37 · 38 · 42 · 39 · 40

625'
2830'
2320'
2430'
1400'
1320'
1980'
1400'
1400'
1400

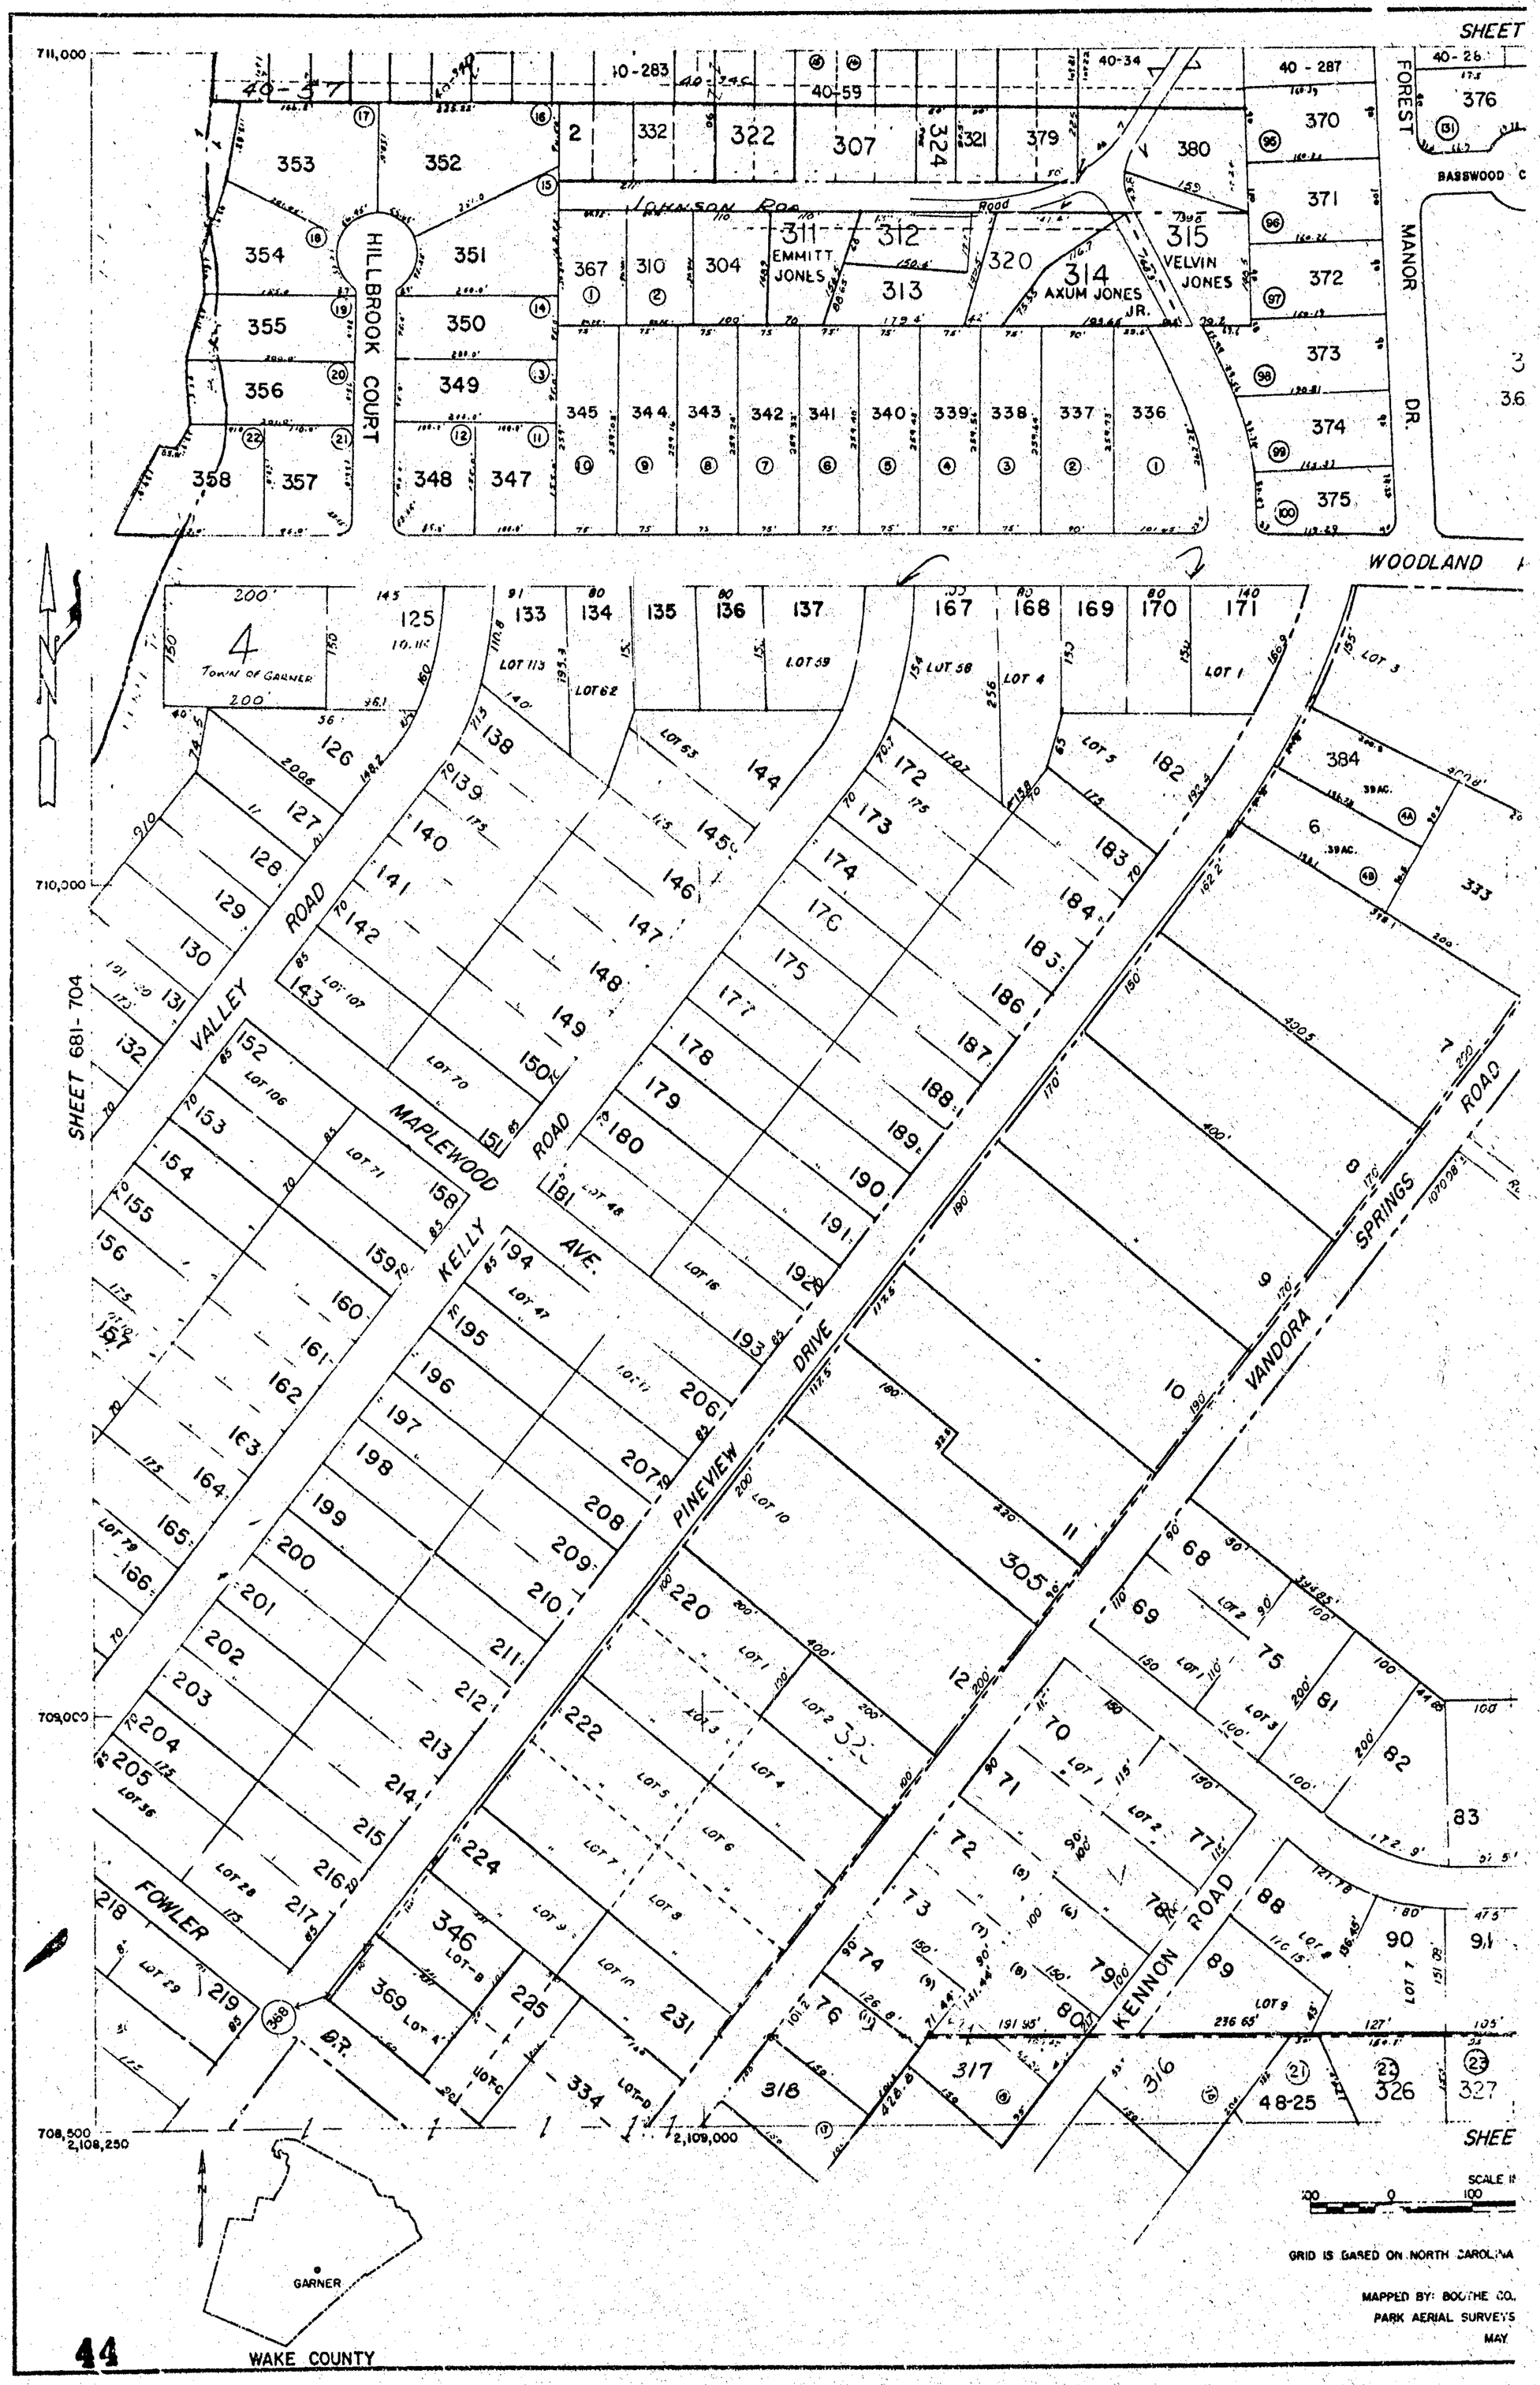
SHEET
711,000
40-37
40-283
40-59
40-34
40 - 287
40-26
376
FOREST
MANOR
DR.
BASSWOOD C
JOHNSON ROAD
Road
HILLBROOK COURT
353
352
354
351
355
350
356
349
358
357
348
347
2
332
322
307
324
321
379
380
370
371
372
373
374
375
367
310
304
311
EMMITT JONES
312
313
320
314
AXUM JONES JR.
315
VELVIN JONES
345
344
343
342
341
340
339
338
337
336
WOODLAND
4
TOWN OF GARNER
125
126
127
128
129
130
131
132
133
134
135
136
137
LOT 113
LOT 62
LOT 63
LOT 59
144
138
139
140
141
142
143
LOT 107
145
146
147
148
149
150
LOT 70
151
152
LOT 106
153
154
155
156
157
158
159
160
161
162
163
164
165
LOT 79
166
167
168
169
170
171
LOT 58
LOT 4
LOT 1
LOT 3
LOT 5
172
173
174
176
175
177
178
179
180
181
LOT 46
182
183
184
185
186
187
188
189
190
191
192
LOT 16
193
194
LOT 47
LOT 17
195
196
197
198
199
200
201
202
203
204
205
LOT 36
206
207
208
209
210
211
212
213
214
215
216
LOT 28
217
218
LOT 29
219
220
LOT 1
LOT 2
LOT 3
LOT 4
222
LOT 5
LOT 6
LOT 7
LOT 8
224
LOT 9
346
LOT-B
369
LOT A
225
LOT-C
LOT-D
231
334
368
D.T.
384
39 AC.
6
333
7
8
9
10
11
305
12
68
69
LOT 2
LOT 1
75
61
82
83
70
LOT 1
71
72
73
74
LOT 2
77
78
79
80
88
89
LOT 9
90
91
LOT 7
48-25
316
317
318
326
327
KELLY AVE.
MAPLEWOOD
VALLEY
ROAD
PINEVIEW
DRIVE
VANDORA
SPRINGS
KENNON
710,000
709,000
708,500
2,108,250
2,109,000
SHEE
SCALE IN
100 0 100
GRID IS BASED ON NORTH CAROLINA
MAPPED BY: BOOTHE CO.
PARK AERIAL SURVEYS
MAY
GARNER
WAKE COUNTY
44

GARNER, N.C.

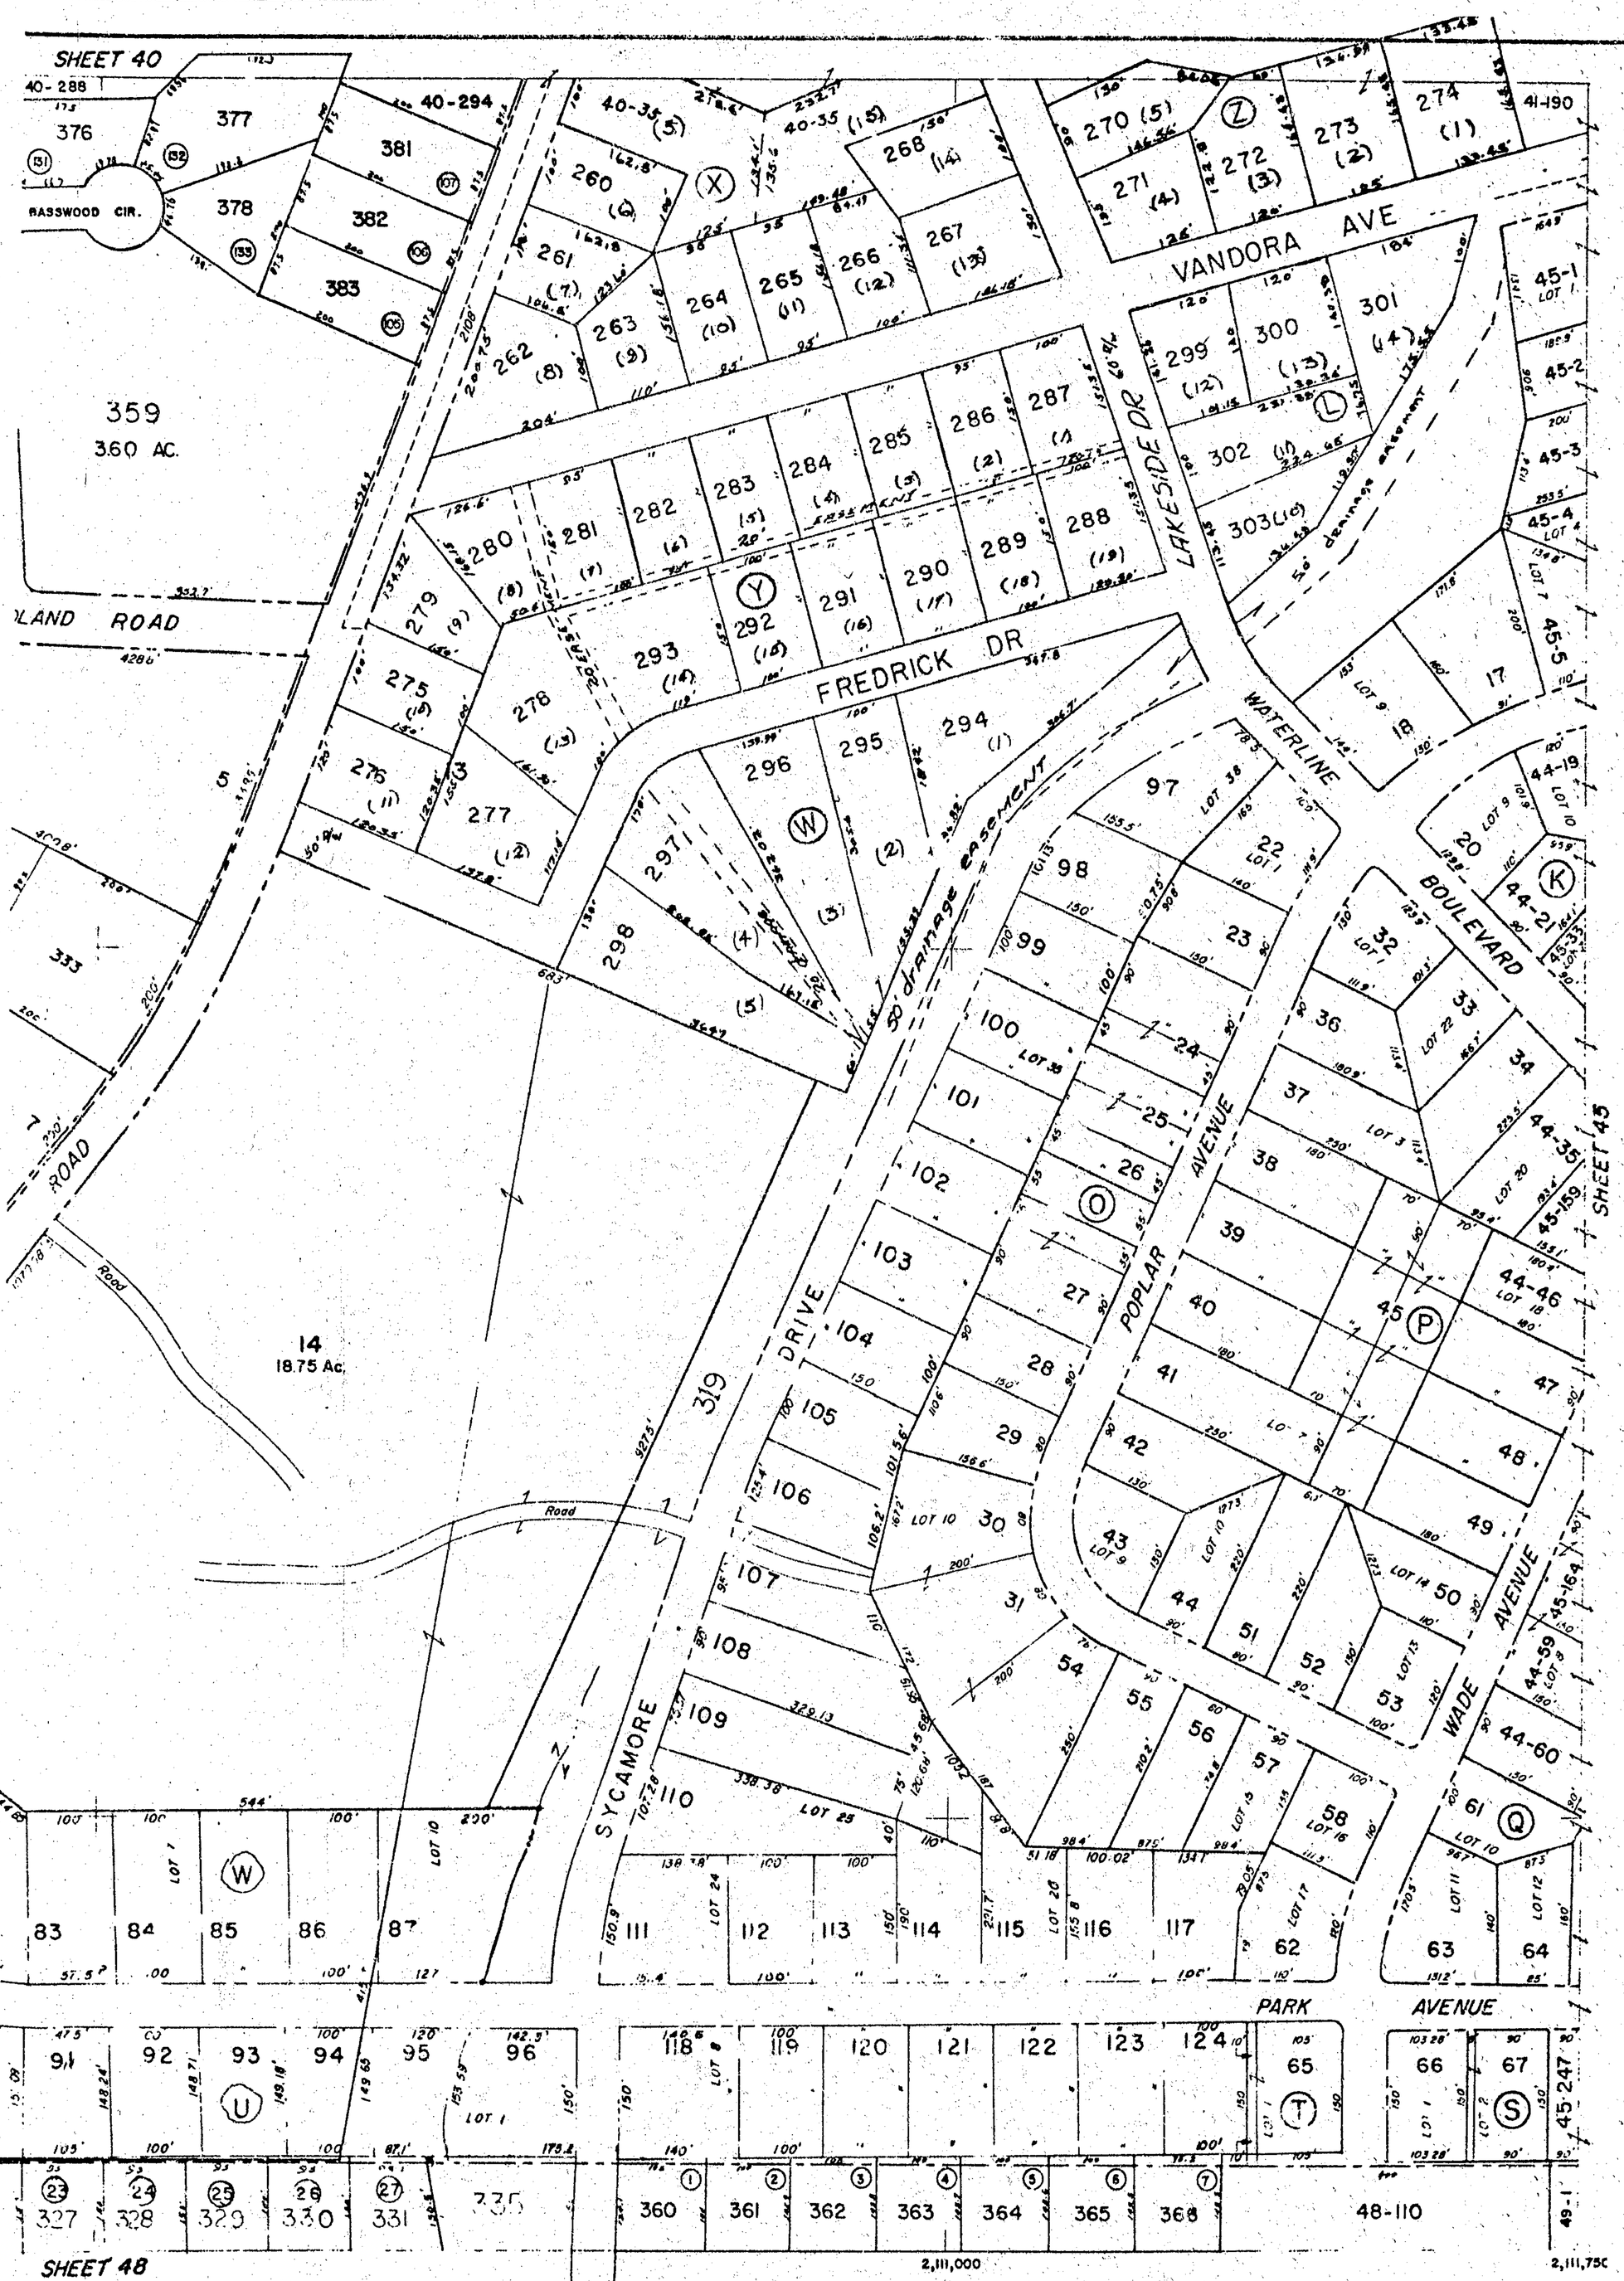


SCALE IN FEET
100 200 300 400


ORTH CAROLINA STATE PLANE COORDINATE SYSTEM

BY: BOOTHE CO., INC., GREENSBORO, N.C.
ERIAL SURVEYS, INC., LOUISVILLE, KY.
MAY 1958

SHEET 44

LAST NO. 38
44

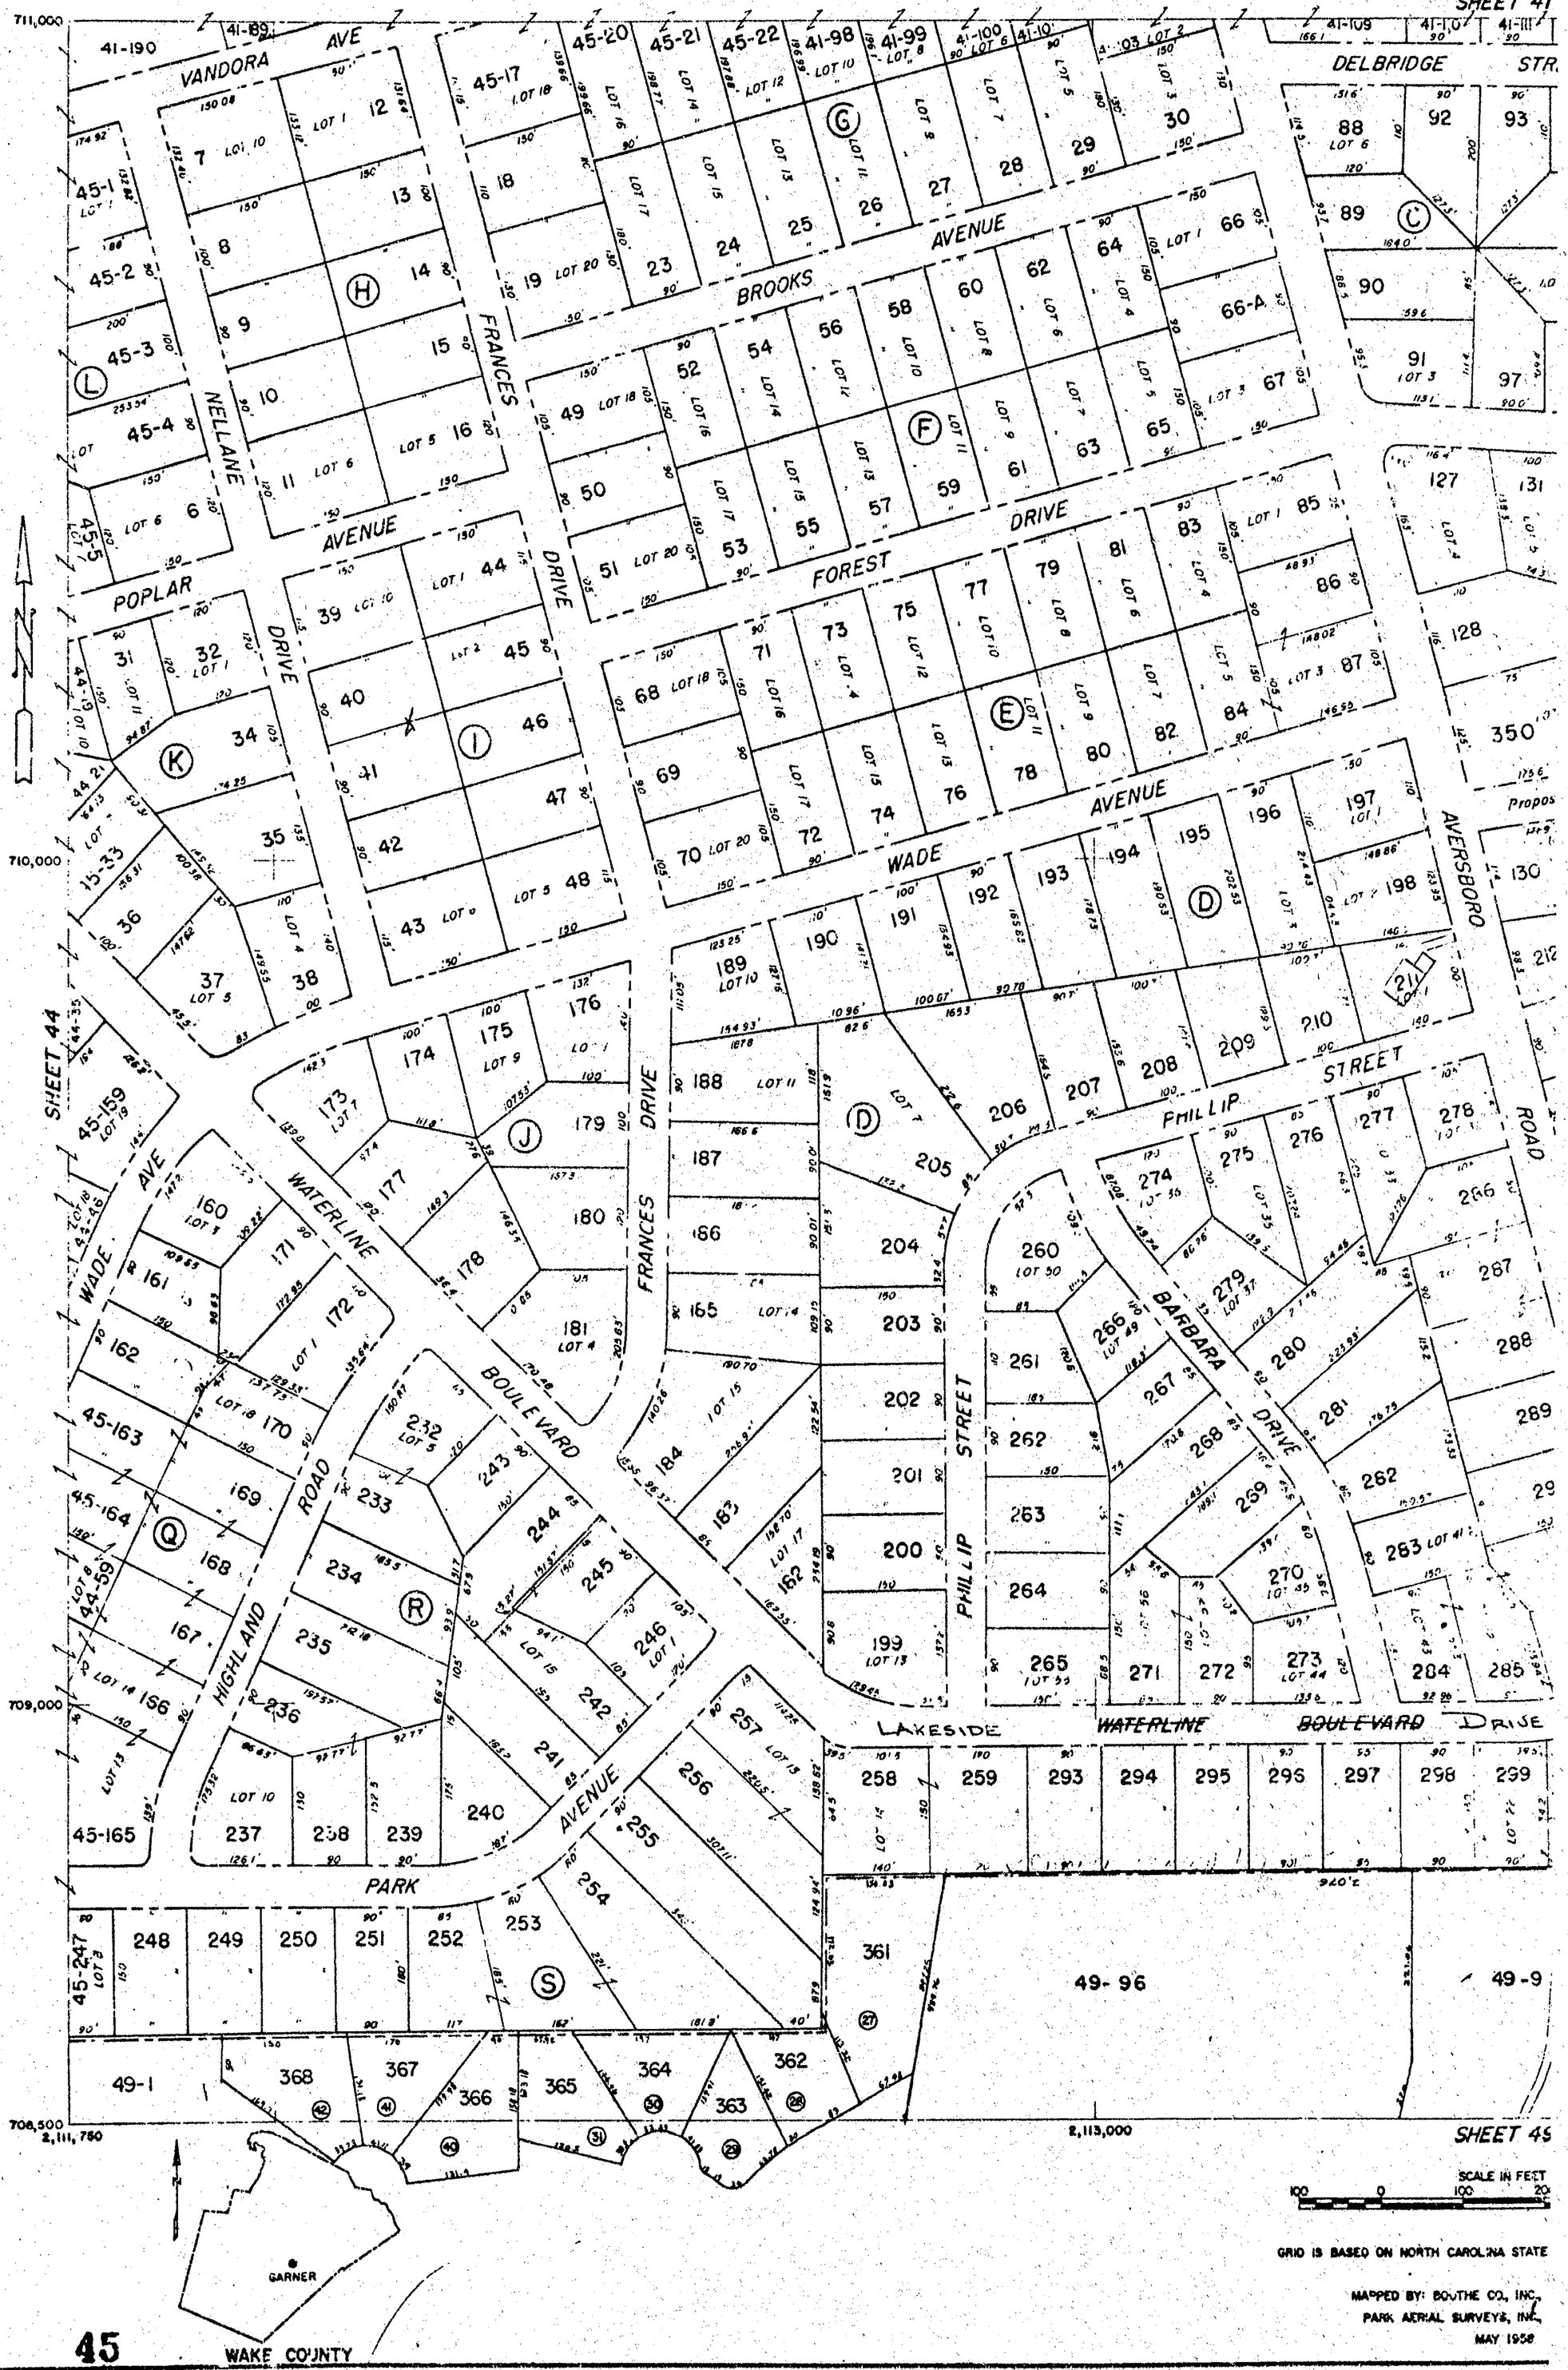
SHEET 41
711,000
41-190
41-89
VANDORA AVE
45-17
45-20
45-21
45-22
41-98
41-99
41-100
41-101
41-103 LOT 2
41-109
41-110
41-111
DELBRIDGE STR
45-1
45-2
45-3
45-4
NELLANE
FRANCES
BROOKS AVENUE
DRIVE
POPLAR AVENUE
FOREST DRIVE
WADE AVENUE
AVERSBORO ROAD
PHILLIP STREET
BARBARA DRIVE
WATERLINE BOULEVARD
HIGHLAND ROAD
LAKESIDE WATERLINE BOULEVARD DRIVE
PARK AVENUE
SHEET 44
SHEET 49
710,000
709,000
708,500
2,111,750
2,113,000
GARNER
SCALE IN FEET
100 0 100 200
GRID IS BASED ON NORTH CAROLINA STATE
MAPPED BY: SOUTHE CO., INC.,
PARK AERIAL SURVEYS, INC.,
MAY 1958
45
WAKE COUNTY

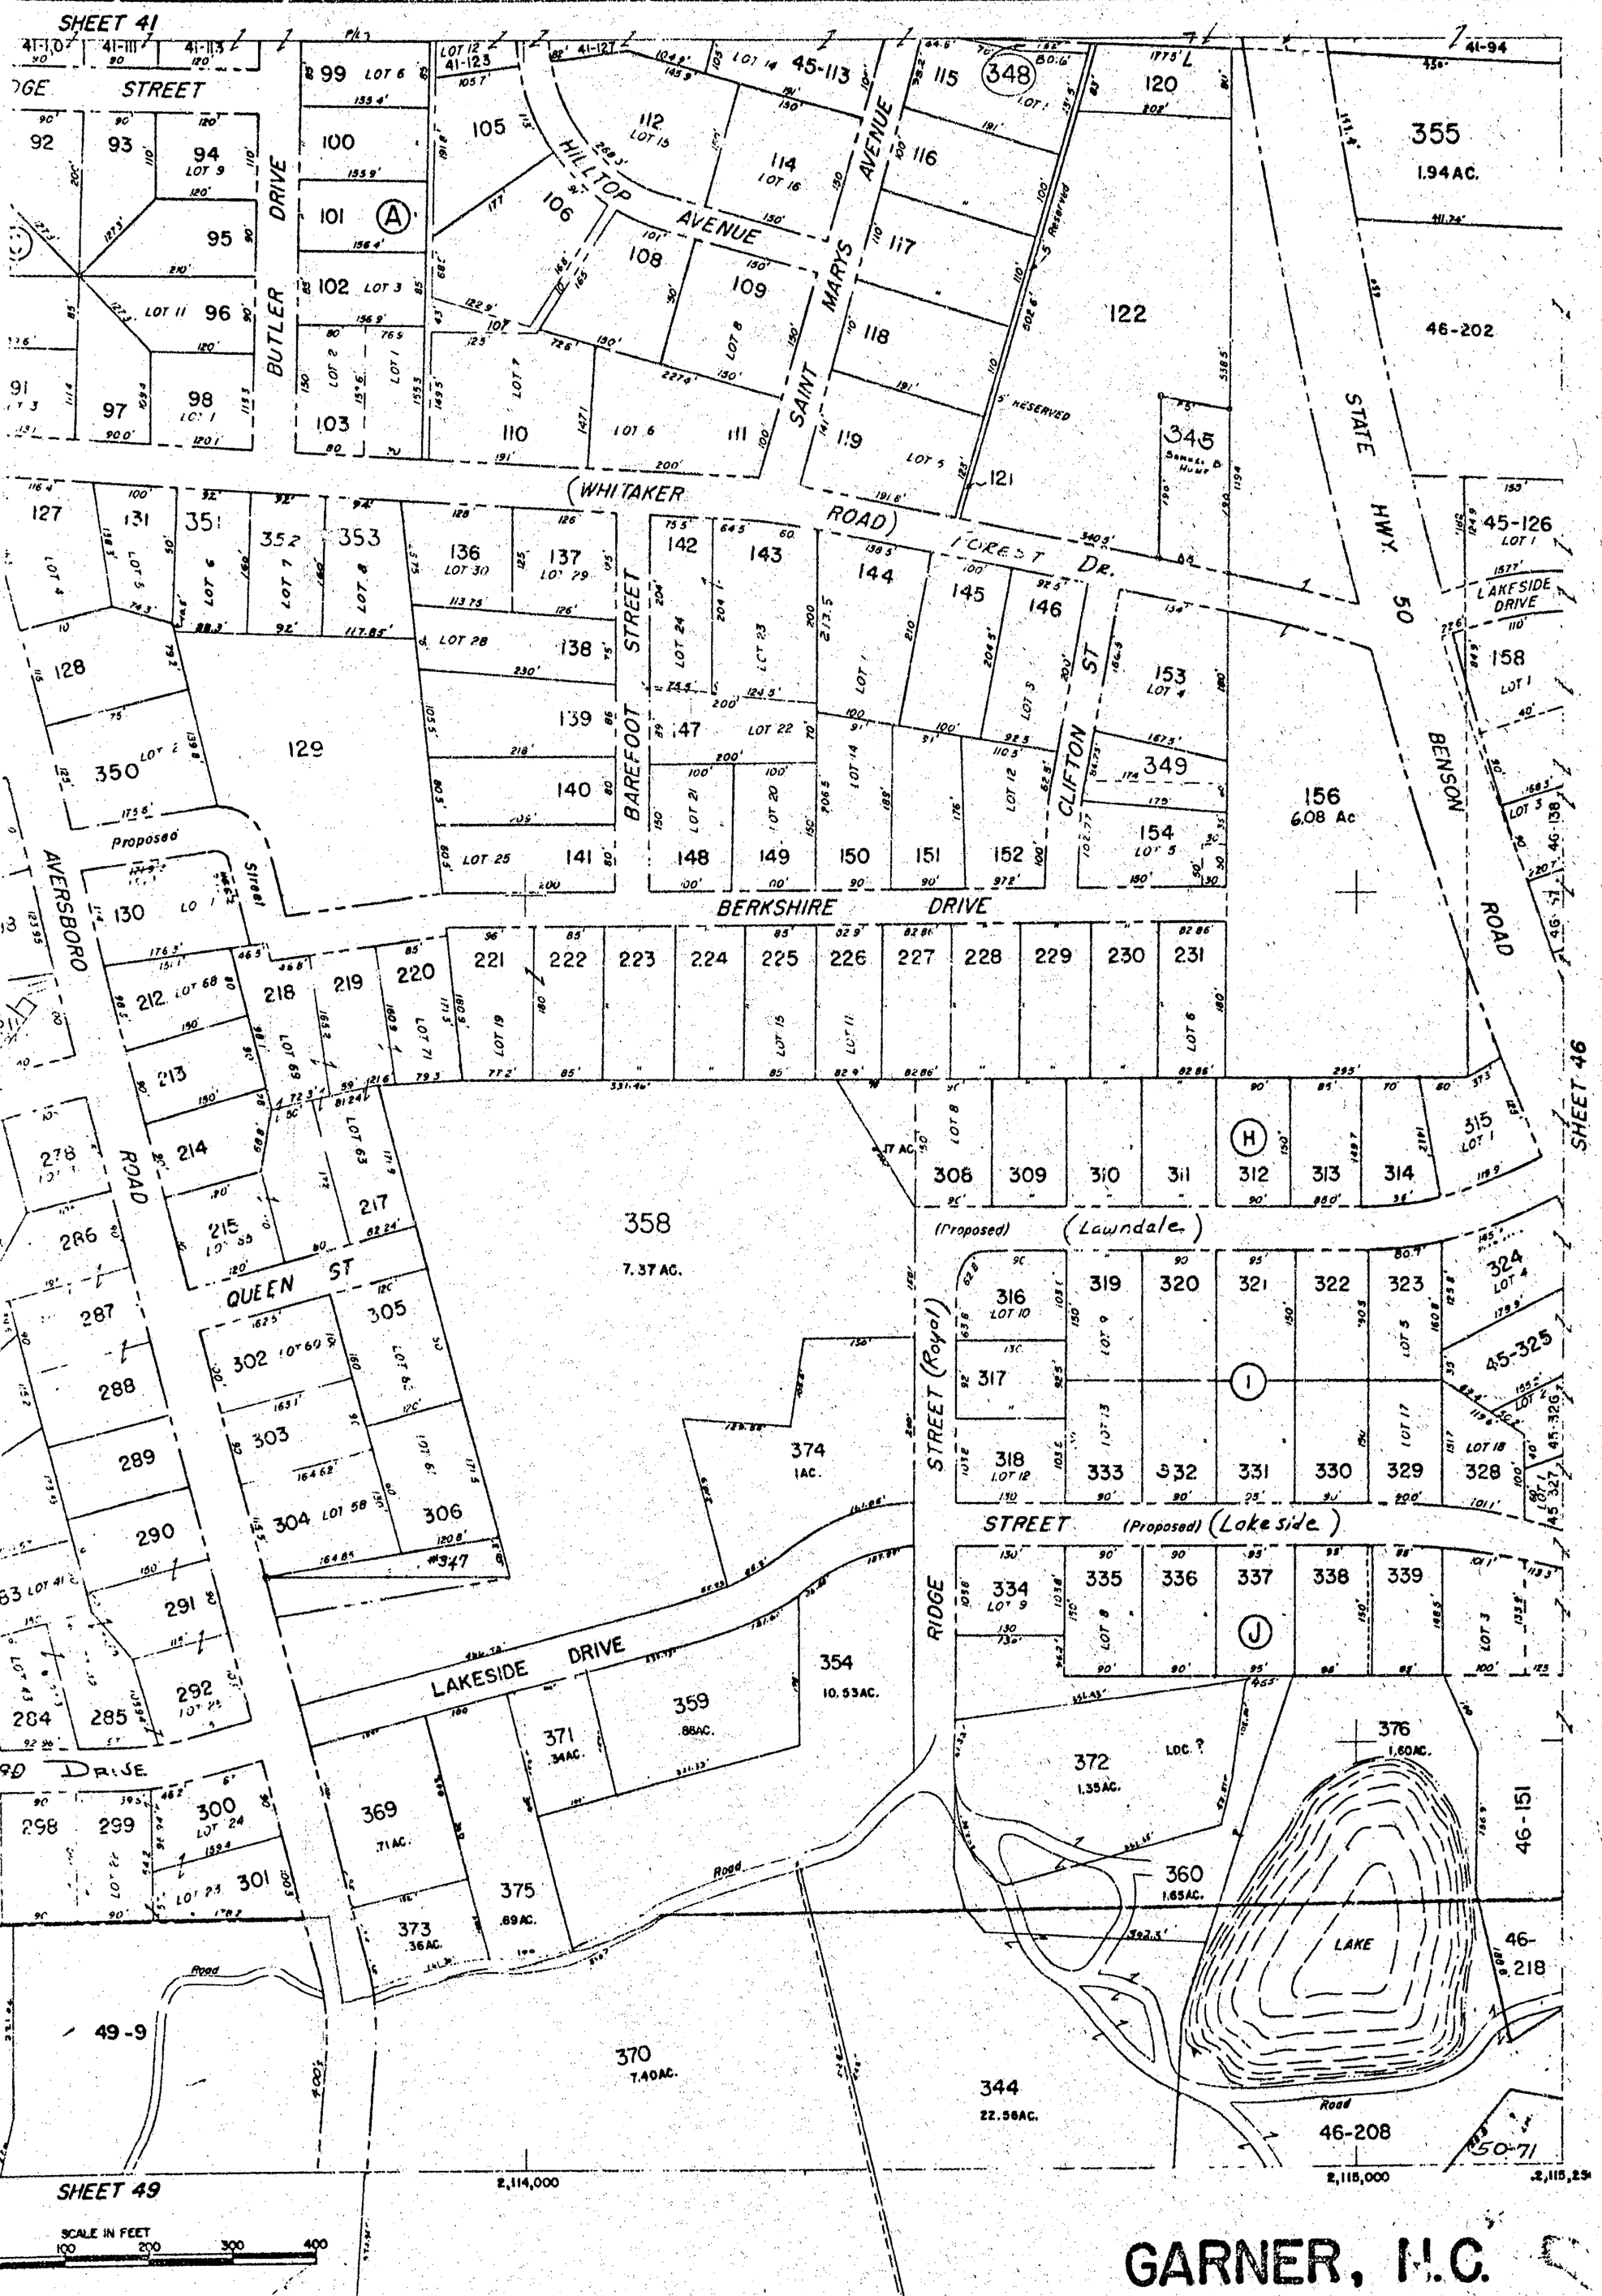
SHEET 41
STREET
BUTLER DRIVE
HILLTOP AVENUE
SAINT MARYS AVENUE
(WHITAKER ROAD)
Forest Dr.
STATE HWY. 50
BENSON ROAD
BAREFOOT STREET
CLIFTON ST
BERKSHIRE DRIVE
AVERSBORO ROAD
QUEEN ST
LAKESIDE DRIVE
STREET (Royal)
RIDGE STREET (Proposed) (Lakeside)
(Proposed) (Lawndale)
LAKESIDE DRIVE
LAKESIDE DRIVE
LAKE
Road
Proposed Street
SHEET 46
SHEET 49
SCALE IN FEET
100 200 300 400
NORTH CAROLINA STATE PLANE COORDINATE SYSTEM
D BY: BOOTHE CO, INC., GREENSBORO, N.C.
(AERIAL SURVEYS, INC., LOUISVILLE, KY.
MAY 1958
GARNER, N.C.
DISTRICT 43
Lot # 316
45

711,000

41-94 | 42-294 | 42-245A | 42-245

HAYWOOD STREET

45 - 355

202
11.59 AC.

204
4.5 AC.

207

197

10A | 10 | 10B

8 LOT 7 | 9 LOT 6 | 3 LOT 5 | 4 | 5 | 6 | 7 LOT 1

13 | 14 | 15 | 16 | 17 | 42 3.15 AC. | 43 | 44 ① | 45 ② | 46 | 47 | 48

12

SPRINGS VALLEY

45-126

LAKESIDE DRIVE

109 LOT 17 | 110 | 111 | 112 | 113 | 114 | 115 | 116 | 117 | 118 | 119 | 120 | 121 | 122 | 123 | 124 | 125 | 126 | 127 | 128 | 129 | 130 | 131 LOT 10 | 132 LOT 9 | 133 | 134 | 135 LOT 6 | 136 | 137

45-158 LOT 2 | LOT 15

46-138 LOT 3

45-325 | 45-326 | 45-327 LOT 1

LAWNDALE STREET

139 LOT 1 | 140 | 141 | 142 LOT 4 | 143 | 144 | 145 | 146 | 147 LOT 9 | 148 | 149 | 150 LOT 12

147 LOT 9

Ⓓ | Ⓔ | Ⓒ

STATE HWY 50

SHEET 45

C P & L UTILITY EASEMENT

1
3.1 AC. ±

192
13.5 AC.

196
1.91 AC.

49
4.09 AC.

LAKE | LAKE | LAKE

153
1 AC.

154
16.5 AC.

151
3.39 AC.

218
.63 AC.

208
13.40 AC.

Dirt Road

709,000

708,500

2,115,000

2,116,000

50-3

50-71

SHEET 5


SCALE IN FEET
100 0 100 2

GRID IS BASED ON NORTH CAROLINA STATE

MAPPED BY BOOTHE CO., INC.,
PARK AERIAL SURVEYS, INC.,
MAY 1958

GARNER

46 WAKE COUNTY

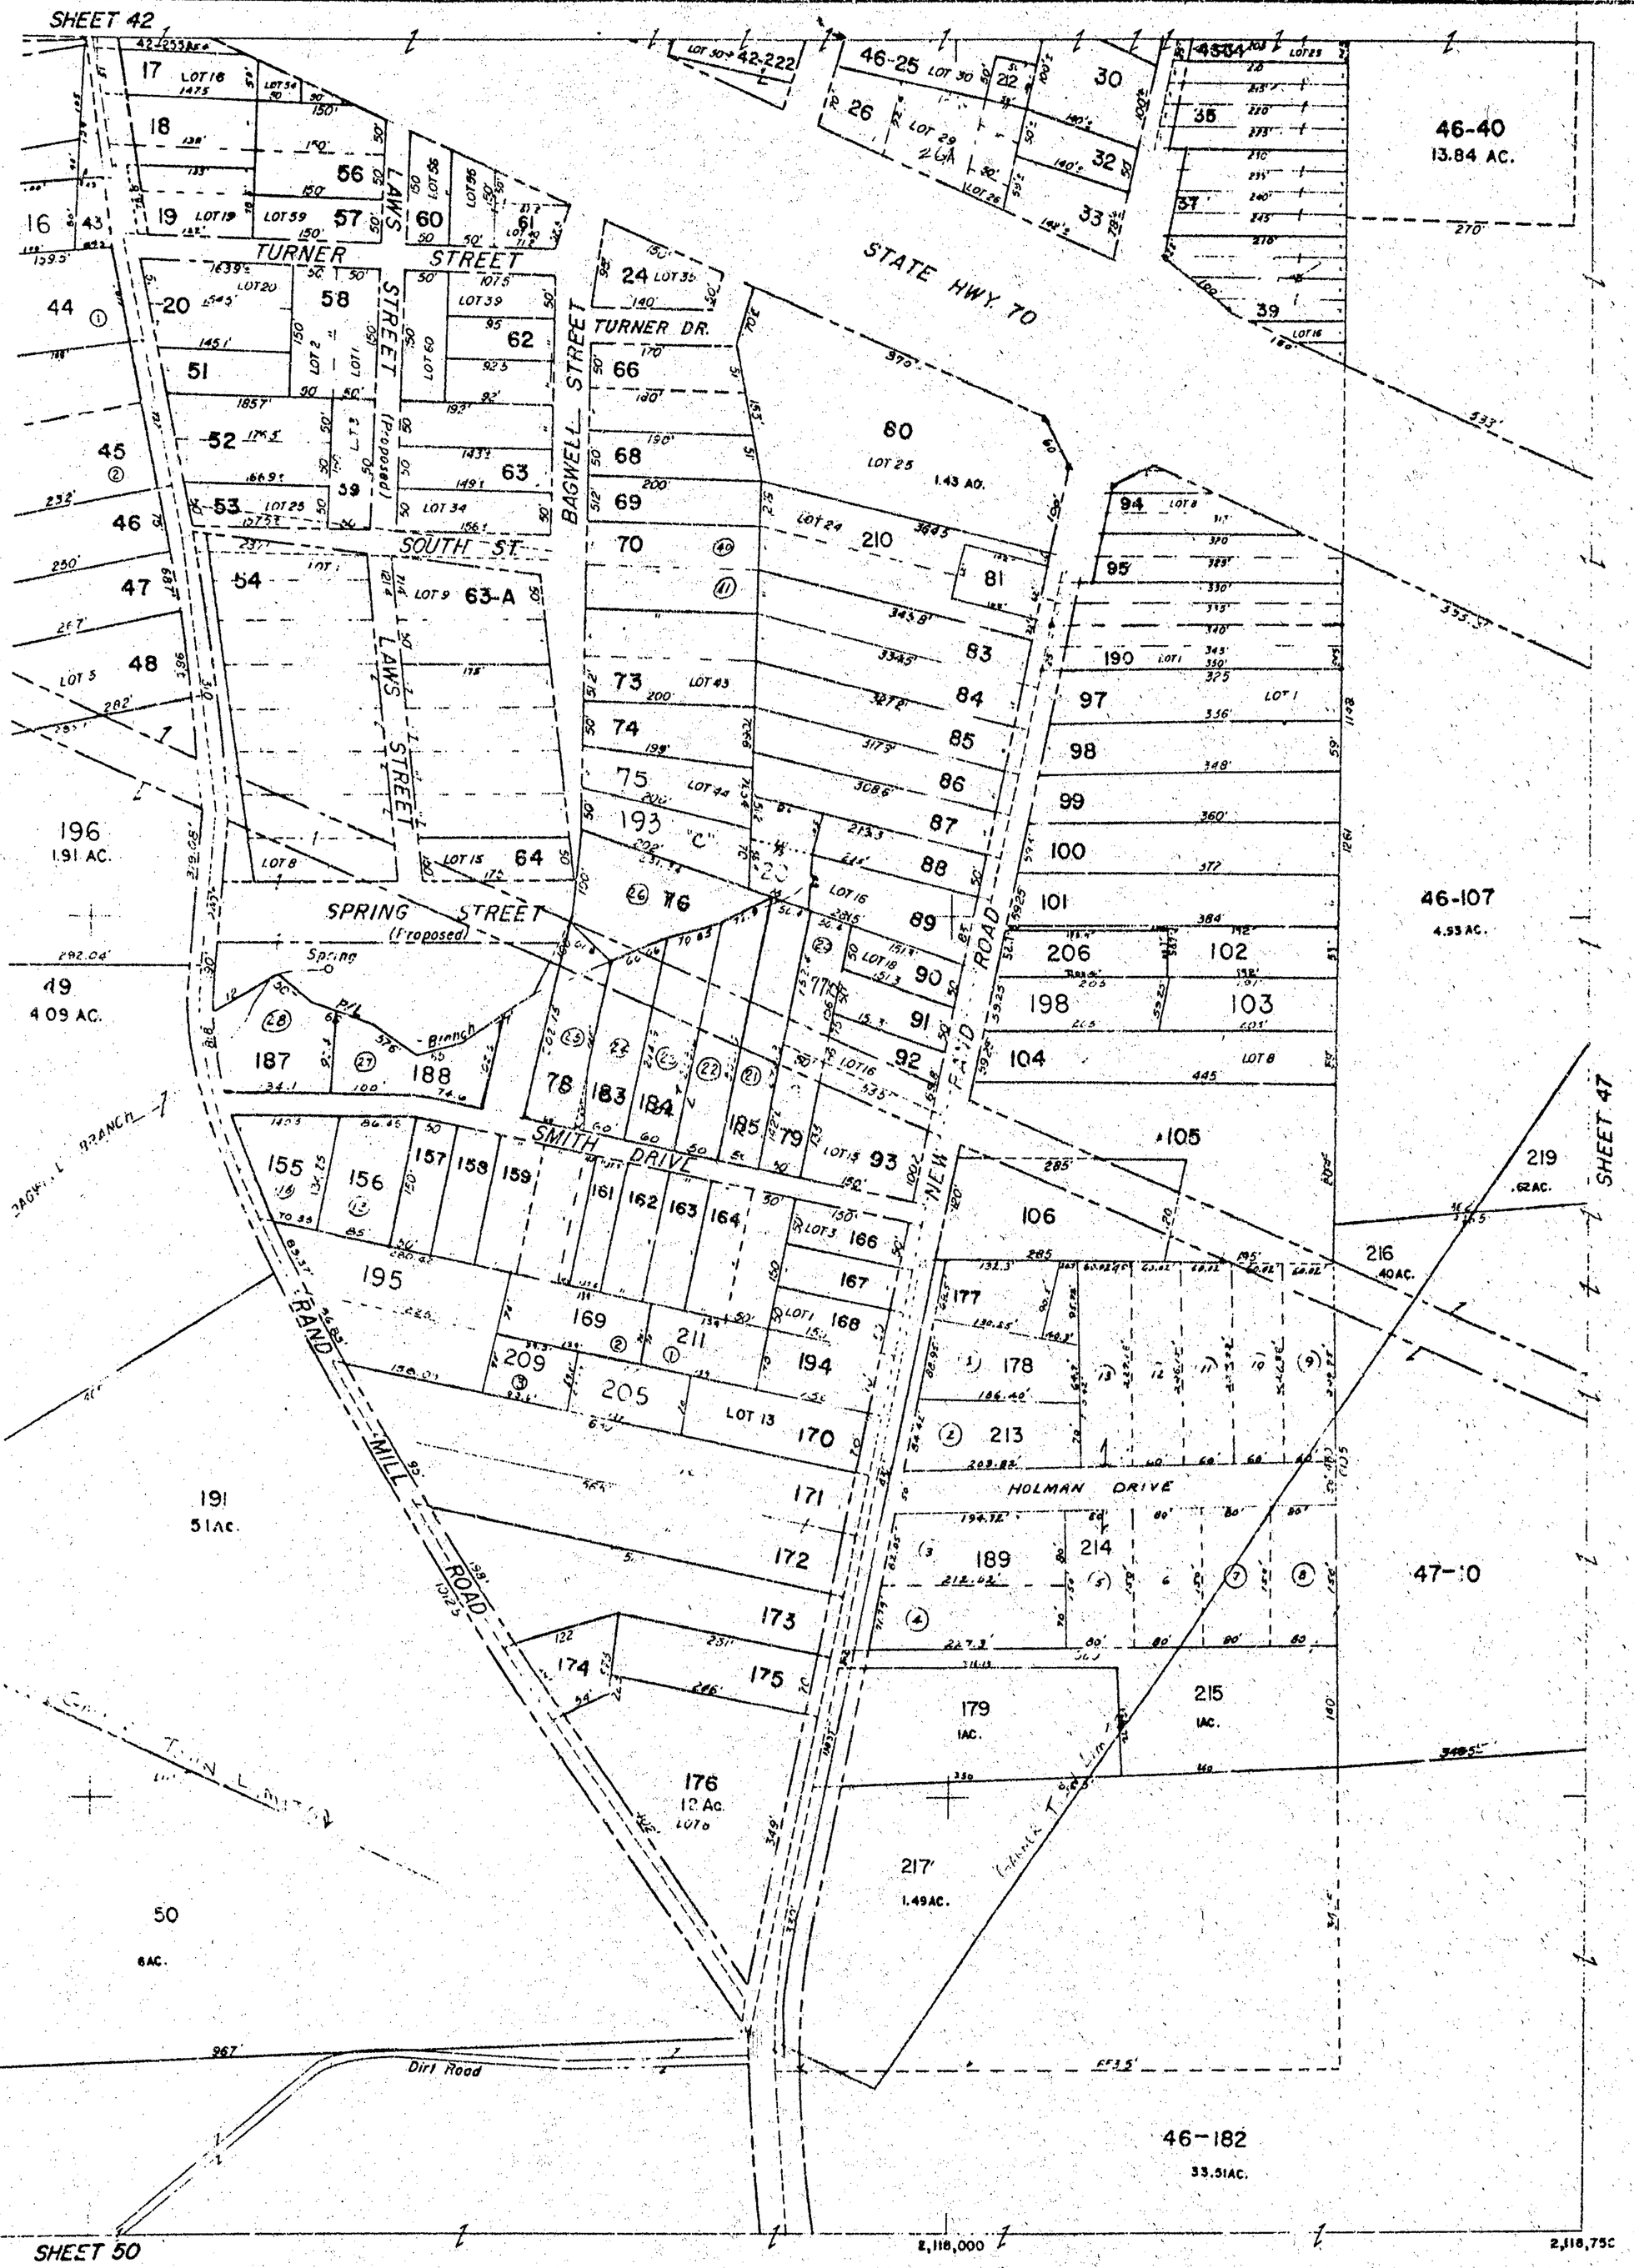
SHEET 42
TURNER STREET
LAWS STREET
BAGWELL STREET
STATE HWY. 70
TURNER DR.
SOUTH ST.
SPRING STREET (Proposed)
SMITH DRIVE
MILL ROAD
NEW RAND ROAD
HOLMAN DRIVE
Spring Branch
Dirt Road
46-40 13.84 AC.
46-107 4.93 AC.
47-10
46-182 33.51AC.
SHEET 47
SHEET 50
SCALE IN FEET 100 200 300 400
GARNER, N.C.
SHEET 46
Sheet No 219 46

SHEET 43

711,000

46-40

47-1
8.35 Ac.

55
3.44AC.

47-2
6.76AC.

43-10

16
2.25 Ac.

47-3
16.82 AC.

49
0.37 AC.

53
1.78 AC.

54
61 AC.

68

67
1.57AC.

57
2.70 AC.

46-107

710,000

46-219

SHEET 46

9
5.87AC.

10
9.304C.

15
17.2 Ac.

Pond

46-182

6
20 AC.

709,000

708,500
2,118,750

2,120,000

CP&L UTILITY EASEMENT

U.S.

SHEET 5

SCALE IN FEE
100 0 100 2

GRID IS BASED ON NORTH CAROLINA STAT

MAPPED BY: BOOTHE CO., INC.
PARK AERIAL SURVEYS, INC.
MAY 1958

47

WAKE COUNTY

GARNER

SHEET 43

47-4
.9 Ac.

43-4

47-5
9.67 Ac. Total
1.92 " R/W
7.75 " NET

47-6

14
10.26 Ac. Total
2.97 R/W
7.29 Ac. NET

16
2.25 Ac.

7
6.75 AC.

SOUTHERN RAILWAY

WHITE OAK ROAD

Old Raleigh & Clayton Road

3
20.70 AC.

59
3.6 AC.

60
4.63 AC.

62
.91 AC.

63
.93 AC.

64
1.06 AC.

12

61
.94 AC.

65
.49 AC.

13

66
.47AC.

58
.49 AC.

56
.77 AC.

50
12.41AC.

U.S. HIGHWAY 70

19
10 ACRES
LUTHER H. MASSENGALE

SHEET 706+683

SHEET 51

2,121,000

2,122,000

2,122,250

SCALE IN FEET
100 200 300 400


NORTH CAROLINA STATE PLANE COORDINATE SYSTEM

BY: BOOTHE CO., INC., GREENSBORO, N.C.
AERIAL SURVEYS, INC., LOUISVILLE, KY.
MAY 1958

GARNER, N.C.

SHEET 47

Index No. 47

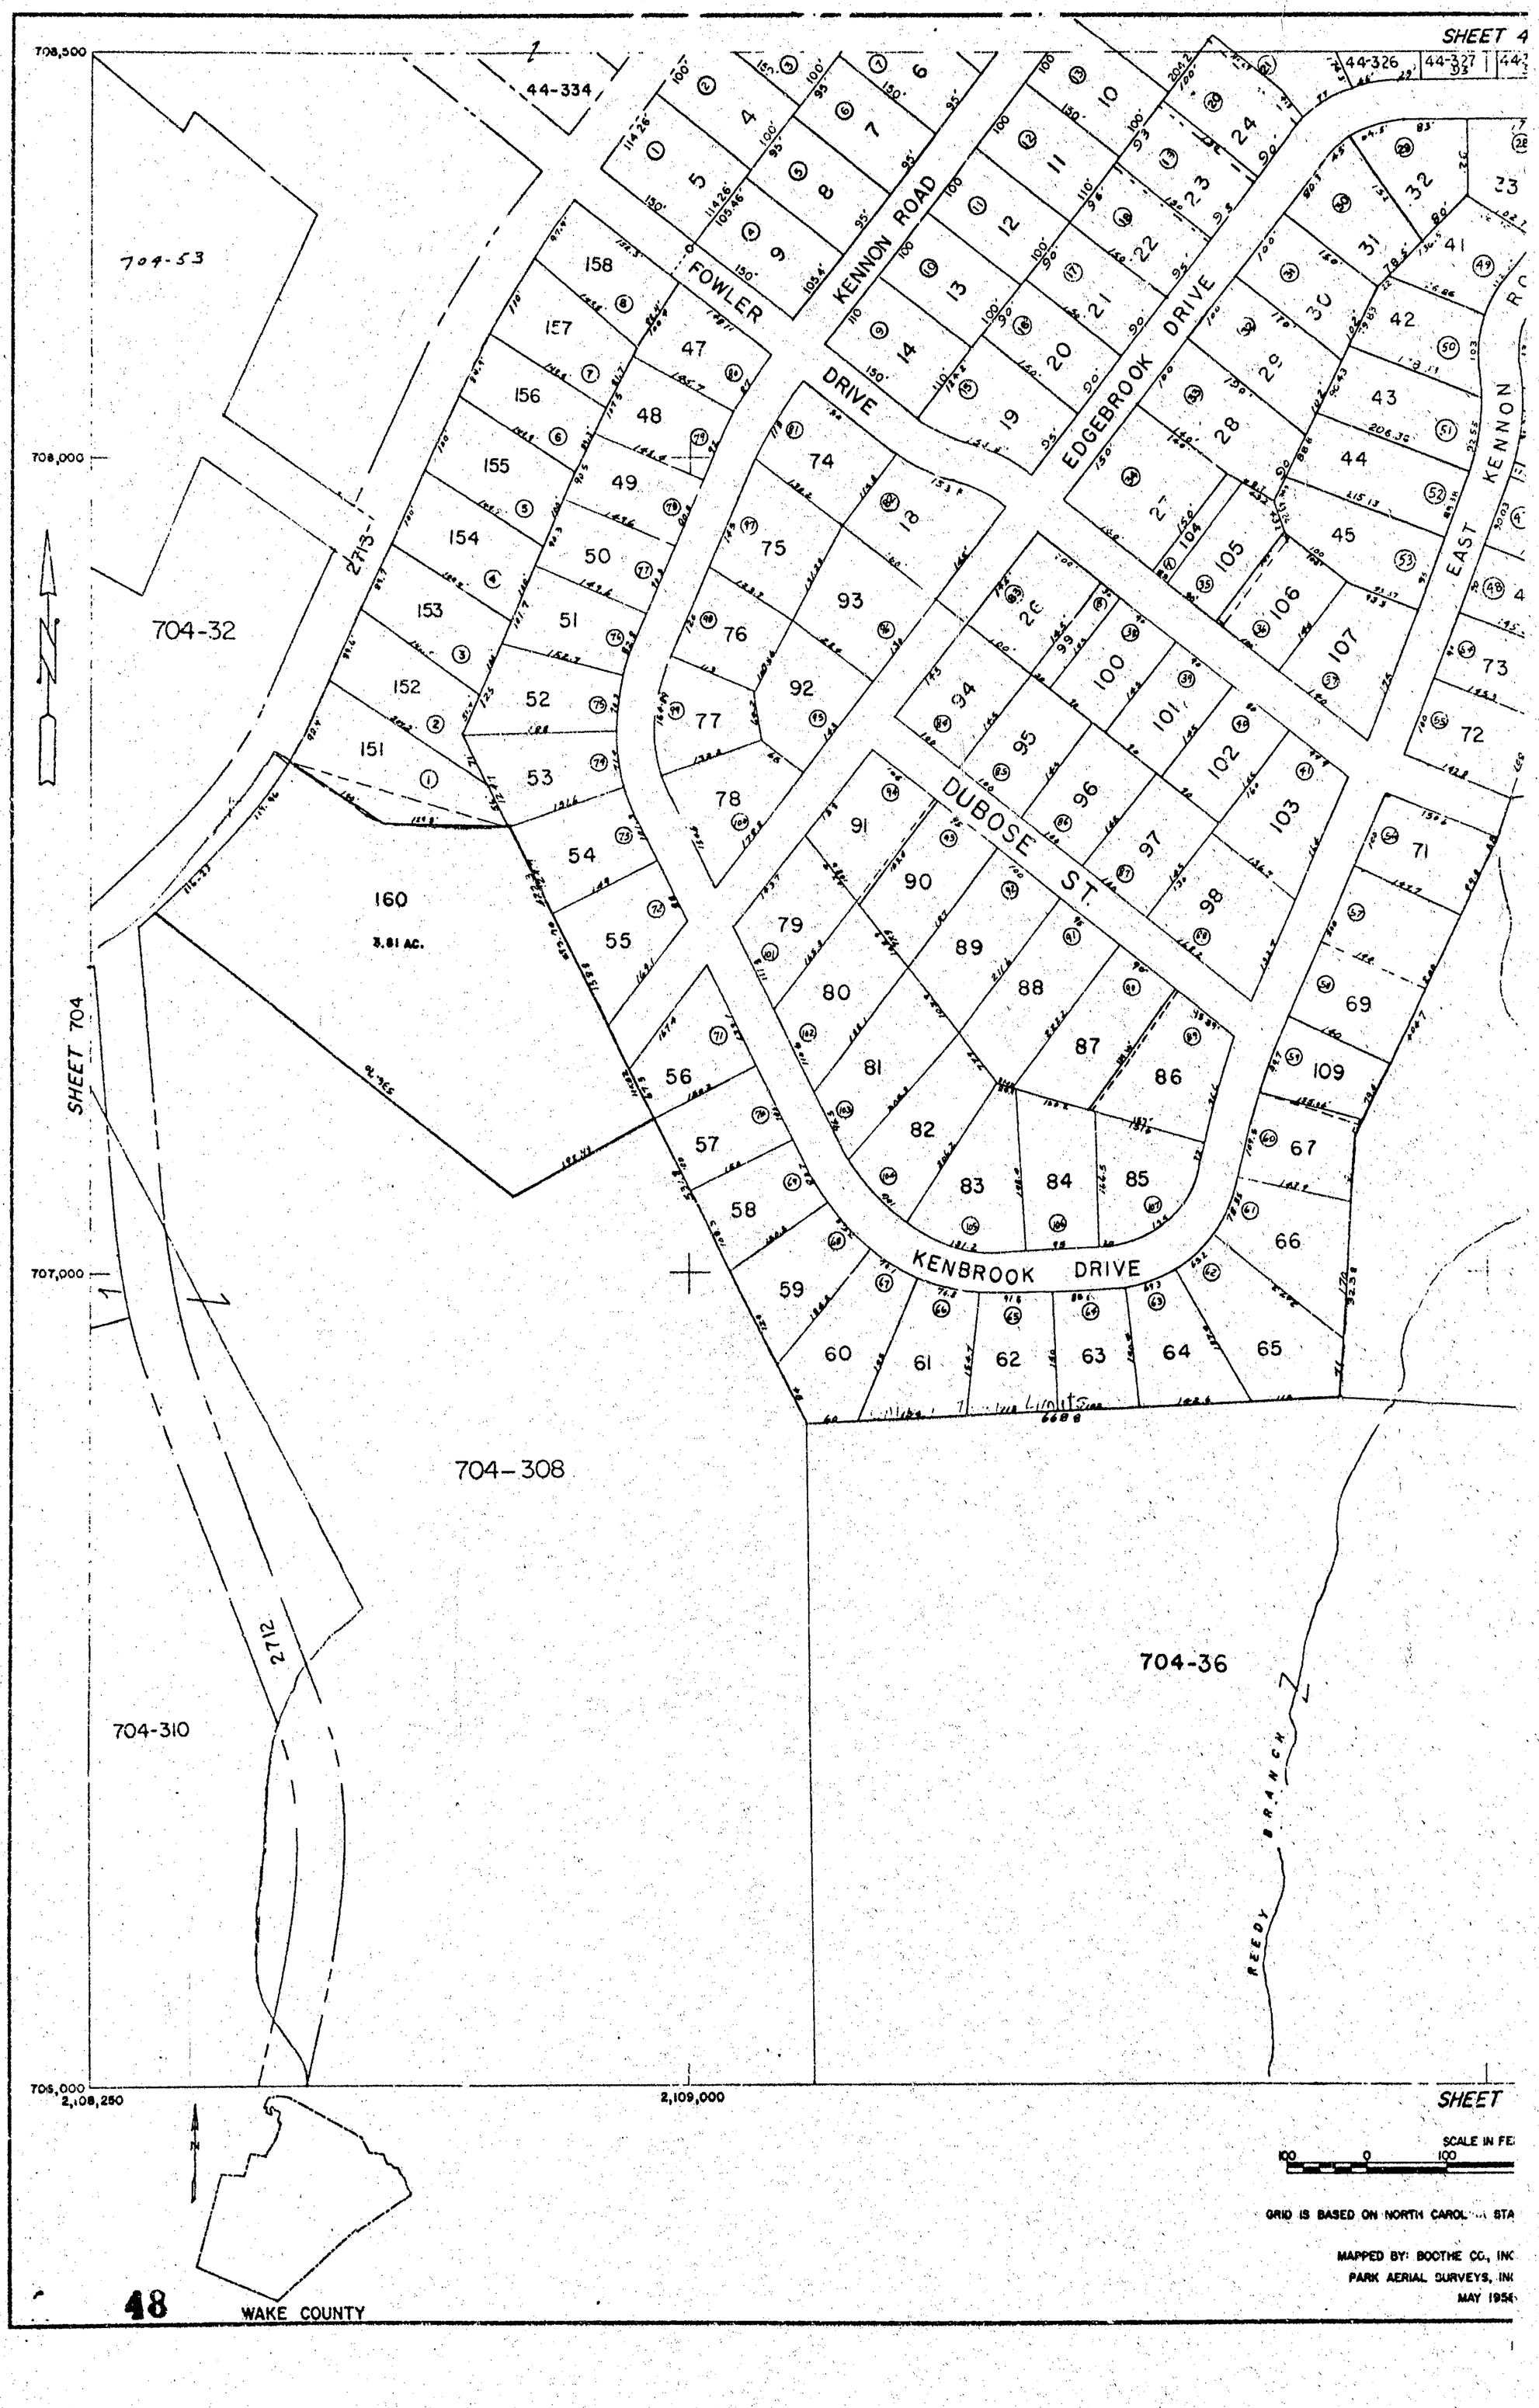
SHEET 4
708,500
708,000
707,000
705,000
2,108,250
2,109,000
44-334
704-53
704-32
704-308
704-36
704-310
SHEET 704
2713
2712
FOWLER
KENNON ROAD
DRIVE
EDGEBROOK DRIVE
EAST KENNON
DUBOSE ST.
KENBROOK DRIVE
44-326
44-327
160
3.81 AC.
Limits
REEDY BRANCH
SHEET
SCALE IN FE
100 0 100
GRID IS BASED ON NORTH CAROL... STA
MAPPED BY: BOOTHE CO., INC
PARK AERIAL SURVEYS, INC
MAY 1956
48
WAKE COUNTY

SHEET 44

44-327 | 44-328 | 44-329 | 44-339 | 44-331 | 44-335

ROAD | KENNON | EAST | SYCAMORE DR. | TIARA CT. | BLUEGRASS DR.

33 | 34 | 149 | 126 | 125 | 124 | 123 | 112 | 111 | 110 2.38 AC. | 49-95

41 | 46 | 148 | 127 | 128 | 122 | 113

36 | 147 | 129 | 121 | 114

37 | 146 | 137 | 130 | 120 | 115

38 | 145 | 138 | 136 | 131 | 119 | 116 | 159 10.7 AC.

39 | 144 | 139 | 135 | 132 | 118 | 117

40 | 143 | 140 | 134 | 133

73 | 142 | 141

72

FOOLE DRIVE

17 1.05 AC.

2 34.2 AC.

49-2

SHEET 49

420'

SEE "HEATHER HILLS" SUB. ON MAP 704

2120'

2726'

TR. 2

SEE "HEATHER HILLS" SUB. ON MAP 704

SHEET 704

2,111,000

2,111,750

SCALE IN FEET
100 200 300 400


I CAROLINA STATE PLANE COORDINATE SYSTEM

BOOTHE CO., INC., GREENSBORO, N.C.
L SURVEYS, INC., LOUISVILLE, KY.
MAY 1959

GARNER, N.C.

SHEET 48

LAST NO. 160 48

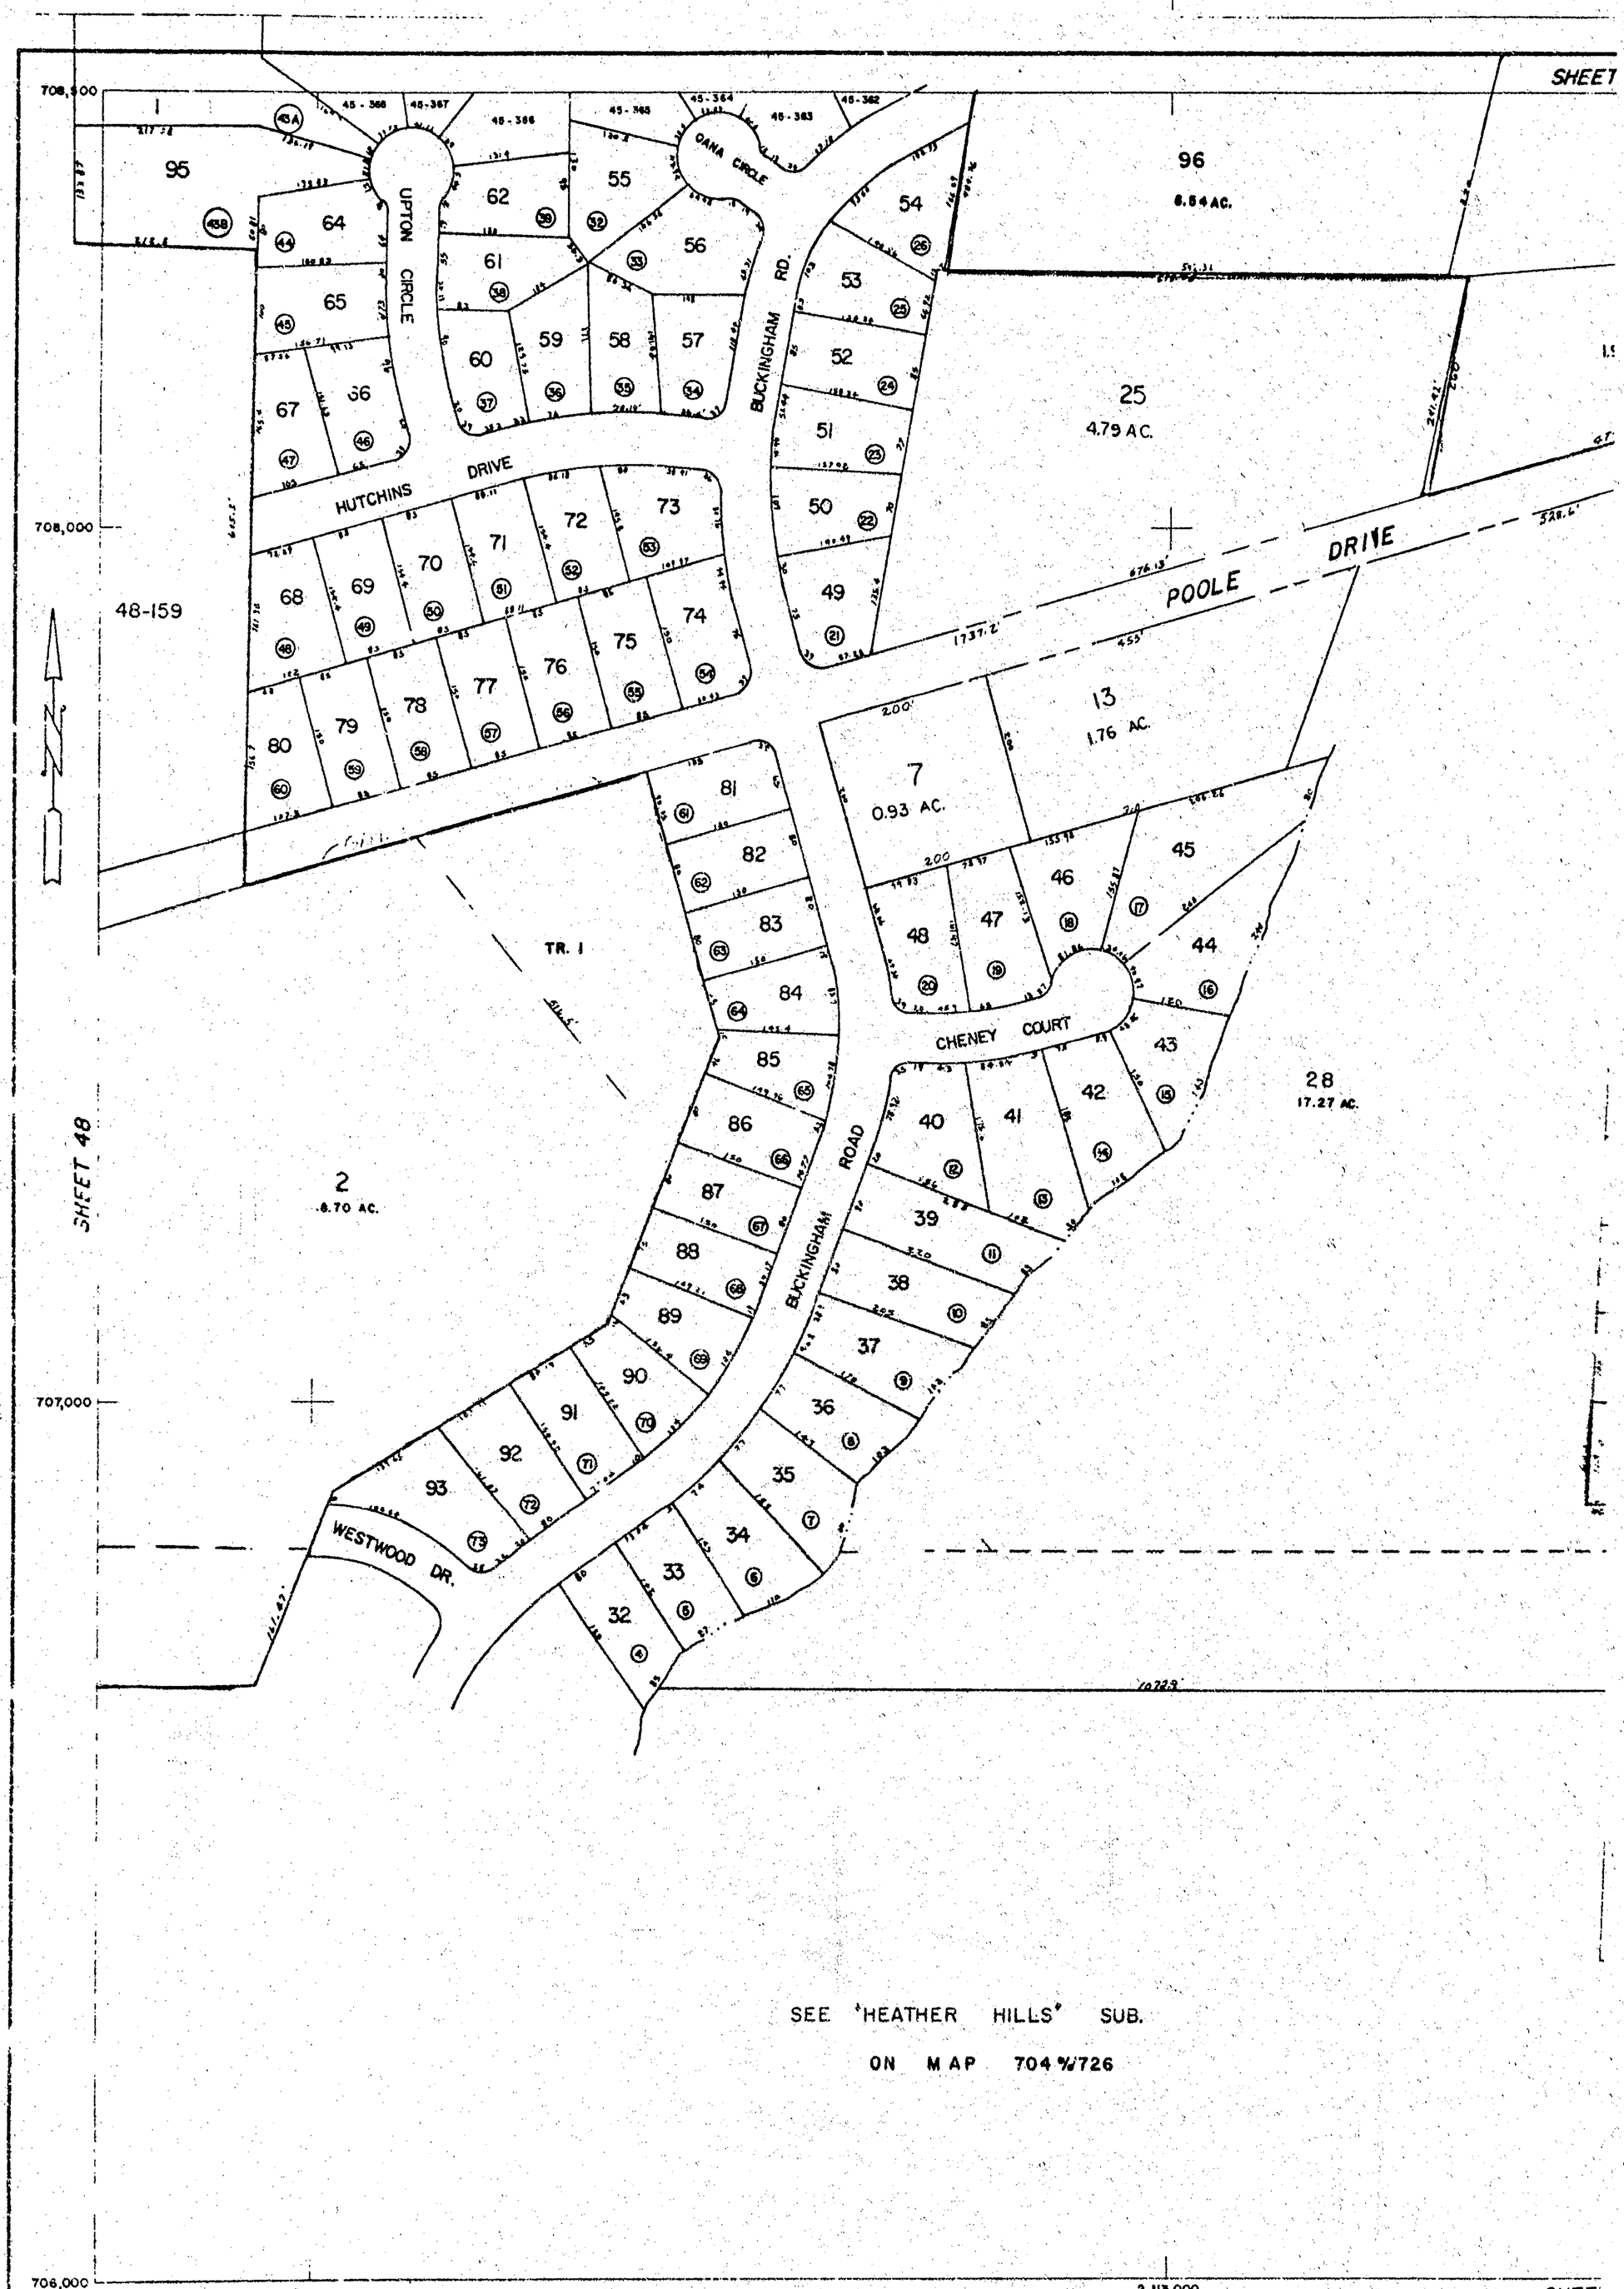

SEE 'HEATHER HILLS' SUB.

ON MAP 704 & 726

SHEET 45

9
3.63 AC.

400'

410.05'

10
1.94 AC.

150'

475.4'

100'

520.6'

315'

① 14

100'

② 15

③ 16

④ 17

⑤ 18

⑥ 19

70'

100'

7) 20

⑧ 21

⑨ 22

9 23

100'

8
0.5 AC.

100.2'

105'

100.05'

94
.68 AC.

45-370

POND

45-344

POND POND POND

POND

46-208

50-71

200'

4A

200'

100'

200.27'

6

200.27'

100'

98
3.79AC.

27
52.62 AC.

2132'
1610.8'

1500'

SHEET 50

PT. 72-5

2710

663'

1475'

97
3.66AC.

746.98

488.8

200'

152'

297.98
310.2'

50-8

50-9

705-45

SHEET 704 - 705

2,114,000

2,115,000

2,115,250

SCALE IN FEET
100 200 300 400


NORTH CAROLINA STATE PLANE COORDINATE SYSTEM

BY: BOOTHE CO, INC., GREENSBORO, N.C.
AERIAL SURVEYS, INC., LOUISVILLE, KY.
MAY 1958


GARNER, N.C.

SHEET 49

LAST No. 75 49

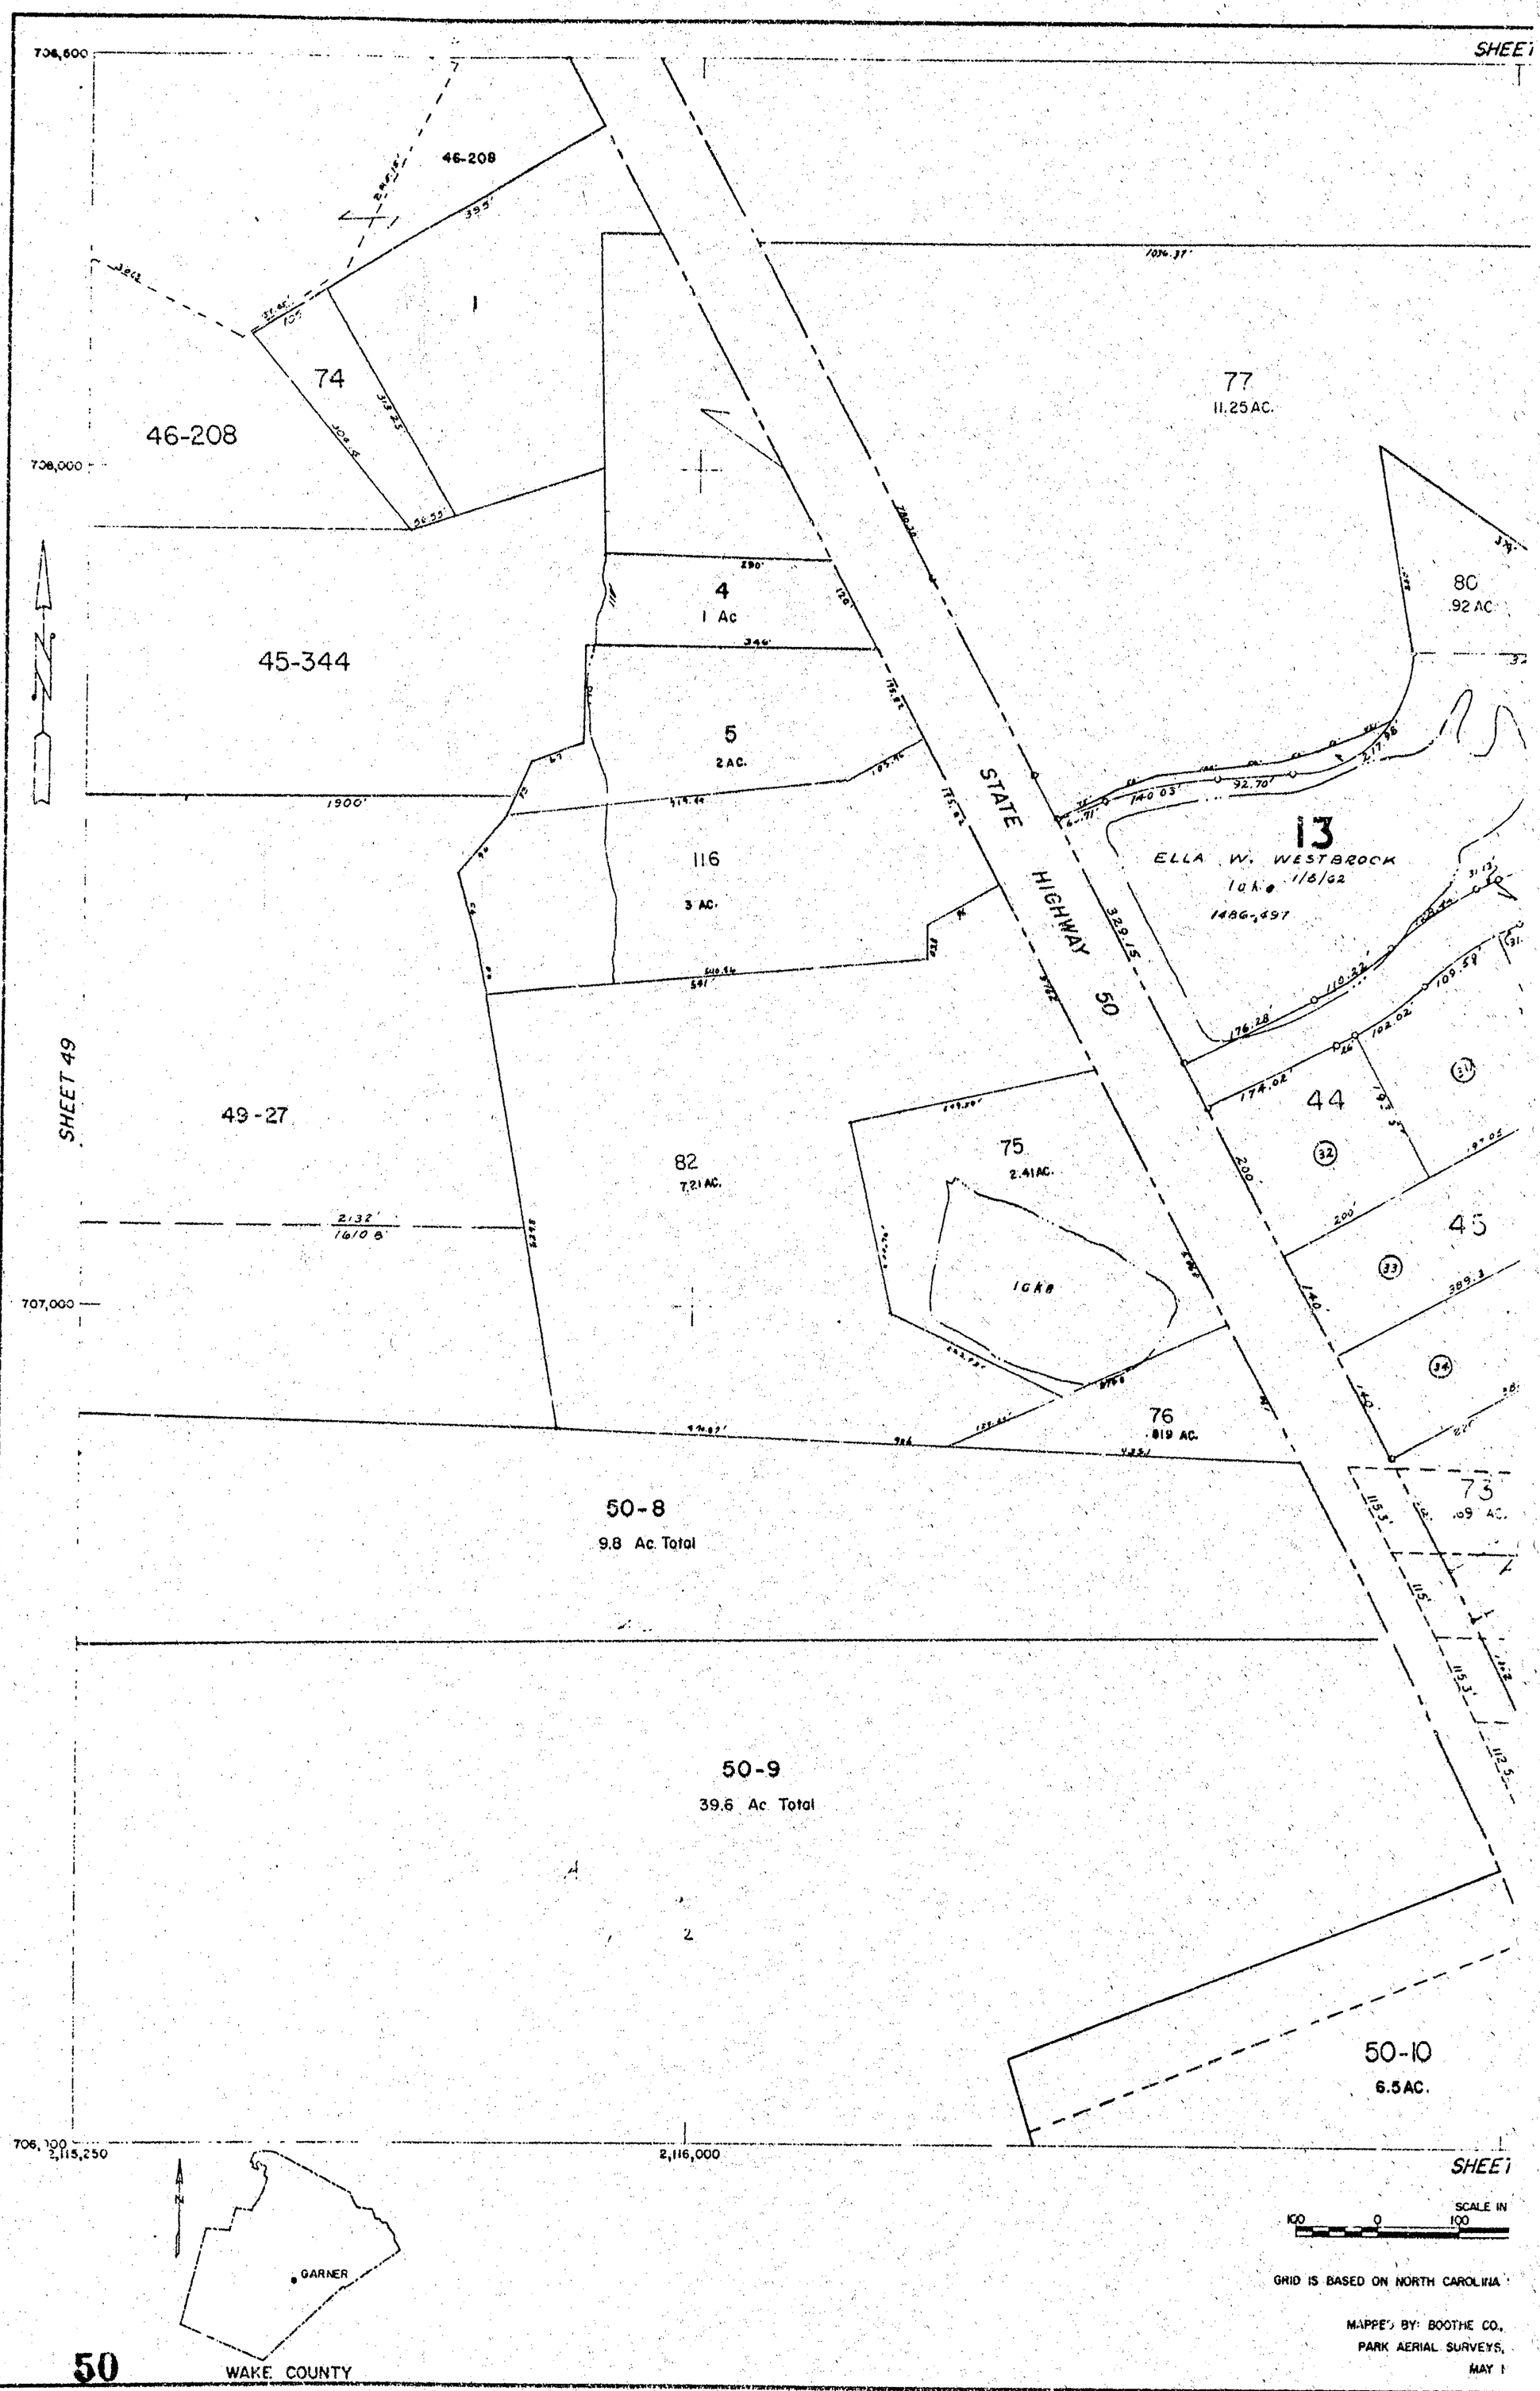
706,500
SHEET
46-208
74
313.25'
306.55'
56.55'
395'
324.45'
105'
46-208
708,000
4
1 Ac
290'
126'
346'
45-344
5
2 AC.
1900'
116
3 AC.
540.54'
591'
STATE HIGHWAY 50
77
11.25 AC.
1034.37'
80
.92 AC
140.03'
92.70'
13
ELLA W. WESTBROOK
1/8/62
1486-497
329.15'
110.32'
109.58'
102.02'
176.28'
174.02'
44
200'
45
389.3'
140'
73
1.09 AC.
115.3'
115'
112.5'
SHEET 49
49-27
82
7.21 AC.
75
2.41 AC.
IGRB
2132'
1610.8'
707,000
76
.819 AC.
50-8
9.8 Ac. Total
50-9
39.6 Ac. Total
50-10
6.5 AC.
706,100
2,115,250
2,116,000
SHEET
SCALE IN
100 0 100
GRID IS BASED ON NORTH CAROLINA
MAPPED BY: BOOTHE CO.,
PARK AERIAL SURVEYS,
MAY 1
GARNER
WAKE COUNTY
50

SHEET 46

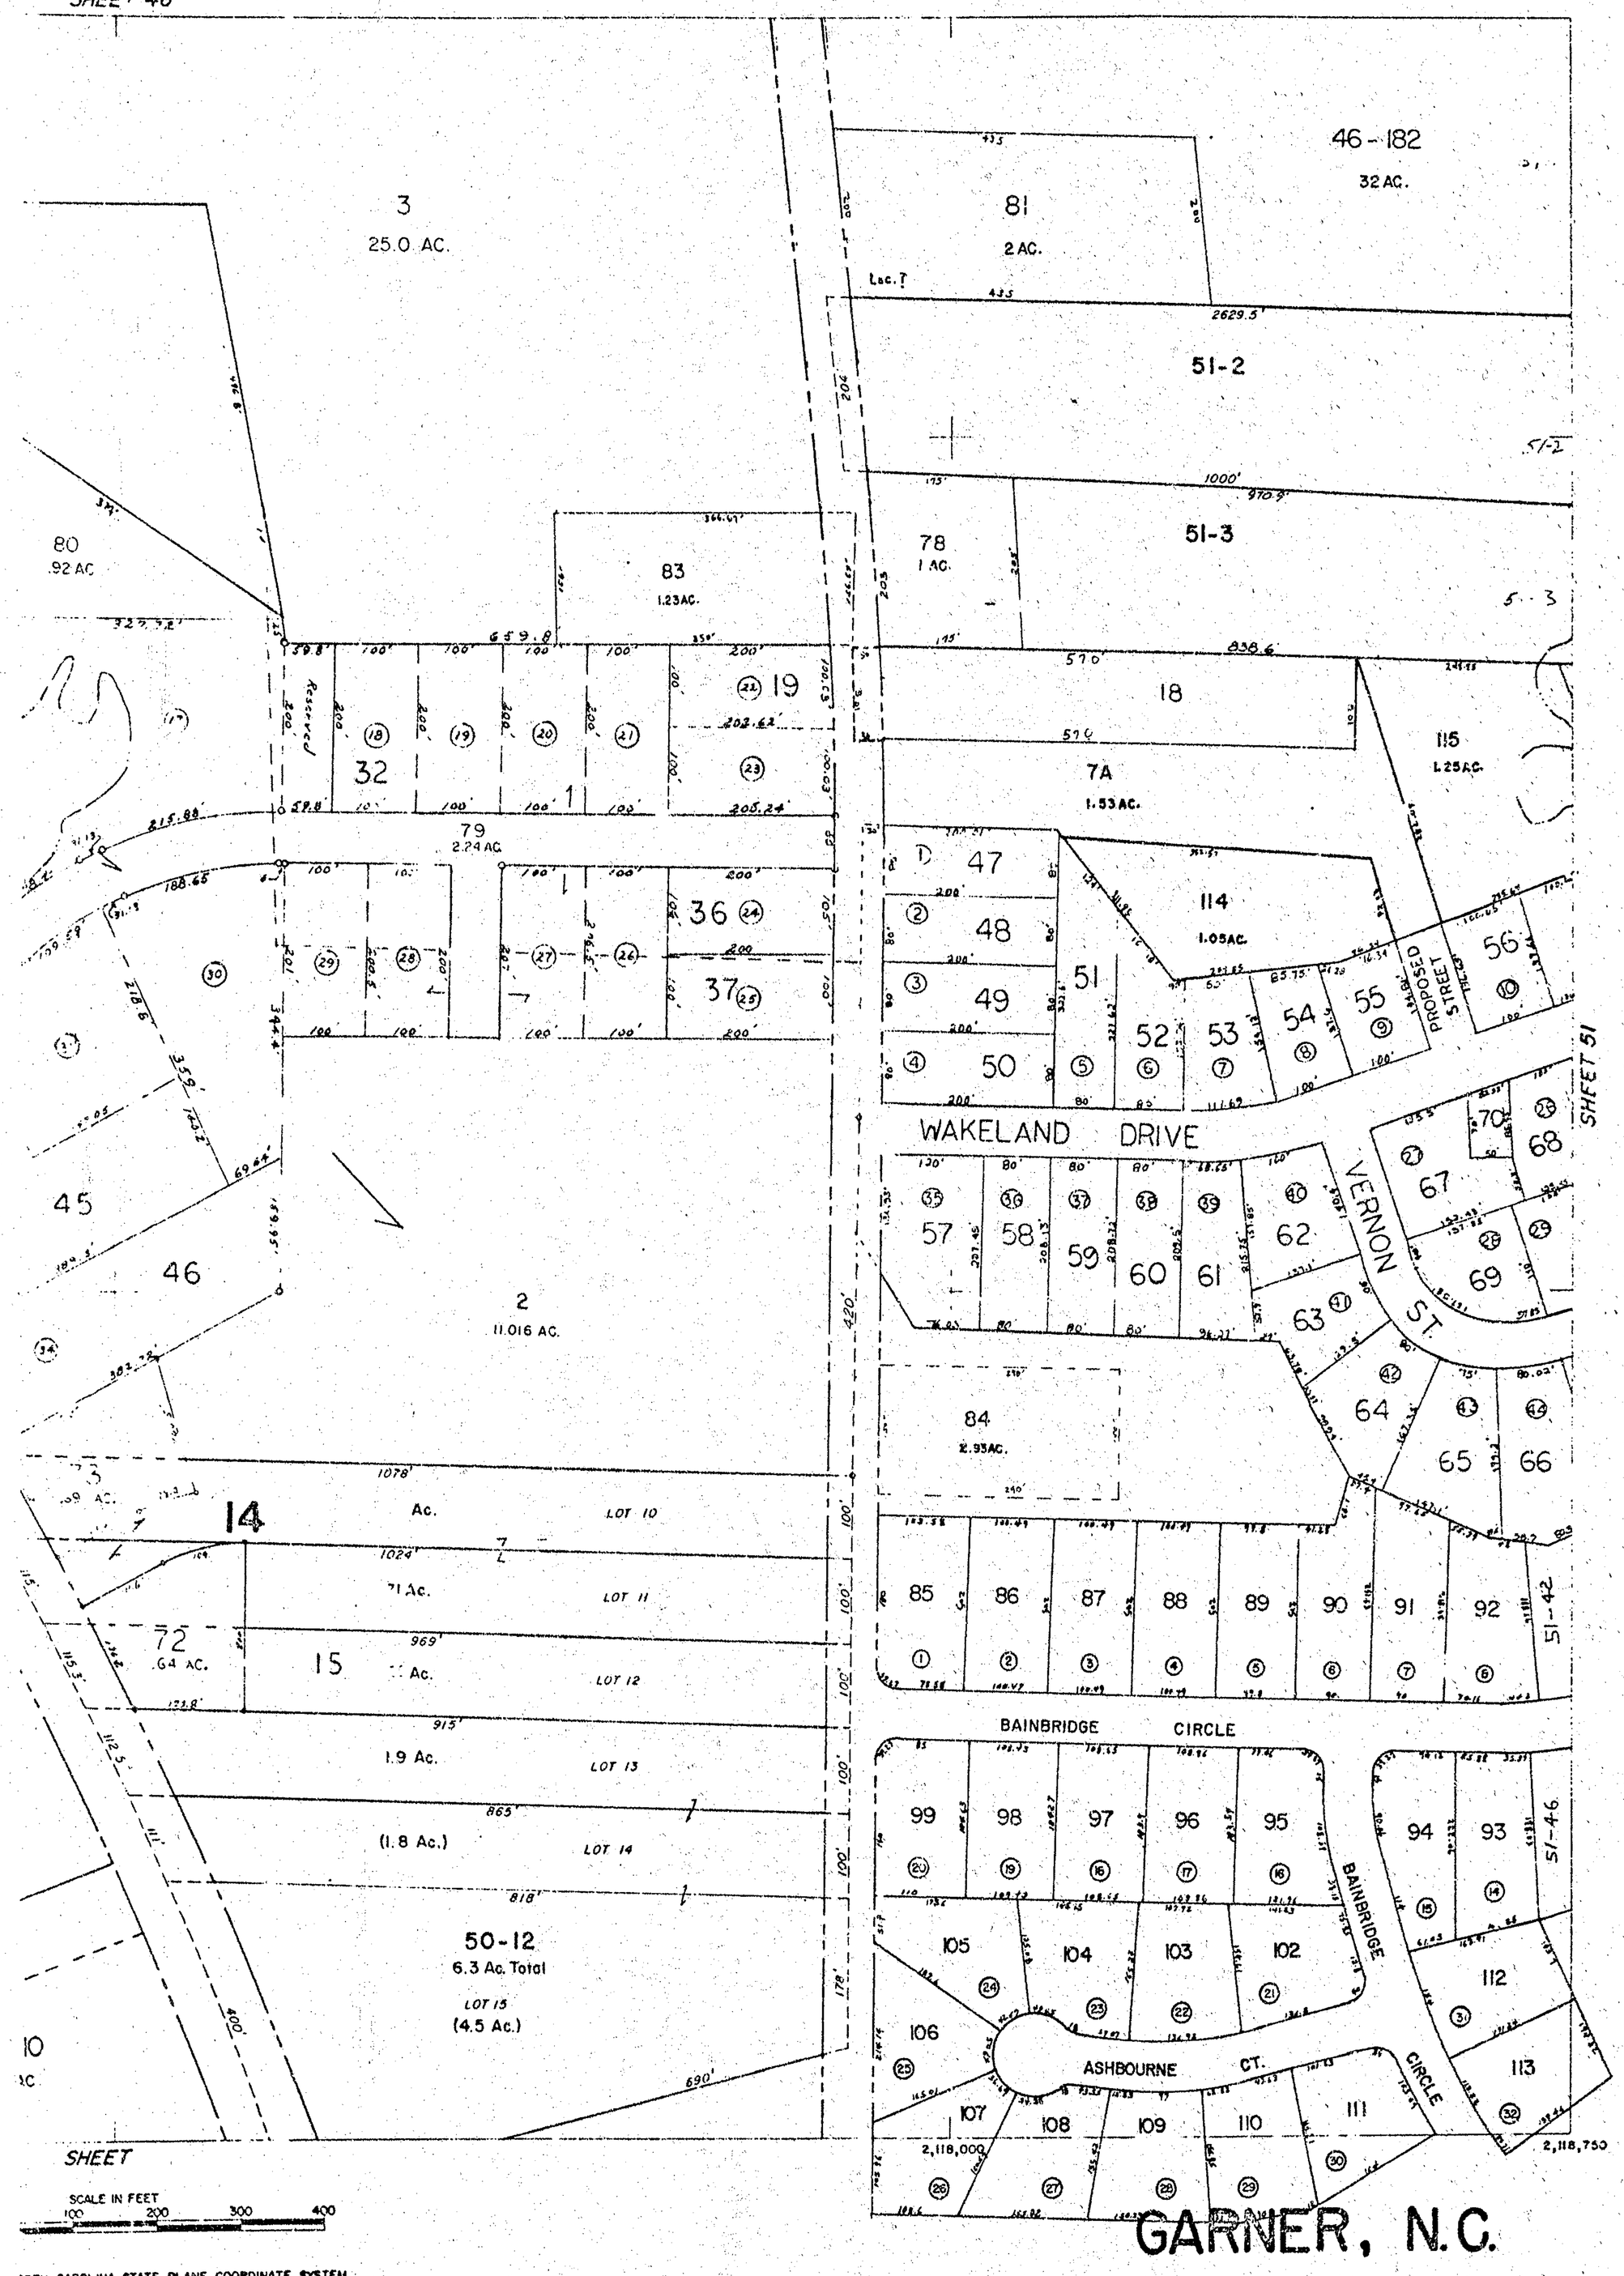

SCALE IN FEET
100 200 300 400

ORTH CAROLINA STATE PLANE COORDINATE SYSTEM

Y BOOTHE CO., INC., GREENSBORO, N.C.
ERIAL SURVEYS, INC., LOUISVILLE, KY.
MAY 1958

GARNER, N.C.

SHEET 50

LAST No. 46

50

SHEET 47

708,500

46-182
33 Ac.

47-6

47-

2
16.2 Acres

708,000

719.8

3
9.27 AC.

POND

370

WAKELAND DRIVE

SHEET 50

VERNON STREET

LONG AVE.

4

707,000

705-75

BAINBRIDGE CIRCLE

30-113

706,000
2,118,750

2,120,000

SHEET

SCALE IN FEET
100 0 100 200

GRID IS BASED ON NORTH CAROLINA STATE PLA

MAPPED BY: BOOTHE CO., INC., GREE
PARK AERIAL SURVEYS, INC., LOUI
MAY 1958

51 WAKE COUNTY

SHEET 47

47-19

65'

47-50

1422.4'

706-7

SHEET

38 AC.

706-13

2,121,000

2,122,000

2,122,25

SCALE IN FEET
100 200 300 400

NORTH CAROLINA STATE PLANE COORDINATE SYSTEM

BY: BOOTHE CO., INC., GREENSBORO, N.C.
AERIAL SURVEYS, INC., LOUISVILLE, KY.
MAY 1956

GARNER, N.C.

LAST No: 46

SHEET 51






















NO SHEET

761,500

421-45

1825'

761,000

420-28

926'

570'

NO SHEET

660'

54-1

1374'

760,000

448-31

1188'

448-12

396'

759,000
2,197,500

2,198,000

54-2

2,199,000

SHEET

LOT 15
(3.99 Ac.)

51

50

48

HENDERSON LAKE

1

R.F. IRON STICKS
20 ft. ±

585.9'

971'

Lake

795'

1133'

123'

171'

316'

495'

U.S. - 64

N

ZEBULON


52

WAKE COUNTY

SCALE IN
100 0 100

GRID IS BASED ON NORTH CAROLINA

MAPPED BY: BOOTHE CO.,
PARK AERIAL SURVEYS,
MAY

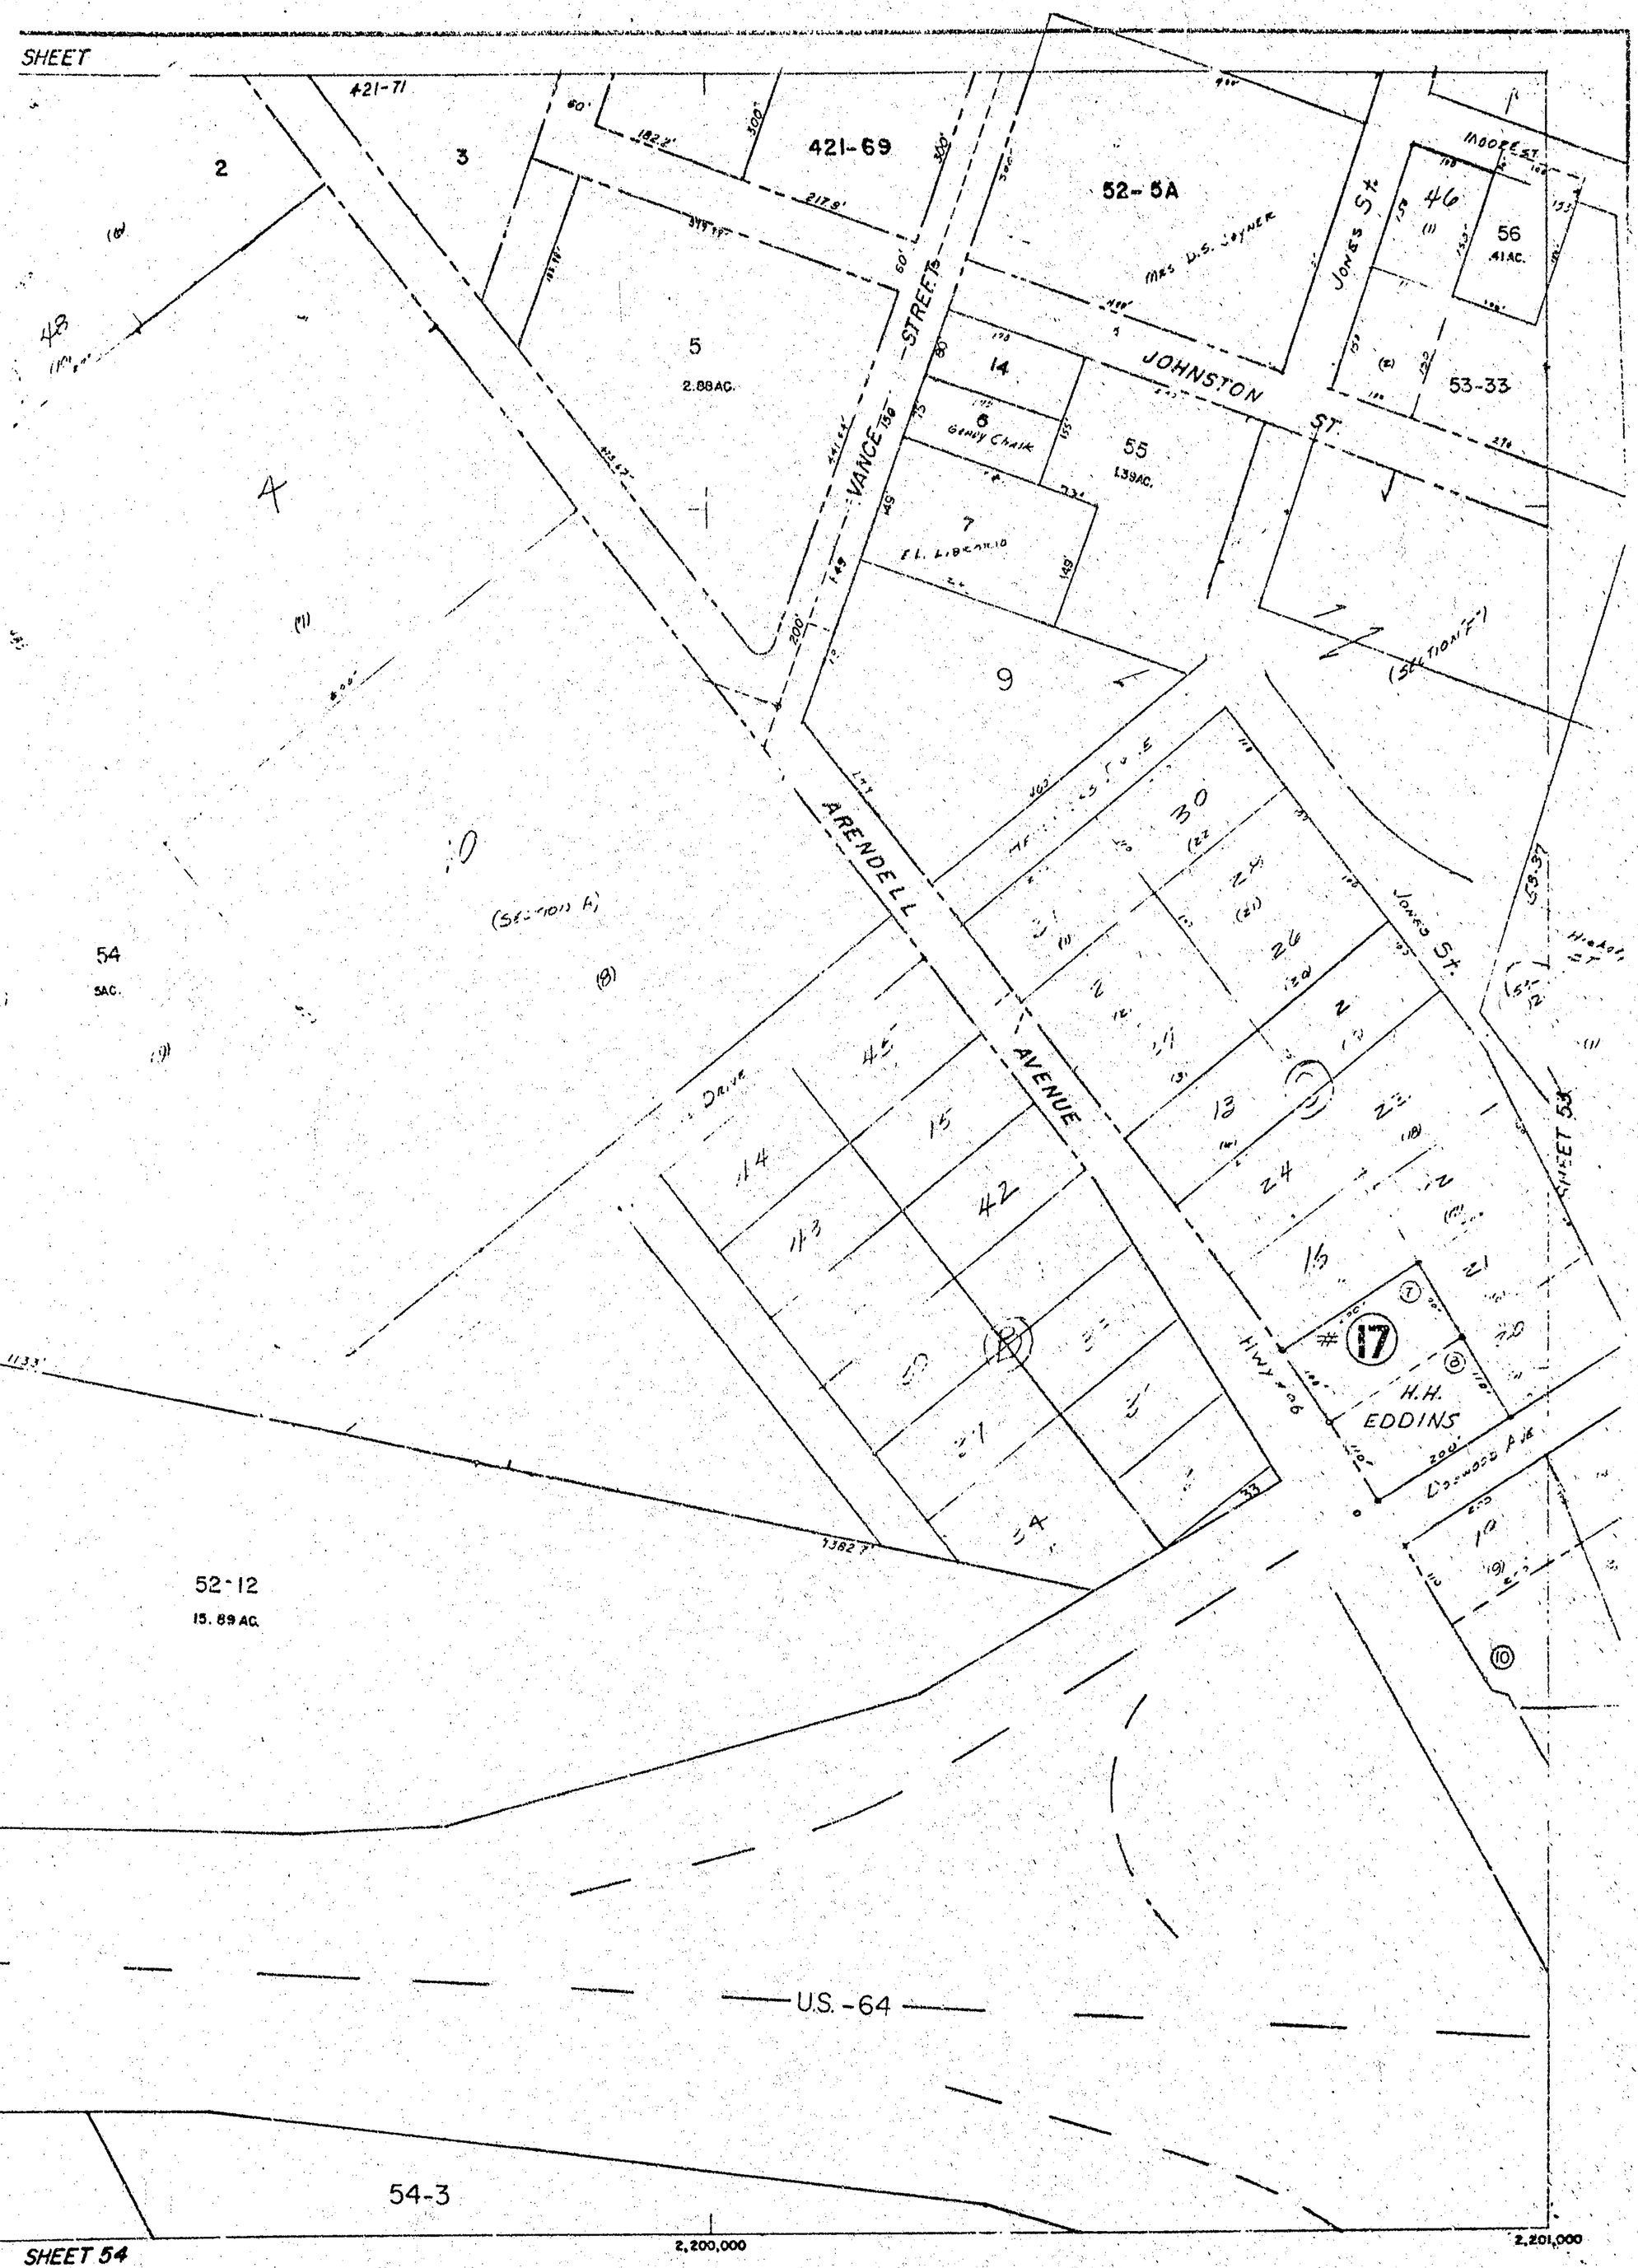
SHEET
421-71
421-69
52-5A
MRS. D.S. JOYNER
JOHNSTON ST.
VANCE STREET
JONES St.
MOORE ST.
46
56
.41 AC.
53-33
5
2.88 AC.
14
6
GENNY CHASE
55
1.39 AC.
7
E.L. LIBERTON
9
ARENDELL AVENUE
30
24
26
13
24
15
42
45
14
50
51
54
SAC.
52-12
15.89 AC.
17
H.H. EDDINS
DOGWOOD AVE
10
SHEET 53
U.S. -64
54-3
SHEET 54
2,200,000
2,201,000
SCALE IN FEET
100 200 300 400
TH CAROLINA STATE PLANE COORDINATE SYSTEM
BOOTHE CO., INC., GREENSBORO, N.C.
IAL SURVEYS, INC., LOUISVILLE, KY.
MAY 1958
ZEBULON, N.C.
LAST NO. 5
SHEET 52
52

SHEET

761,500

53-2A

53-2

421-44

(H)

52-9

MOORE ST.

37
23.27 AC.

33

(G)

761,000

JOHNSTON ST.

(F)

MASSEY ST.

HICKORY ST.

12
13
14
26
15
27
28
29
16
17
30
18
31
19
32
20
22
23
24
21
25

SHEET 52

52-7

52-19

760,000

DOG WOOD AVE.

JONES ST.

38
1.82 AC.

PROCTOR ST.

Lake

SHEET

Lake

53-4

N.C. - 96

U. S. - 64

759,000
2,201,000

2,202,000

SHEET

SCALE IN FE
100 0 100

GRID IS BASED ON NORTH CAROLINA ST

MAPPED BY: BOOTHE CO., IN
PARK AERIAL SURVEYS, IN
MAY 195

N

ZEBULON

53

WAKE COUNTY

SHEET

421-44

8
125.68 AC.

3-A
0.96 Ac.

FOR ST.

135'

41
.87 AC.

219.5'

2320

422-14

U.S. HWY. 64

39
.75 AC.

9
3 Ac.

7
1.4 Ac.

53-10
33 Ac. Total

Lake

20.46AC Total
53-40

Lake

409.3'

55-209

S.-64

SHEET 55

2,203,000

2,204,000

2,204

SCALE IN FEET
0 100 200 300 400

ON NORTH CAROLINA STATE PLANE COORDINATE SYSTEM

MAPPED BY: BOOTHE CO., INC., GREENSBORO, N.C.
PARK AERIAL SURVEYS, INC., LOUISVILLE, KY.
MAY 1958

ZEBULON, N.C.

SHEET 53

LAST NO: # 4 : 53

SHEET 52

759,000

448-12

396'

54-1

67 Ac. Total

LOT 2
(28 Ac.)

1320'

LOT 1
(39 Ac.)

1593'

54-2

832'

54-1A
6.9AC. ±

448-21

528'

992'

462'

584'

531'

758,000

448-22

94' 78' 78' 78' 78'

37 36 35 34 33
.605 Ac.

SHEET

448-23

448-24

1.25 Ac. 1.21 Ac. 1.21 Ac. 1.21 Ac.

40
.645 Ac.

5 4 3 2 1

68' 78' 78' 78' 78'

350'

4
23.5 AC.

470'

54-1B
1.74AC.

54-1D
2 AC.

757,000

1157'

1394'

1177'

54-8
34.25 Ac. Total

44
1 AC.

304'

304'

304'

231'

460'

1167.2'

54-1E
4AC. ±

57-1

708'

756,500

2,197,000

2,198,000

2,199,000

SHEET 5

SCALE IN FEE
100 0 100

GRID IS BASED ON NORTH CAROLINA STAT

MAPPED BY: BOOTHE CO., INC.
PARK AERIAL SURVEYS, INC.
MAY 1958

N

ZEBULON

54

WAKE COUNTY

SHEET 52

54-3
12.54 AC.

U.S. - 64

935'

500'

718'

51
.47 AC.

55-4

5
9 Ac.
LOT 1A

611'
761'

9.77'

584'
531'

508'

7
13.61 AC.

GULF R.R.

46
6.38 AC.

330'

52
1 AC.

6
19.7 AC.
LOT 2

44
1 AC.

10
2.48 Ac.

475'
225'

1182'

39
1.027 AC.

231'

Road 20'

545'

42
1.43 AC.

41
1.341 AC.

53
1 AC.

47
7.26 AC.

980'

50
.69 AC.

54-9
13.06 Ac.
LOT 1B

12
9.15 AC.

703'

JUDD STREET

WAKEFIELD STREET

McIVER STREET

57-49

38
.46 Ac.

SHEET 55

SHEET 57

2,200,000

2,201,000

SCALE IN FEET
100 200 300 400

I CAROLINA STATE PLANE COORDINATE SYSTEM

)OOTHE CO., INC., GREENSBORO, N.C.
L SURVEYS, INC., LOUISVILLE, KY.
MAY 1958

ZEBULON, N.C.

SHEET 54

54

LAST NO

759,000

SHEET

U.S. — 64

N.C. -96

54-3

270
.41 AC.

3

1.73 AC.

Dirt Road

276
2.17AC.

55-4
Ac Total

Dirt Road

758,000

SHEET 54

JUDD

STREET

219
5.22 AC.

W.L.N. T.

TOWN LIMIT

BLOCK C

BLOCK B

ARENDELL

STREET

MCIVER

CHURCH

FRANKLIN

LEE

757,000

2,201,000

2,202,000

SHEET

ZEBULON

WAKE COUNTY

55

SCALE IN F

GRID IS BASED ON NORTH CAROLINA S

MAPPED BY: BOOTHE CO. I
PARK AERIAL SURVEYS,
MAY 19

SHEET 53

266
20.32 AC.

53-10

264

173A
.9 AC.

W.L.N.F.D.
TOWN LIMITS

267 .35 AC.
269
1.48 AC.
LOT 24
159
160
LOT 20 190

173
7.5 AC ±
SCHOOL

201
8.88 AC.

JUDD STREET

243
244
245
223
221
222
247
246
235
234
233
232
231
161 LOT 18
196
163
LOT 15 271
164
165
195
166
166-A
178
LOT 10 167
168
168A
169A
169
170A
170
171A
171
LOT 5 172
200
LOT 15

205
206
207
174
1.39 AC.
Dirt Road
275
1.44 AC.

229
230
212
228
191
177
108F
210
179
111
111B
124
242
.38 AC.
127-A
126
208
119
120
118
121
122
123
128
129
132
134
136
137
138
139
140
141
142
144
145
146
147
148
149
150
193
194
193A
193B
175
9.0 AC.
176
19 AC. ±
265
41 AC.
146 A
261
237
238
236
214
198
151
152
153
157
156A
183
184
155

LEE STREET
BLK-A
BLK-D
U.S. HIGHWAY 64
GANNON AVE.
PITTS ST.
OAK STREET
STRONACH AVE.
GILL AVE.
WHITLEY STREET
GLENN STREET

SHEET 58
SHEET 56

2,203,000
2,204,000
2,204,500

SCALE IN FEET
100 200 300 400

TH CAROLINA STATE PLANE COORDINATE SYSTEM

BOOTHE CO., INC., GREENSBORO, N.C.
IAL SURVEYS, INC., LOUISVILLE, KY.
MAY 1958

ZEBULON, N.C.

SHEET 55

LAST NO. 55

SHEET

759,000

U.S.-64

55-264

1
42 AC.

8
49.04 A

234.41'

758,000

ZEBULON

TOWN LIMITS

INLN. F.D.

SHEET 55

55-174

55-176

55-105

500'

200.5'

245.4'

285.75'

5
23.94 AC.

757,000

55-182

12
.27AC.

185'

11
8.55AC.

ZEBULON VLN. F.D.

500'

300'

1844'

275.7'

97.4'

756,500
2,204,500

2,205,000

2,206,000

SHEET 5

ZEBULON

SCALE IN FEET
100 0 100 20

GRID IS BASED ON NORTH CAROLINA STATE

MAPPED BY: BOOTHE CO., INC.,
PARK AERIAL SURVEYS, INC.,
MAY 1958

56 WAKE COUNTY

SHEET

8
49.04 AC.

450-1

1427'

700'

612'

586'

121.8'

456'±

14
20.88 AC.

13
1 AC.

1142'±

36'

31'

21'

381'±

4
26.7AC.

500'±

926'±

464'

6
25.16 AC.

786'

pond

489'

220'

10
.93 AC.

9
.31 AC.

174.31'

208'±

792.15'

113'

N.C. HWY. 64

1735.7'

974.9'

1015.4'

59-89

59-90

SHEET 59

SCALE IN FEET
100 200 300 400

TH CAROLINA STATE PLANE COORDINATE SYSTEM

BOOTHE CO., INC., GREENSBORO, N.C.
'IAL SURVEYS, INC., LOUISVILLE, KY.
MAY 1958

2,207,000

2,208,000

SHEET 59

ZEBULON, N.C.

SHEET 56

Last #

56

SHEET 54

756,500

57-1A

54-8

448-30

SHEET 55

756,000

755,000

754,000
2,197,500

2,198,000

2,199,000

SHEET 60

CALVIN ST.

GORDON ST.

SEXTON AVE.

DEVON PL.

LEEDS PL.

COVENTRY DR.

STRATFORD DRI

SOMERSET DR.

CAMBRIDGE

WEDGWOOD AVE.

177 1A .25 AC.

85 .40AC.

107 3.77 AC.

51 7.657 AC.

67 RESERVED

477-45

19 4.493AC.

72 3.12 AC.

147 1.06 AC.

60-39

60-25

60-14

ZEBULON

57 WAKE COUNTY


SCALE IN FEET
100 0 100 200

GRID IS BASED ON NORTH CAROLINA STATE

MAPPED BY: BOOTHE CO., INC.,
PARK AERIAL SURVEYS, INC.,
MAY 1958

ZEBULON, N.C.

SHEET 57

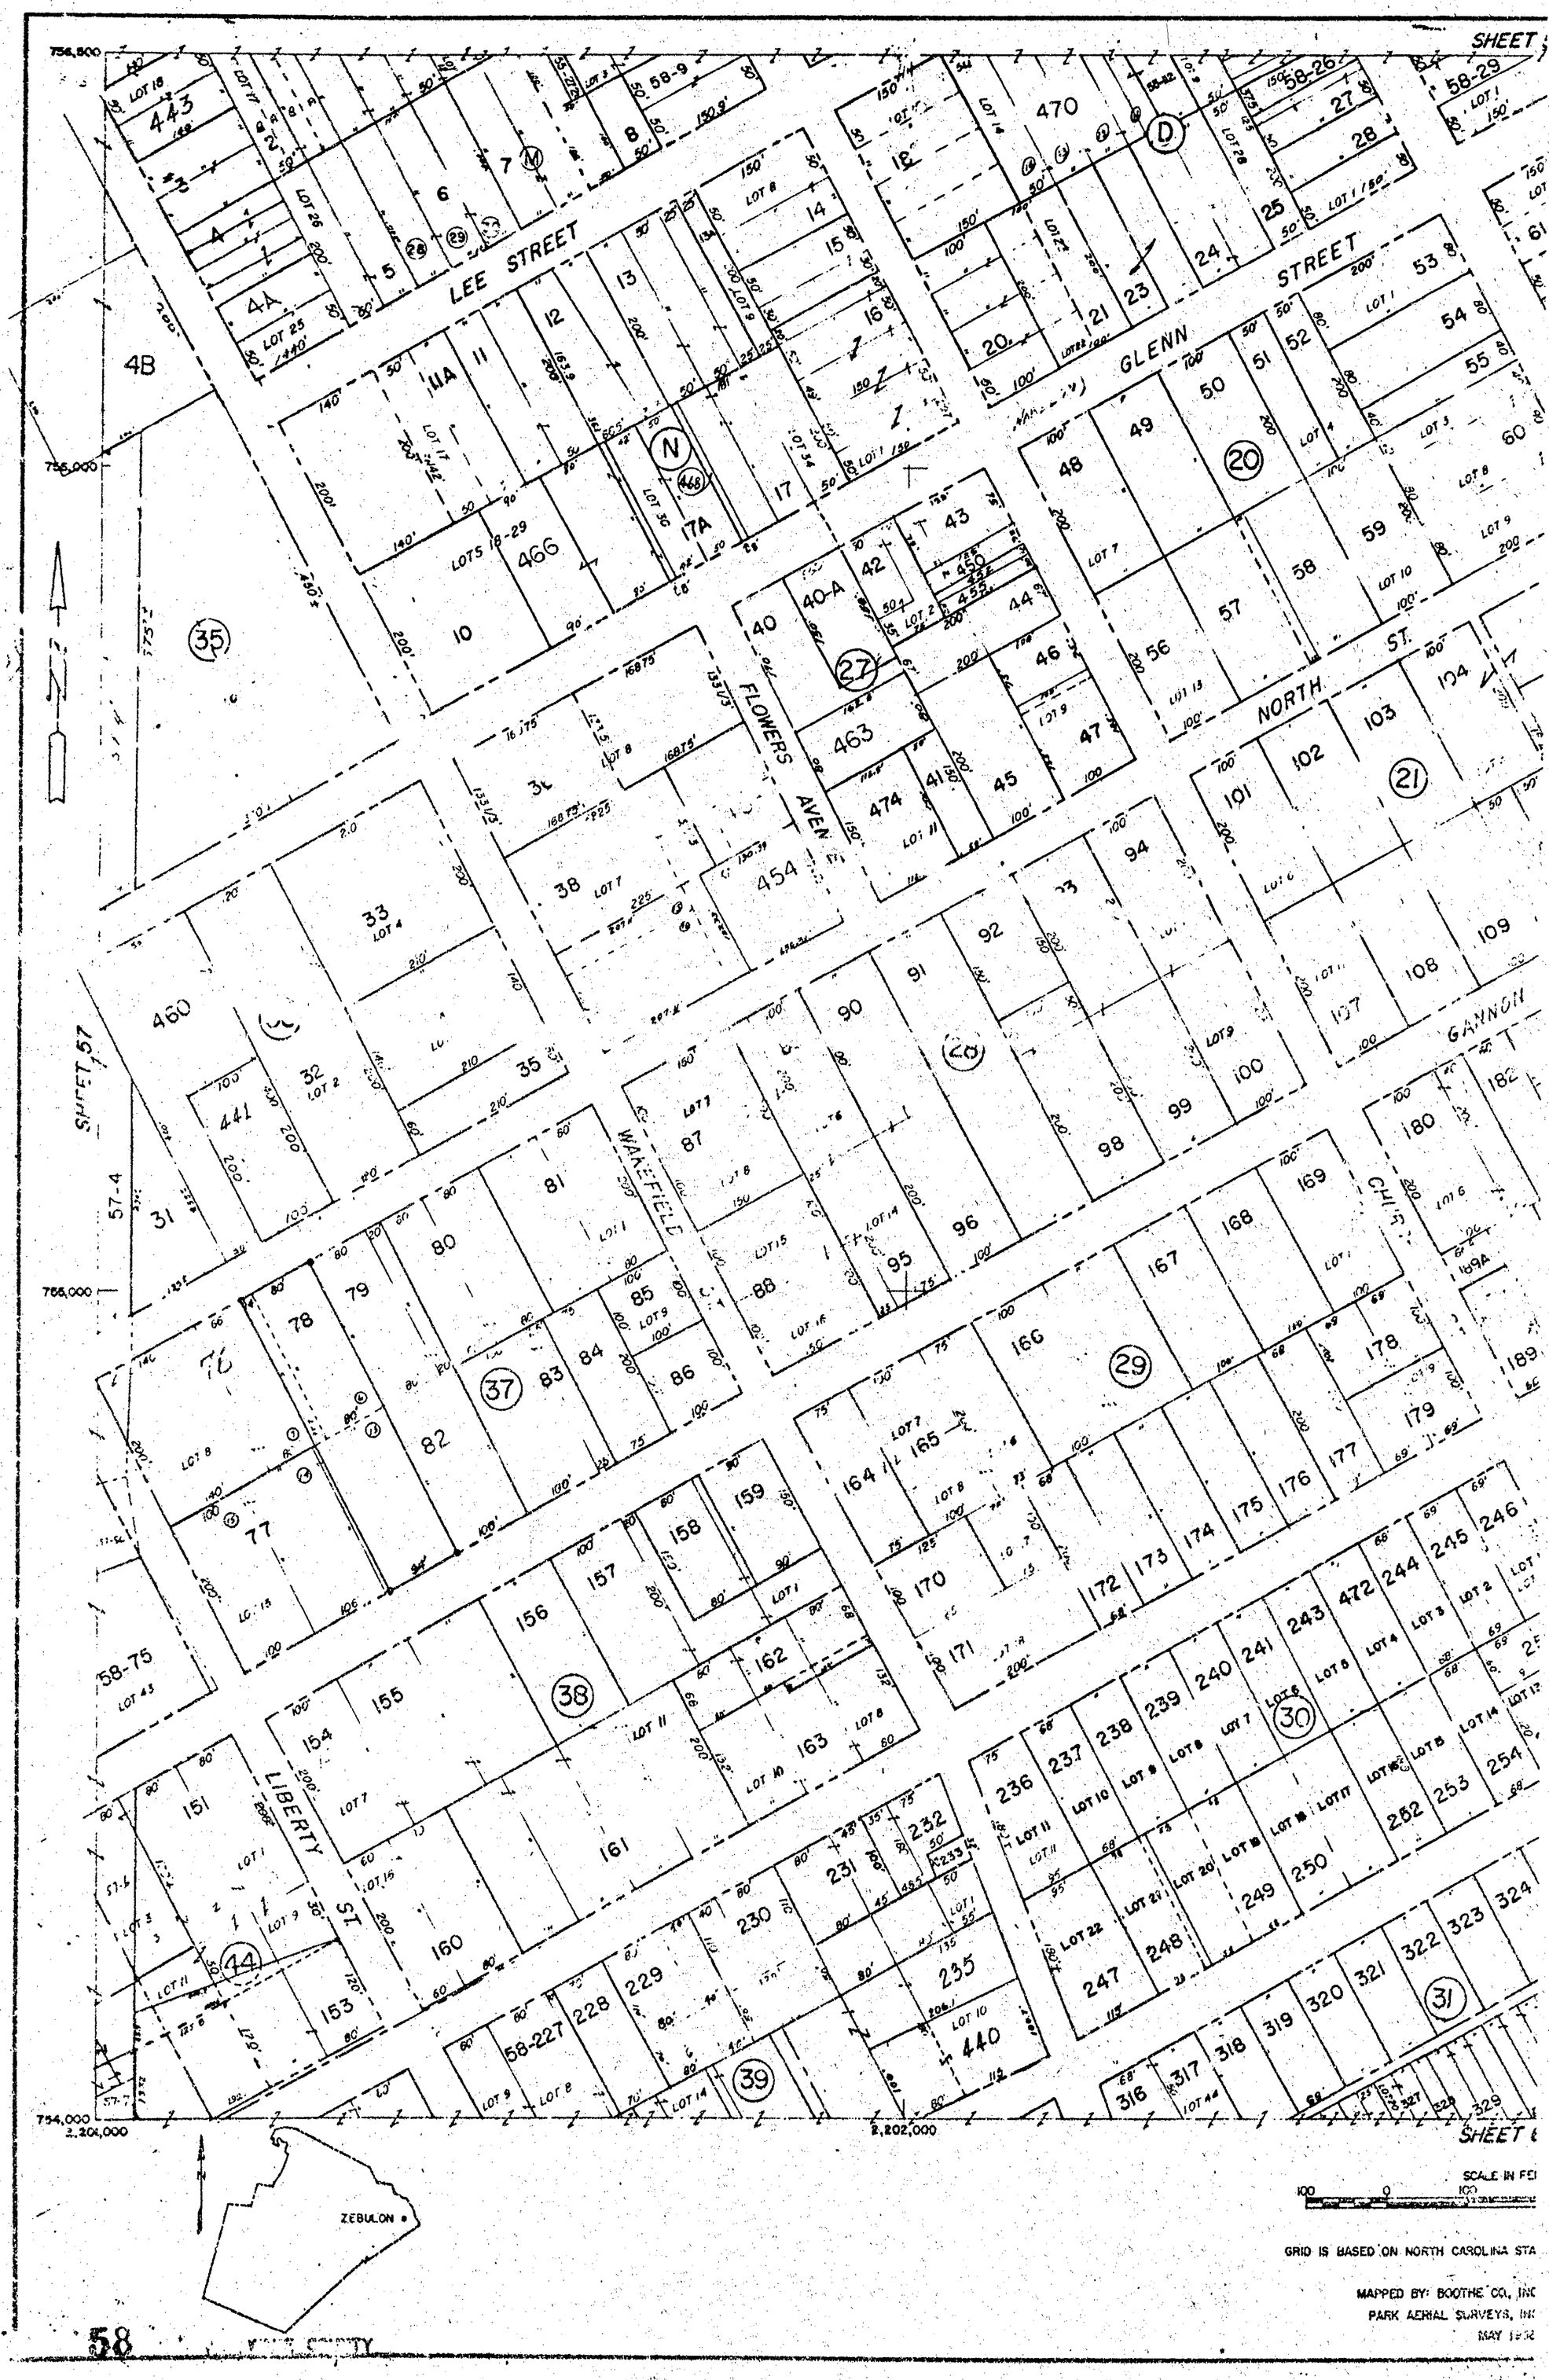
SHEET
LEE STREET
GLENN STREET
NORTH ST.
FLOWERS AVEN.
WAKEFIELD
LIBERTY ST.
GANNON
CHILTON
4B
4A
4
3
2
1
5
6
7
8
58-9
58-26
58-29
58-12
58-75
58-227
57-4
57-7
LOT 18
LOT 25
LOT 26
LOT 28
LOT 1
LOT 2
LOT 3
LOT 4
LOT 5
LOT 7
LOT 8
LOT 9
LOT 10
LOT 11
LOT 12
LOT 13
LOT 14
LOT 15
LOT 16
LOT 17
LOT 18
LOT 20
LOT 22
LOT 34
LOT 35
LOT 43
LOT 44
LOT 45
LOT 46
LOT 47
LOTS 18-29
LOTS 22-23
LOTS 44-45
443
470
466
463
474
454
460
441
456
450
452
455
756,500
756,000
755,500
755,000
754,500
754,000
2,204,000
2,202,000
SHEET
SCALE IN FE
100 0 100
GRID IS BASED ON NORTH CAROLINA STA
MAPPED BY: BOOTHE CO., INC
PARK AERIAL SURVEYS, INC
MAY 19
ZEBULON
58
COUNTY




SCALE IN FEET
0 200 300 400

NORTH CAROLINA STATE PLANE COORDINATE SYSTEM

[illegible] CO., INC., GREENSBORO, N.C.
[illegible], INC., LOUISVILLE, KY.

ZEBULON, N.C.

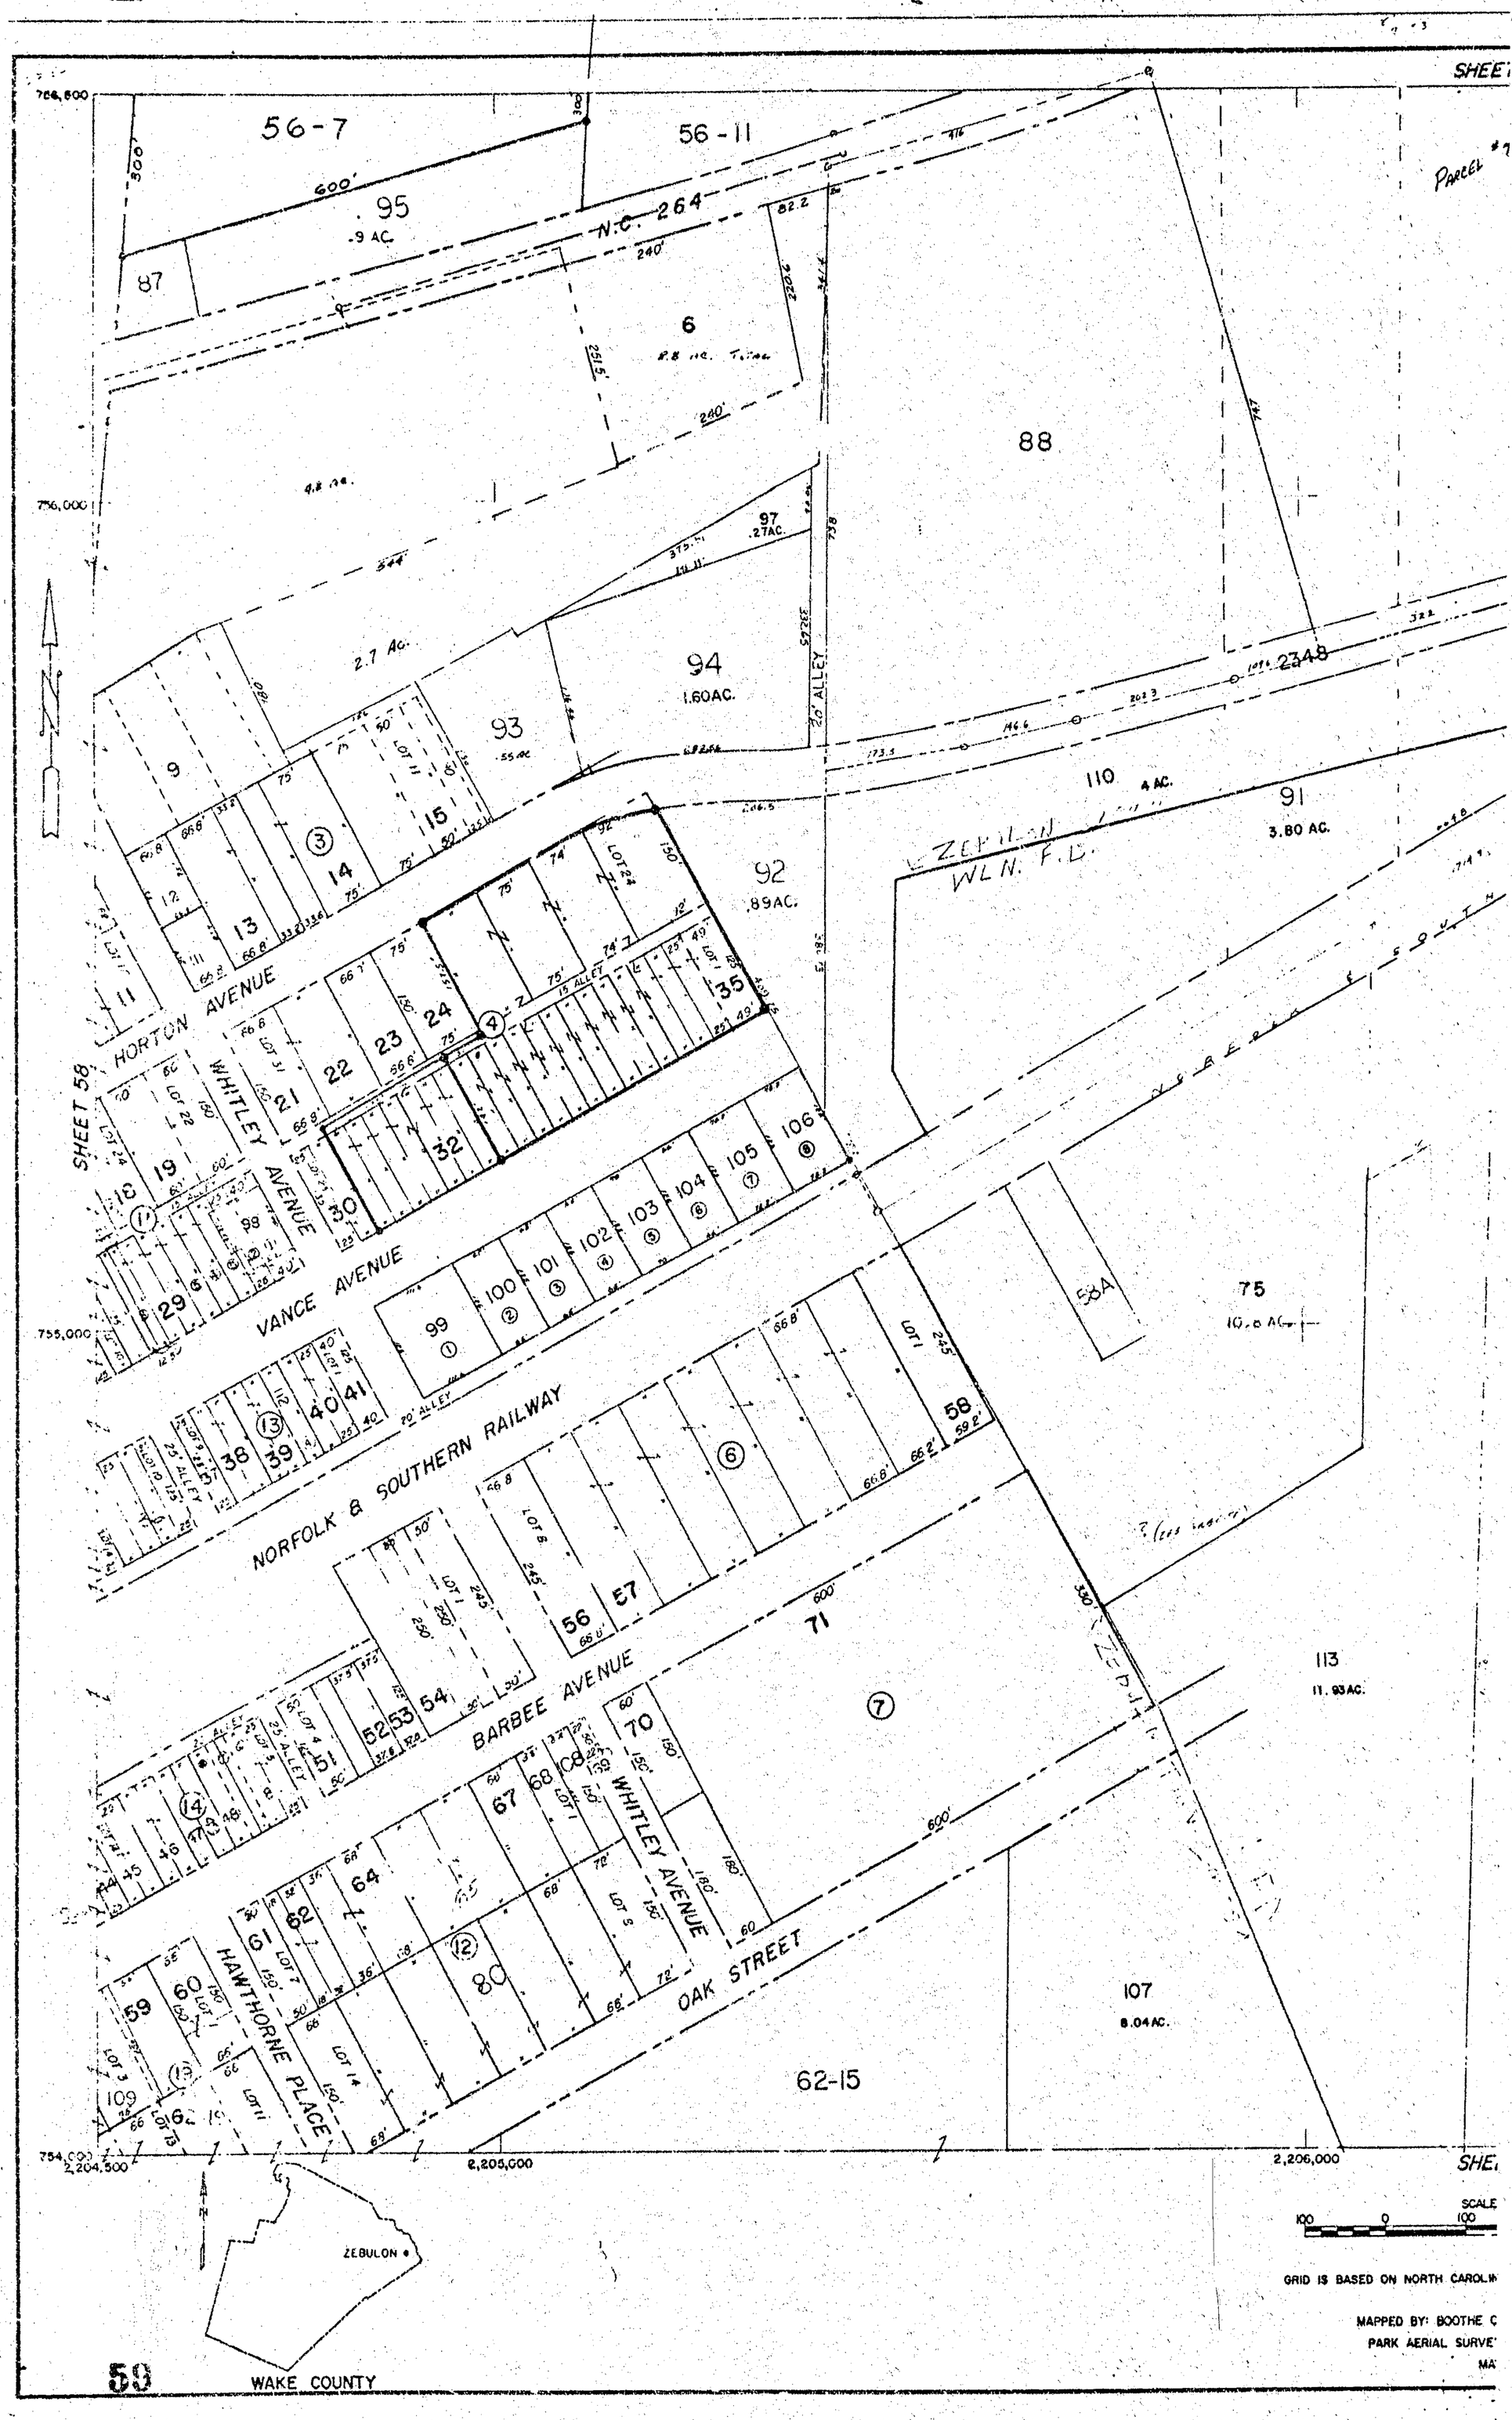
SHEET
PARCEL #7
56-7
56-11
.95
.9 AC.
87
N.C. 264
600'
300'
416'
240'
82.2
222.2
361.4
6
8.8 AC. TRACT
251.5'
88
747'
738'
97
.27AC.
94
1.60AC.
93
.55 AC.
2.7 AC.
544'
375.4'
20' ALLEY
572.5'
2348
322
92
.89AC.
110
4 AC.
91
3.80 AC.
ZEBULON
W.L.N. F.D.
SOUTH
58A
75
10.0 AC.
9
15
14
13
12
11
HORTON AVENUE
SHEET 58
WHITLEY AVENUE
22
23
24
21
19
18
32
30
35
29
VANCE AVENUE
99
100
101
102
103
104
105
106
98
40
41
39
38
NORFOLK & SOUTHERN RAILWAY
25' ALLEY
15' ALLEY
BARBEE AVENUE
71
7
56
57
58
59
54
53
52
51
70
68
67
64
62
61
60
80
WHITLEY AVENUE
HAWTHORNE PLACE
OAK STREET
109
LOT 13
LOT 14
LOT 11
LOT 8
LOT 5
LOT 7
LOT 3
113
11.93AC.
107
8.04AC.
62-15
756,000
755,000
754,500
2,204,500
2,205,000
2,206,000
SHEET
SCALE
100 0 100
GRID IS BASED ON NORTH CAROLI
MAPPED BY: BOOTHE C
PARK AERIAL SURVE
MA
ZEBULON
59
WAKE COUNTY

SHEET 56

PARCEL #73 & 74 ON SHEET #56

89
15 AC

90
6.50 AC

56-6

81
3 AC.

86

83
45 AC

82
99 AC

96
41.1 AC.

79
.82 Ac.
BR RAPER

77
17 AC.

78
22.73 AC.

62-1

62-2

SHEET 62

2,207,000

2,208,000

SCALE IN FEET
100 200 300 400

NORTH CAROLINA STATE PLANE COORDINATE SYSTEM

D BY: SCOTHE CO., INC., GREENSBORO, N.C.
K AERIAL SURVEYS, INC. LOUISVILLE, KY.
MAY 1958

ZEBULON, N.C.

SHEET 59

LAST No. # 113

59

SHEET 5.

754,000

57-132

57-147

39
1.46 AC.

60-14
.66 AC.

25
1.7 AC.

35
OTAC.

34
K.08

77

57-19

38
2.82 AC.

477-45

1
7.07 AC.

34 AC. 13

10

31
A8 AC.

16

LOT 2&3 17
1.1C AC.

LOTS 4&5 12
1.3 AC.

W. N. T. L.

477-7

60-2
23.9AC.

Dirt Road

33
15.17 AC.

U.S. HIGHWAY 64

37
1.56 AC.

3
4.30 AC.

477-8

27
2.17 AC.

Stream

Pond

21
4. AC.

752,000

60-6A
2.36 AC.

60-6
3 AC.

751,500
2,197,500

2,198,000

2,199,000

SHEET


SCALE IN FEET
100 0 100 200

GRID IS BASED ON NORTH CAROLINA STATE

MAPPED BY: BOOTHE CO., INC.,
PARK AERIAL SURVEYS, INC.,
MAY 1958

ZEBULON

WAKE COUNTY

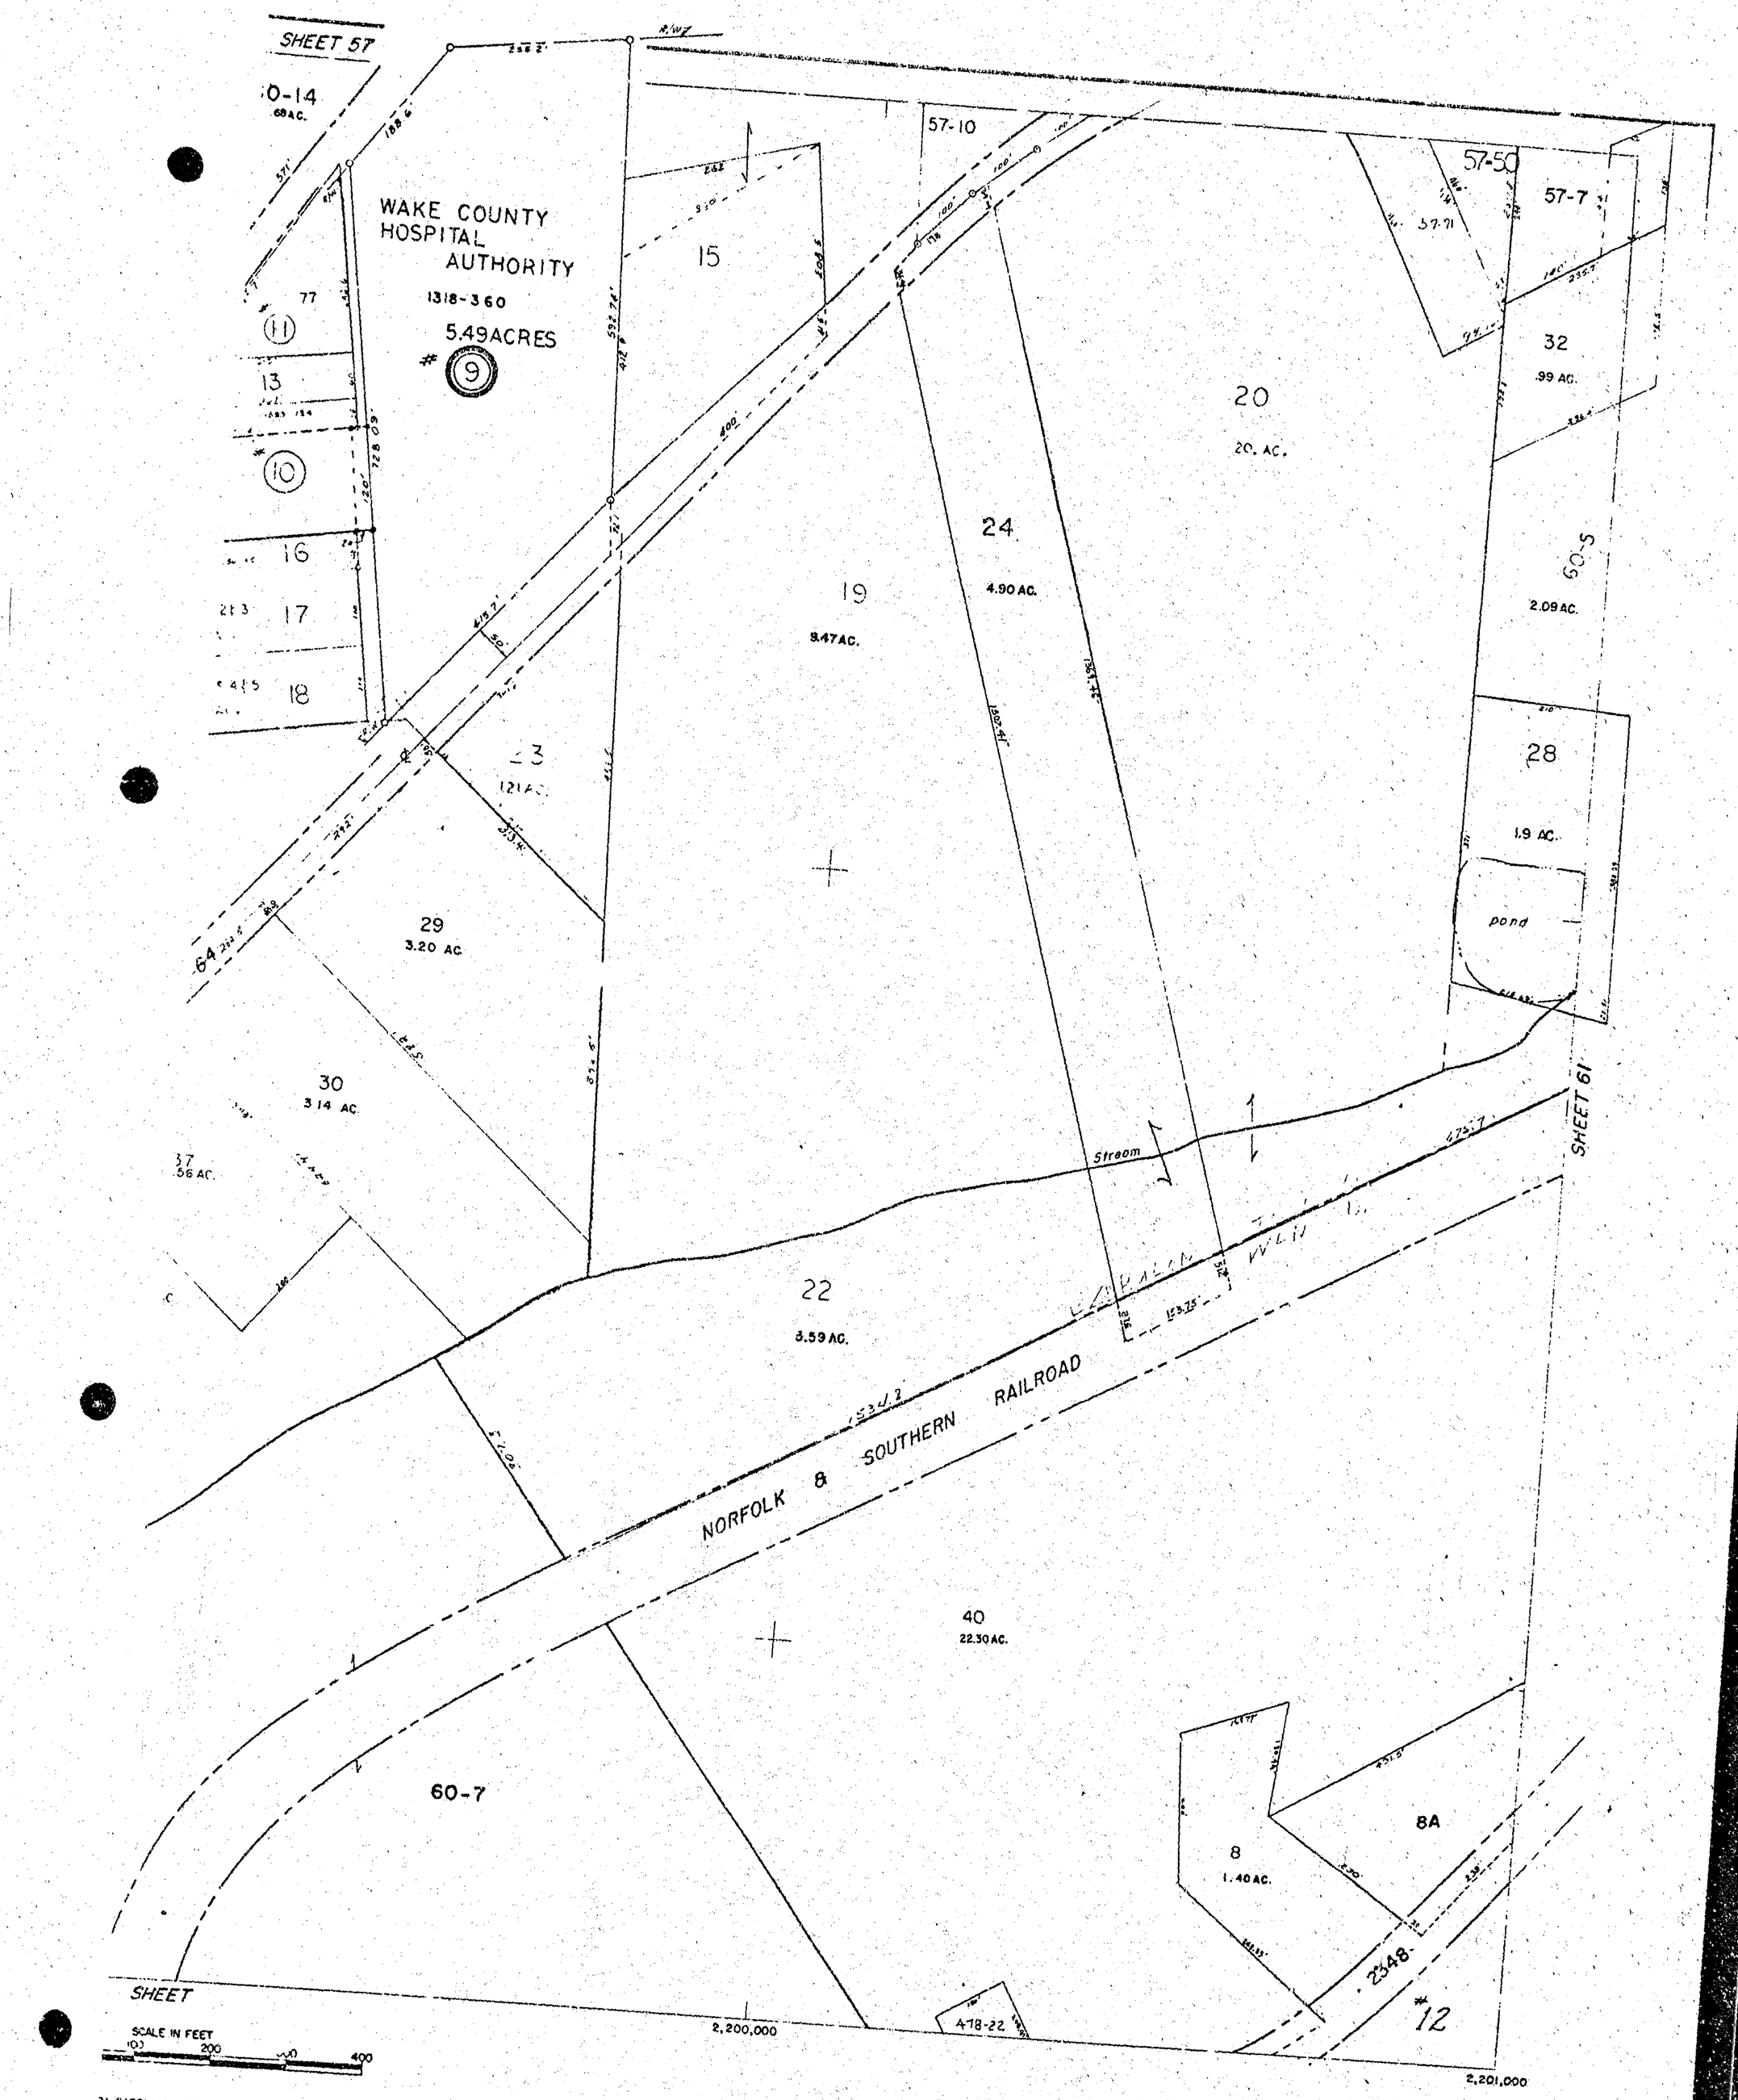
SHEET 57
10-14
.69 AC.
WAKE COUNTY HOSPITAL AUTHORITY
1318-360
5.49 ACRES
9
77
11
13
10
16
17
18
15
57-10
57-50
57-7
57-71
32
.99 AC.
20
20. AC.
24
4.90 AC.
19
9.47 AC.
28
1.9 AC.
pond
29
3.20 AC.
30
3.14 AC.
37
.56 AC.
22
8.59 AC.
Stream
NORFOLK & SOUTHERN RAILROAD
40
22.30 AC.
60-7
8
1.40 AC.
8A
12
SHEET 61
SHEET
SCALE IN FEET
100 200 400
2,200,000
2,201,000
H CAROLINA STATE PLANE COORDINATE SYSTEM
BOOTHE CO., INC., GREENSBORO, N.C.
AL SURVEYS, INC., LOUISVILLE, KY.
MAY 1956
ZEBULON, N.C.
SHEET 60
LAST No 1:
60

SHEET 58

754,000

SYCAMORE ST.

HORTON STREET

LIBERTY STREET

VANCE STREET

NORFOLK & SOUTHERN RAILWAY

WAKEFIELD STREET

NORTH ALLEY

(PROPOSED STREET)

60-32

60-28

60-40

60-12

60-8A

752,000

751,500

2,201,000

2,202,000

SHEET 60

SHEET 6

61-140

61-142

14.14 AC.

LAKE

ZEBULON

61


WAKE COUNTY

SCALE IN FEE

100 0 100

GRID IS BASED ON NORTH CAROLINA STAT

MAPPED BY: BOOTHE CO., INC.
PARK AERIAL SURVEYS, INC.
MAY 1958

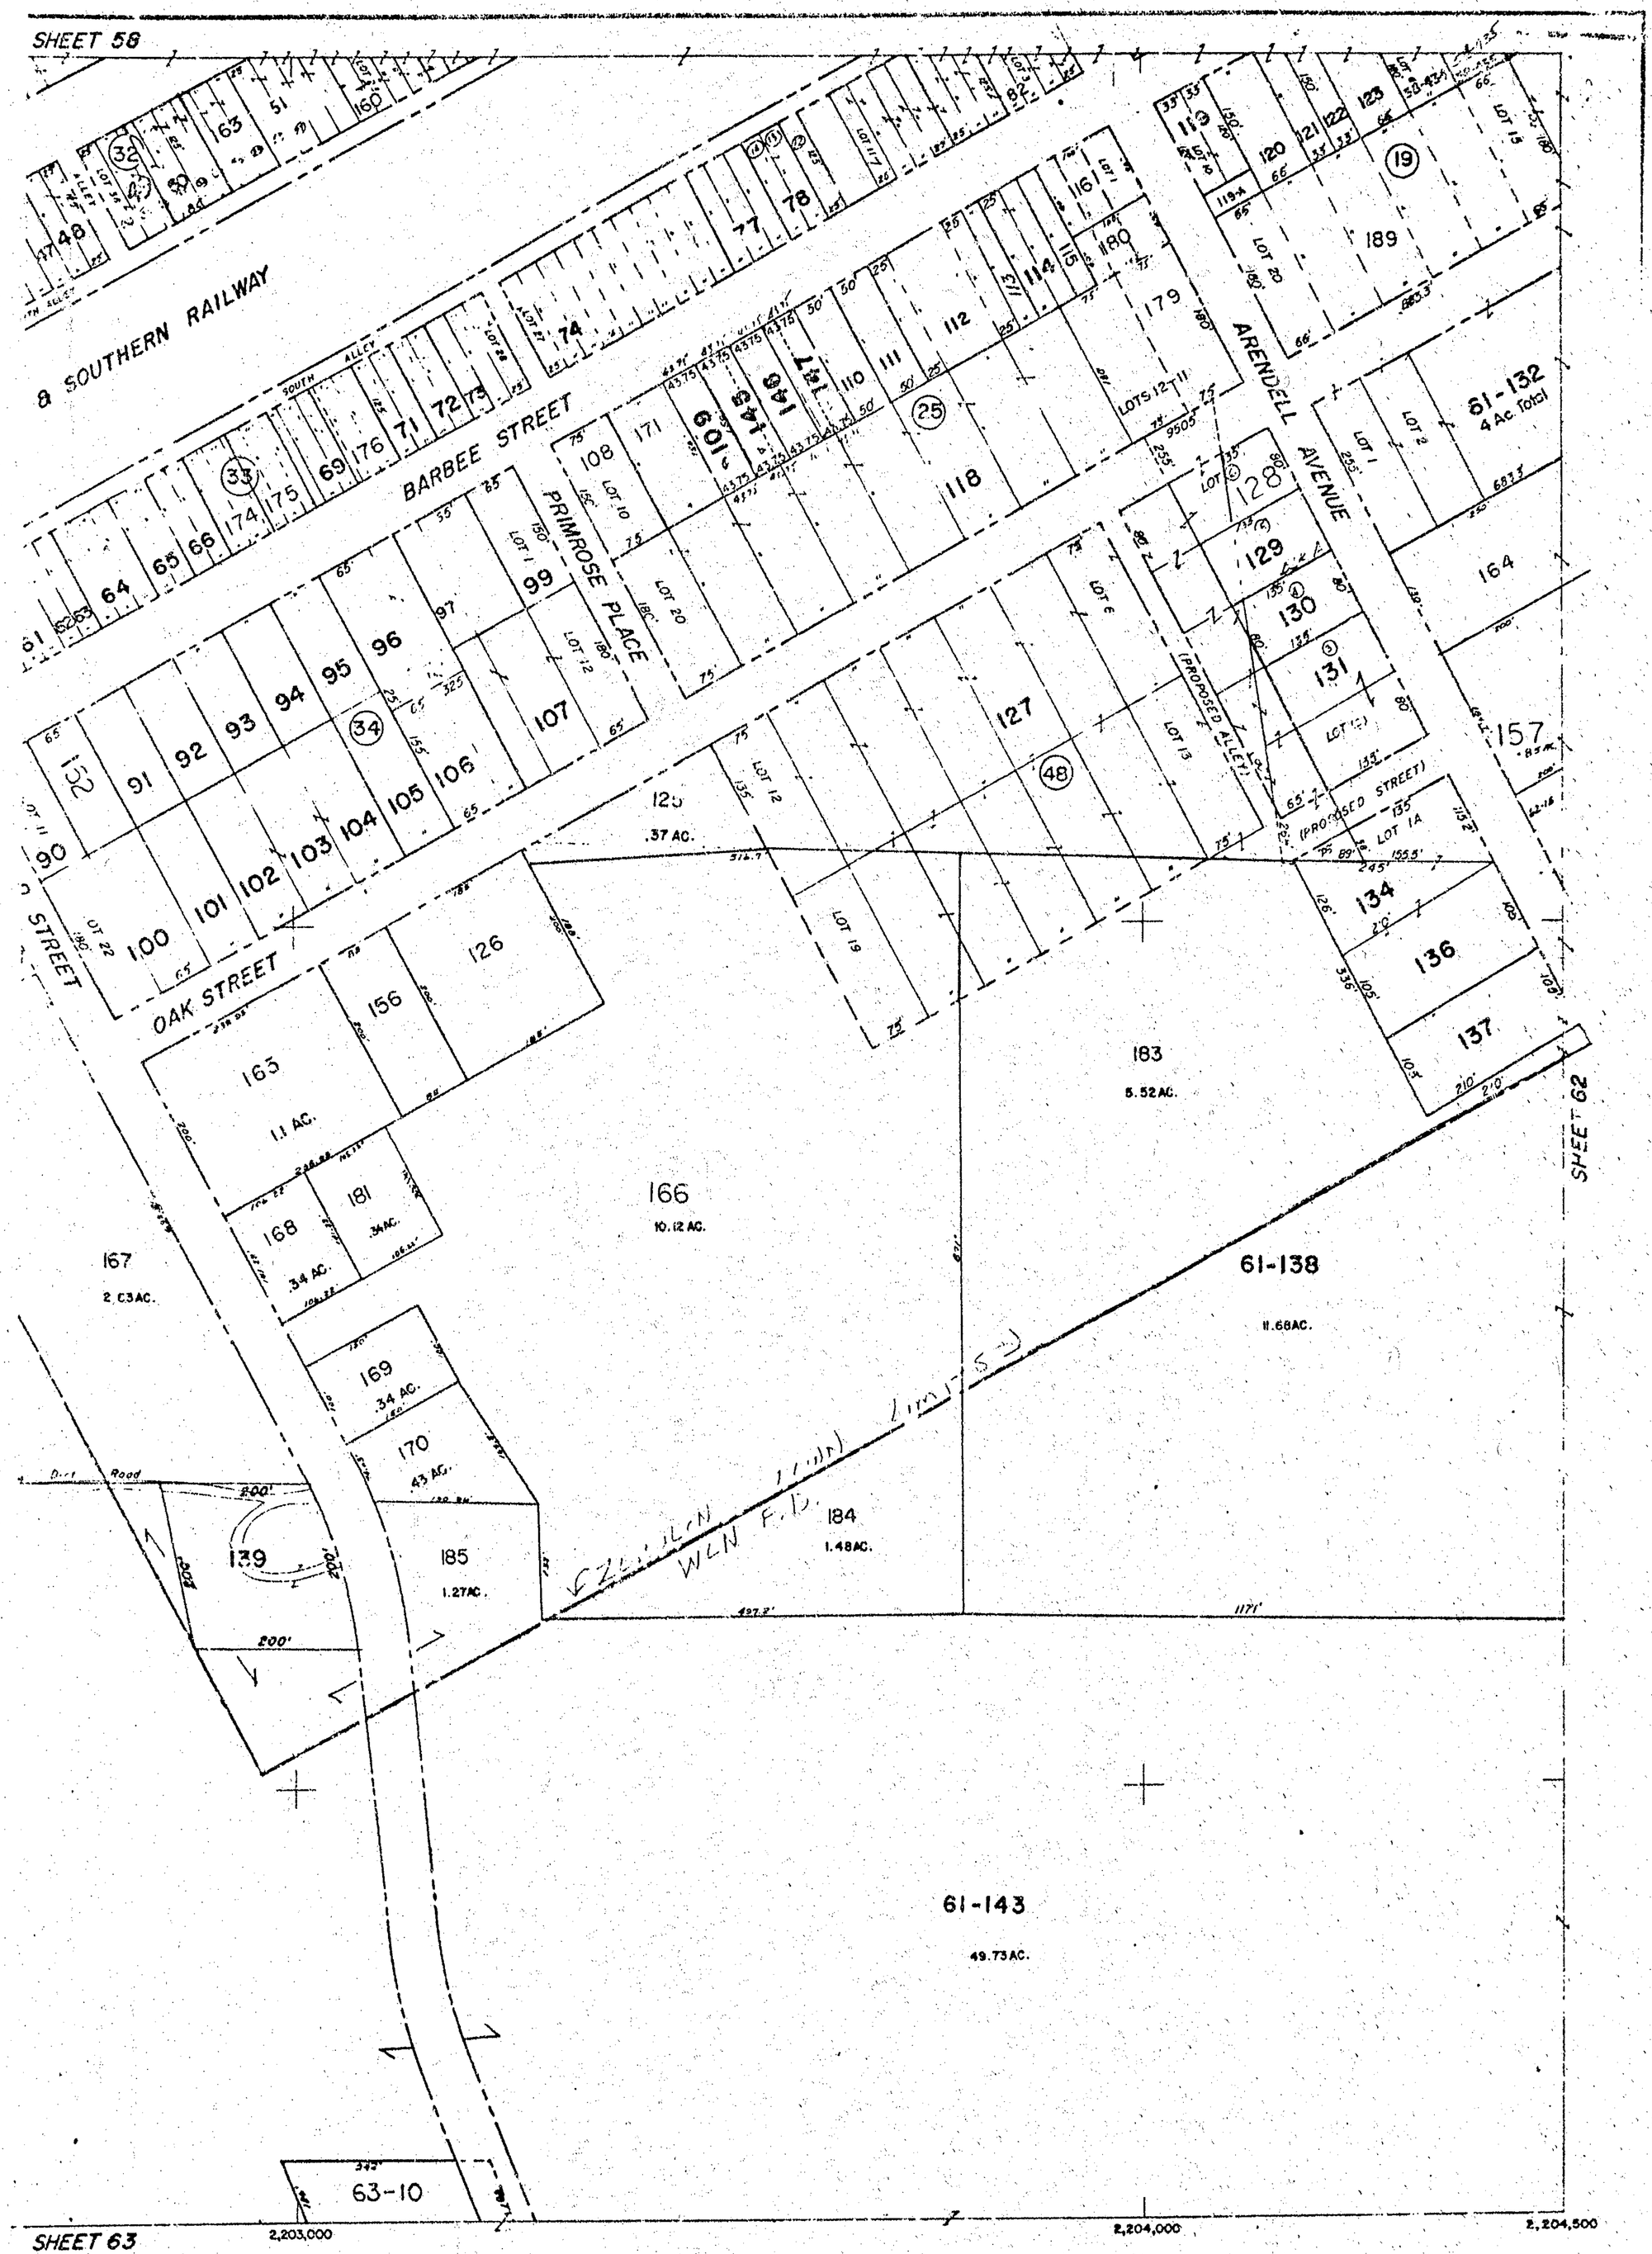

ZEBULON, N.C.

H CAROLINA STATE PLANE COORDINATE SYSTEM

BOOTHE CO., INC., GREENSBORO, N.C.
IL SURVEYS, INC., LOUISVILLE, KY.
MAY 1956

SHEET 61

LAST PG.

61

SHEET 59

754,000

19

61-122

15
23.6 AC.

59-107

59-113

61-163

61-157

N

CORPORATION LIMIT

18
1.69 AC.

1218.2'

460.7'
530'

11

12

753,000

14

SHEET 61

61-138

3
7.9 AC.

16
7.94 AC.

17
7.92 AC.

ARENDELL STREET

1171'

9
.92 Ac.

752,000

8
1 AC.

6
13.5 AC.

7
1.25 AC.

1053.16'

TR #1

10
10.16 AC.

64-1

751,500
2,204,500

2,205,000

2,206,000

SHEET 64

SCALE IN FEET
100 0 100 200

GRID IS BASED ON NORTH CAROLINA STATE F

MAPPED BY: BOOTHE CO., INC., G
PARK AERIAL SURVEYS, INC., L
MAY 1958

N

ZEBULON

62

WAKE COUNTY

SHEET 59

59-96

1
57.5 AC.

479-6

479-6

5
19.49 AC.

SHEET

2346

13
.51 Ac.

stream

64-3

64-4

64-5

64-6

728.4'

2,207,000

2,208,000

SHEET 64

SCALE IN FEET
100 200 300 400

NORTH CAROLINA STATE PLANE COORDINATE SYSTEM

BY: BOOTHE CO., INC., GREENSBORO, N.C.
AERIAL SURVEYS, INC., LOUISVILLE, KY.
MAY 1958

ZEBULON, N.C.

SHEET 62

Last # 19 62

751,500

61-140
W.H. GREEN

61-142
[illegible] COMBS

61

751,000

2
34.50 AC.
PAUL L. BROWN
1488-306

K. LINCO
TRIVETTE

478-6

SHEET 62

SAMUEL WINSTON

16
9.09 AC.
TRACT 3

750,000

478-3

19
10.34 AC.
TRACT 2

14
12.80 AC.
TRACT 1

508-1

508-4

749,000
2,201,000

2,202,000

SHEET

SCALE IN FEET
100 0 100 200

GRID IS BASED ON NORTH CAROLINA STATE PL

MAPPED BY: BOOTHE CO., INC., GR
PARK AERIAL SURVEYS, INC., LO
MAY 1958

ZEBULON

63 WAKE COUNTY

SHEET 61

61-143

10
1 AC.

4

11
1.16 AC.

1385.10

3

23.10 AC.

63-5
23.84 Ac. Total

1600'

5A
15. AC.

18
.40 AC.

8

9
S. P. GILL

2349

21
.65AC.

17
8.11AC.

20
.26AC.

13
.49 AC.

TRACK 'A'

15
1.13 AC.

63-7
60 Ac. Total

2351

SHEET 64

SHEET

2,203,000

2,204,000

2,204,500

SCALE IN FEET
100 200 300 400

ORTH CAROLINA STATE PLANE COORDINATE SYSTEM

BY: BOOTHE CO., INC., GREENSBORO, N.C.
ERIAL SURVEYS, INC., LOUISVILLE, KY.
MAY 1958

ZEBULON, N.C.

SHEET 63

LAST SHEET 63

SHEET 62

751,500

61-143

62-10

TR #2

10
9.89 AC.

63-5

64-1
20 Ac. Total

751,000

680'

SHEET 63

750,000

63-7

64-7
22 Ac. Total

64-8
22 Ac. Total

749,000
2,204,500

2,205,000

2,206,000

SHEET

SCALE IN FEET
100 0 100 200

GRID IS BASED ON NORTH CAROLINA STATE P

MAPPED BY: BOUTHE CO. INC., GA
PARK AERIAL SURVEYS, INC., LI
MAY 1958

ZEBULON

64 WAKE COUNTY

SHEET 62

64-3
14.2 Ac. Total

64-4
15 Ac. Total

64-5
15 Ac. Total

64-6
43.58AC.

14
.82 AC.

12
.87 AC.

13
.37 AC.

11

2347

479-14

479-15

SHEET

64-9
37.80 AC.

509-1

64-8
22 Ac. Total

509-5

SHEET

2,207,000

2,208,00

SCALE IN FEET
100 200 300 400

RTH CAROLINA STATE PLANE COORDINATE SYSTEM

Y BOOTHE CO., INC., GREENSBORO, N.C.
RIA. SURVEYS, INC., LOUISVILLE, KY.
MAY 1958

ZEBULON, N.C.

SHEET 64

LAST SHEET 64

SHEET

796,500

796,000

248-10

1699'

1
27.3 AC.
NEW SURVEY 29.68 Ac.

R. B. LEWIS

801'

SHEET

795,000

5
42.00 AC.

248-10

68-1

794,000
2,155,000

2,156,000

SHEET 6

SCALE IN FEE
100 0 100

GRID IS BASED ON NORTH CAROLINA STA

MAPPED BY: BOOTHE CO., INC.
PARK AERIAL SURVEYS, INC
MAY 1958

65

WAKE COUNTY

SHEET

1Ac.

2
14AC.

66-1

15.0

3
14AC

SHEET 66

5
.OC AC.

7
2.9AC.

266-5

SHEET 68

2,157,000

2,158,000

69-84

2,158,500

SCALE IN FEET
100 200 300 400

NORTH CAROLINA STATE PLANE COORDINATE SYSTEM

BY: BOOTHE CO., INC., GREENSBORO, N.C.
AERIAL SURVEYS, INC., LOUISVILLE, KY.
MAY 1958

ROLESVILLE, N.C.

LAST No: 8

SHEET 65

65

SHEET

796,500

796,000

795,500

794,000
2,158,500

2,159,000

2,160,000

50 AC.

249-18

26

25

24

23

22

21

20

19

18

17

3
34.57 AC.

TERESA DRIVE

TERESA DRIVE

SHEET 65

69-84

69-2

SHEET 6

SCALE IN FEET
100 0 100 200

GRID IS BASED ON NORTH CAROLINA STATE

MAPPED BY BOOTHE CO., INC.,
PARK AERIAL SURVEYS, INC.
MAY 1958

SHEET

249-13

57 AC.

33
.98 AC.

4
192 AC.

DRIVE

17

16

15

1945

35
1.13AC.

SHEET 67

6

14
1.56 AC.

8
.99 AC.

27
.71AC.

28
.71AC.

29
.71AC.

10

69-3

11

12

30
.63AC.

31
.63AC.

32
.63AC.

9
.99 AC.

69-86

SHEET 69

2,161,000

2,162,000

SCALE IN FEET
100 200 300 400

ORTH CAROLINA STATE PLANE COORDINATE SYSTEM

BY BOOTHE CO, INC, GREENSBORO, N.C.
ERIAL SURVEYS, INC, LOUISVILLE, KY
MAY 1958

ROLESVILLE, N.C.

SHEET 66

LAST No. 5

66

SHEET

796,500

66-4

796,000

SHEET 66

66-6

795,000

69-86

794,000
2,162,000

2,163,000

2

17.0 AC.

1

13.46.

13

9.79 AC.

18

2.20 AC.

70-1

10.00 AC.

15

7

67-9

70-6


SHEET 70

SCALE IN FEET
100 0 100 200

GRID IS BASED ON NORTH CAROLINA STATE PL

MAPPED BY: BOOTHE CO., INC., GR
PARK AERIAL SURVEYS, INC., LO
MAY 1958

67 WAKE COUNTY

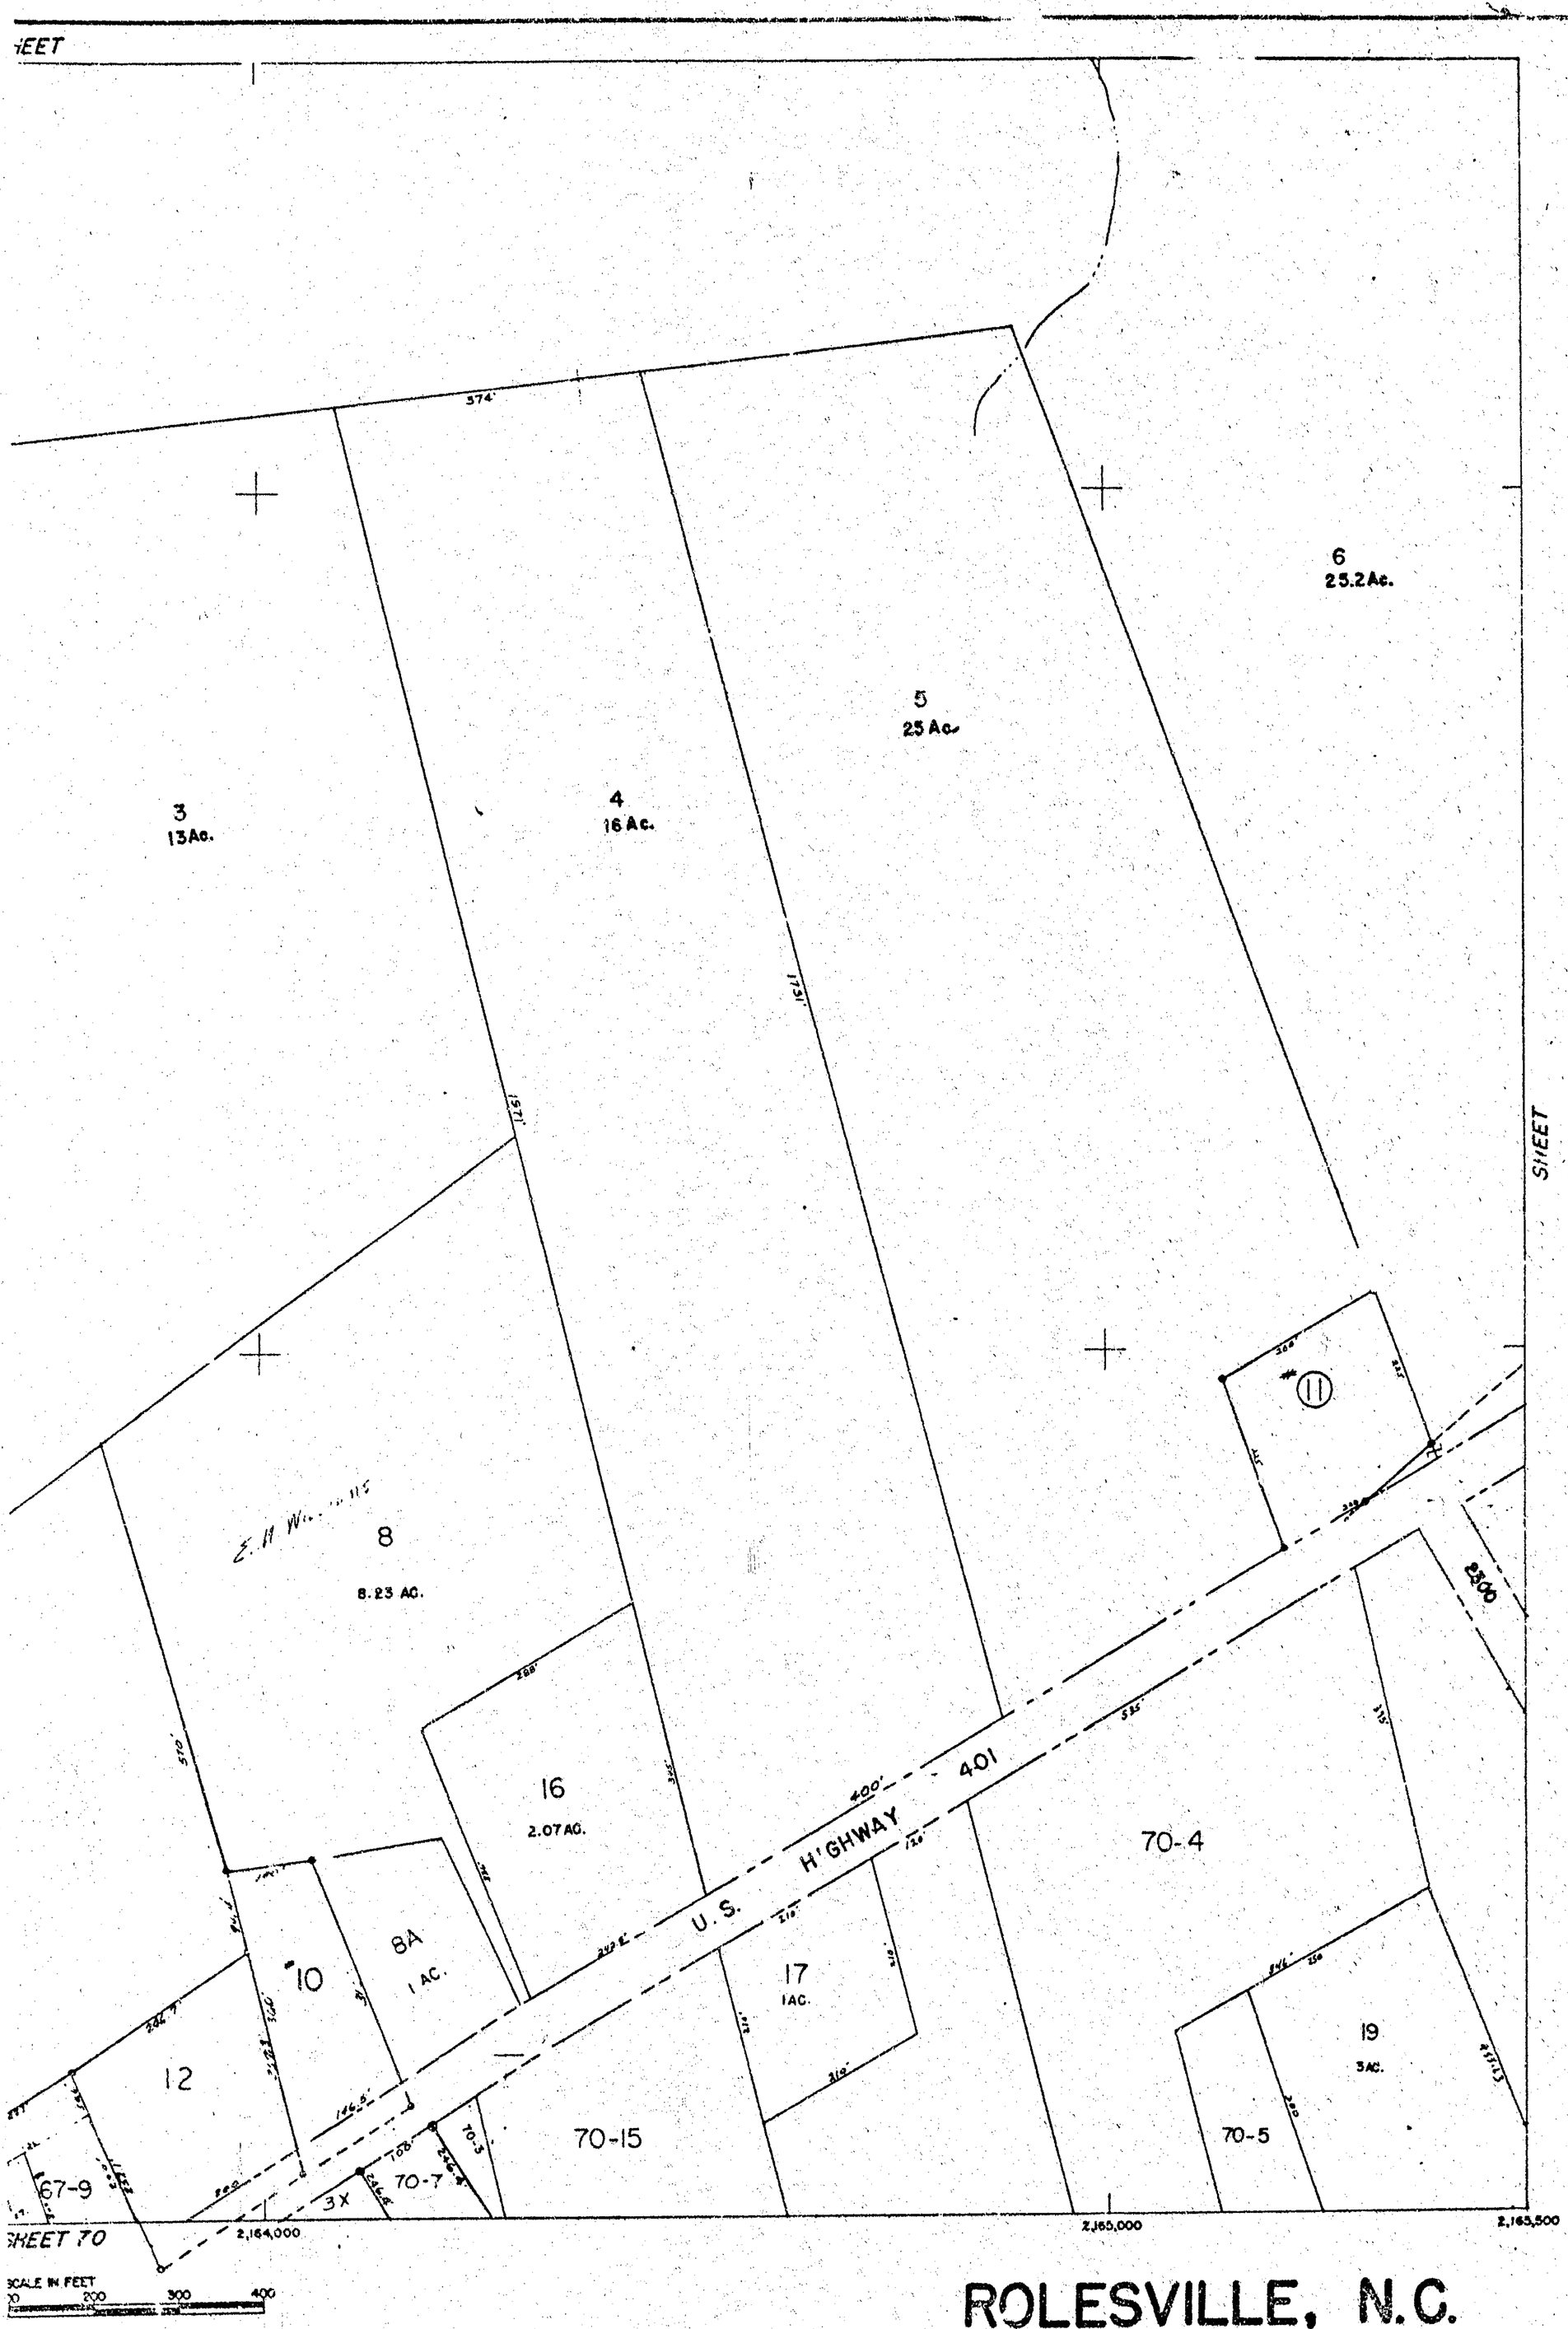

ROLINA STATE PLANE COORDINATE SYSTEM

HE CO., INC., GREENSBORO, N.C.
JRVEYS, INC., LOUISVILLE, KY.
MAY 1958

ROLESVILLE, N.C.

67

LAST No: 19

SHEET 67

67

SHEET 65

794,000

267-5

5
1.72 AC.

10
1.80 AC.

11
11AC.

68-1
71.38 AC. TOTAL

793,000

SHEET

9
5.05AC.

68-3
30.8 Ac. Total

792,000

2
90.09 AC.

791,500
2,155,000

2,156,000

ROLESVILLE

68 WAKE COUNTY

SHEET 71

SCALE IN FEET
100 0 100 200

GRID IS BASED ON NORTH CAROLINA STATE PL

MAPPED BY: BOOTHE CO., INC., GRE
PARK AERIAL SURVEYS, INC., LO
MAY 1958

SHEET 65

65-5

Stream

69-84

SHEET 69

68-4

41 Ac. Total

SHEET 71

2,157,000

2,158,000

2,158,500

SCALE IN FEET
100 200 300 400

RTH CAROLINA STATE PLANE COORDINATE SYSTEM

: BOOTHE CO., INC., GREENSBORO, N.C.
RIAL SURVEYS, INC., LOUISVILLE, KY.
MAY 1958

ROLESVILLE, N.C.

6

SHEET 68

LAST NO. #11 ... 68

SHEET 66

734,000

84
73.34 AC.

69-2
108.21 Ac. Total

Dirt Road

SPRING BRANCH

P/L

POND

793,000

1
25.48 AC.

SHEET 68

80
1 AC.

PROPOSED STREET

LOT 14 | LOT 10 | LOT 8 | LOT 6 | 8

LOT 11 | LOT 9 | LOT 7 | LOT 5

PROPOSED STREET

SCARBORO STREE

LOT 17 | LOT 15

79
.72 AC.

26

2.19 AC.

89
2.80 AC.

88
25.60 AC.

792,000

68-4

72-7

72-6

72-2

72-1

72-175

72-165

72-138

751.4' DEED

184.8' DEED

834.9'

2,158,500

2,158,000

2,160,000

SHEET 72

ROLESVILLE

SCALE IN FEET
100 0 100 200

GRID IS BASED ON NORTH CAROLINA STATE PL.

MAPPED BY BOOTHE CO. INC., CHAPEL HILL AERIAL SURVEYS, INC., LOUISVILLE, KY. MAY 1958

69 WAKE COUNTY

SHEET 66

66-9

72

73

74

75

76

63

69-3
24.43 AC.

LAKE

LAKE

LAKE

64

86
48.30AC.

62

44
6.70AC.

85
13.19AC.

1A
.5 AC.

8 LOT 4
78

16

LOT 5
LOT 1 18

STREET

ORO STREET

28

29
7.83 Ac
LOT 14

38
2.3 Ac.

30

31

26
2.19AC.

23

25

65

27

66

67

72-138

32

35

36

37

34

69-33

72-21

45

46

47

70

72-31

2,161,000

48 LOT 3

49

50 LOT 1

51

52

69-53

54
1.02AC.

55

56

57

58

59

40

42 LOT 2

LOT 4

81
1.49 AC.

82
.5AC.

83
.62AC.

87
.98 AC.

68

69
.29AC.

70-17

72-48

2,162,000

Dirt Road

NC #1003

HIGHWAY 91

WAKE FOREST STREET & STATE

LOUISBURG STREET

WILLIAMS STREET

U.S. HIGHWAY 401

SHEET 70

SHEET 72

SCALE IN FEET
100 200 300 400

AROLINA STATE PLANE COORDINATE SYSTEM

BOOTHE CO INC., C FENSBORO, N.C.
IAL SURVEYS, INC., LOUISVILLE, KY.
MAY 1958

ROLESVILLE, N.C.

SHEET 69

LAST No. 69

SHEET

794,000

70-1
13 Ac. Total

69-86

67-18

252.5

70-6
1.05AC.

67-7

239.38

139.95

U.S. HIGHWAY 401

12
1.11 AC.

14
.54AC.

11
.59AC.

200

730

180

240

POOLE ROAD

69-44

793,000

SHEET 69

2A

16
1.90 AC.

9

8

10
1.19 AC.

264.4

100

200

70-2
52.10AC.

1610.

17
6.90AC.

792,000

69-83

Dail Road

69-87

149.16

73-5

791,500
2,162,000

2,163,000

SHEE

ROLESVILLE

70

WAKE COUNTY

SCALE 1
100 0 100

GRID IS BASED ON NORTH CAROL

MAPPED BY: BOOTHE C
PARK AERIAL SURVEY
MAY

SHEET 67

67-7

67-9

3X
?

70-7
.6Ac.

67-19

15
10.8AC.

4
10.3AC.

5
6AC.

70-3
56.16AC Total

269-3

269-8

Lake

SHEET

SHEET 73

2,164,000

2,165,000

2,165,500

SCALE IN FEET
100 200 300 400

STH CAROLINA STATE PLANE COORDINATE SYSTEM

SOOTHE CO., INC., GREENSBORO, N.C.
RIAL SURVEYS, INC., LOUISVILLE, KY.
MAY 1956

ROLESVILLE, N.C.

LAST No: 1/

SHEET 70

70

SHEET 6

791,500

791,000

790,000

789,000
2,155,000

2,156,000

68-2

68-3

8
318 AC.

1
42.02 Ac.

74-1

SHEET

SHEET

SCALE IN FE
100 0 100

MAPPED BY: BOOTHE CO., INC
PARK AERIAL SURVEYS, INC
MAY 1956

ROLESVILLE

71

WAKE COUNTY

SHEET 68

8
3.18 AC.

Lake

68-4

72-175

72-144

72-166

FORESTVILLE ROAD

7
(5)

Lake

SHEET 72

72-16

2
61.75AC.

13
1.50AC.

10
1.9AC.

5

71-4
44.7AC.

6
4.23AC.

W. H. Wall Jr.
1.34 A. ±

U.S. HIGHWAY 401

310-1

12
1AC.

9
1.45 AC.

74-18

SHEET 74

2,157,000

2,158,000

2,158,500

SCALE IN FEET
0 100 200 300 400

ON NORTH CAROLINA STATE PLANE COORDINATE SYSTEM

PED BY: BOOTHE CO., INC., GREENSBORO, N.C.
RK AERIAL SURVEYS, INC., LOUISVILLE, KY.
MAY 1956

ROLESVILLE, N.C.

SHEET 71

LAST NO. 73 **71**

SHEET 6.

791,500

1
6.43AC.

165
7A

164
(12)

175
3.04 AC.

143
(6)
BLK. "B"

BROWN AVE.

158
(4)

160
(7)

162
(5A)

163
(6A)

170
(3)

150
(8)

155

156
(2)

147
(9)

144
(9)

166
.86 AC.

146
(1)

154

167
.58AC.
(7)

142
(6)

153

141
(3)

130
(2)

129

132
(1)

161
64 AC.

4

3

72-7
5.377 Ac. Total

72-6
2.37Ac. Total

138

137

131

72-2
9.5AC.

152
1.5 AC.

5

63

139

140

60

58

PERRY STREET

PERRY

94

169

95

82
(3)

84

96

06

11

10

57
12.18AC.

LOT 2

LOT 1

791,000

790,000

SHEET 71

72-16
6.56 Ac Total

FORESTVILLE RD.

SCHOOL ST.

51
6.32AC.

174
3.18AC.

550'±

171
.62AC.

125

79A
5AC.

126

127

128

61.46 Ac Total
LOT 13

72-79

Road

789,000

2,158,500

2,159,000

2,160,000

SHEET

SCALE IN F
100 0 100

GRID IS BASED ON NORTH CAROLINA ST

MAPPED BY: BOOTHE CO., I
PARK AERIAL SURVEYS, I
MAY 19

ROLESVILLE

72

WAKE COUNTY

SHEET 69

LOUISBURG ST.

PULLEY ST.

ROGERS ST.

CHURCH ST.

PERRY STREET

COLEY STREET

CIRCLE

NC #1003

72-168
11 AC.

72-81
Ac Total

Dirt Road

41 AC.
LOT 6

LOT 8

LOT 9

SHEET 73

SHEET 75

SCALE IN FEET
100 200 300 400

H CAROLINA STATE PLANE COORDINATE SYSTEM

BOOTHE CO., INC., GREENSBORO, N.C.
AL SURVEYS, INC., LOUISVILLE, KY.
MAY 1958

ROLESVILLE, N.C.

LAST NO: 1/5

SHEET 72

72

791,500

SHEET 70

660'

72-48

70-2

1610'

Stream

560'

791,000

70-17

1280'

5
23.41AC.

650'

2
21.27AC.

Lake

650'

3
52.16AC.

SHEET 72

72-81

790,000

6
3.73AC.

7
.84AC.

Dirt Road

Dirt Road

789,000
2,162,000

76-11

1446.63'

76-1

2,163,000

SHEET 76

ROLESVILLE

73

WAKE COUNTY

SCALE IN FEET
100 0 100 200

GRID IS BASED ON NORTH CAROLINA STATE PL

MAPPED BY: BOOTHE CO., INC., GRE
PARK AERIAL SURVEYS, INC., LO
MAY 1968

SHEET 70

Lake

269-8

Lake

Lake

73-4

40.2 Ac.± Total

3

52.16AC.

SHEET 73

76-2

SHEET 76

2,164,000

2,165,000

2,165,500

SCALE IN FEET
100 200 300 400

NORTH CAROLINA STATE PLANE COORDINATE SYSTEM

BY: BOOTHE CO., INC., GREENSBORO, N.C.
AERIAL SURVEYS, INC., LOUISVILLE, KY.
MAY 1958

ROLESVILLE, N.C.

LAST No. 7

SHEET 73

73

74-1
56.20 AC.


71-4


288-7

74-3
34.8 Ac. Total

SHEET

SHEET

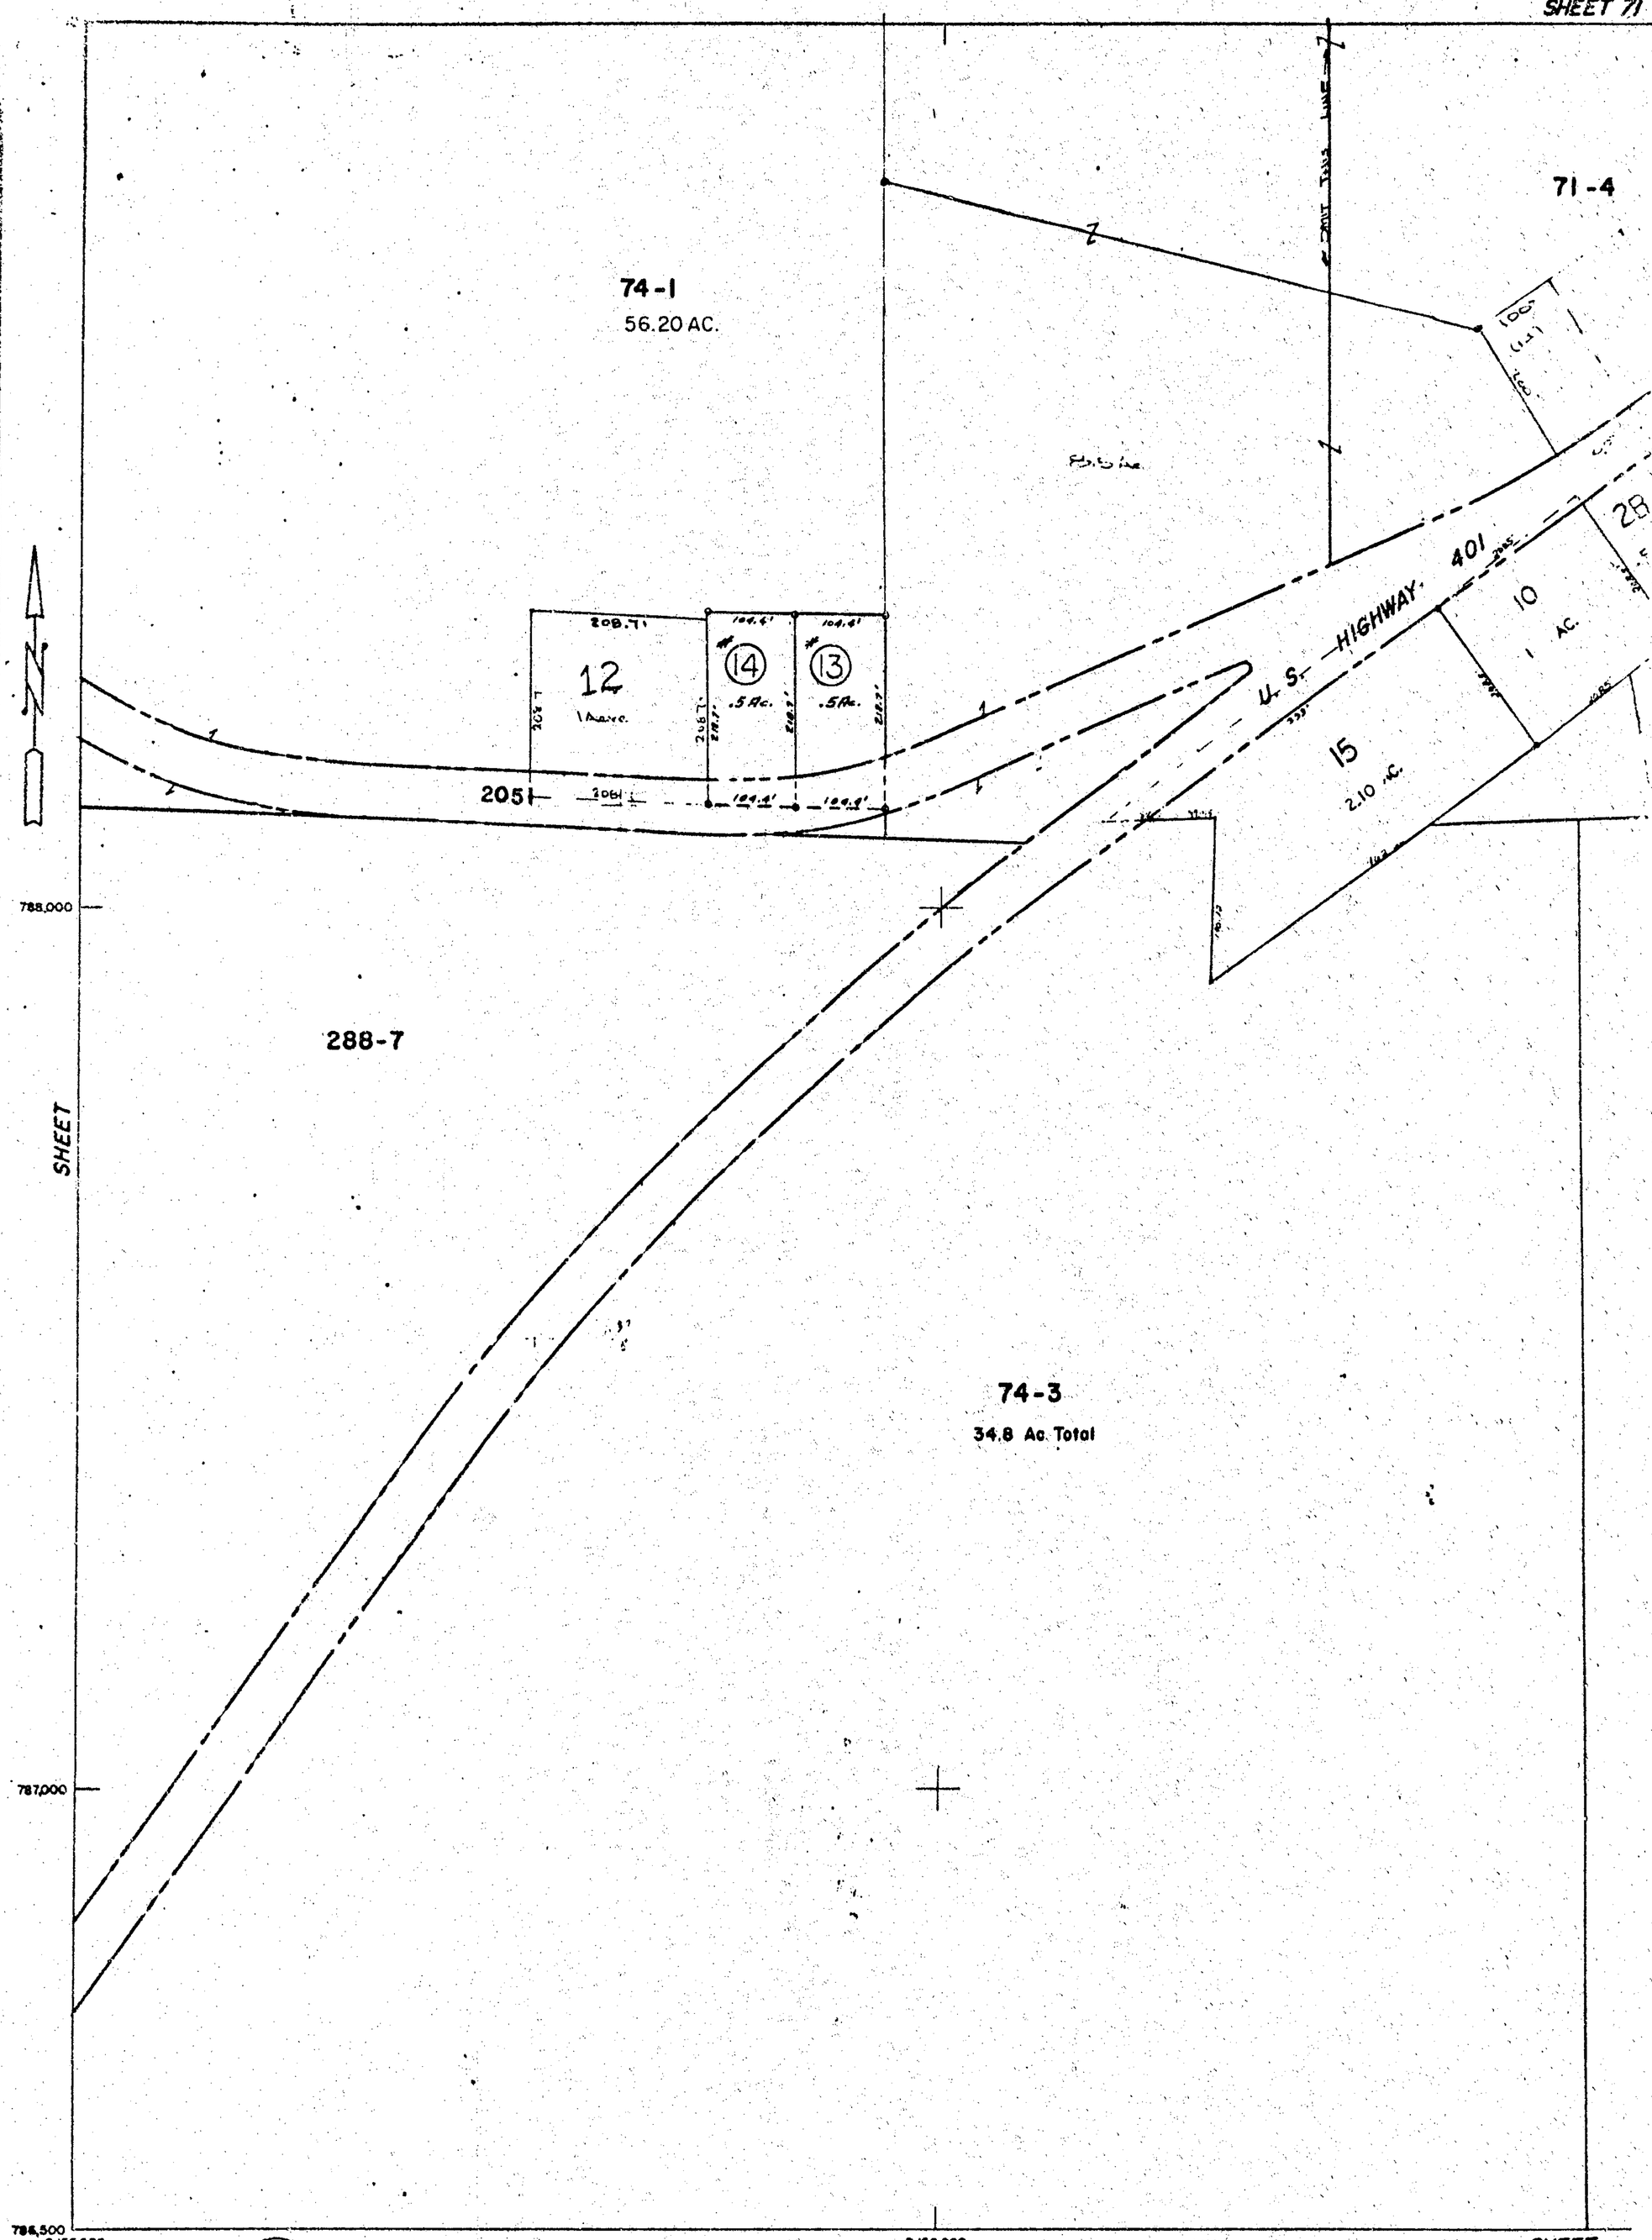

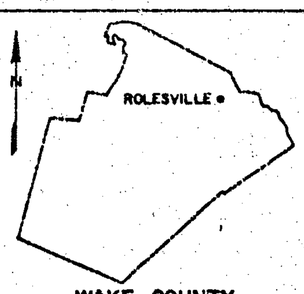

74
WAKE COUNTY

SCALE IN FEET
100 0 100 200

GRID IS BASED ON NORTH CAROLINA STATE

MAPPED BY: BOOTHE CO., INC.,
PARK AERIAL SURVEYS, INC.,
MAY 1958

SHEET 71

71-4

11 (9) 200' (S)

100'

2A 0.75 Ac.

19 .73 AC.

18 .97AC.

71-9

74-2
9.57.AC.

2B 1 AC.

2C 1.5 AC.

10 1 AC.

16 .5 AC.

17 1.505 AC.

310-1

74-4
63.7 Ac. Total

Stream

SHEET 75

SHEET

2,157,000

2,158,000

2,158,500

SCALE IN FEET
100 200 300 400

RTH CAROLINA STATE PLANE COORDINATE SYSTEM

: BOOTHE CO., INC., GREENSBORO, N.C.
RIAL SURVEYS, INC., LOUISVILLE, KY.
MAY 1958

ROLESVILLE, N.C.

LAST No: 19

SHEET 74

74

SHEET 72

789,000

180'

72-79
LOT 13

LAKE

1500'

310-1

788,000

SHEET 74

2461'

LAKE

448'

410'

Branch

Powells

Called 618

787,000

786,500

2,158,500

2,159,000

2,160,000

SHEET

SCALE IN FEET
100 0 100 200

GRID IS BASED ON NORTH CAROLINA STATE PLA

MAPPED BY: BOOTHE CO., INC., GREE
PARK AERIAL SURVEYS, INC., LOU
MAY 1958

ROLESVILLE

75 WAKE COUNTY

SHEET 72

LOT 8

72-172

LOT 9

554'

LAKE

1354'

3

3815'

75-1

105.73 Ac. Total

LOT 10

LAKE

3605'

LOT 11

3020'

75-2

37 Ac. Total

LOT 12

LAKE

LAKE

SHEET 76

SHEET

2,161,000

2,162,000

SCALE IN FEET
100 200 300 400

RTH CAROLINA STATE PLANE COORDINATE SYSTEM

r: BOOTHE CO., INC., GREENSBORO, N.C.
RIAL SURVEYS, INC., LOUISVILLE, KY.
MAY 1958

ROLESVILLE, N.C.

7:

SHEET 75

#3 75

789,000

Lake

11

600'

LOT 10

1A

2 AC.

3

5

.73 Ac.

650'

34.8 AC.

1

8

1 AC.

7

1 AC.

2306

75-1

LOT 11

788,000

9

1.27 AC.

ROLESVILLE HIGHWAY

SHEET 75

75-2

LOT 12

1003

787,000

289-3

786,500

2,162,000

2,163,000

SHEET

ROLESVILLE


SCALE IN FEET

100 0 100 200

GRID IS BASED ON NORTH CAROLINA STATE

MAPPED BY: BOOTHE CO., INC., &
PARK AERIAL SURVEYS, INC.,
MAY 1958

EET 73

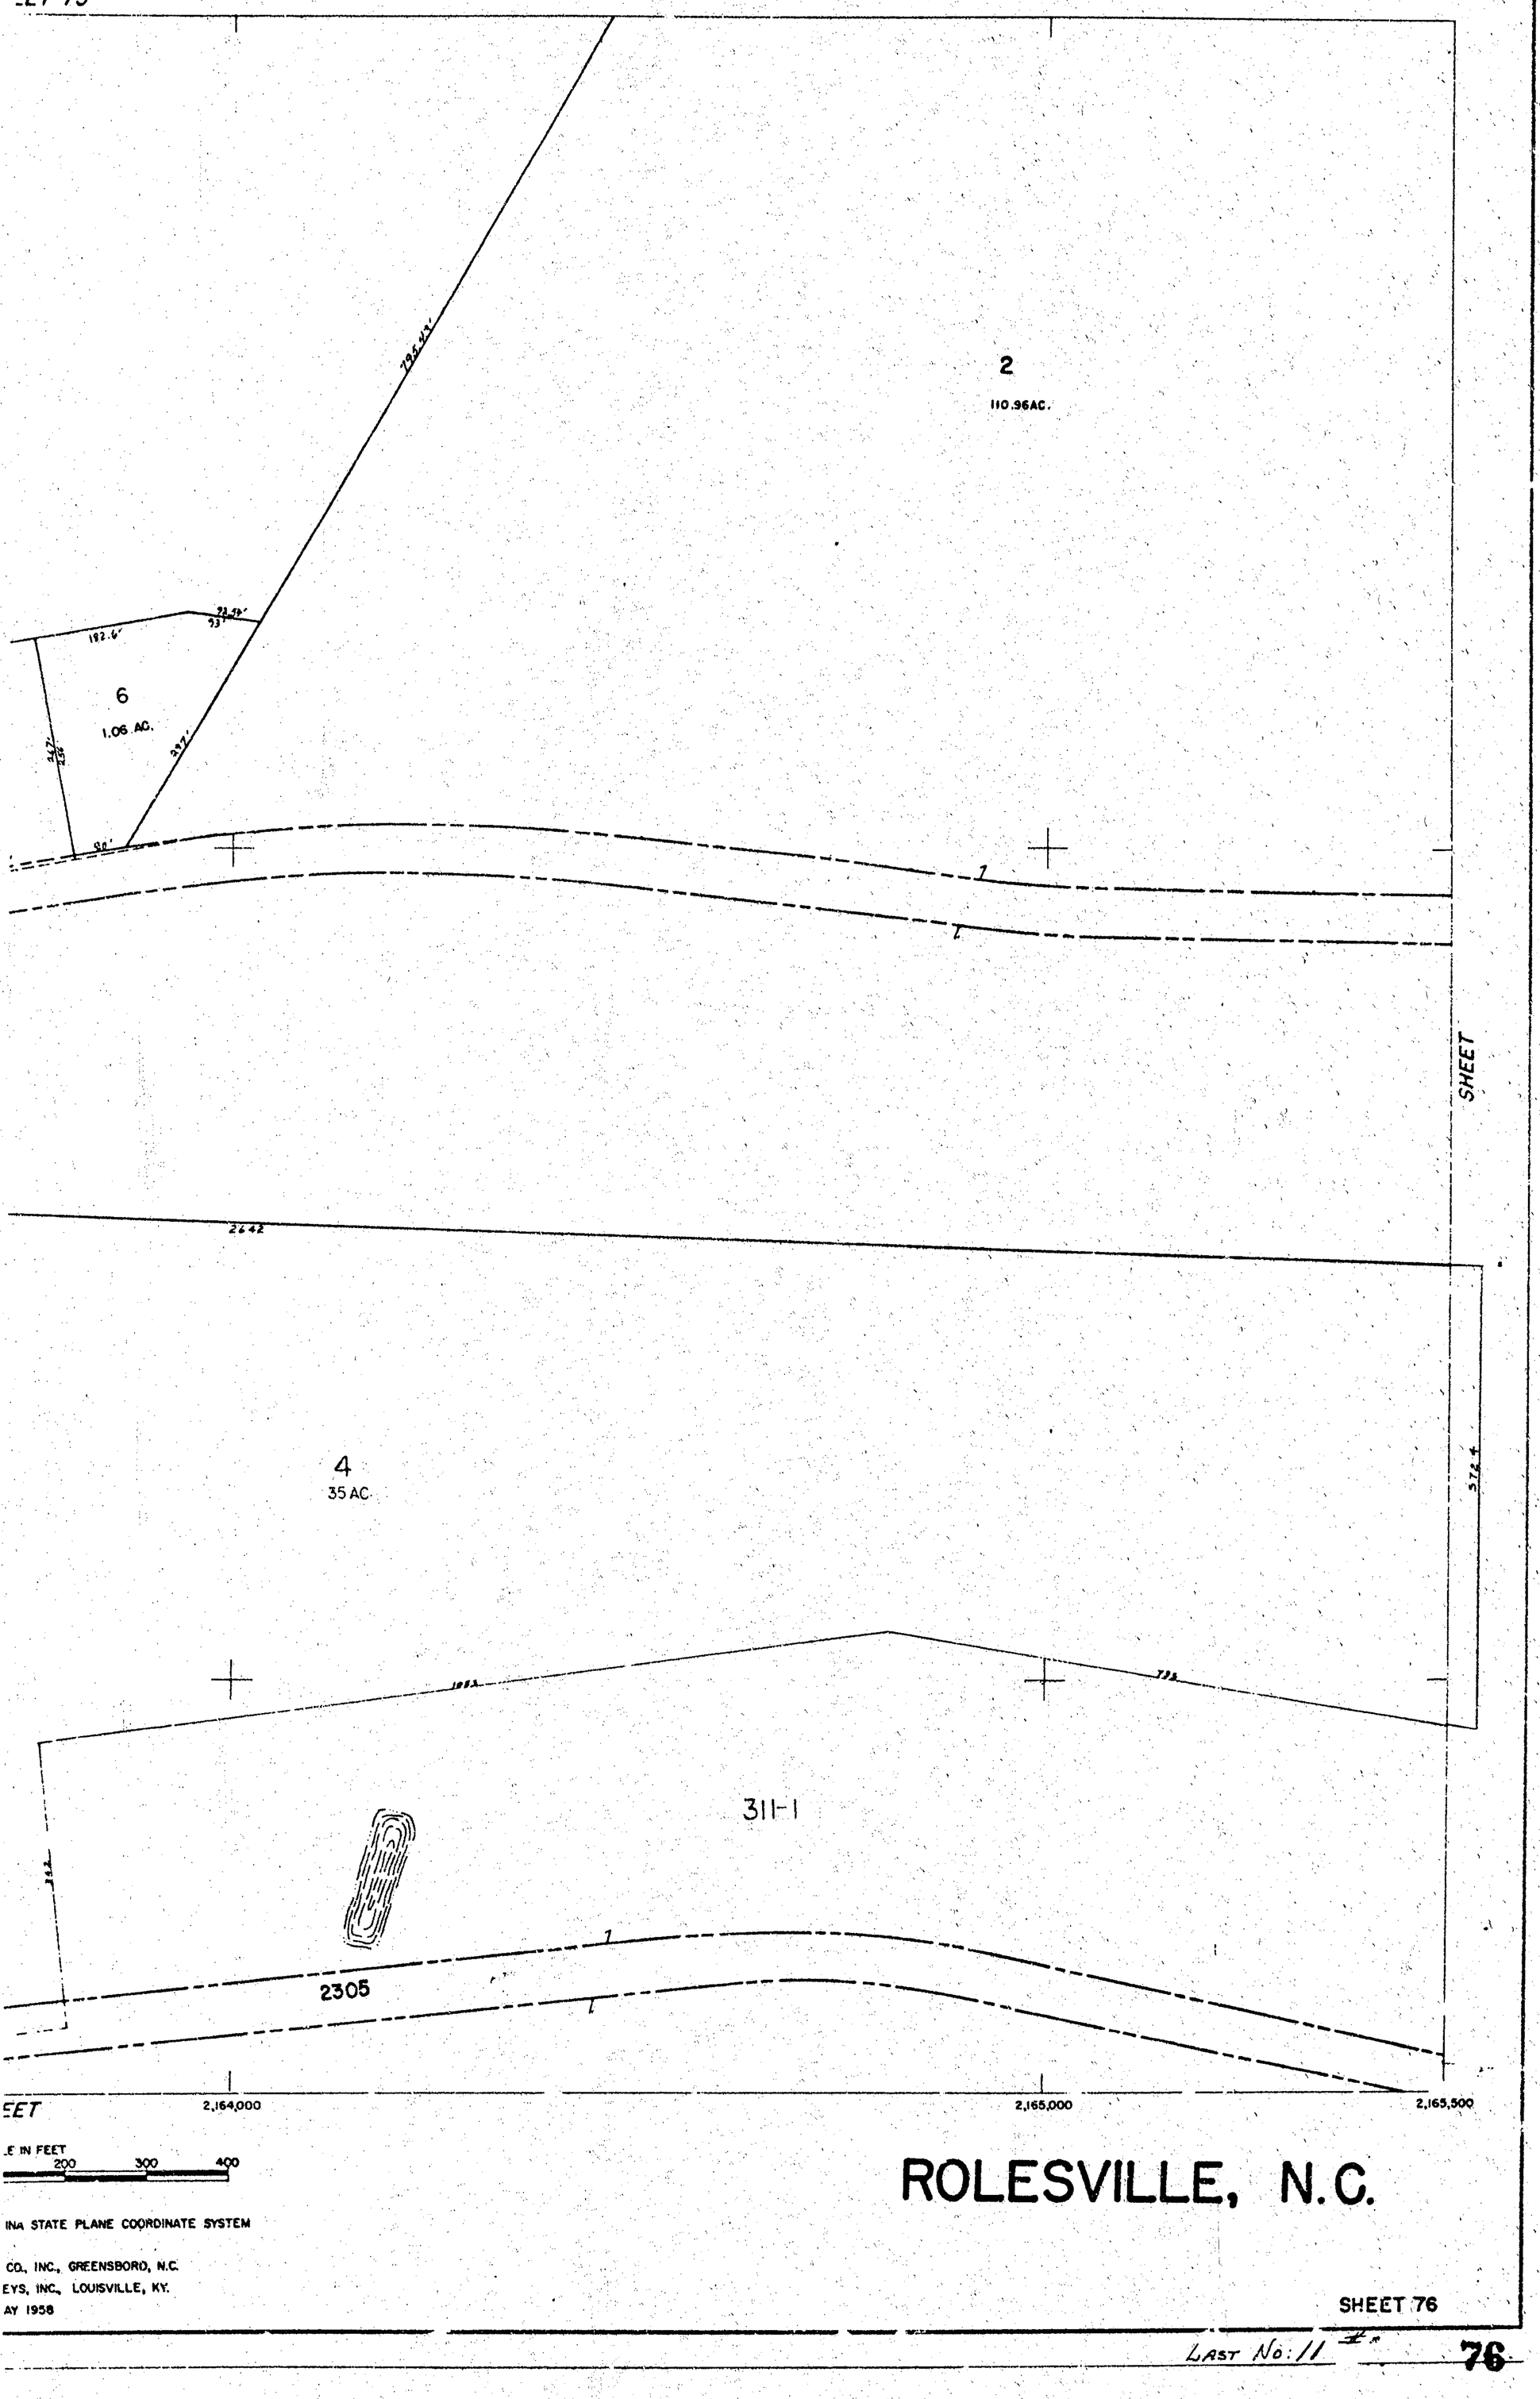

E IN FEET
200 300 400

INA STATE PLANE COORDINATE SYSTEM

CO., INC., GREENSBORO, N.C.
EYS, INC., LOUISVILLE, KY.
AY 1958

ROLESVILLE, N.C.

SHEET 76

LAST NO: 11

76

SHEET 5

745,500

505-18

8

9

10

16
.50 AC.

1.2 AC.

11

1B
1.3 AC.

1C
1.3 AC.

13
1.3 AC.

2
15.93 AC.

778

743,000

505-20
46.97AC.

A. P. Dean

15
.98 AC.

14
.52 AC.

17
.46AC.

U. S. HWY. 64

pond

SHEET 534

744,000

534-6

6
19.25AC.

WE Line

2364

2.54 AC.

743,000
2,182,000

2,183,000

SHEET

SCALE IN F
100 0 100

GRID IS BASED ON NORTH CAROLINA S

MAPPED BY: BOOTHE CO. I
PARK AERIAL SURVEYS,
MAY 19

77 WAKE COUNTY

SHEET 505

SHEET 506

2
15.53 AC.

3
33.13 AC.

2A
9.95 AC

2B
9.95 AC.

2C
9.95 AC.

78-2

4
9.95 AC.

5
9.95 AC.

2329

SHEET 78

12
2.59 AC.

18
1.76 AC.

7
35.36 AC.

7A

77F

WENDELL HOLMES F.D.

80-184

80-2

80-3

2,184,000

2,185,000

2,185,500

SHEET 80

SCALE IN FEET
100 200 300 400

NORTH CAROLINA STATE PLANE COORDINATE SYSTEM

BY: BOOTHE CO., INC., GREENSBORO, N.C.
AERIAL SURVEYS, INC., LOUISVILLE, KY.
MAY 1958

WENDELL, N.C.

SHEET 77

77

SHEET 5

745,500

77-2A

77-2B

77-2C

745,000

2
9.95AC.

77-4

2A

SHEET 77

77-5

3
29.81AC.

①

744,000

3A
.78AC.

PROPOSED ST.

36
.88 AC.

㉑

33
BLK. A

pond

506-11

pond

②

4
27.8 AC.

lake

4A
1 AC.

lake

23
22.75AC.

WENDELL CITY LIMITS

34
12.4 AC.

81-459

BLOCK-E

19

18

20

2

SHEET 81

81-447 | 81-441 | 81-443 | 81-440 | 81-444

743,000
2,185,500

2,186,000

WENDELL-HOLMES F.D.

WENDELL TOWN LIMITS

2,187,000

SCALE IN FEET
100 0 100 200

GRID IS BASED ON NORTH CAROLINA STATE

MAPPED BY: BOOTHE CO., INC.
PARK AERIAL SURVEYS, INC.
MAY 1958

78 WAKE COUNTY

SHEET 5)o

pond

506-11

506-12

62.31 AC.

154.1'

74.4

86.2

228.2

6

7

198.5

108.1

376.3

124.3

205.67

100

5

1.292 Ac.

214.2'

250

38

1.23AC.

1

7A

1 AC

lake

4

27.8 AC.

27.4 AC.

41

1.13AC.

35

1.06 AC.

79-14

SHEET 79

79-15

40

1.35AC.

39

1.15 AC.

3063.3

78 H

34

81-3

67.4 AC.

BLOCK-E

19

20

43

.84 AC.

18

21

37

SHEET 81

pond

2,188,000

2,189,00

SCALE IN FEET

100 200 300 400

WENDELL, N.C.

NORTH CAROLINA STATE PLANE COORDINATE SYSTEM

BY: BOOTHE CO., INC., GREENSBORO, N.C.
AERIAL SURVEYS, INC., LOUISVILLE, KY.
MAY 1958

SHEET 78

Lot No 43. 78

SHEET 5

745,500

745,000

744,000

78-7

78-7A

506-12

14
1.33AC.

SHEET 78

15
1.99AC.

506-13

pond

6

1
35.92 AC.

12
1 AC.

13
1 AC.

2
24.79 AC.

2359

11
.61 AC.

3
1AC.

9
1.75 A.C.

78-39

81-3

Z ROAD

WENDELL

2,189,000

2,190,000

SHEET 82

SCALE IN FEET
100 0 100 200

GRID IS BASED ON NORTH CAROLINA STATE PLA

MAPPED BY: BOOTHE CO., INC., GREE
PARK AERIAL SURVEYS, INC., LOUI
MAY 1958

79 WAKE COUNTY

SHEET 5

507-16

507-7

P/L.

4
34AC.

536-2

SHEET 536

7

82-18

Lake

U.S. HWY. 64

500'

400'

500'

⑦
4.59 AC.

SHEET 82

2,191,000

2,192,000

2,192,500

SCALE IN FEET
100 200 300 400

TH CAROLINA STATE PLANE COORDINATE SYSTEM

BOOTHE CO., INC., GREENSBORO, N.C.
IAL SURVEYS, INC., LOUISVILLE, KY.
MAY 1958

WENDELL, N.C.

SHEET 79

LAST #15 79

SHEET 7

743,000

534-6

77-6

534-13

742,000

741,000

534-19

83-24

740,500

2,182,000

2,183,000

SHEET 8

SCALE IN FEET


100 0 100

GRID IS BASED ON NORTH CAROLINA STATE PLANE COORDINATES

MAPPED BY: BOOTHE CO., INC.
PARK AERIAL SURVEYS, INC.
MAY 1956

WENDELL

80 WAKE COUNTY

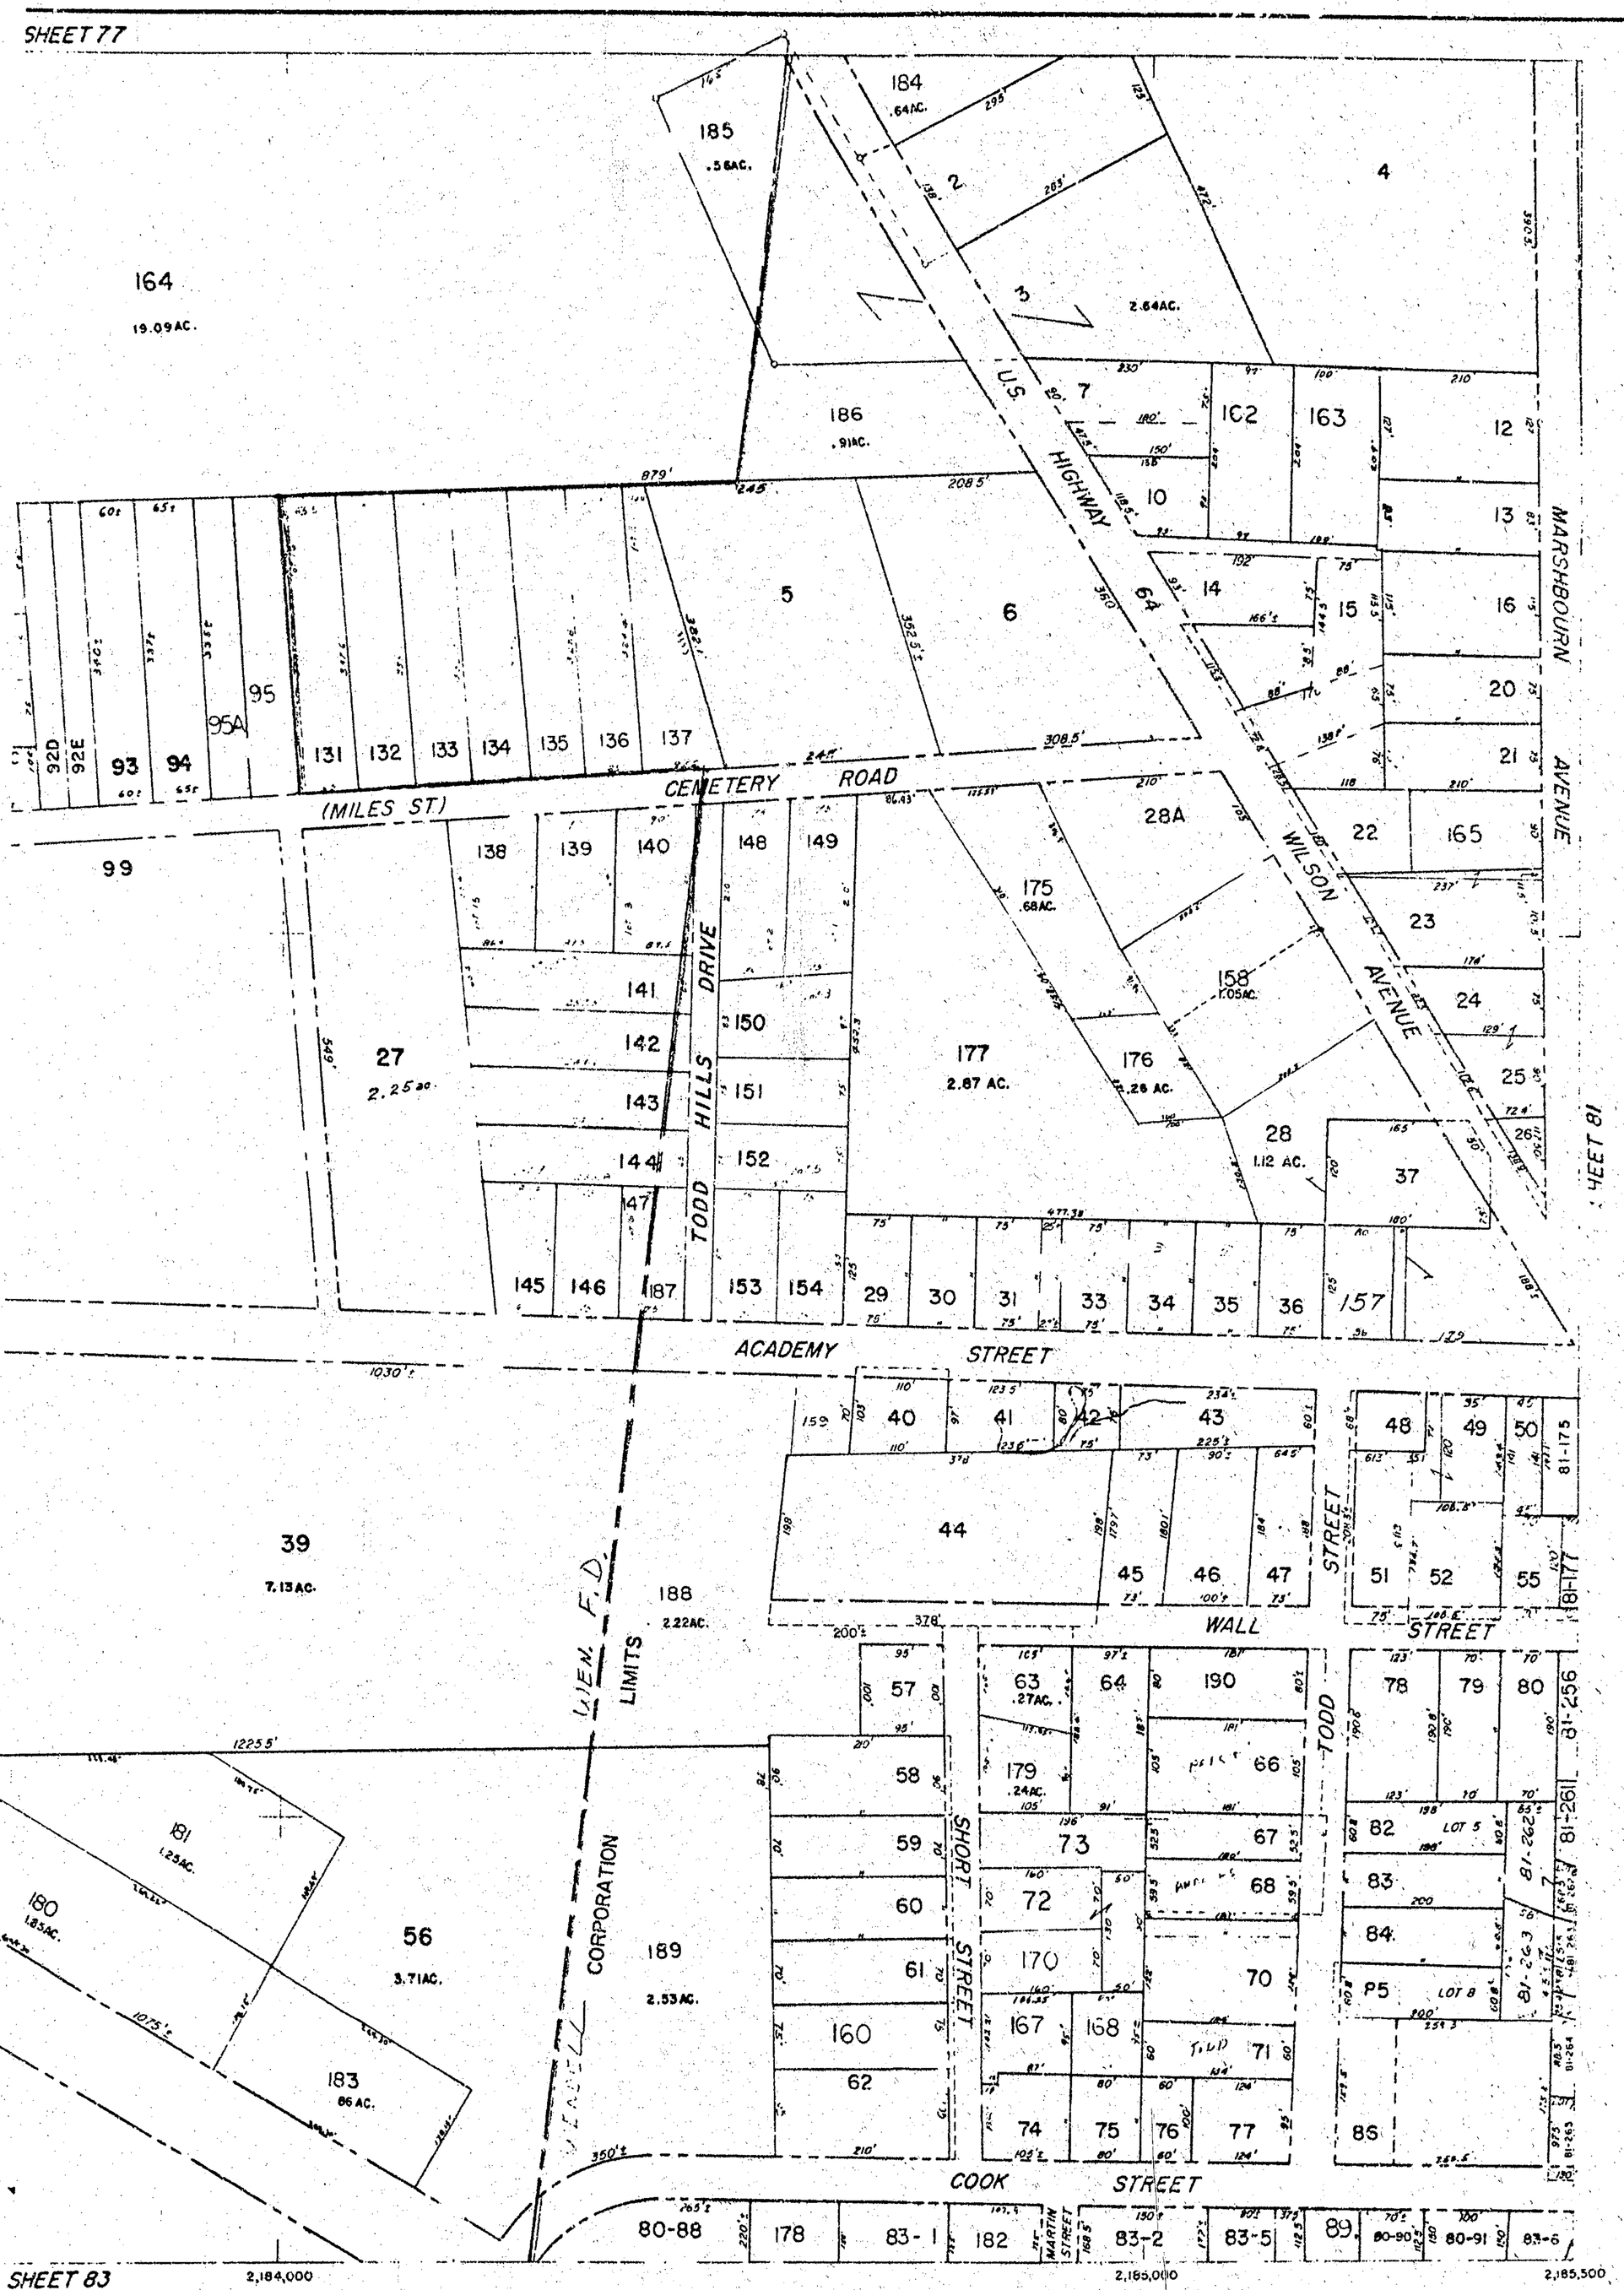

SCALE IN FEET
100 200 300 400

CAROLINA STATE PLANE COORDINATE SYSTEM

OOTHE CO., INC., GREENSBORO, N.C.
. SURVEYS, INC., LOUISVILLE, KY.
MAY 1956

WENDELL, N.C.

SHEET 80

LAST No. 191

80

SHEET 78

SHEET 80

SHEET 82

STRATFORD DR.

LOTS 1&2 447 BLK. A | LOTS 3&4 441 BLK. A. | LOTS 5&6 443 BLK. A. | LOTS 7&8 440 BLK. A. | LOTS 9&10 444 BLK. A.

LOTS 1&2 438 "BLOCK B" | 439 | LOTS 5&6 449 | LOTS 7&8 442 | LOTS 9&10 445 BLK. B | LOTS 11&12 446 BLK. B.

459 12.12 AC.

462 .80 AC.

NOWELL ST.

POPLAR STREET

ANDERSON STREET

WHITLEY AVENUE

MAPLE STREET

CYPRESS STREET

ACADEMY STREET

WALL ST

U.S. HIGHWAY 64

BUFFALO STREET

COOK STREET

FIFTH STREET

MAGNOLIA STREET

WILSON STREET

MAIN STREET

NORTH AVENUE

WENDELL

SCALE IN FEET 100 0 100 200

GRID IS BASED ON NORTH CAROLINA STATE

MAPPED BY: BOOTHE CO., INC., G
PARK AERIAL SURVEYS, INC., I
MAY 1958

81 WAKE COUNTY

SHEET 78

81-3
62.66AC.

81B

WENDELL CORPORATION LIMITS

458
5.56AC.

434
1.63 AC.

165
13.94AC.

SHEET 82

ACADEMY STREET

MATTOX AVENUE

US HIGHWAY 64

ZEBULON ROAD

SHEET 81

SCALE IN FEET
00 200 300 400


CAROLINA STATE PLANE COORDINATE SYSTEM

THE CO., INC., GREENSBORO, N.C.
URVEYS, INC., LOUISVILLE, KY.
MAY 1958

WENDELL, N.C.

SHEET 81

LAST No. 81

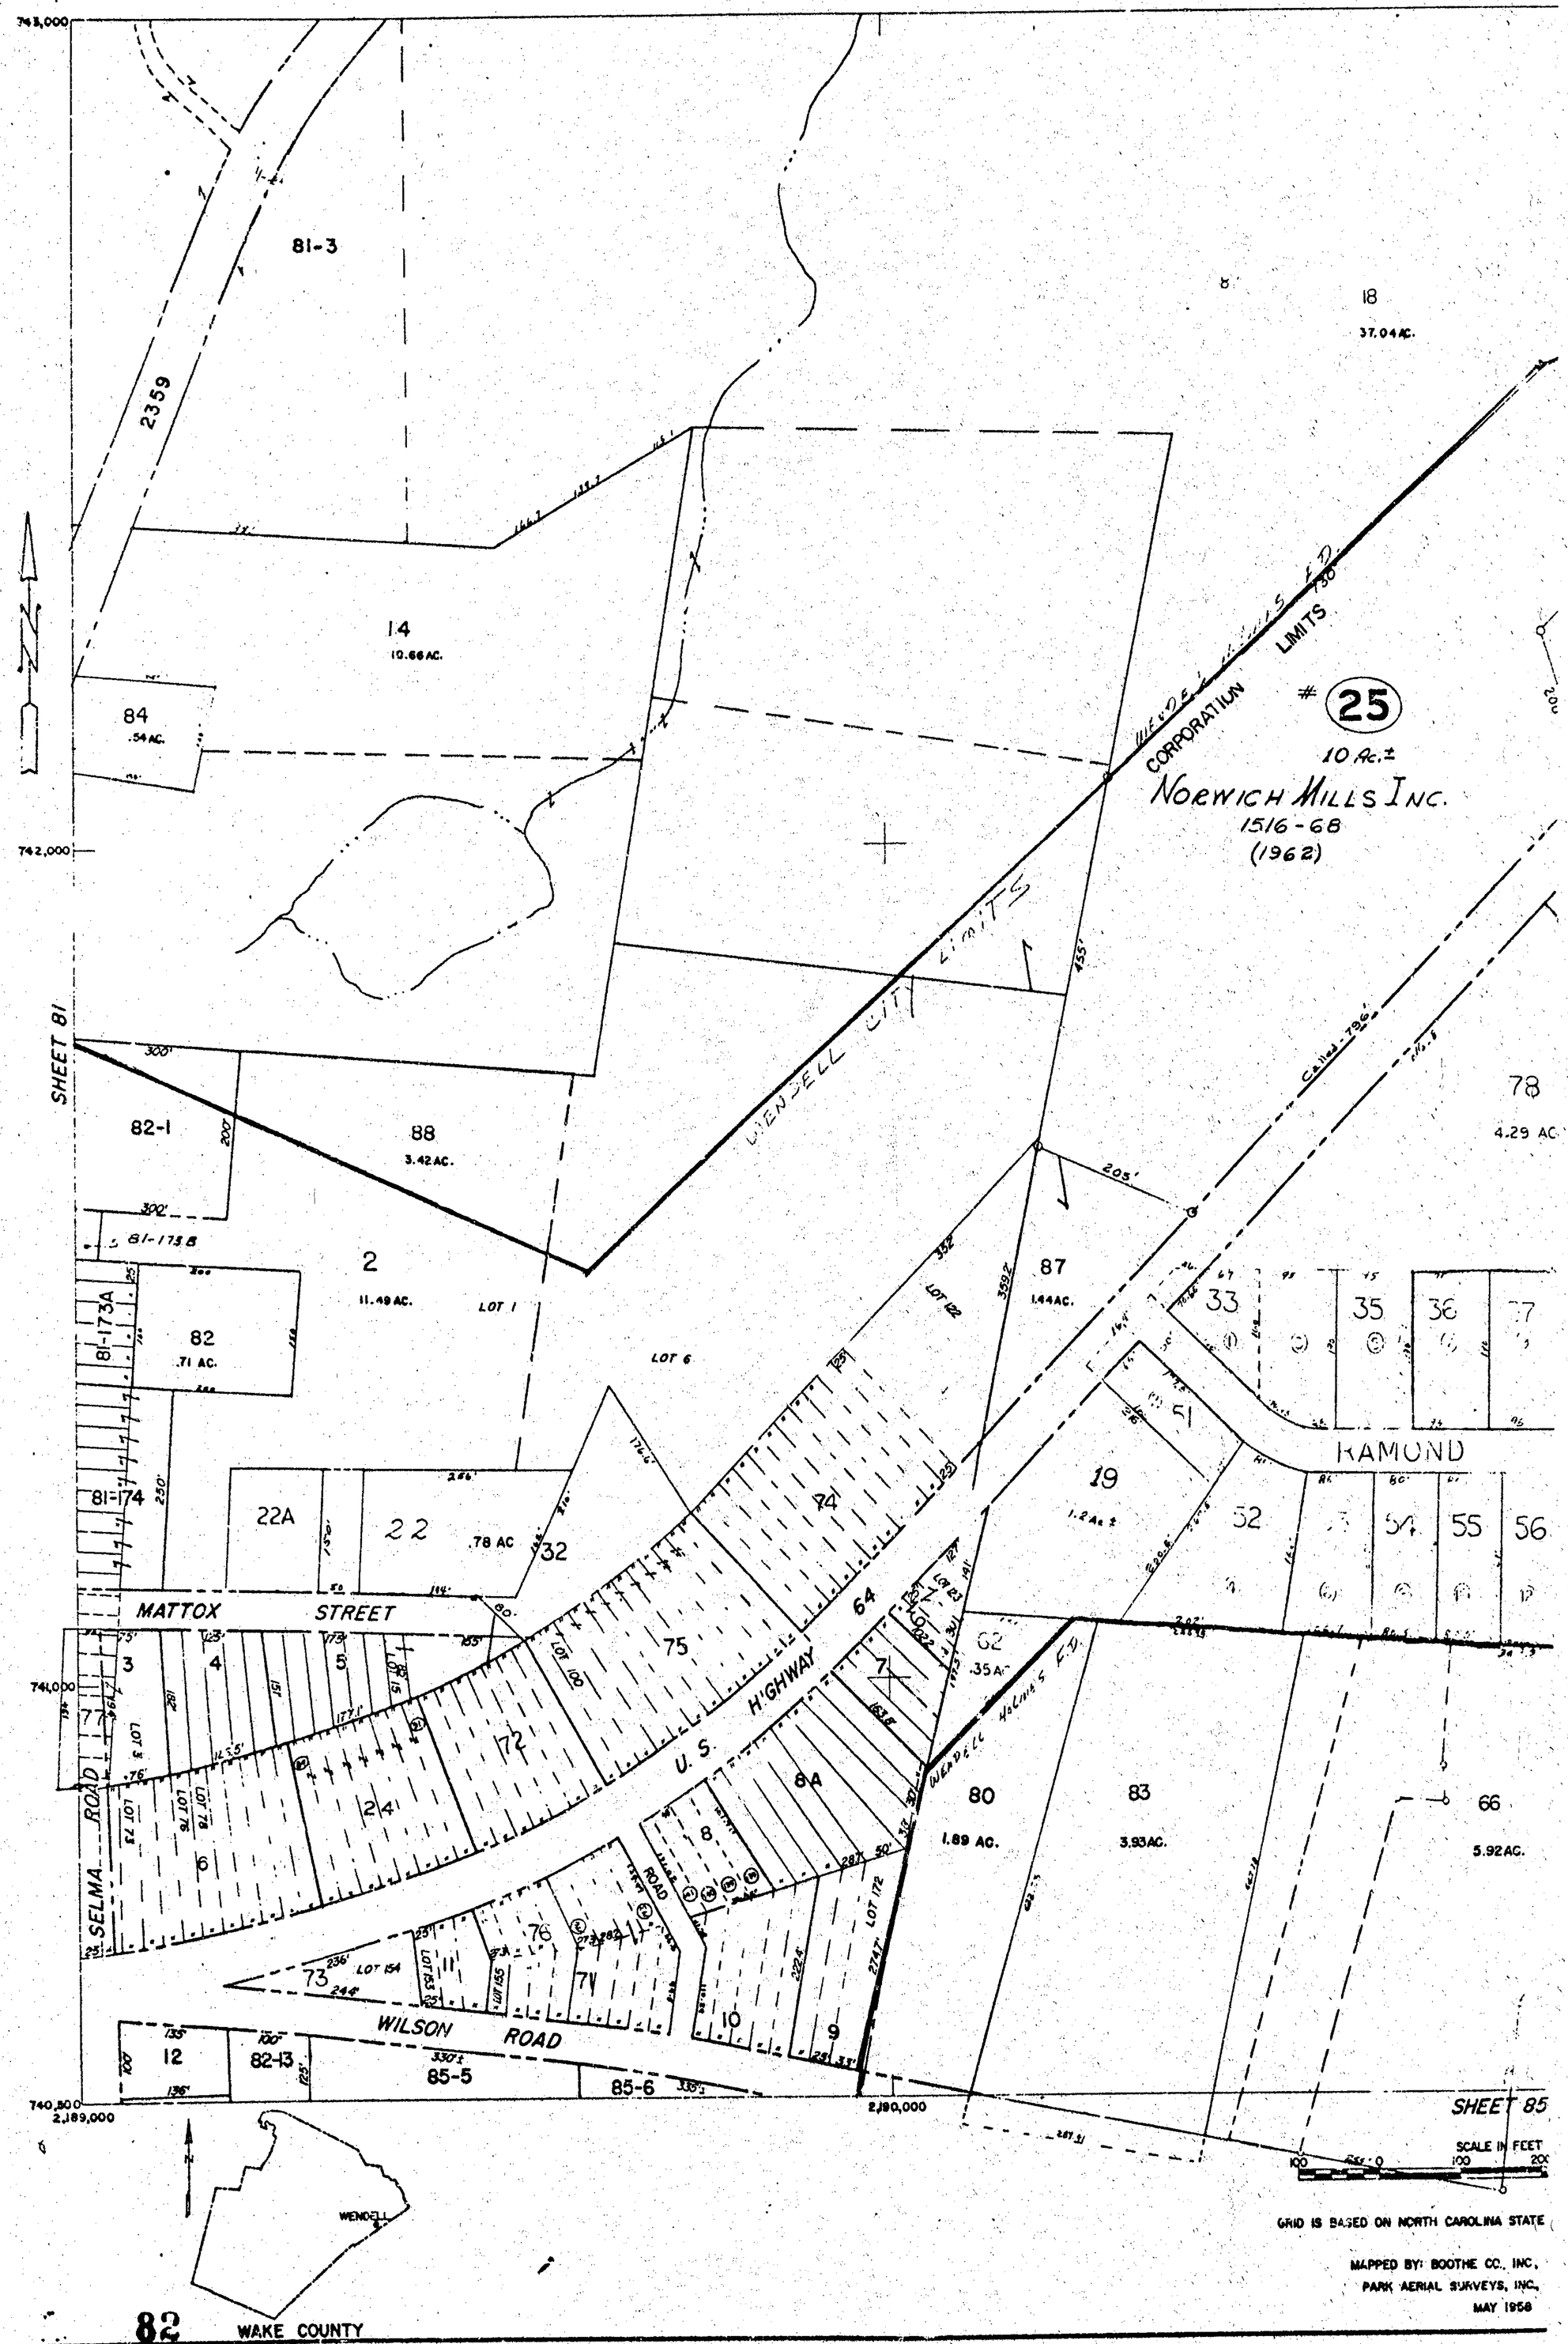

GRID IS BASED ON NORTH CAROLINA STATE

MAPPED BY: BOOTHE CO., INC.,
PARK AERIAL SURVEYS, INC.,
MAY 1958

ET 79

536-2

WHITLEY WAY SUB.
SEE MAP - 336

536-33

536-26

536-27

536-39

536-44

536-38

SHEET 536

27
26
85
.46AC.
26B
26A
81
1.07 AC.
67
1.93 AC.
28
89
.20AC.
50
49
48
47
46
45
44
43
42
41
40
60
59
58
30
68
2.04AC.
31
78
4.29 AC.
66
5.92AC.
21
36.8AC. TOT.

DRIVE

2,191,000
2,192,000
2,192,500

EET 85

LE IN FEET
200 300 400

INA STATE PLANE COORDINATE SYSTEM

CO., INC., GREENSBORO, N.C.
EYS, INC., LOUISVILLE, KY.
AY 1956

WENDELL, N.C.

SHEET 82

LAST # 10

82

SHEET 80

740,500

534-19

24

740,000

1260'

340'

751'

25

40.11AC.

SHEET

739,000

562-8

41

59.71AC.

42

1.51AC.

738,000

2,182,000

2,183,000

SHEET 86

SCALE IN FEET

100 0 100 200


GRID IS BASED ON NORTH CAROLINA STATE PL

MAPPED BY: BOOTHE CO., INC., GRE
PARK AERIAL SURVEYS, INC., LO
MAY 1958

WENDELL

83 WAKE COUNTY

SHEET 80

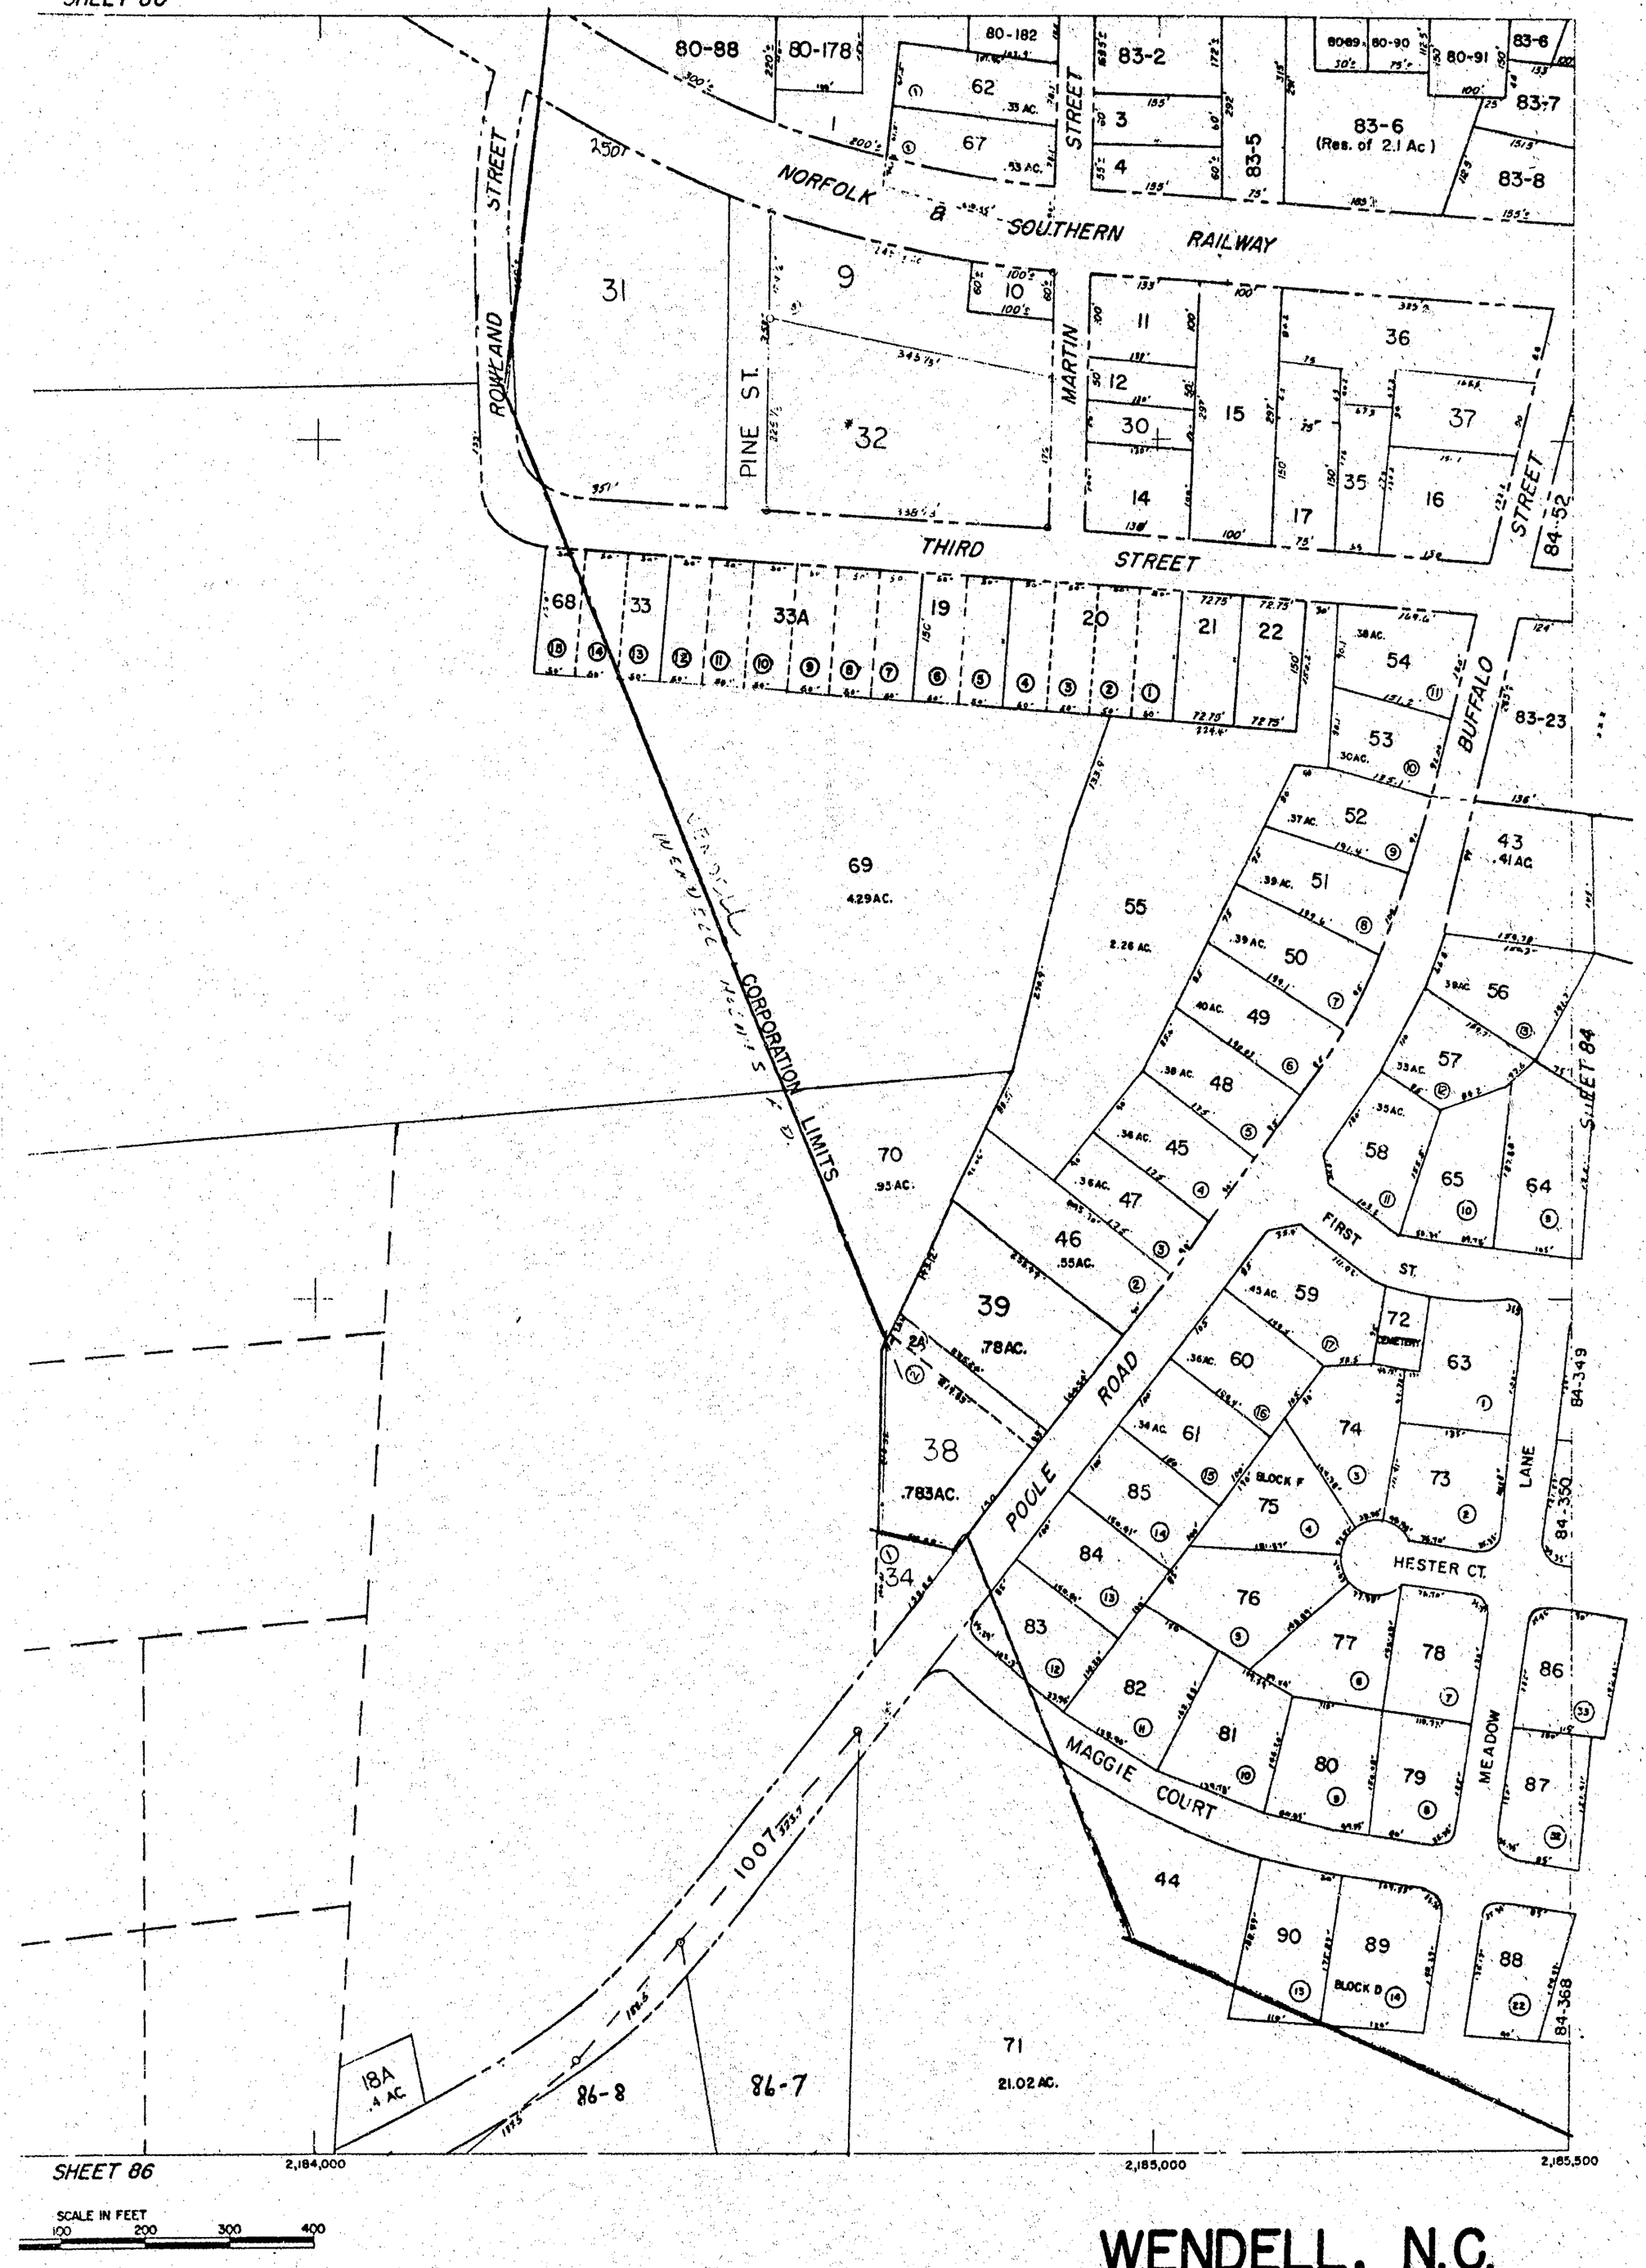

SCALE IN FEET
100 200 300 400

TH CAROLINA STATE PLANE COORDINATE SYSTEM

BOOTHE CO., INC., GREENSBORO, N.C.
IAL SURVEYS, INC., LOUISVILLE, KY.
MAY 1958

WENDELL, N.C.

SHEET 83

LAST # 91 .. 83

SHEET 81

740,500

84-1 | 81-333 | 81-334 | 81-335 | 81-336 | BUFFALO ST. | MAGNOLIA ST. | 81-287 | 81-290 | 81-297 | 84-249 | 81-306 | LEASEHOLD 348 | LEASEHOLD 347 | NORFC

740,000

84-52 | 83-7 | 83-23 | 83-43 | 83-64 | 83-86 | 83-87 | 83-44 | 87-86 | 87-2 | 84-14 | 84-23

SHEET 83

PARRISH COURT | SECOND STREET | MAGNOLIA ST. | CYPRESS AVENUE | MAIN STREET | PINE AVENUE | FIRST STREET | HAYWOOD STREET | HAYWOOD EXT. | FOWLKES STREET

739,000

HESTER COURT | MAGGIE COURT | BLOCK B

738,000

2,185,500 | 2,187,000

SHEET 87

WENDELL

SCALE IN FEET
100 0 100 200

GRID IS BASED ON NORTH CAROLINA STATE

MAPPED BY: BOOTHE CO., INC.,
PARK AERIAL SURVEYS, INC.,
MAY 1958

84 WAKE COUNTY

EET 81

FOURTH STREET

NORFOLK & SOUTHERN RAILWAY

AVENUE

THIRD STREET

OAKWOOD

SECOND STREET

HOLLYBROOK AVENUE

(1493-147) FEB. 6, 1962

241
4.4843 AC.
WAKE COUNTY HOUSING AUTHORITY

LAKE

W. LAKE DR.

WILLOW ST.

ST. EXT.

HAYWOOD

LAKE ROAD

WALNUT ST.

ZEBULON ROAD

OLD ZEBULON RD.

SHEET 85

SHEET 87

SCALE IN FEET
0 200 300 400

ROLINA STATE PLANE COORDINATE SYSTEM

...NG CO., INC., GREENSBORO, N.C.
...RVEYS, INC., LOUISVILLE, KY.
MAY 1958

WENDELL, N.C.

SHEET 84

LAST # 84

SHEET 82

740,500

740,000

739,000

738,000

2,189,000

2,190,000

WILSON ROAD

NORFOLK & SOUTHERN RAILWAY

CORPORATION LIMITS

HALL STREET

KNOTT STREET

THIRD STREET

HILLCREST DRIVE

LAWSON DRIVE

TIMBER DRIVE

GRIFFIN DRIVE

COURT

SELMA ROAD

LAKEWOOD DRIVE

WHITLEY ST.

WAKE AD

85-5

85-6

148

82-66

127

SHEET 84

84-156

84-217

84-227

84-228

84-229

84-239

88-34A

88-30

SHEET 8

SCALE IN FEET

GRID IS BASED ON NORTH CAROLINA STATE

MAPPED BY: BOOTHE CO., INC.,
PARK AERIAL SURVEYS, INC.,
MAY 1958

MENDELL

85

WAKE COUNTY

SHEET 82

82-21

536-38

146
.50 AC.

129
.80 AC.

123
.57 AC.

147
.17 AC.

536-41

SHEET 536

135

122

128

130

142

142A

132

131

133

150
.45 AC.

125

126

140

121
1.09 AC.

134

151
3.21 AC.

154
1 AC.

152

158
1 ac.? .35 AC.

2353

120.
~~.84 AC.~~ 62.25 AL.

PC BRANTLEY

SHEET 564

564-2

88-31

157
1 AC.

SHEET 88

2,191,000

2,192,000

2,192,500

SCALE IN FEET
100 200 300 400

TH CAROLINA STATE PLANE COORDINATE SYSTEM

BOOTHE CO., INC., GREENSBORO, N.C.
IAL SURVEYS, INC., LOUISVILLE, KY.
MAY 1958

WENDELL, N.C.

SHEET 85

LAST 150.. 85

SHEET 83

738,000

562-8

83-41

83-42

772'

1007'

100'

665'

6
1.AC.

1250'

17.26 AC.

737,000

562-13

SHEET 562

736,000

562-17

562-18

562-1

735,500
2,182,000

2,183,000

SHEET

SCALE IN FEET

GRID IS BASED ON NORTH CAROLINA STATE P

MAPPED BY: BOOTHE CO., INC., GR
PARK AERIAL SURVEYS, INC., LI
MAY 1958

SHEET 83

8
2. AC.

7
12.28 AC.

2
59.2AC.
49.54 AC.

83-71

87-1

SHEET 87

10
9.96 AC.

9
2.75 AC.

11
1.26 AC.

5
.7 AC.

4
.75 AC.

3
7.43 AC.

562-19

620'

752.9'

497.72'

2358

SHEET 562

2,184,000

SCALE IN FEET
100 200 300 400

SHEET 563

2,185,000

2,185,500

ITH CAROLINA STATE PLANE COORDINATE SYSTEM

BOOTHE CO., INC., GREENSBORO, N.C.
RIAL SURVEYS, INC., LOUISVILLE, KY.
MAY 1956

WENDELL, N.C.

SHEET 86

LAST SHEET 86

SHEET 8

738,000

83-44

83-71

76 .39AC.

77 .47AC.

78 .51AC.

84 .22AC.

79 .37AC.

85 .21AC.

80 .30AC.

MEADOW LANE

81 .35AC.

86 2.98AC.

CORPORATION LIMITS

87-2

339.3'

355

FOWLKES STREET

LOT 8

LOT 1

10

11

12

53

52

19

20

DRIVE

23

HARRIS

29

30

32

33

37

38

39

40

41

42

CRESTVIEW

PARSON

LAKE

87-1

45.05AC.

87-45

35.1AC.

737,000

SHEET 86

2358

POND

736,000

1257'

563-10

735,500

2,185,500

2,186,000

2,187,000

SHEET 8

SCALE IN FEET

100 0 100 2

GRID IS BASED ON NORTH CAROLINA STATE

MAPPED BY: BOOTHE CO., INC.,
PARK AERIAL SURVEYS, INC.,
MAY 1958

WENDELL

87 WAKE COUNTY

SHEET 84

84-235 | 84-237 | 84-238 | 84-258 | 84-288 | 84-300 | 84-290 | 84-321 | 84-291 | 84-264

DOGWOOD

TRAIL

AVENUE

FOREST LANE

HOLLYBROOK STREET

PLACE

WENDELL ACRES F.D.

LAKE

LAKE

2357

84-239

SHEET 88

563-11

85.80 AC.

563-12

2,188,000

2,189,000

SHEET 1

SCALE IN FEET
100 200 300 400

CAROLINA STATE PLANE COORDINATE SYSTEM

THE CO., INC., GREENSBORO, N.C.
SURVEYS, INC., LOUISVILLE, KY.
MAY 1958

WENDELL, N.C.

SHEET 87

LAST No. 90

87